
c 1 03701	(MDE USE		STATE OF MARYLAND WELL COMPLETION REPORT	THIS REPORT MUST BE SUBMITTED AFTER WELL IS COMPLETED.
1 2 3			FILL IN THIS FORM COMPLETELY PLEASE TYPE	COUNTY
ST/CO USE ONLY DATE Received MM DD YY	DATE WEL	COMPL 109-13	Depth of Well 22 320 26 0	FROM "PERMIT TO DRILL WELL"
8	15.		(TO NEAREST FOOT)	28 29 30 31 32 33 34 35 36 37
OWNERSTREET OR RFD_\	last name	856	of willow Wis plies now	land
SUBDIVISION Willo	ws caf Re	elly (1001X SECTION	ьот 34
WELL LOG Not required for driven wells			WELL HAS BEEN GROUTED (Circle Appropriate Box)	1 2
STATE THE KIND OF FORMATIONS PENETRATED, THEIR COLOR, DEPTH, THICKNESS AND IF WATER BEARING			TYPE OF GROUTING MATERIAL (Circle one)	PUMPING TEST HOURS PUMPED (nearest hour)
DESCRIPTION (Use additional sheets if needed)	FROM TO	check if water bearing	NO. OF BAGS 46 30 NO. OF POUNDS 1500	PUMPING RATE (gal. per min.)
Vay+Oir+	06		GALLONS OF WATER 750	METHOD USED TO
2 Cond	6 30		DEPTH OF GROUT SEAL (to nearest foot) fromft. toft.	MEASURE PUMPING RATE
OLU ZELLICI	1 . 4		48 TOP 52 54 BOTTOM 58 (enter 0 if from surface)	WATER LEVEL (distance from land surface) BEFORÈ PUMPING ft.
ScftGrestode	30 00	-	casing types insert ST CO	17. / 20
5071816GyRodi	4.		appropriate code PL OT	WHEN PUMPING 22 25 ft.
50718169Rode	200 320		PLASTIC OTHER	TYPE OF PUMP USED (for test) A air P piston T turbine
505+ White Rock	220 320		MAIN Nominal diameter Total depth CASING for (main) casing of main casing TYPE (nearest inch)! (nearest foot)	C centrifugal R rotary O other (describ
xxx white kock	000			27 27 Delow)
0			60 61 63 64 66 70 . E OTHER CASING (if used)	J jet S submersible
0 m			A diameter depth (feet) H inch from to	PUMP INSTALLED
	- '	MX 1	A S	DRILLER INSTALLED PUMP YES (CIRCLE) (YES or NO)
83			N G	IF DRILLER INSTALLS PUMP, THIS SECTION MUST BE COMPLETED FOR ALL WELLS.
			screen type or open hole STBR HO	TYPE OF PUMP INSTALLED PLACE (A,C,J,P,R,S,T,O) 29
E S			insert STEEL BRASS OPEN HOLE	IN BOX 29. CAPACITY:
	1		code below PLASTIC OTHER	(to nearest gallon) 31 38
a closed.	100 PS		C 2 DEPTH (nearest ft.)	PUMP HORSE POWER 37 4:
NUMBER OF UNSUCCESSE			1 2	(nearest ft.)
WELL HYDROFRACTURED	Yes	N	E 8 9 11 15 17 21	CASING HEIGHT (circle appropriate box and enter casing height)
CIRCLE APPROPRIATE LETTER A WELL WAS ABANDONED AND SEALED			H ² 23 24 26 30 32 36	49 LAND SURFACE
E ELECTRIC LOG OBTAINED			C 3 45 47 51	below \
P TEST WELL CONVERTE	71.		E SLOT SIZE 1 2 3	LOCATION OF WELL ON LOT SHOW PERMANENT STRUCTURES
HEREBY CERTIFY THAT THIS WELL HAS BEEN CONSTRUCTED IN ACCORDANCE WITH COMAR 26.04.04 "WELL CONSTRUCTION" AND IN CONFORMANCE WITH ALL CONDITIONS STATED IN THE ABOVE CAPTIONED PERMIT, AND THAT THE INFORMATION PRESENTED			DIAMETER (NEAREST INCH)	AND INDICATE NOT LESS THAN TWO DISTANCES
HEREIN IS ACCURATE AND COMPLETE TO THE BEST OF MY KNOWLEDGE.			from to	(MEASUREMENTS TO WELL)
DRILLERS VIC/NO.1, MW D 553			GRAVEL PACK IF WELL DRILLED WAS STOWNED WELL	100 76. 887446 GO
DRILLEAS SIGNATURE (MUST MATCH SIGNATURE ON APPLICATION)			WAS FLOWING WELL INSERT F IN BOX 68 MIDE USE ONLY	much of all
LIC. NO.1 AWD 94			(NOT TO BE FILLED IN BY DRILLER) T (E.R.O.S.) W Q	Front
salles	4		70 72	
SITE SUPERVISOR (sign. of driller or journeyman responsible for sitework if different from permittee)			TELESCOPE LOG 74 75 76 CASING INDICATOR OTHER DATA	
DENV-CR97			② COUNTY	

DENV-CR97

1) THIS PLAT IS PREPARED FOR THE BENEFIT OF THE CLIENT SIGNING THE HOUSE LOCATION SURVEY APPROVAL FORM INSOFAR AS IT IS REQUIRED BY A LENDER OR TITLE INSURANCE COMPANY OR ITS AGENTS IN CONNECTION WITH THE CONTEMPLATED TRANSFER, FINANCING OR RE-FINANCING. UNLESS INDICATED AS BEING A BOUNDARY SURVEY, THIS PLAT IS NOT INTENDED FOR USE IN THE ESTABLISHMENT OF PROPERTY LINES AND IS NOT TO BE RELIED UPON FOR THE ESTABLISHMENT OR LOCATIONS OF FENCES, GARAGES, BUILDINGS OR OTHER EXISTING OR FUTURE IMPROVEMENTS. AS A RESULT, THIS PLAT DOES NOT PROVIDE FOR ACCURATE IDENTIFICATION OF PROPERTY LINE, BUT SUCH IDENTIFICATION MAY NOT BE REQUIRED FOR THE TRANSFER OF TITLE OR SECURING FINANCING OR RE-FINANCING.

2) SUBJECT PROPERTY IS SHOWN IN ZONE _C__ON THE NATIONAL FLOOD INSURANCE PROGRAM FLOOD INSURANCE RATE MAP OF __HOWARD __COUNTY, MARYLAND, COMMUNITY PANEL No. _2400440042 B _, EFFECTIVE DATE: __DEC. 4, 1906 _.

3) THE OFFSETS FROM BUILDING LINE TO PROPERTY LINE AS SHOWN ON THE PLAT HEREON ARE TO AN ACCURACY OF 1' PLUS OR MINUS (*).

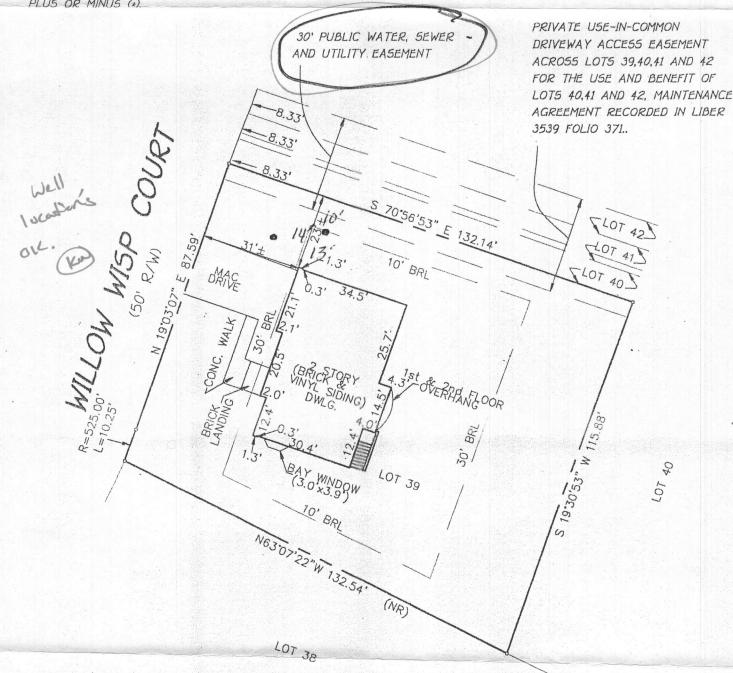

• 8521 WILLOW WISP COURT

TOP FOUNDATION ELEV.= 379.1±

BRL = BUILDING RESTRICTION LINE

LOT 39
THE WILLOWS OF ROCKY GORGE
LOTS 1 THRU 45
6TH ELECTION DISTRICT
HOWARD COUNTY, MARYLAND
PLAT REF: * 11879

FISHER, COLLINS & CARTER, INC.
CIVIL ENGINEERING CONSULTANTS & LAND SURVEYORS
CENTENNIAL SQUARE OFFICE PARK - 10272 BALTIMORE NATIONAL PIRE

CENTENNIAL SQUARE OFFICE PARK - 10272 BALTIMORE NATIONAL PICE ELLICOTT CITY, MARYLAND 21042 (410) 461 - 2055



HOUSE LOCATION DRAWING

FOUNDATION LOCATION:<u>8/28/9</u>8 FINAL LOCATION:<u>12/10/98</u> BOUNDARY SURVEY:

1"= 30"