

APPLICATION

26049

SEWAGE DISPOSAL TESTING

P. _____

STATE OF MARYLAND - DEPARTMENT OF HEALTH AND MENTAL HYGIENE

HOWARD COUNTY HEALTH DEPARTMENT
ENVIRONMENTAL HEALTH SERVICES

P. O. BOX 476, ELLICOTT CITY, MARYLAND 21043
TELEPHONE: 465-5000, EXT. 356

DISTRICT 3rd

DATE 6/7/77

TO: THE COUNTY HEALTH OFFICER
ELLICOTT CITY, MARYLAND

I, HEREBY, APPLY FOR THE NECESSARY TEST IN ORDER TO CONSTRUCT (OR RECONSTRUCT) A SEWAGE DISPOSAL SYSTEM.

PROPERTY OWNER William B. Ridgely Thomas W. Lutz

ADDRESS Spring Meadow Farm Cookeville, Md. 21728 PHONE Carol Clark

Apt. G

531-5115

33, 34, 35

PROPERTY LOCATION:

SUBDIVISION Ridgely Property (Friendship) LOT NO. 26

manor

ROAD AND DESCRIPTION Rte. 144 - Rte. 32 2574 Wellworth Way

SIZE OF LOT ? TYPE BLDG. 3 or 4 bedroom
NUMBER OF BEDROOMS

IF NOT SINGLE RESIDENCE DESCRIBE _____

THE SYSTEM INSTALLED UNDER THIS APPLICATION IS ACCEPTABLE ONLY UNTIL PUBLIC FACILITIES BECOME AVAILABLE.

SIGNATURE OF APPLICANT /s/ Albert Schoel

APPROVED BY D.W. M. & F. Scheris FOR drywell DATE 5/20/82
(KIND OF SYSTEM)

REJECTED BY _____ FOR _____ DATE _____
(KIND OF SYSTEM)

HOLD PENDING FURTHER TESTS _____ DATE _____


REASONS FOR REJECTION OR HOLDING _____

BLDG. PERMIT SIGNED
AND RETURNED 6/24/82
For S.F.D. # 44626

THIS IS NOT A PERMIT

0
1 clay mixed
3-6
1
13 sandy loam

Lot 26

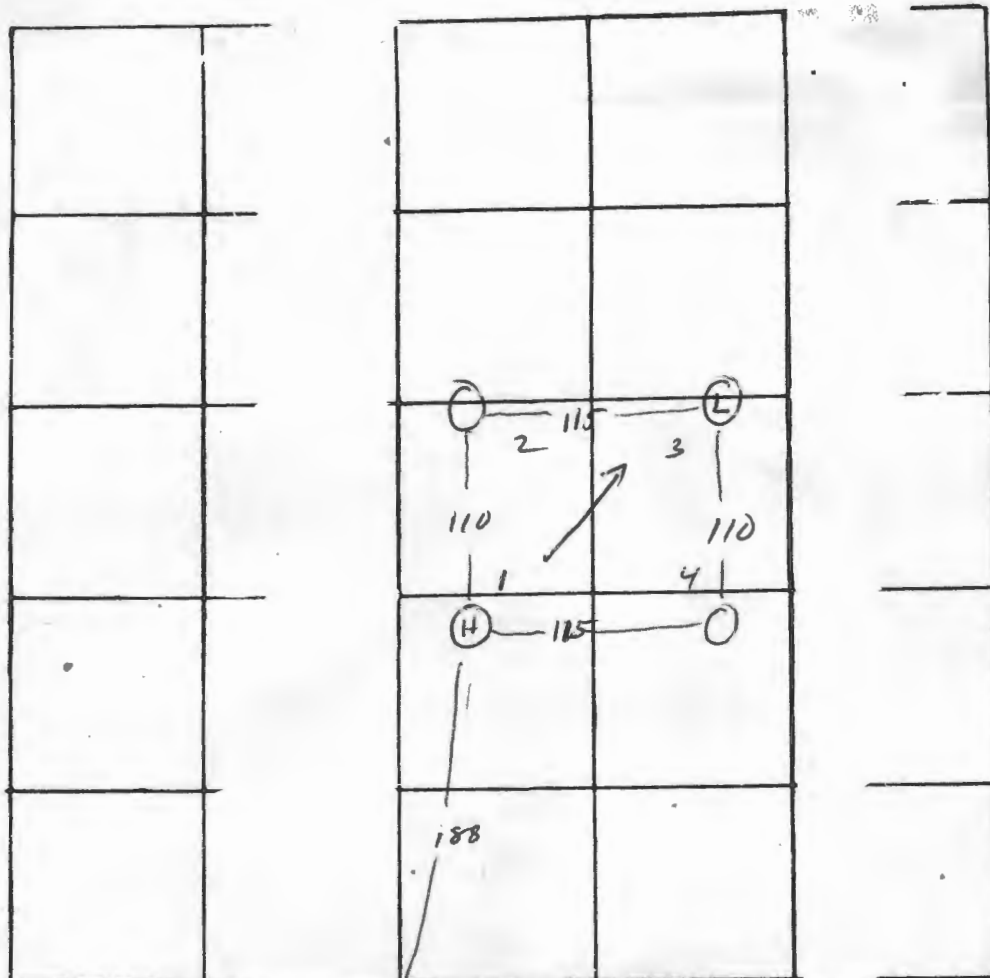

INDICATE NORTH. - NAME ADJOINING ROADWAY AS BASE LINE

ERW

DATE	TEST NO.	DEPTH	PRE-WET		TEST - 1" DROP		TIME
			START	STOP	START	STOP	
1 July 77	1	3	9 ³⁸	9 ⁴⁶	9 ⁴⁶	10 ⁰⁴	18
	1A	13	9 ³⁸	9 ⁴⁴	9 ⁴⁴	9 ⁵⁶	12
	2	3	9 ⁴²	9 ⁵⁵	9 ⁵⁵	10 ¹⁵	20
	2A	13	9 ⁴²	9 ⁴⁷	9 ⁴⁷	9 ⁵⁸	11
	3	4	9 ⁴⁰	10 ⁰⁰	10 ⁰⁰	10 ²⁶	26
	3A	13	9 ⁴²	9 ⁴²	9 ⁴²	9 ⁴⁸	6
	4	12	vis				

REMARKS

TYPE OF SOIL

TESTED BY

M

ALSO PRESENT:

Scheel