

MARYLAND DEPARTMENT OF THE ENVIRONMENT, WATER MANAGEMENT ADMINISTRATION
1800 Washington Blvd., Baltimore, Maryland 21230 (410) 537-3784

WATER WELL ABANDONMENT-SEALING REPORT FORM

SUBMIT COPIES OF COMPLETED FORM TO:

- * COUNTY ENVIRONMENT AGENCY (contact MDE, WMA if address needed)
- * WELL OWNER
- * MDE, WATER MANAGEMENT ADMINISTRATION, WELL PROGRAM

DATE WELL ABANDONED: Oct. 19, 07 (month/day/year)

* PERMIT NUMBER OF ABANDONED WELL (if any) None

* PERMIT NUMBER OF REPLACEMENT WELL None


* PERSON ABANDONING WELL: Mark Rutherford

WELL DRILLERS LICENSE NUMBER: 554
CIRCLE: MWD/MSD/MGD

* OWNER'S NAME: Jong H. Lee

SITE LOCATION MAP

* WELL LOCATION:
 COUNTY: Howard
 NEAREST TOWN: Elliott City
 TAX MAP _____ BLOCK _____ PARCEL _____
 SUBDIVISION: _____
 SECTION: _____ LOT: _____
 NEAREST ROAD: 10470 Pulaski Hwy

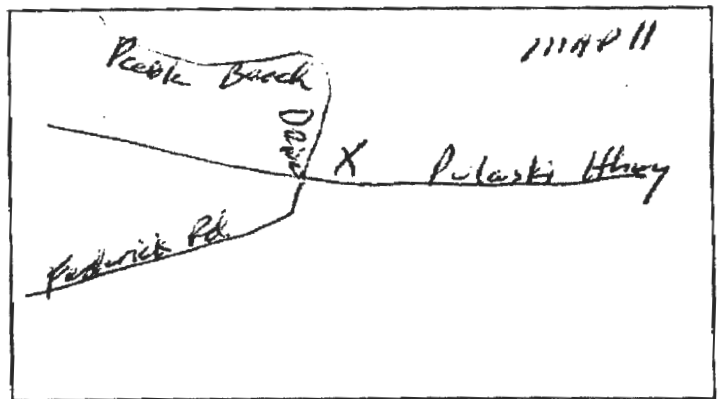

* TYPE OF WELL BEING ABANDONED:

- DRILLED _____ JETTED
 _____ BORED/AUGERED _____ HAND DUG
 _____ OTHER (specify) _____

* USE CODE:

- DOMESTIC _____ MUNICIPAL/PUBLIC
 _____ IRRIGATION _____ INDUSTRIAL
 _____ TEST/OBSERVATION _____ GEOTHERMAL

* TYPE OF CASING:

- STEEL _____ PLASTIC
 _____ CONCRETE _____ OTHER (specify) _____

* SIZE OF CASING: 6 INCHES IN DIAMETER

* DEPTH OF WELL: 83 FEET DEEP

* WAS ANY CASING REMOVED? _____ YES NO
if yes, length removed, in feet: _____

* WAS CASING RIPPED OR PERFORATED? _____ YES NO

LOG OF SEALING MATERIAL

MATERIAL	FEET	
	FROM	TO
well pit to be dtds during abandonment		
bentonite hole plug	4	83
VOLUME OF MATERIAL USED		
15.8 cu. ft. bentonite		

SIGNATURE-MASTER WELL DRILLER OR SUPERVISING SANITARIAN

David Kelly

304
LICENSE #

MWD/MSD/MGD
CIRCLE ONE

10/22/07
DATE

JONES WELL DRILLING, INC.
3700 RUSH RD.
JARRETTSVILLE, MD 21084
410-557-8123
410-692-6981
FAX #410-692-6969
www.joneswelldrilling.com
joneswelldrilling@yahoo.com

Fax

To: Inspector	From: Donna Jones
Fax: 410-313-2648	Pages: 2 Includes Cover
Phone:	Date: 10/24/07
Re: Abandonment report	CC:
10470 Pulaski Highway	

Urgent For Review Please Comment Please Reply Please Recycle

● Comments:

This fax contains confidential material and intended only for the individual or entity to which it is addressed. Please notify us if you have received this in error. Distribution or copying is prohibited.

P. 29297 A. 26514
DATE 12/1/78

LOCATION <u>18807 Penn Shop Rd.</u>	APPLICATION
_____	HOLD
_____	APPROVED <input checked="" type="checkbox"/>
_____	REJECTED <input type="checkbox"/>
LOT _____	INSTALLATION
APPLICANT <u>Albert Mc Pherson</u>	HOLD
OWNER <u>Albert Mc Pherson</u>	APPROVED <input checked="" type="checkbox"/>
PERMITTEE " "	APPROVED DATE <u>12/27/78</u>

HD - 11

12860 Marshall Farm Pa
Rot 12 Maplefield

FAX 301 854 0422
WATER LABS

502 490 5794

6810 Green Hollow Way
443 250 0835
DALE

lot 49 yield test not done
8:00 3hr yield.