

3/9/84
1:30 p.m.

APPLICATION

PRELIMINARY

SEWAGE DISPOSAL TESTING

STATE OF MARYLAND - DEPARTMENT OF HEALTH AND MENTAL HYGIENE

HOWARD COUNTY HEALTH DEPARTMENT
ENVIRONMENTAL HEALTH SERVICES

P. O. BOX 476 ELLICOTT CITY, MARYLAND 21043
TELEPHONE: 992-2330

A 33634

P _____

DISTRICT 3rd

DATE 3/8/84

TO: THE COUNTY HEALTH OFFICER
ELLICOTT CITY, MARYLAND

I, HEREBY, APPLY FOR THE NECESSARY TEST IN ORDER TO CONSTRUCT (OR RECONSTRUCT) A SEWAGE DISPOSAL SYSTEM.

PROPERTY OWNER Woodmark, Inc. D.G.B. Inc.

ADDRESS 12150 Mt. Albert Road, Ellicott City, Md.

PHONE 531-5500
531-5072

PROPERTY LOCATION:

SUBDIVISION Woodmark, Inc.

DAN BLAKE PROPERTY

LOT NO. 2

ROAD AND DESCRIPTION 12/90 Willowind Court

BLDG. PERMIT SIGNED

AND RETURNED

6-28-91
Serial # 38441

SIZE OF LOT 7.058 (to be subdivided in two lots)

TYPE BLDG. 3 or 4 bedrooms
(NUMBER OF BEDROOMS)

THE SYSTEM INSTALLED UNDER THIS APPLICATION IS ACCEPTABLE ONLY UNTIL PUBLIC FACILITIES BECOME AVAILABLE. I FULLY UNDERSTAND THE

FEE CONNECTED WITH THE FILING OF THIS PERC TEST APPLICATION IS NON-REFUNDABLE UNDER ANY CIRCUMSTANCES. I ALSO AGREE TO COMPLY

WITH ALL M.O.S.H.A. REQUIREMENTS IN TESTING THIS LOT. X /s/ Jack Fyock for AM Dan Blake

(SIGNATURE OF APPLICANT)

APPROVED BY _____ FOR _____ DATE _____

REJECTED BY _____ FOR _____ DATE _____

HOLD PENDING FURTHER TESTS C. Waller DATE 5-12-84

REASONS FOR REJECTION OR HOLDING SUBDIVISION PLAT REQUIRED - CW


BLDG. PERMIT SIGNED

AND RETURNED

6-28-91
Serial # 38441 - SFD

4 Bedrooms

THIS IS NOT A PERMIT

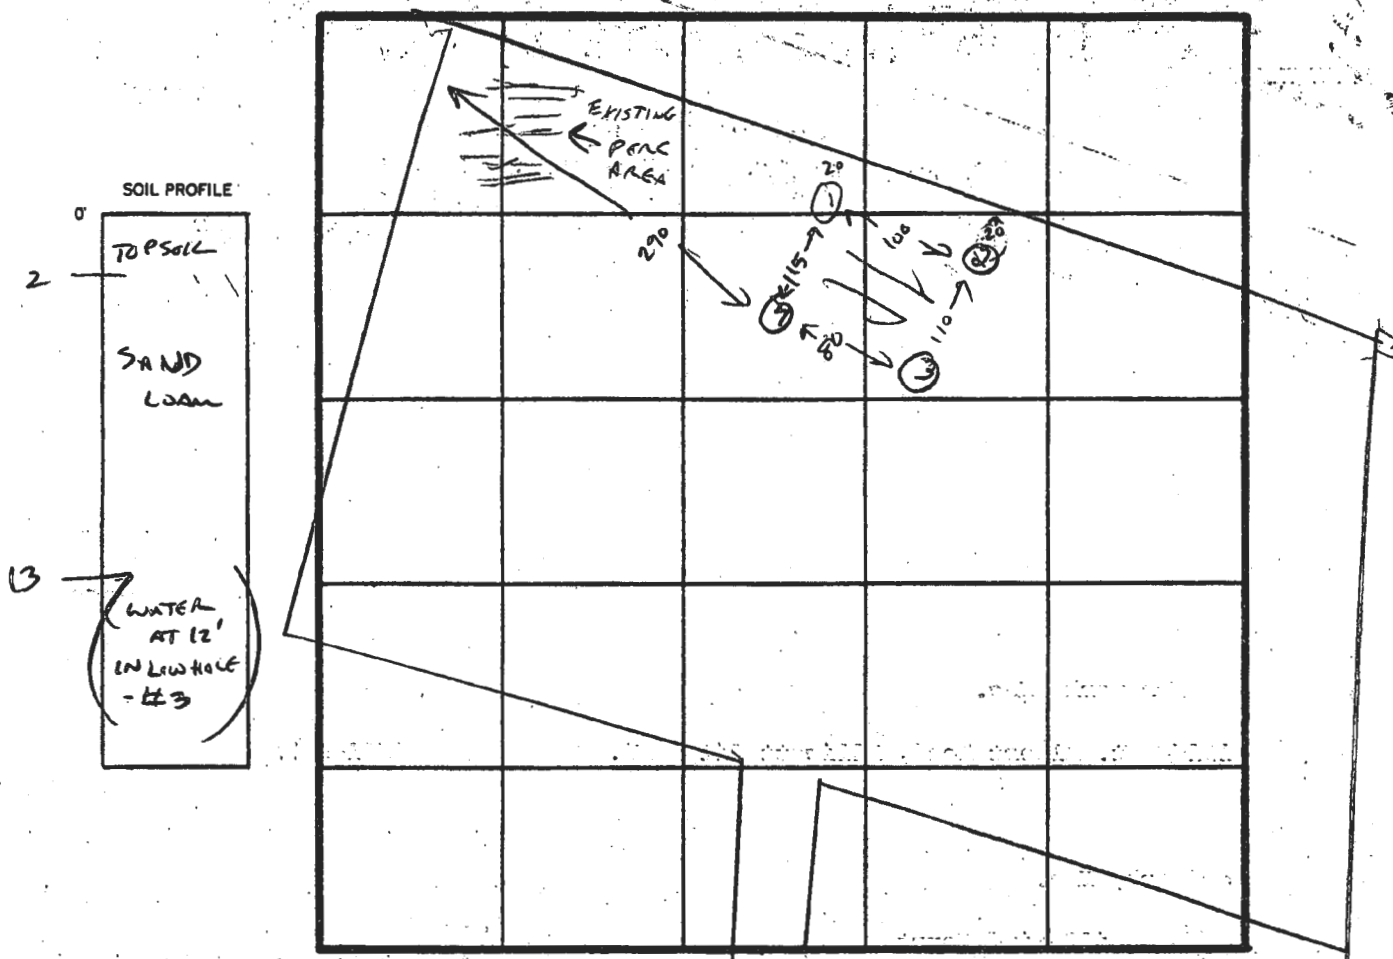

INDICATE NORTH - NAME ADJOINING ROADWAY AS BASE LINE.

DATE	TEST NO.	DEPTH	PRE-WET		TEST - 1" DROP		TIME
			START	STOP	START	STOP	
3-9-84	1 H16H	3 8	2:28	2:30	2:30	2:32	2 MIN
		13	SAND	LOAM			
3-9-84	2	3 8	2:20	2:22	2:22	2:24	2 MIN
		13	SAND	LOAM			
3-9-84	3 LOW	3 8	2:17	2:19	2:19	2:21	2 MIN
		13	SAND LOAM				
3-9-84	4 H16H	3 8	2:35	2:38	2:38	2:41	3 MIN
		13	SAND	LOAM			

REMARKS SUBDIVISION PLAT REQUIRED.



TYPE OF SOIL SAND

TESTED BY C. Williams

ALSO PRESENT F. Lock

COORDINATE SCHEDULE			
No.	North	East	
1	520, 501.76	816, 571.64	
2	520, 494.13	816, 631.13	
3	520, 435.06	816, 721.16	
4	520, 464.20	817, 207.51	
5	520, 779.47	817, 387.30	
6	520, 646.75	817, 775.27	
7	520, 082.53	817, 442.75	
8	520, 070.67	816, 983.10	
9	520, 437.52	817, 192.27	
10	520, 410.18	816, 983.67	

CURVE DATA					
No.	Rad.	Length	A	Ch.	LCB
1-2	508.47	6002	08°50'37"	30.04	9 82° 41' 35" E
2-3	497.00	500.54	54°58'59"	155.02	5 78° 27' 16" E
10-1	528.00	378.56	40°46'59"	194.04	5 79° 25' 09" W

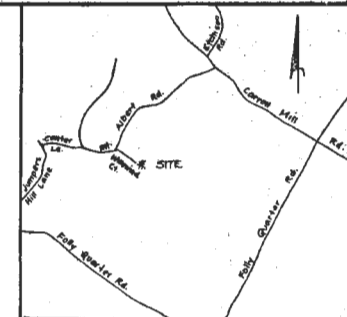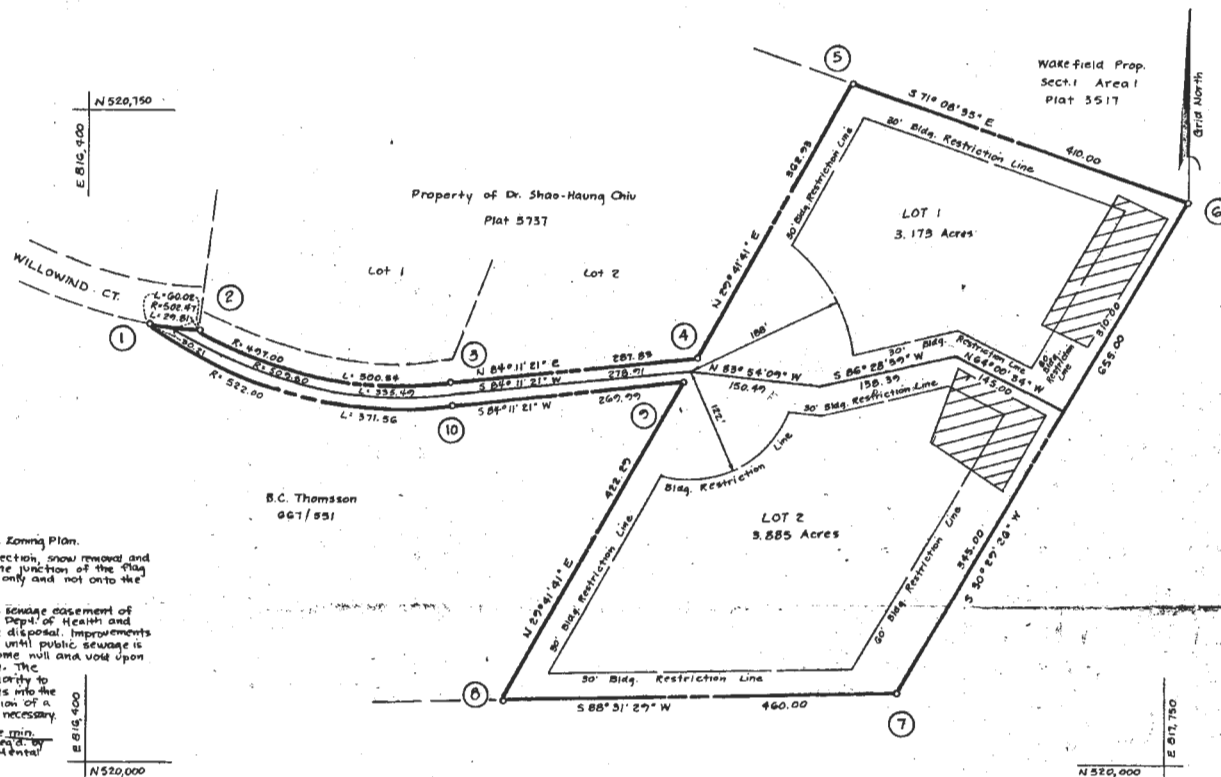

NOTES:

- Subject to VP 54-121.
- Zoned R as per 1977 Comprehensive Zoning Plan.
- For flag or pipeline lots, refuse collection, snow removal and road maintenance are provided to the junction of the flag or pipeline & the road right-of-way only and not onto the flag or pipeline lot driveway.
- This area designates a private sewage easement of 10,000 sq. ft. as required by the Md. State Dept. of Health and Mental Hygiene for individual sewage disposal. Improvements of any nature in this area are restricted until public sewage is available. These easements shall become null and void upon connection to a public sewage system. The Co. Health Officer shall have the authority to grant variances for encroachments into the private sewage easement. Recordation of a modified sewage easement shall not be necessary.
- The lots shown hereon comply with the min. ownership width and lot areas as required by the Md. State Dept. of Health and Mental Hygiene.

TABULATION:

Total No. of Lots and/or Parcels to be recorded	2
Total Area of Lots and/or Parcels	7.058 Ac.
Total Area of Roadways incl. widening strips	0
Total Area of Subdivision	7.058 Ac.

APPROVED: For Private Water & Private Sewerage Systems, in conformance with the Master Plan of Water and Sewerage for Howard Co., Howard Co. Dept. of Health and Mental Hygiene.

County Health Officer _____ Date _____

APPROVED: Howard County Office of Planning and Zoning.

Director _____ Date _____

APPROVED: For Storm Drainage Systems, Public Water & Public Sewer and Public Roads, Howard Co. Dept. of Public Works

Director _____ Date _____

OWNER'S DEDICATION:

I (we), _____ owner(s) of the property shown & described hereon, hereby adopt this plan of subdivision in consideration of the approval of this Final Plat by the Office of Planning & Zoning, establish the min. Bldg. Restriction Lines & grant unto Howard Co., Md.; its successors & assigns, (1) the right to lay, construct & maintain sewers, drains, water pipes & other municipal utilities & services, in and under all roads & street rights-of-way & the specific easement areas shown hereon; (2) the right to require Roadplaza & open space where applicable, & for good and other valuable consideration, hereby grant the right & option to Howard Co., Md. to acquire the fee simple title to the beds of the streets and/or roads & floodplains, storm drainage facilities & open space where applicable; (3) the right to require dedication of waterways & drainage easements for the specific purpose of their construction, repair & maintenance; and (4) that no bldg. or similar structure of any kind shall be erected on or over the said easements & rights-of-way.

Owner D.B. Dr. Shao-Huang Chiu Date 7-18-84


Witness Paul Higgins Date 7-18-84

SURVEYOR'S CERTIFICATE:

I hereby certify that the Final Plat shown hereon is correct, that it is a subdivision of land conveyed by MICHAEL & CYNTHIA F. SLICK to D.B. Dr. Shao-Huang Chiu deed dated 1-25-84 and recorded in the Land Records of Howard County in Liber 128 at folio 35, and that all monuments are in place or will be in place prior to the acceptance of the streets in the subdivision by Howard County as shown, in accordance with the Annotated Code of Maryland, as amended.

Signature Paul Higgins

Date 7-18-84

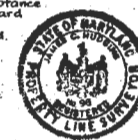

RECEIVED
JUL 24 1984

DIVISION OF LAND DEVELOPMENT
OF HOWARD COUNTY

ASSOCIATES, INC.
Surveying & Land Development
15205 Old Frederick Road
Mt. Airy, Maryland 21111
(301) 442-2051

DANIEL G. BLAKE PROPERTY

Lots 1 and 2

R 350
Tax Map 22
Zoned R

2nd Election District, Howard County, Md.
Scale: 1" = 100' Date: 7-18-84

In 7-26-84

F-85-89

Septic