

C1 2301

SEQUENCE NO.
(DENV USE ONLY)STATE OF MARYLAND
WELL COMPLETION REPORTFILL IN THIS FORM COMPLETELY
PLEASE PRINT OR TYPETHIS REPORT MUST BE SUBMITTED WITHIN
45 DAYS AFTER WELL IS COMPLETED.COUNTY
NUMBER A 33634

DATE Received

DATE WELL COMPLETED

Depth of Well

PERMIT NO.
FROM "PERMIT TO DRILL WELL"

1	2	3
8	9	10
11	12	13

14	15	16	17	18	19	20
----	----	----	----	----	----	----

21	22	23	24	25	26
----	----	----	----	----	----

27	28	29	30	31	32	33	34	35	36	37
----	----	----	----	----	----	----	----	----	----	----

OWNER Black, Dan
last name first nameSTREET OR RFD Willowood Ct TOWN GreenleeSUBDIVISION Acres Property SECTION 1 LOT 2

WELL LOG

Not required for driven wells

STATE THE KIND OF FORMATIONS
PENETRATED, THEIR COLOR, DEPTH,
THICKNESS AND IF WATER BEARINGDESCRIPTION (Use
additional sheets if needed)

FEET

FROM

TO

Check
if water
bearing

GROUTING RECORD

WELL HAS BEEN GROUTED
(Circle Appropriate Box)

TYPE OF GROUTING MATERIAL

CEMENT CM BENTONITE CLAY BCNO. OF BAGS 13 NO. OF POUNDS 1300GALLONS OF WATER 65

DEPTH OF GROUT SEAL (to nearest foot)

from 0 ft. to 30 ft.
(enter 0 if from surface)casing
types
insert
appropriate
code
below

CASING RECORD

ST	CO
STEEL	CONCRETE
PL	OT
PLASTIC	OTHER

MAIN Nominal diameter Total depth
CASING top (main) casing of main casing
TYPE (nearest inch) (nearest foot)

ST	6	42
60	61	70

EACH
CASING

OTHER CASING (if used)

diameter depth (feet)
inch from to

screen type
or open holeinsert
appropriate
code
below

SCREEN RECORD

ST	BR	HO
STEEL	BRASS	OPEN
PL	BRONZE	HOLE
PLASTIC	OTHER	

C2

EACH
SCREEN

DEPTH (nearest ft.)

1	2	3	4	5	6	7	8	9	10	11	12	13	14	15	16	17	18	19	20	21
22	23	24	25	26	27	28	29	30	31	32	33	34	35	36	37	38	39	40	41	42
43	44	45	46	47	48	49	50	51	52	53	54	55	56	57	58	59	60	61	62	63

SLOT SIZE 1 2 3

DIAMETER OF SCREEN (NEAREST INCH)

from to

GRAVEL PACK

IF WELL DRILLED WAS
FLOWING WELL INSERT
F IN BOX 68OEP USE ONLY
(NOT TO BE FILLED IN BY DRILLER)

T (E.R.O.S.)

70 72

TELESCOPE LOG
CASING INDICATOR

OTHER DATA

C3

1

2

PUMPING TEST

HOURS PUMPED (nearest hour) 3PUMPING RATE (gal. per min. to nearest gal.) 7METHOD USED TO
MEASURE PUMPING RATE Pressure

WATER LEVEL (distance from land surface)

BEFORE PUMPING 73WHEN PUMPING 70


TYPE OF PUMP USED (for test)

A	P	T
air	piston	turbine
C	R	O
centrifugal	rotary	other (describe below)
J	S	
jet	submersible	

PUMP INSTALLED

DRILLER WILL INSTALL PUMP YES NO

IF DRILLER INSTALLS PUMP, THIS SECTION
MUST BE COMPLETED FOR ALL WELLS
EXCEPT HOME USE
TYPE OF PUMP INSTALLED
PLACE (A,C,J,P,R,S,T,O)
IN BOX - SEE ABOVE:CAPACITY:
GALLONS PER MINUTE (to nearest gallon) 31PUMP HORSE POWER 37PUMP COLUMN LENGTH (nearest ft.) 43CASING HEIGHT (circle appropriate box
and enter casing height)

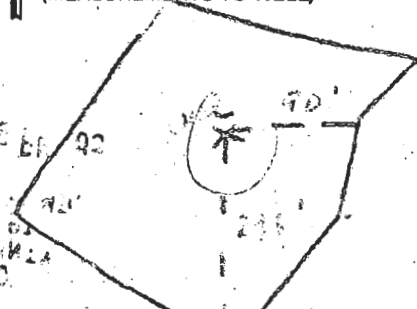LOCATION OF WELL ON LOT
SHOW PERMANENT STRUCTURE SUCH AS
BUILDING, SEPTIC TANKS, AND/OR
LANDMARKS AND INDICATE NOT LESS
THAN TWO DISTANCES
(MEASUREMENTS TO WELL)CIRCLE APPROPRIATE LETTER
A A WELL WAS ABANDONED AND SEALED
WHEN THIS WELL WAS COMPLETED

E ELECTRIC LOG OBTAINED

P TEST WELL CONVERTED TO PRODUCTION
WELLI HEREBY CERTIFY THAT THIS WELL HAS BEEN CONSTRUCTED IN
ACCORDANCE WITH COMAR 10.17.13 "WELL CONSTRUCTION"
AND IN CONFORMANCE WITH ALL CONDITIONS STATED IN THE
ABOVE CAPTIONED PERMIT, AND THAT THE INFORMATION
PRESENTED HEREIN IS ACCURATE AND COMPLETE TO THE BEST
OF MY KNOWLEDGE.DRILLERS IDENT. NO. 40DRILLERS SIGNATURE
(MUST MATCH SIGNATURE ON APPLICATION)SITE SUPERVISOR (sign. of driller or journeyman
responsible for sitework if different from permittee)

COUNTY

3/26/92 ASAP

APPLICATION FOR PITLESS ADAPTER, WELL PUMP AND PRESSURE TANK INSTALLATION

Howard County Health Department
Bureau of Environmental Health
3525-H Ellicott Mills Drive
Court House Square
Ellicott City, Md. 21043
461-9933

New Installation ☒
Replacement ☐

Receipt # 44929
Date 3/18/92

Name of Installer BRUCE H. GALLUP INC.

Telephone 321-7244

License number P1014

Certified Well Pump Installer ☒ Well Driller ☐ Registered Plumber ☐

Name of Property Owner DGB INC

Telephone

Subdivision WOOD MARK

Lot # 2

Well tag # 10-88-0476

Site Address 12190 WILLOW WIND CT
ELLCOTT CITY, MD 21042

Pump

1. Type

- a. Deep well jet ☐
b. Shallow well jet ☐
c. Submersible ☒

2. Make WEIRTRUL

3. Model # 7257163

4. Capacity 7 GPM

5. Pump exceeds well capacity Yes ☐ No ☒

6. If Yes, is low pressure cutoff switch installed? Yes ☐ No ☐

7. What methods are used to protect the pump and electrical wiring from vibrations? Torque arrestors ☐ Cable guards ☐ Other ☐

Motor

1. Horsepower 3/4

2. RPM 3450

3. Voltage 230

- a. 110 ☐
b. 220 ☒

Pitless Adapter

1. Make MARTINSON

2. Model # BPIUX

3. Depth 300'

Tank

1. Capacity 60

2. Pressure relief valve? ☒

Piping

1. Type POLYETHYLENE

2. Size 1

3. NSF and/or BOCA Code approved ☒

4. Depth of supply line 36'

Well data

1. Depth 300 ft.

2. Yield 10 GPM

3. Static water level ft.

4. Will water supply be disinfected by installer? YES

I understand that it is my responsibility to notify the Howard County Health Department when the installation is ready for inspection (otherwise this permit is null and void).

All information given above is true to the best of my knowledge.

Signature of Applicant: Bruce H. Gallup

Date: 3/11/92


3/26/92 OK TO COVER ROOFSIDE

Note: A sticker indicating approval/status of the installation will be placed on the well casing at the time of the inspection.

OK WORK

Wakefield Prop
Sect. 1 Area
Plat 3517

of Dr. Shao-Huang Chiu
Plat 5737

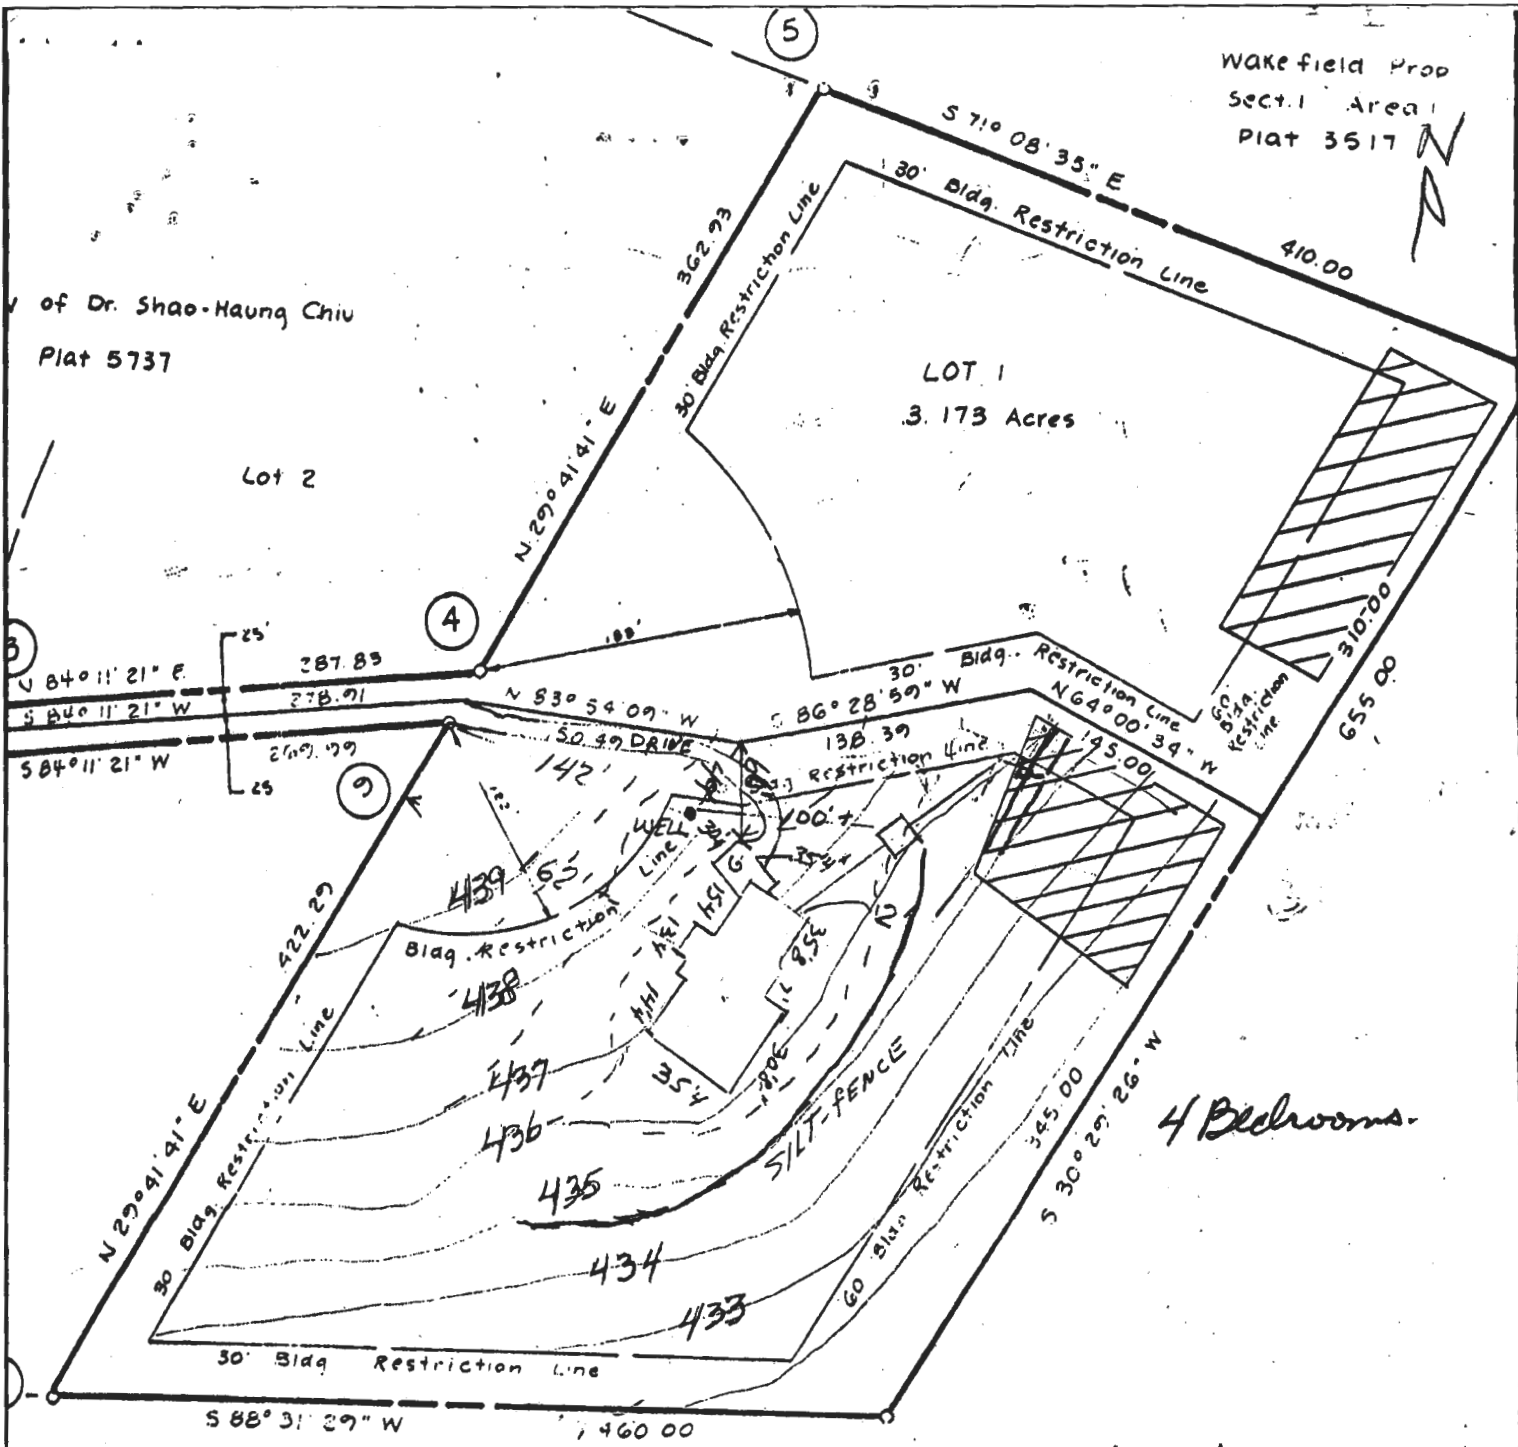

4 Bedrooms.

FF House	437.0
BASE	429.0
INV. EL.	435.5
TANK INV.	434.7
EXIST TANK FL.	436
Box INV. EL.	433
EXIST.	436
E. AT TEST	436
WELL EL.	438

6/28/91
REVISED PLANS OK
R HODGE

N 520,000

DANIEL BLAKE PROPERTY

LOT 2
P336

TAX MAP-22
ZONING

Owner:
D.G.B. Inc.
12190 Willowind Ct.
Ellington City, Ma. 01043
SCALE 1"=100'

144' Total Trenches

Daniel Blake

PROPERTY TO BE CONVEYED BY
WOODMARK INC.
 3rd ELEC. DISTRICT HO. CO., MD.
 JUNE 6, 1973 SCALE: 1"=100'

WILLOWIND. COURT
 50' WIDE R/W

R=497.00 L=300.57' 588°04'39"E 287.83'
 R=502.47 L=53.58' 25' WIDE R/W
 R=522.00 L=371.56' N88°04'39"W 270.00'

NOTE: The lot shown hereon complies with minimum ownership width and lot area as required by the Maryland State Department of Health Regulations.

APPROVED: For Private Water and Private Sewerage Systems,
 Howard County Health Department.


Michael M.D.
 County Health Officer

9/25/73
 Date

PURDUM & JESCHKE
 ENGINEERS
 LAND SURVEYORS
 3697 PARK AVE.
 ELLICOTT CITY, MD.



W. Purdum

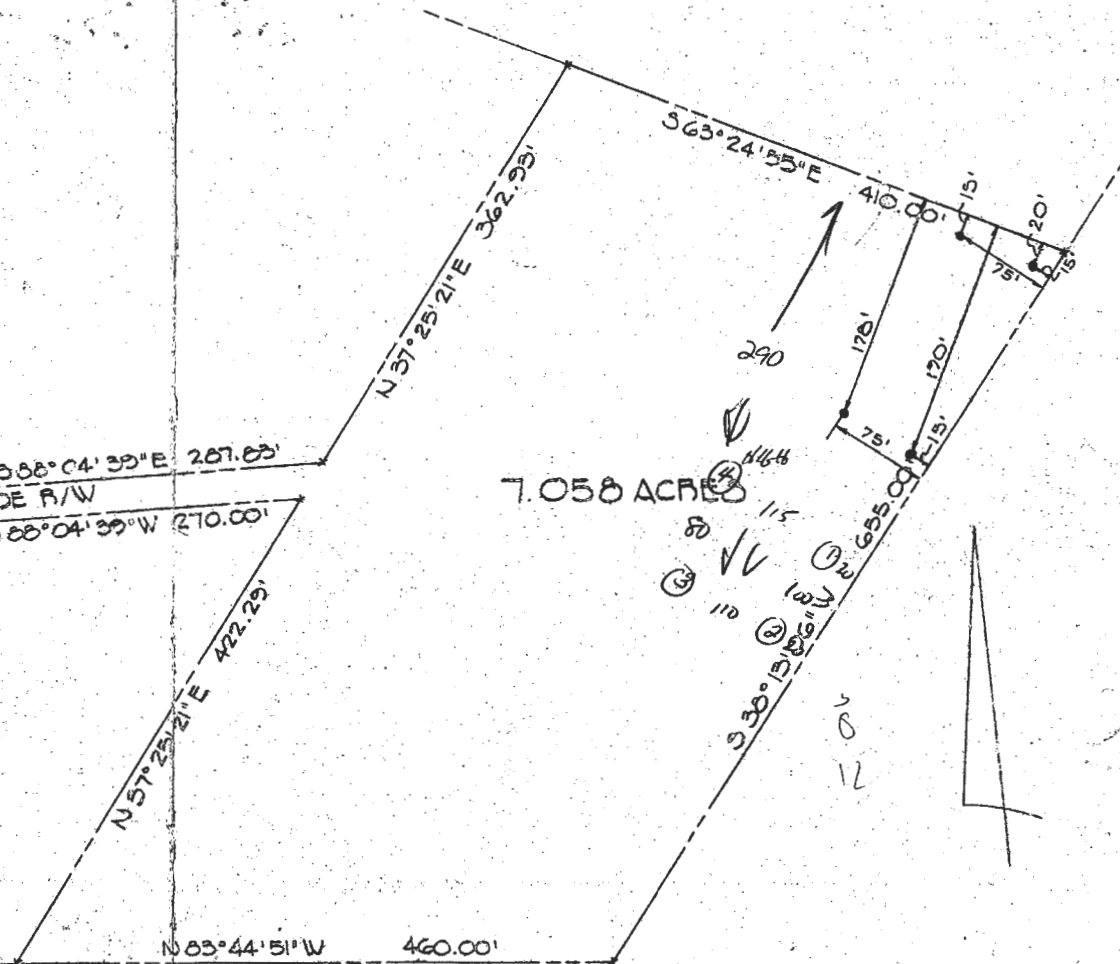



HOWARD COUNTY DEPARTMENT OF PLANNING AND ZONING
3430 Courthouse Drive ■ Ellicott City, Maryland 21043 ■ 410-313-2350

Marsha S. McLaughlin, Director

www.howardcountymd.us
FAX 410-313-3391
TDD 410-313-2323

May 7, 2013

Sandra L. Parlett
James D. Phillips
12190 Willowind Court
Ellicott City, MD 21042

RE: Accessory Apartment
12190 Willowind Court
Ellicott City, MD 21042

Dear: Ms. Parlett & Mr. Phillips:

In response to your amended Accessory Apartment Application, the following is provided for your information and use.

The subject property is zoned R-R (Rural Residential). The information you have provided indicates **compliance** with Sections 105.C.3 and 128.A.13 of the Howard County Zoning Regulations that regulate the creation and maintenance of accessory apartments. Please note that your accessory apartment must be maintained in compliance with the following regulations of Sections 105.C.3 and 128.A.13 including, but not limited to, the following:

1. The floor area of the apartment, including one-third of the floor area of any shared storage or utility areas, shall not occupy more than 40% of the net floor area of a dwelling with a net floor area of 2,000 square feet or less. For a dwelling larger than 2,000 square feet of net floor area, the apartment shall occupy no more than one-third of the net floor area, up to a maximum of 1,500 square feet.

Please note that Section 133.D of the Howard County Zoning Regulations requires a minimum of two off-street parking spaces for the residents of the subject property plus one additional parking space for the accessory apartment.

Additionally, please be advised, this approval is based on the building and architectural plans submitted to this Department. Any changes to those plans will require further review by this Department. Should you have any questions or need further information, please call me at 410-313-2350.

Sincerely,

Anthony N. LaRose,
Zoning Supervisor
Division of Public Service and
Zoning Administration

Enclosure
ANL:al

