

Chout
7/13/61

PERMIT

SEWAGE DISPOSAL SYSTEM

MARYLAND STATE DEPARTMENT OF HEALTH

HOWARD COUNTY

ELLICOTT CITY

DISTRICT 4

DATE 5/22/61

INDEXED

Walter S. Johnson

IS PERMITTED TO INSTALL X ALTER

ADDRESS 9150 Main St., Damascus, Md.

PHONE CLINTON 3427

A SEWAGE DISPOSAL SYSTEM LOCATED AT 18609 Windsor Forest Rd. - Rt. 40 to Long Corner Rd.

turn left about 2 miles back Long Corner Rd. to Windsor Forest Rd. right on it to house on left.

SUBDIVISION

ROAD

LOT

PROPERTY OWNER

Noore, Richard E.

ADDRESS

4207 Amundale Rd., Beltsville

SPECIFICATIONS

DRAIN FIELD DEPTH FEET. BOTTOM AREA SQ. FT.

SEEPAGE PITS X ABSORBENT SIDE WALL AREA SQ. FT.

SEPTIC TANK CAPACITY 1500 GALLONS

FOR GARBAGE GRINDER, INCREASE DISPOSAL AREA 25% & TANK CAPACITY 50%

OTHER Septic tank cannot be installed more than 3 feet below original grade.

PLANS APPROVED BY

Walter T. Loevy

DATE


4/21/61

FILL SEPTIC TANK AND DISTRIBUTION BOX WITH WATER BEFORE CALLING FOR AN INSPECTION. COVER NO WORK UNTIL INSPECTED AND APPROVED.

NEITHER THE HOWARD COUNTY COMMISSIONERS NOR THE HEALTH DEPARTMENT IS RESPONSIBLE FOR THE SUCCESSFUL OPERATION OF ANY SYSTEM.

103605

13
 3.1
 .13
 3.9
 403
 11
 403
 403
 1.4 3.3

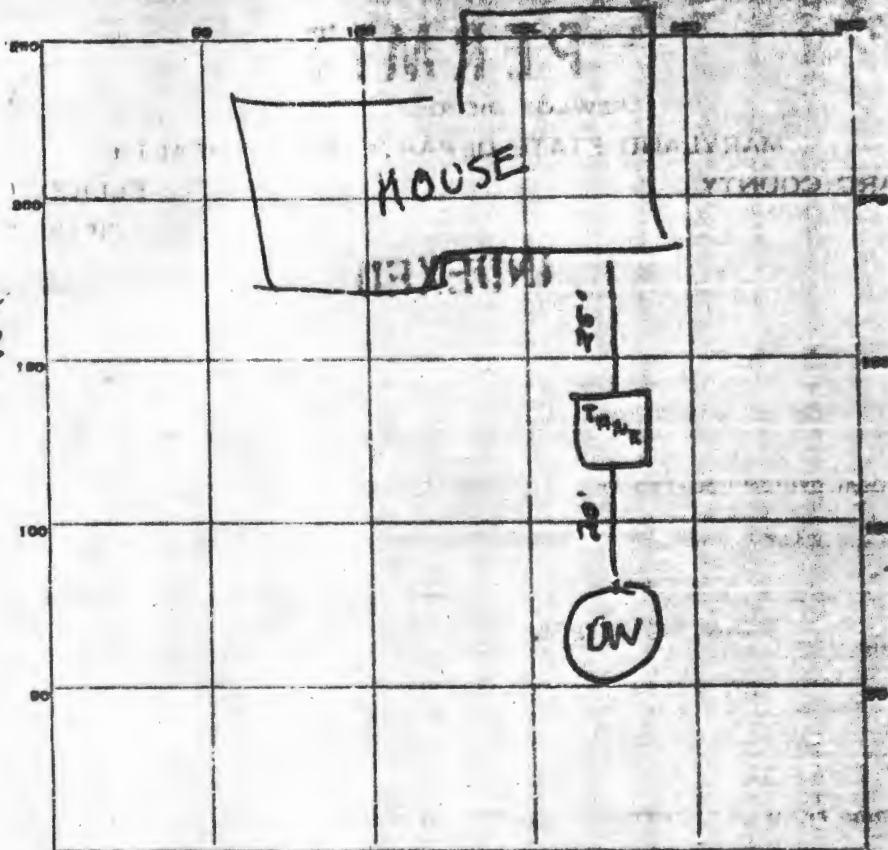

INDICATE NORTH. - NAME ADJOINING ROAD MAY BE BASE LINE.

PERMIT CARD ☒

SEPTIC TANK, LEVEL 1500 - concrete

CLEANOUT ☒

DISTRIBUTION BOX, LEVEL _____

TILE FIELD, DEPTH _____ FT. TRENCH WIDTH _____ FT.

GRAVEL DEPTH _____ IN. TOTAL LENGTH _____ FT.

NUMBER OF TRENCHES _____ TOTAL BOTTOM AREA _____

SEEPAGE PITS, INSIDE DIAMETER 13 FT. DEPTH BELOW INLET 11 FT.

ABSORBENT AREA 443 SQ. FT.


REMARKS

Dry well is about 112 S.F.

System is completed, but not approved by Howard County Health Dept.

DATE SYSTEM APPROVED Completed 7/13/61 INSPECTOR deery

98089/004/89-bnd.dwg

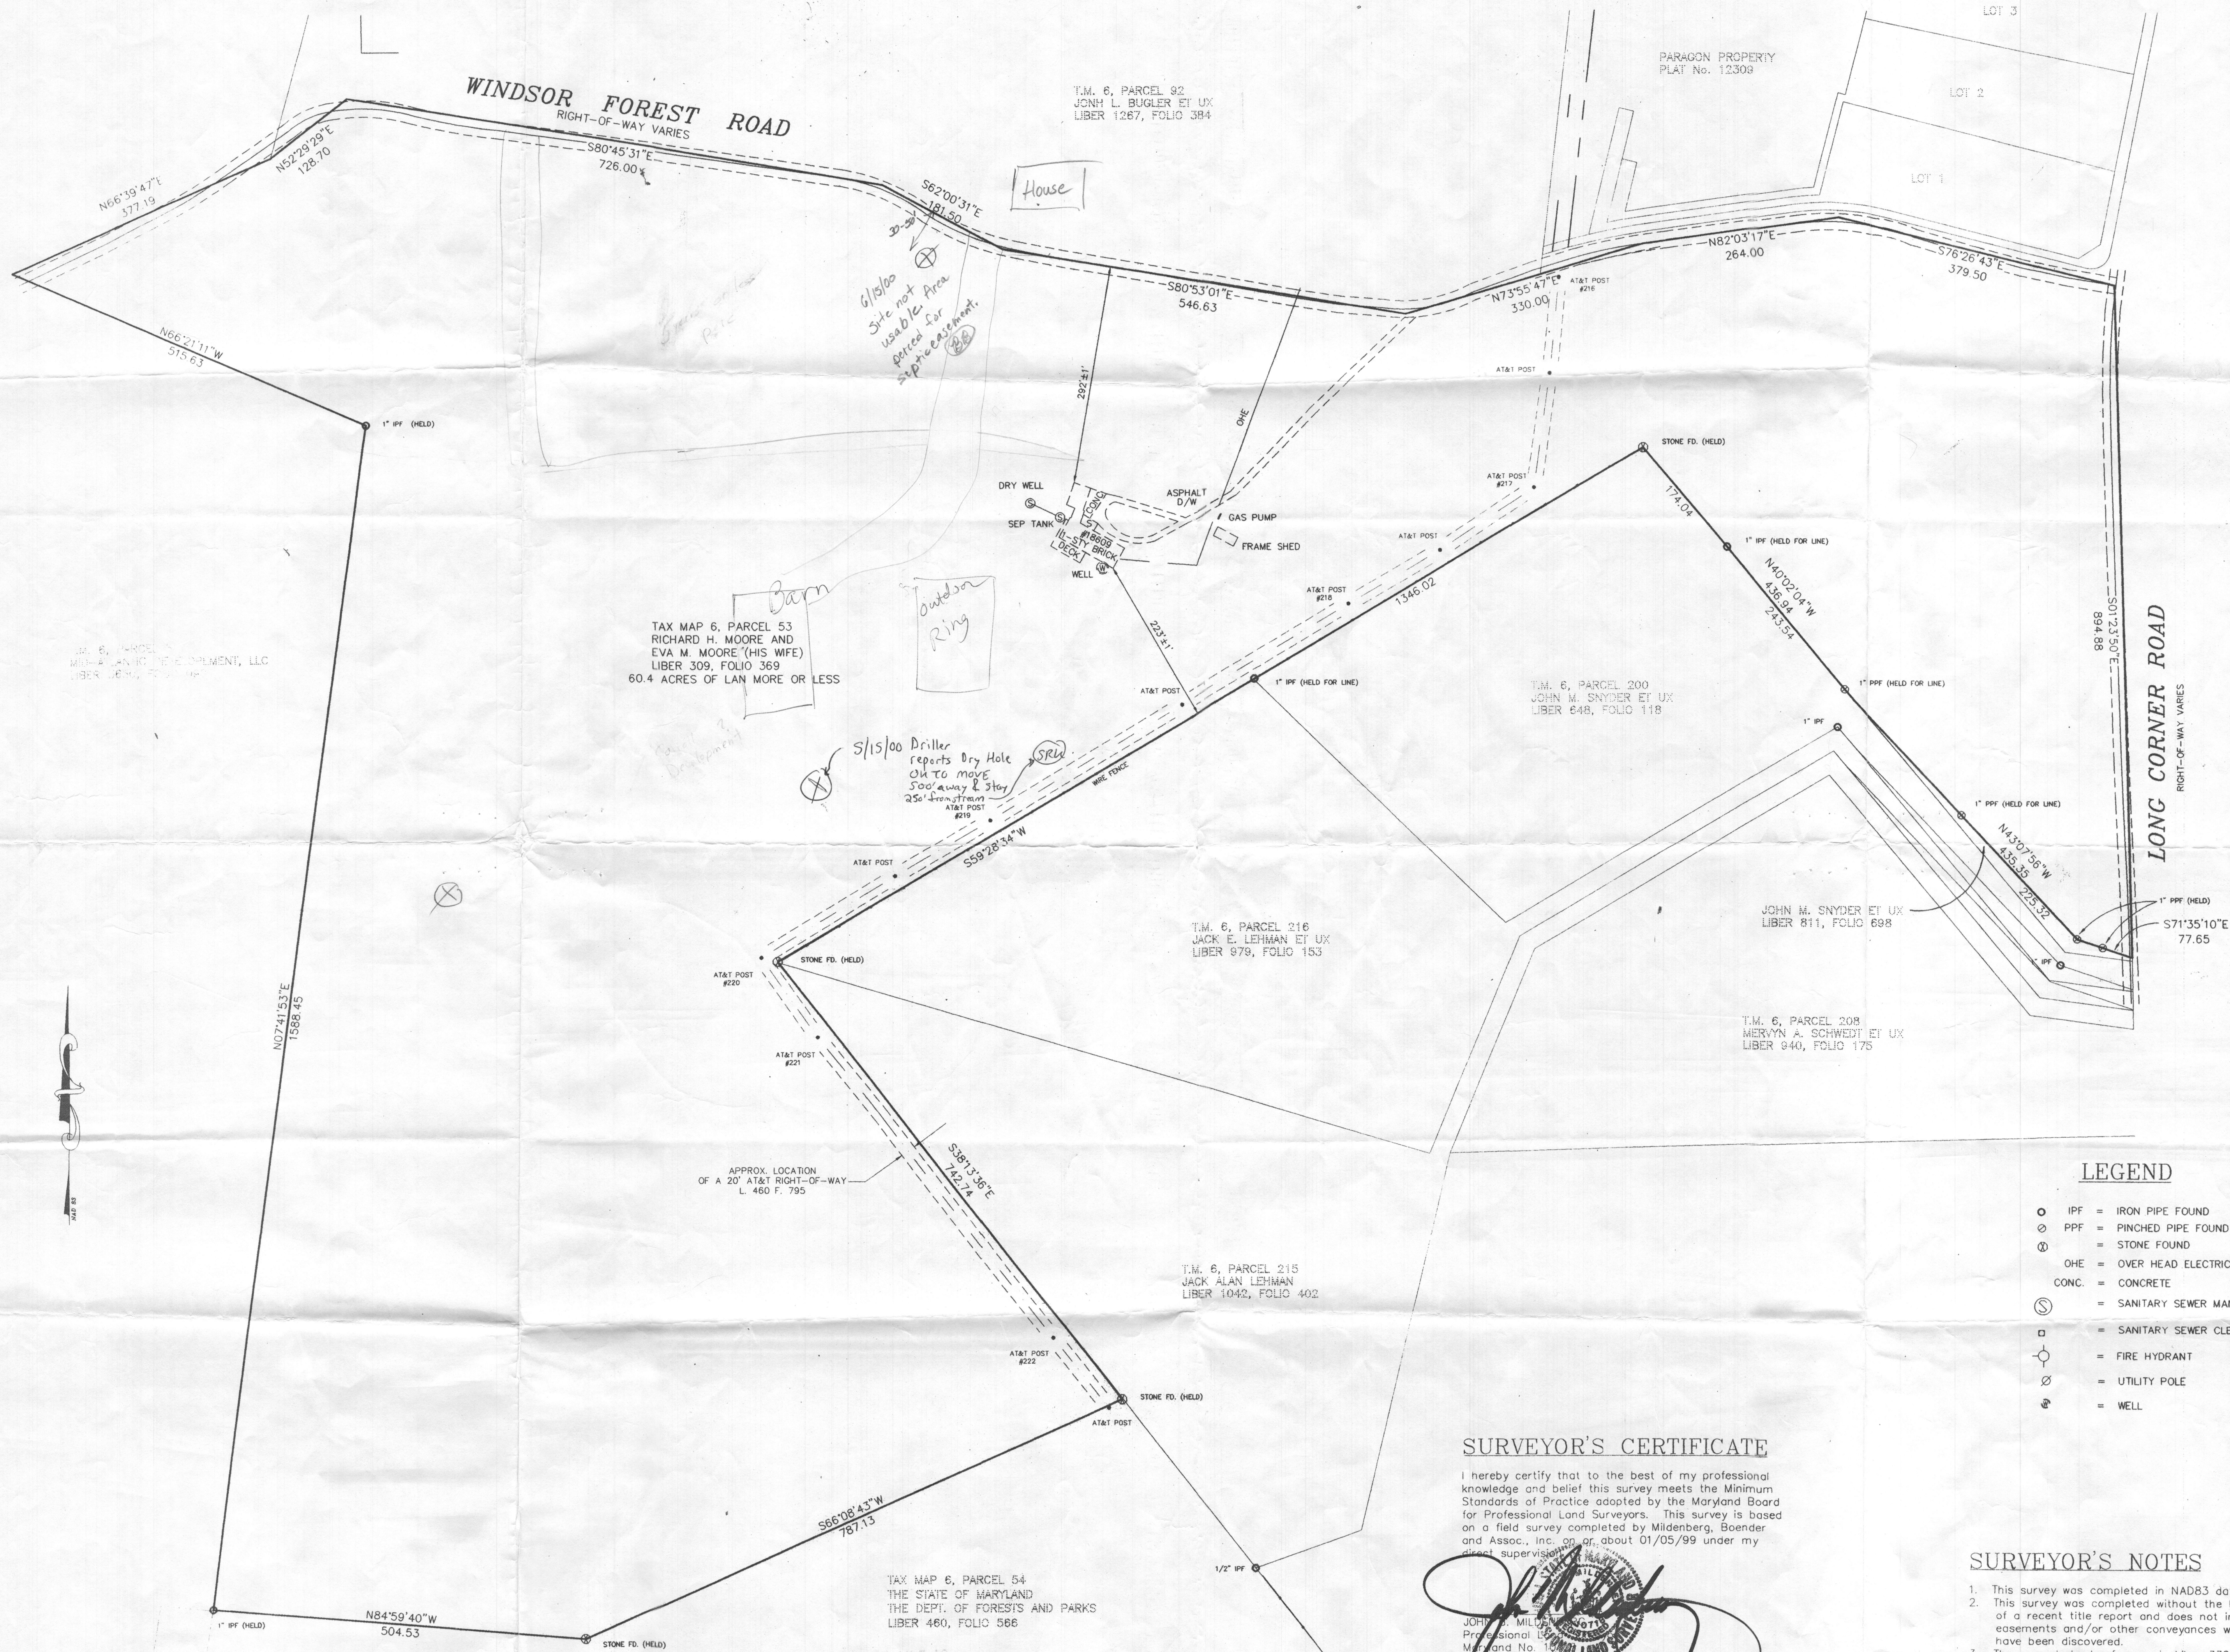

SURVEYOR'S CERTIFICATE

I hereby certify that to the best of my professional knowledge and belief this survey meets the Minimum Standards of Practice adopted by the Maryland Board for Professional Land Surveyors. This survey is based on a field survey completed by Mildenberg, Boender and Assoc., Inc. on or about 01/05/99 under my direct supervision.

JOHN A. MILDENBERG
Professional Land Surveyor
Maryland No. 10000

LEGEND

- IPF = IRON PIPE FOUND
- ⊗ PPF = PINCHED PIPE FOUND
- ⊙ = STONE FOUND
- OHE = OVER HEAD ELECTRIC LINES
- CONC. = CONCRETE
- ⊕ = SANITARY SEWER MAN HOLE
- ⊖ = SANITARY SEWER CLEAN OUT
- ⊙ = FIRE HYDRANT
- ⊙ = UTILITY POLE
- ⊙ = WELL

SURVEYOR'S NOTES

- This survey was completed in NAD83 datum.
- This survey was completed without the benefit of a recent title report and does not indicate easements and/or other conveyances which may have been discovered.
- The current deed reference is Liber 339, folio 369.

MILDENBERG, BOENDER & ASSOC., INC.
Engineers Planners Surveyors
5072 Dorsey Hall Drive, Suite 202, Ellicott City, Maryland 21042
(410) 997-0296 Fax (301) 621-5521 Wash. (410) 997-0298 Fax

MOORE PROPERTY
FIFTH ELECTION DISTRICT HOWARD COUNTY
BOUNDARY SURVEY

date	project	drawn by	scale	1" = 100'
01/05/99	98089	TMH	MS	approval
no.				revisions
				date