

APPLICATION

SEWAGE DISPOSAL TESTING

MARYLAND STATE DEPARTMENT OF HEALTH

HOWARD COUNTY

ELLICOTT CITY

SEPTIC TANK - 1500 gallon capacity for 5 bedrooms

DISTRICT 4

DRY WELL - 555 square feet of sidewalk area below

DATE 4-19-61

Builder: Walter S. Johnson *hus inlet,*
9150 Main St.,
Damascus, Md. - Clearwater 3-2203

TO: THE COUNTY HEALTH OFFICER
ELLICOTT CITY, MARYLAND

I, HEREBY, APPLY FOR THE NECESSARY TESTS IN ORDER TO CONSTRUCT (OR RECONSTRUCT) A SEWAGE DISPOSAL SYSTEM.

PROPERTY OWNER Moore, Richard H.

ADDRESS 4207 Annendale Rd., Beltsville

PHONE Wobster 5-5677

PROPERTY LOCATION:

SUBDIVISION

LOT NO.

ROAD AND DESCRIPTION Windsor Forest Rd. - Rt. 40 to Long Corner Rd. left about

2 miles back Long Corner Rd. to Windsor Forest Rd. right on W.F. Rd. 2nd house on left.

OCCUPANT

PHONE

PERSON TO CONSTRUCT SYSTEM

ADDRESS

PHONE

SIZE OF LOT

60 acres

TYPE BLDG.

5

NUMBER OF BEDROOMS

IF NOT SINGLE RESIDENCE DESCRIBE

SIGNATURE OF APPLICANT

Walter S. Johnson

APPROVED BY

Walter S. Johnson

FOR

DRY WELL

(KIND OF SYSTEM)

DATE

4/21/61

REJECTED BY

FOR

(KIND OF SYSTEM)


DATE

HOLD PENDING FURTHER TESTS

DATE

REASONS FOR REJECTION OR HOLDING

THIS IS NOT A PERMIT

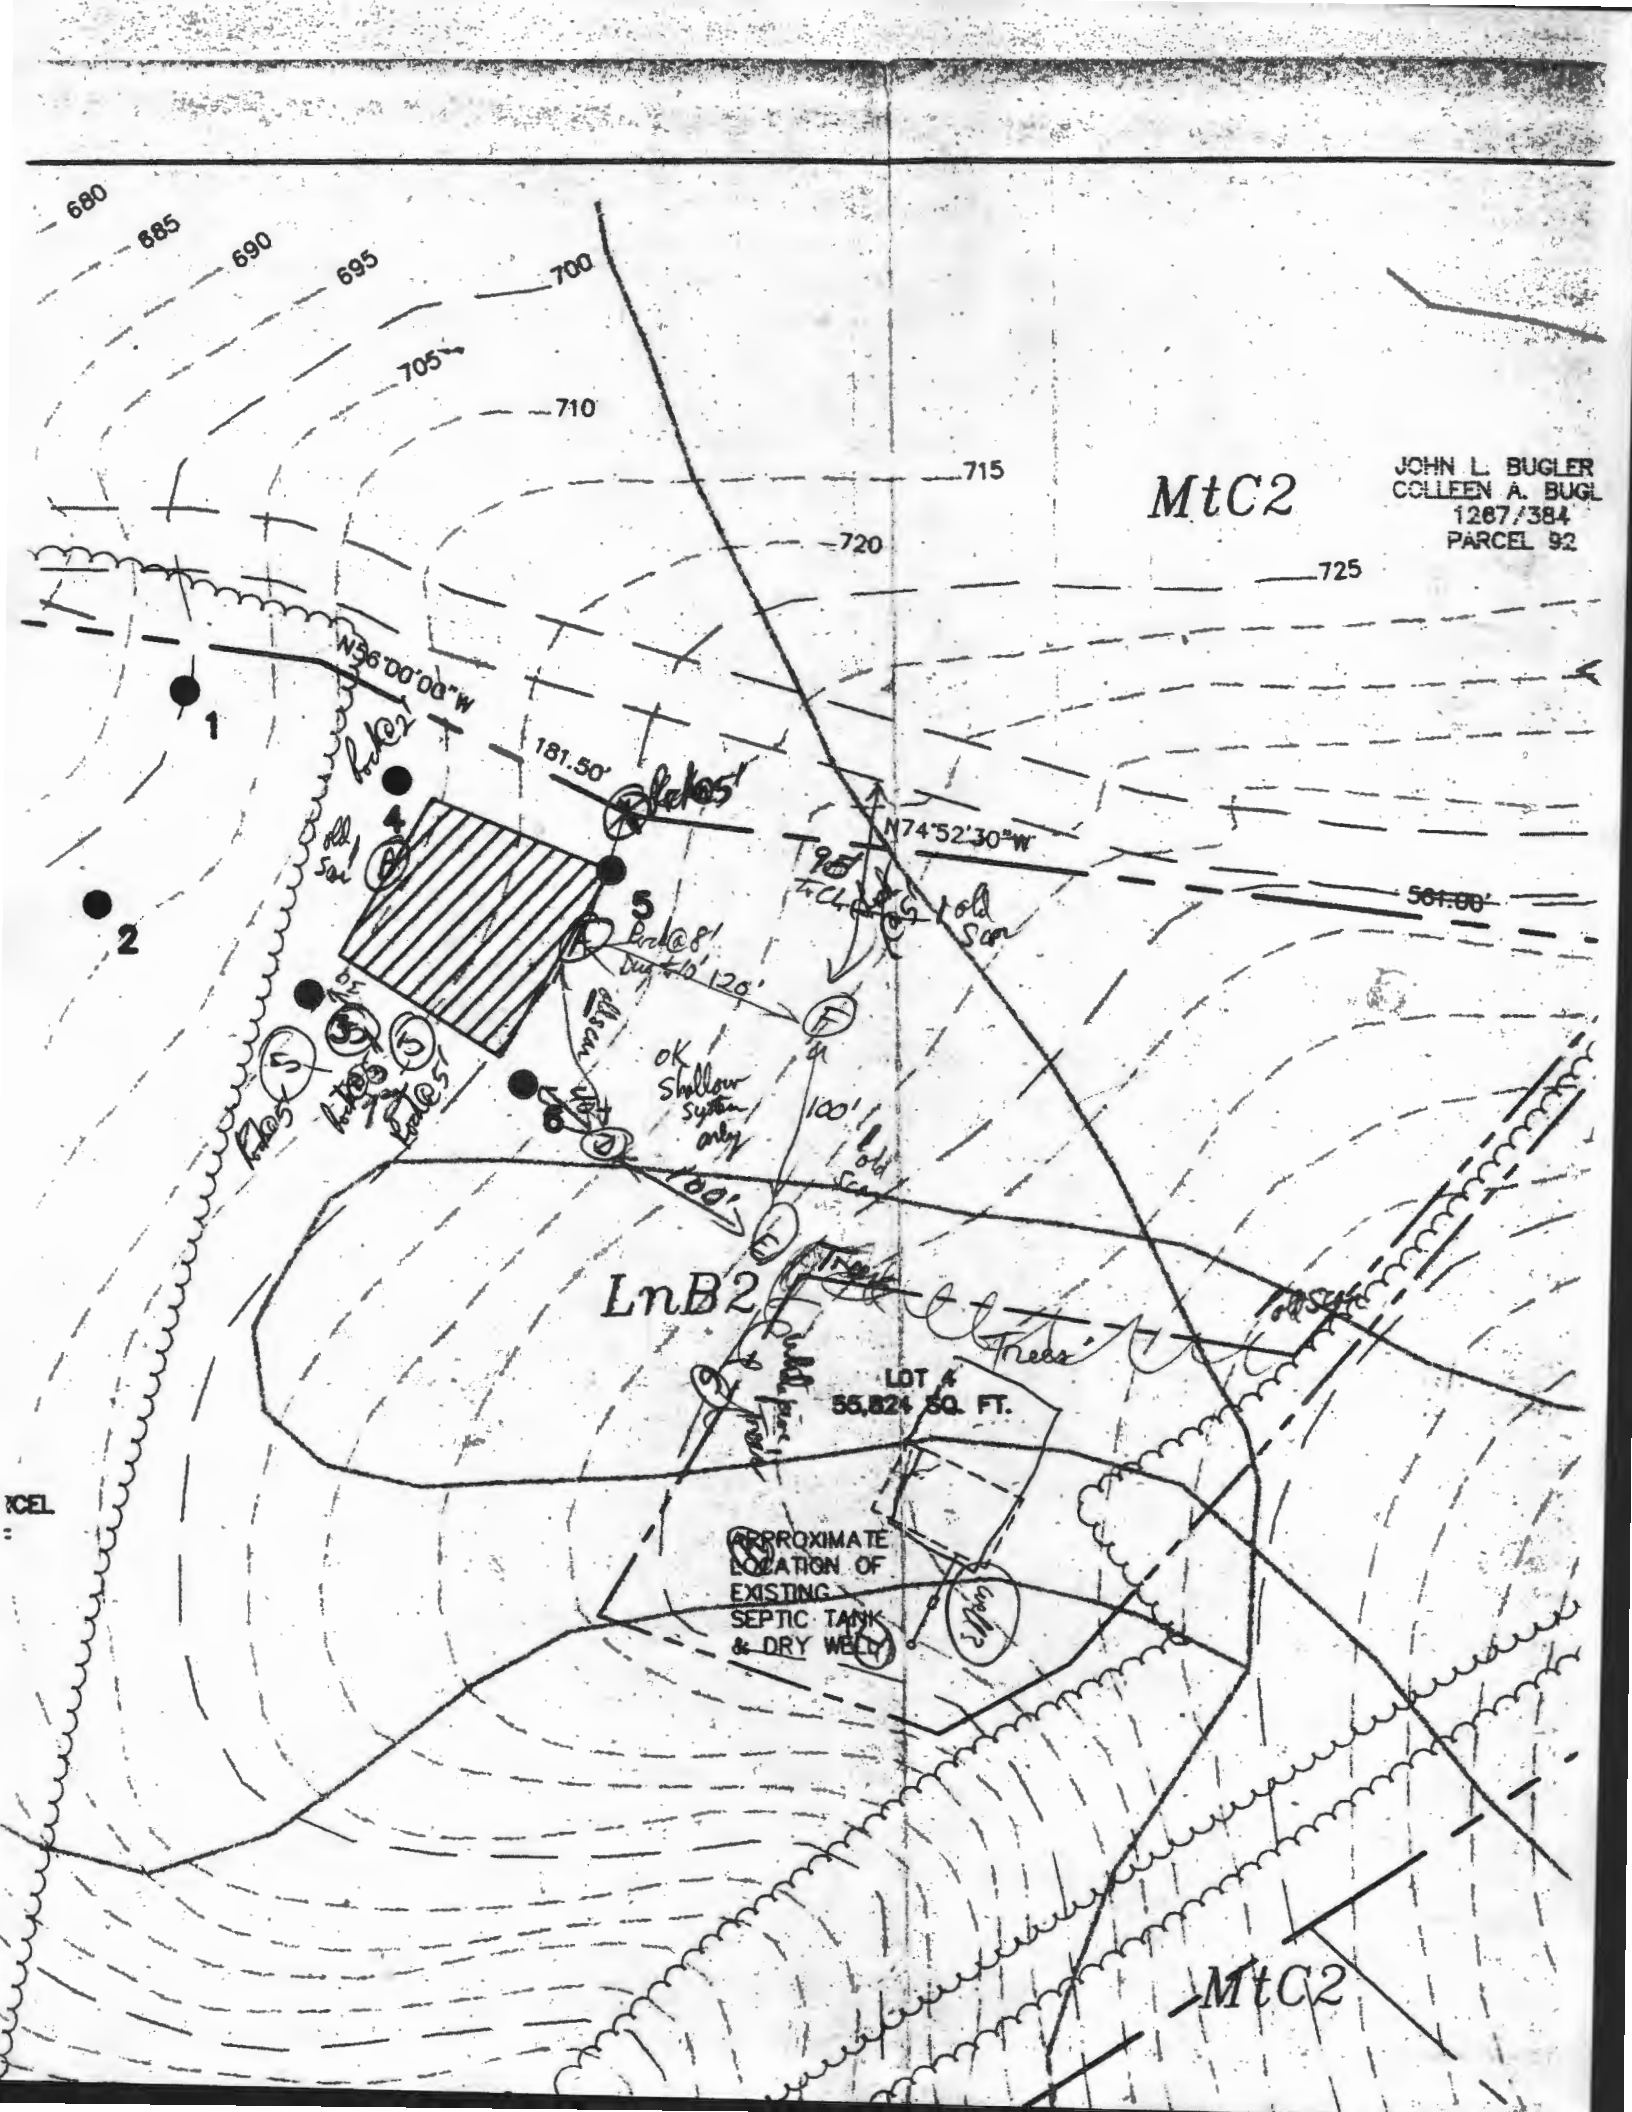

MtC2

JOHN L. BUGLER
COLLEEN A. BUGLER
1267/384
PARCEL 92

LnB2

LOT 4
55,824 SQ. FT.

APPROXIMATE
LOCATION OF
EXISTING
SEPTIC TANK
& DRY WELL

MtC2