

APPLICATION

A 17377

SEWAGE DISPOSAL TESTING

P _____

MARYLAND STATE DEPARTMENT OF HEALTH

HOWARD COUNTY

ELLICOTT CITY

DISTRICT 4

DATE 8/23/72

TO: THE COUNTY HEALTH OFFICER
ELLICOTT CITY, MARYLAND

I, HEREBY, APPLY FOR THE NECESSARY TESTS IN ORDER TO CONSTRUCT (OR RECONSTRUCT) A SEWAGE DISPOSAL SYSTEM.

PROPERTY OWNER Lafayette Jay White & wf.

ADDRESS Wentworth Road, Ellicott, Md. PHONE _____

PROPERTY LOCATION:

SUBDIVISION Ridgeway Subdivision LOT NO. 6

ROAD AND DESCRIPTION Undeveloped land - sign says Caten Realty Co.

OCCUPANT _____ PHONE _____

PERSON TO CONSTRUCT SYSTEM _____

ADDRESS _____ PHONE _____

SIZE OF LOT 1.000 acres TYPE BLDG. 1

NUMBER OF BEDROOMS
(Single Faly. Dvlg.)

IF NOT SINGLE RESIDENCE DESCRIBE _____

SIGNATURE OF APPLICANT Patricia Kelley


APPROVED BY _____ FOR _____ DATE _____

REJECTED BY C. Shuck FOR D. J. Hill DATE 9/8/72

HOLD PENDING FURTHER TESTS _____ DATE _____

REASONS FOR REJECTION OR HOLDING _____

THIS IS NOT A PERMIT

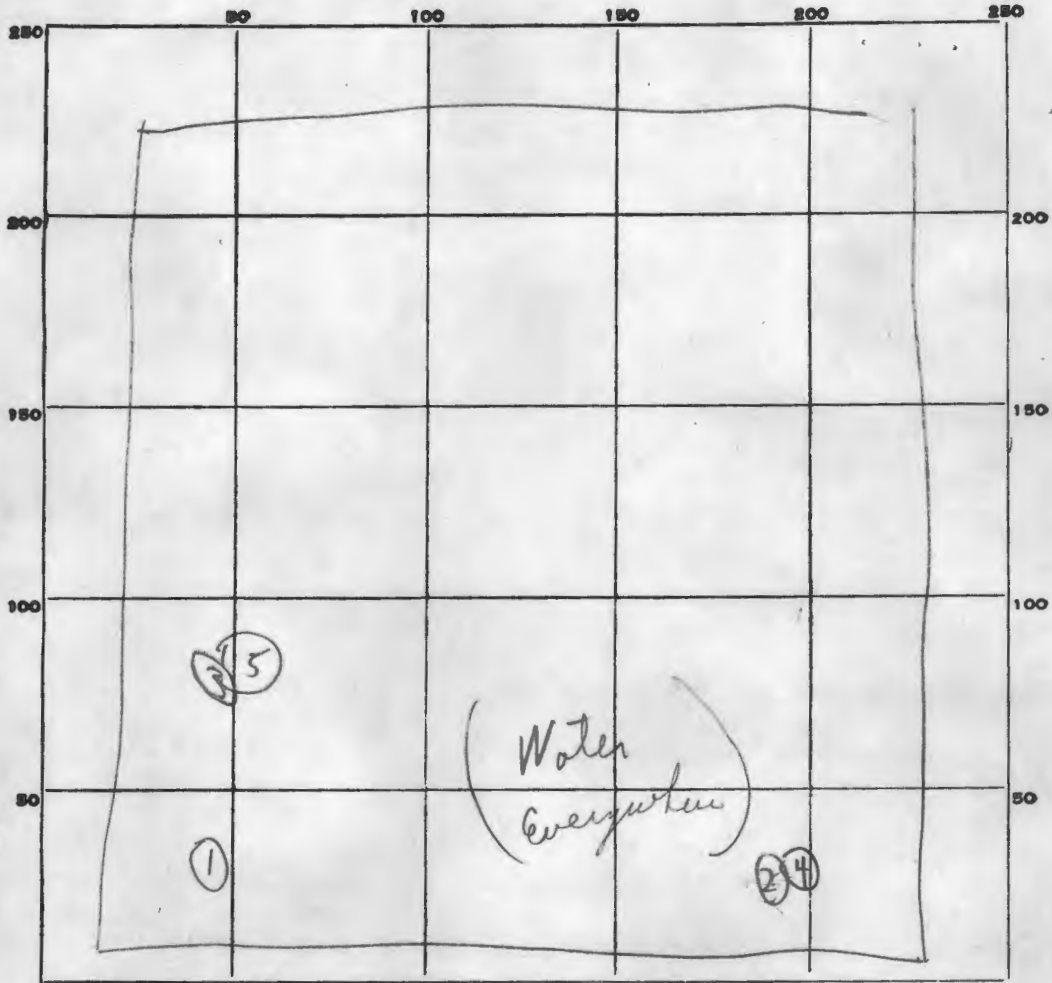

INDICATE NORTH. - NAME ADJOINING ROADWAY AS BASE LINE.

Underwood Road

DATE	TEST NO.	DEPTH	PRE-WET		TEST - 1" DROP		TIME
			START	STOP	START	STOP	
9/8/72	1 hole	7' to	water				} Top 4'-5' appears to be clay
	2 hole	10'	water				
	3 hole	10'	water				
	4	4'	7:57	10:07	10:07		Slow per
	5	3'	10:14				Ms. Rhine stated to forget test pull guys at 10:23
(9/8/72 Reject for dugwell system) C.S.D.							

SOIL AUGER FINDING

No test water at 7'

TESTED BY

B.S.

{ Reject lot for

As Tomina present, Mr. Rhine requested dry well tests for drain hills



REMARKS

Mr. Rhine requested dry well tests for drain hills

UNDERWOOD ROAD


Lot 7
Zacks
Hyman

Lot 5
Lower

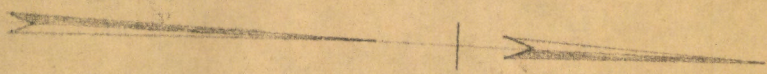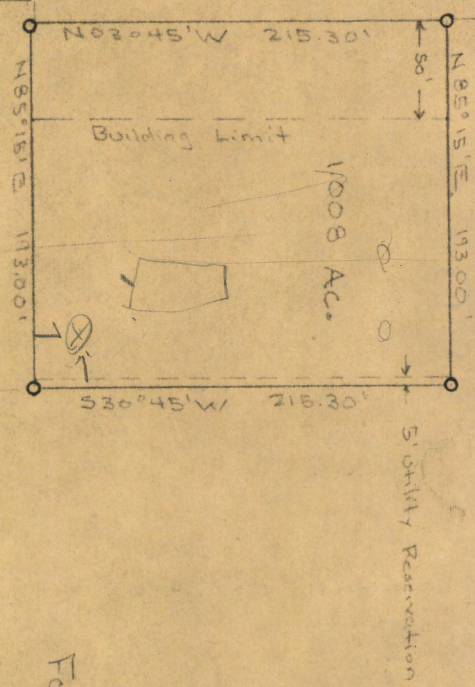


PLAT OF LOT No. 6
RIDGEMANS SUBDIVISION
FOURTH ELECTION DISTRICT OF HOWARD CO.
STYKESVILLE, MARYLAND
SCALE: 1 IN = 100 FT
AUGUST 22, 1972

Claude M. Skinner
Claude M. Skinner, Jr.
Reg. Professional Engineer
Land Surveyor No. 2287

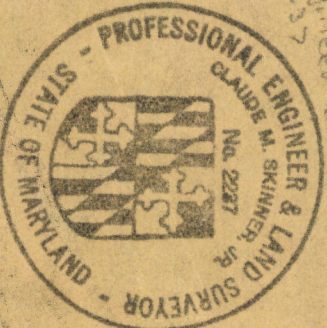

Report for Dry Well System

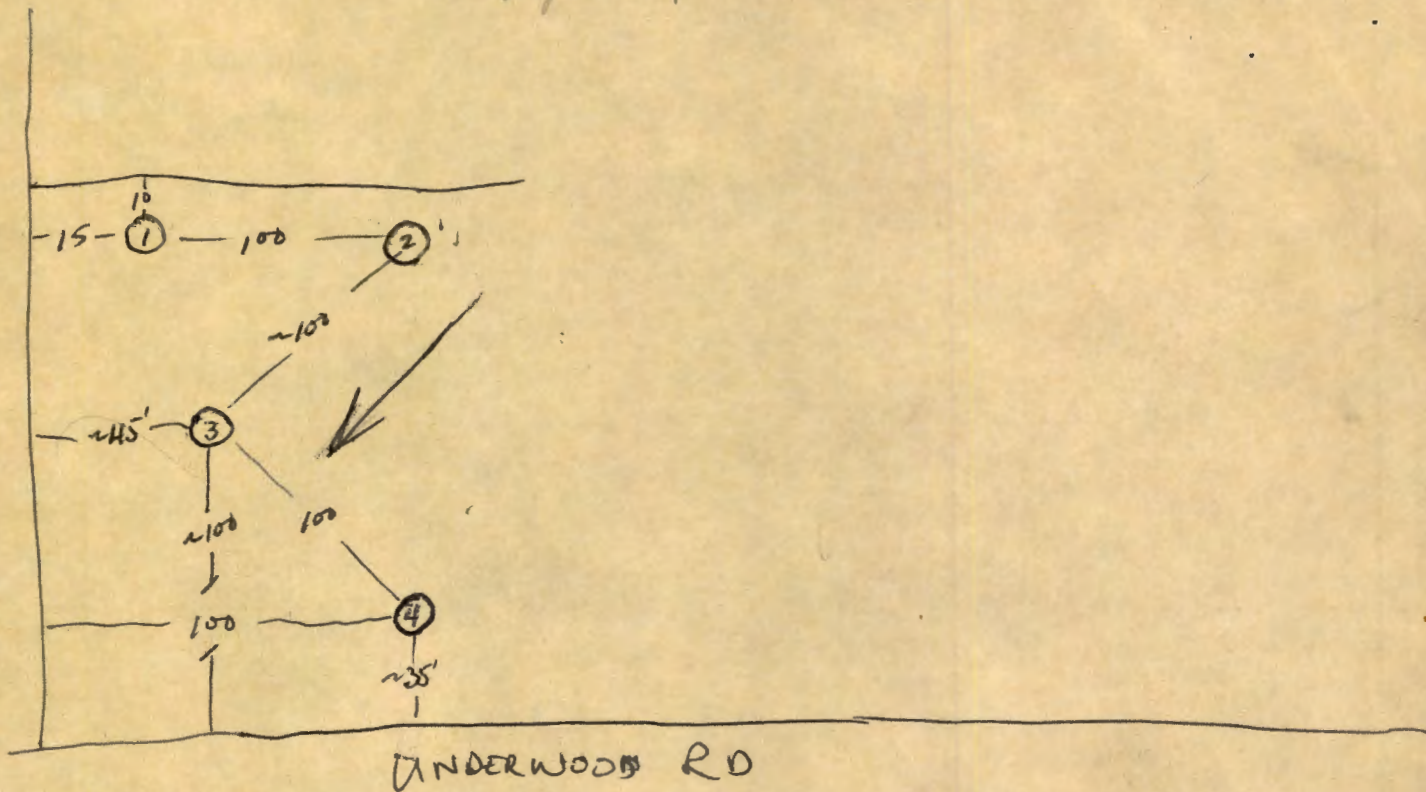

5/3/77

WW2

1	3 3/4'	2:30	FAILED 1" INCH			
1-A	10'	Water				
2	3 3/4'	2:53	3:04	3:04	3:30	26
2-A						
3	3 3/4'	3:16	3:25	3:25	3:42	17
3-A						
4	3 1/4'	3:26	3:53	3:53		
4-A						

December 12, 1977

Mr. Jack Beck
3110 Elmmede Road
Ellicott City, Md. 21043

Dear Mr. Beck:

This is to inform you that the property owned by you in the Ridgeway Subdivision, Lot 6, on Underwood Road and is 1.008 acres failed to pass the standard percolation test on September 8, 1972. Therefore, this land is non-buildable until public sewer becomes available.

Very truly yours,

Palmer F. Wine, Director
Environmental Health

PFW:dg