



HOWARD COUNTY HEALTH DEPARTMENT

64728

DATE
1/16/19

Received
From

Ivan B. Tabor

PHONE #

ps

☐ CASH
☒ CHECK

NO.

1466

For

Septic Repair: 1127 Taylor Park Road
Peric only!

One hundred sixty five


⁰⁰/₁₀₀
Dollars

\$

165 00

Received By

[Signature]

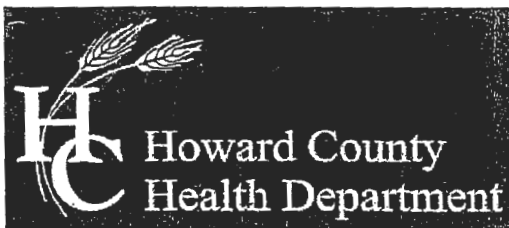

Bureau of Environmental Health

8930 Stanford Boulevard, Columbia, MD 21045

Main: 410-313-2640 | Fax: 410-313-2648

TDD 410-313-2323 | Toll Free 1-866-313-6300

www.hchealth.org

Facebook: www.facebook.com/hocohealth

Twitter: HowardCoHealthDep

Maura J. Rossman, M.D., Health Officer

APPLICATION

FOR PERCOLATION TESTING AND SITE EVALUATION

1504731

PROPERTY LOCATION

SUBDIVISION/PROPERTY NAME

PROPERTY ADDRESS 1127 Taylor Park Rd. Sykesville 21784
STREET TOWN ZIP

TAX ACCOUNT # 287998 TAX MAP 0009 GRID 0011 PARCEL 0111 LOT NO. 27 PROPOSED LOT SIZE (ACRES) 1.00 ACS
ZONING CATEGORY 3 TIER

PROPERTY OWNER(S) Ivan Inkman

DAYTIME PHONE 410-795-5670 CELL 443-398-6168 EMAIL

MAILING ADDRESS 1127 Taylor Park Rd. Sykesville, Md 21784
STREET CITY, STATE ZIP

APPLICANT Fogles Septic RELATIONSHIP TO OWNER: None

DAYTIME PHONE 410-795-5670 CELL EMAIL

MAILING ADDRESS 580 Obrecht Rd. Sykesville, Md 21784
STREET CITY, STATE ZIP

I HEREBY APPLY FOR THE NECESSARY TESTING/EVALUATION PRIOR TO ISSUANCE OF SEWAGE DISPOSAL SYSTEM PERMIT(S):

PROPERTY:

- ☐ SUBDIVISION: NUMBER OF LOTS INCLUDING RESIDUE: SUBDIVISION CLASSIFICATION (PER DEPT. OF PLANNING AND ZONING) ☐ MAJOR ☐ MINOR
- ☐ CONSTRUCT NEW OSDS ON UNDEVELOPED LOT
- ☒ REPAIR OR REPLACE FAILING OSDS
- ☐ UPGRADE EXISTING OSDS

BUILDING:

- ☐ RESIDENTIAL WITH 3 EXISTING OR PROPOSED BEDROOMS IN THE COMPLETED STRUCTURE
- ☐ COMMERCIAL (PROVIDE DETAIL OF TYPE OF USE AND NUMBERS OF EMPLOYEES/CUSTOMERS ON ACCOMPANYING PLAN)

IS THE PROPERTY WITHIN 2500 FEET OF ANY RESERVOIR?

- ☐ YES
- ☒ NO

AS APPLICANT, I UNDERSTAND THE FOLLOWING:

- THIS APPLICATION IS VALID FOR TWO(2) YEARS FROM DATE OF FEE PAYMENT AND APPROVAL IS BASED UPON HEALTH OFFICER SIGNATURE OF A PERC CERTIFICATION PLAN PRIOR TO EXPIRATION OF THIS PERMIT.
- THE APPLICATION FEE IS NON-REFUNDABLE
- THIS APPLICATION MUST BE ACCOMPANIED BY ALL APPLICABLE FEES AND A SUITABLE SITE PLAN IN ORDER TO BE PROCESSED
- THIS IS A PUBLIC DOCUMENT

I declare and affirm that to the best of my knowledge, the information contained herein is correct. I declare that I am the owner of the property or duly authorized to make this application on behalf of the owner. I agree to comply with all applicable state and county regulations.

By signature of this application, I hereby grant Howard County Health Department officials the right to enter onto the property for the purpose of inspecting the property as directly related to the requested permit/service.

** [Signature] **

SIGNATURE OF APPLICANT

1-17-19

DATE

A/P _____

0' A

hole unstable
caved in to
6' ~20mins
after digging

- water @ 4.5' SW side of hole

- water @ 5.5' NE side of hole

14' water

15'

B


brn loam mskbk roots

10' red brn cl loam mskbk roots, mica

3' lt brn/red brn sl weak platy many mica roots, Mn deposits

consistent ↓

14'

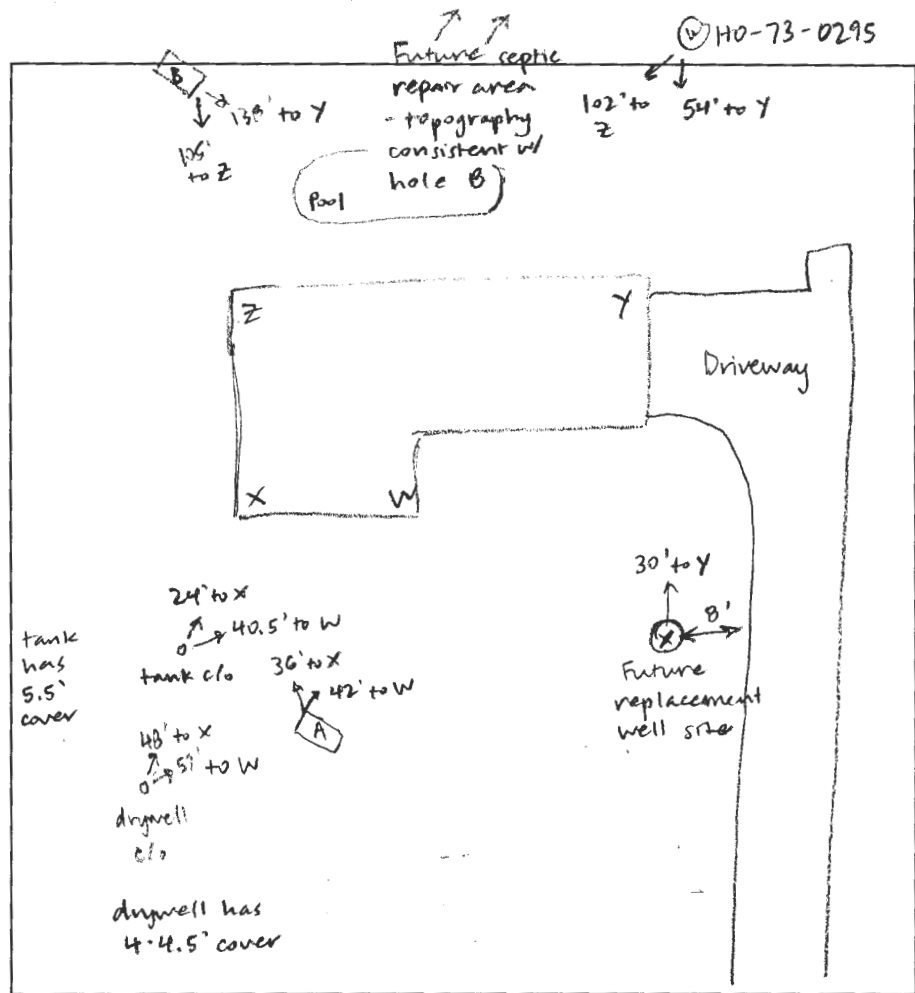

Taylor Park Rd.

| DATE | TEST # | DEPTH | START | BREAK 1" DROP | STOP 2" DROP | TIME OF 2ND INCH | P/F/H |
|---------|--------|---|-------|---------------|--------------|------------------|-------|
| 1/25/19 | B | 5' / 14' | 0:00 | 3:00 | 7:40 | 4:40 | P |
| | | H ₂ O poured at bottom ↳ may be slower rates deeper | | | | 20+ mins/inch | |
| | | | | | | | |
| | | | | | | | |
REMARKS _____

SANITARIAN Sarah Collins BACKHOE Ricky OTHERS Helper (Kevin), Ivan + David Intman

TEST HOLES USED IN SDA B AVG. PERC TIME 4:40 SQ. FT/BR 3 BR

TRENCH WIDTH 3' INLET DEPTH 3' MAX. BOT DEPTH 5' EFFECTIVE S/W _____

↳ could go as deep as 10' but need to check perc rates deeper

NOTICE OF VIOLATION

Posted at residence on 1/10/19

January 10, 2019

Ivan & Bonnie Inkman
1127 Taylor Park Road
Sykesville, MD 21784

RE: Sewage overflow, pollution of ground surface at 1127 Taylor Park Road

Dear Mr. and Mrs. Inkman,

The Health Department received a call from a neighbor saying that sewage from your property was seeping into his yard. On January 9, 2019 at approximately 1 pm, I made a site visit to 1127 Taylor Park Road and saw a saturated area of the yard coming from a pipe outfall in the northwest corner of the property. Liquid had run off into the driveway of the neighbor at 1121 Taylor Park Road. I spoke with the property owner, Mr. Inkman, and he showed me that the septic tank had been modified to have a pipe drain from the upper part of the tank to the surface when the liquid level gets high in the septic tank.

Be advised that the condition of sewage effluent emerging onto the soil surface is a violation of the Code of Maryland (COMAR) 26.04.02.02(E): "A person may not dispose of sewage, body, or industrial wastes in any manner which may cause pollution of the ground surface, the waters of the State, or create a nuisance." This condition is also in violation of the Howard County Code 3.804(a)(1), as a sewage overflow is defined as a nuisance, [12.110(a)]. It is the property owner's responsibility to maintain the onsite sewage disposal system so that an overflow does not occur until a repair can be performed.

You are hereby ordered to immediately pump and haul the contents of the sewage disposal system and treat the contaminated soil with hydrated lime. You will be responsible for continuing to pump the contents of the system at a frequency that prevents sewage effluent from coming to the ground surface. In addition, you must cap off the pipe from the septic tank that allows septic effluent to surface.

Furthermore, you must apply for a septic repair permit within seven (7) days of receiving this notice and the repair must be completed within fourteen (14) days of receiving this notice. Failure to comply will result in the issuance of a civil citation(s). Under Howard County Code, paragraph 12.112, each day this violation is allowed to occur is considered a separate offense.

Maura J. Rossman, M.D., Health Officer

If you believe that the condition described above is not and could not be a hazard to health, or that the Health Department is not acting in compliance with pertinent laws and regulations, you may request a formal hearing before the Board of Health within 15 (fifteen) days of receipt of this letter. All requests are to be made in writing and directed to the Executive Secretary of the Board of Health at the above address.

If you have any questions regarding this letter, please contact me at 410-313-1771.

Sincerely,



Sarah Collins, L.E.H.S.
Howard County Health Department
Well & Septic Program
SCollins@howardcountymd.gov
410-313-6287

Cc: File

LETTER OF ADVISEMENT

January 30, 2019

Ivan & Bonnie Inkman
1127 Taylor Park Road
Sykesville, MD 21784

RE: Sewage overflow, pollution of ground surface at 1127 Taylor Park Road

Dear Mr. and Mrs. Inkman,


The Health Department issued a Notice of Violation on January 10, 2019 for sewage overflow and the pollution of the ground surface at 1127 Taylor Park Road. (see attached)

Several requirements of the Notice of Violation have been completed. The tank was pumped by Fogle's Septic Clean on January 18, 2019 and the Health Department received a copy of the receipt. The pipe from the septic tank that allowed sewage to drain to the ground surface has been capped and no additional sewage has leaked from it. Hydrated lime has been spread over the sewage in the yard and in the neighbor's driveway. Fogle's also completed percolation tests with the Health Department on January 25, 2019 and an area was found for a replacement septic system. You have paid for a percolation testing and site evaluation and Fogle's paid for a permit for a septic repair.

The septic system is still considered to be failing and has the potential to create a sewage overflow. You must continue to pump the tank and prevent sewage from overflowing to the ground surface until the repair installation has been completed. Be advised that the Health Department may issue a citation for any sewage observed on the ground surface and each day the violation is allowed to occur is considered a separate offense.

If you have any questions regarding this letter, please contact me at 410-313-1771.

Sincerely,



Sarah Collins, L.E.H.S.
Howard County Health Department
Well & Septic Program

Cc: File

Fogle's Septic Clean, Inc.
580 Obrecht Road
Sykesville, MD 21784
410-795-5670

FOGLE'S

WORK ORDER

Date

1/18/2019

JOB LOCATION

IVAN INKMAN
1127 TAYLOR PARK RD
SYKESVILLE, MD 21784

BILLING INFORMATION

IVAN INKMAN
1127 TAYLOR PARK RD
SYKESVILLE, MD 21784

Customer Phone

443-266-7162

Customer Alt. Phone

A finance charge of 1.5% will be charged monthly on unpaid balances.
And any actual and reasonable collection fees may be added if delinquent.
There is a \$25 fee for a returned check.

We are not responsible for your cleanout cap if we break it when we remove it. We are not responsible for any damages to your driveway.

Description

Qty

Cost

Total

PUMP SEPTIC - CALL AHEAD!!

185.00

185.00

TANK - FRONT LEFT
PUMP FROM ROAD
C.O.D.

32 - River Road - Right on Howard Lodge - go 1 block - left Taylor Park
and Second
house on right

PERC TEST SCHEDULED FOR 1/24/19 10AM

TANK ACCESS

Manhole: Y ☐ N ☒
Cleanout: Y ☒ N ☐

Tank Depth 4'

TANK LEVEL

☒ Normal
☐ Overfull
☐ Low

TANK CONDITION

☒ Good
☒ Heavy Solids
☐ Roots
☐ Wipes ☐ Other:

TO ENSURE PROPER CLEANING, FOGLE'S SEPTIC RECOMMENDS
PUMPING FROM THE MANHOLE AND NOT THE 6" CLEANOUT

CALL OFFICE TO SCHEDULE:

☐ Snake Inlet line ☐ Other:
☐ Snake outlet line

Thank you for your business.

Harry

Total

\$185.00

Customer Signature: _____

FOGLE'S

Septic Clean, Inc.

410-795-5670

580 Obrecht Rd. • Sykesville, MD 21784
410-795-5670

www.foglesseptic.com

Portable Toilets • Backhoe Service • Percolation Tests • Septic Line Cleaning
Pump Septic Tank & Drywells • New Installations • Repair Systems

Bill To Ivan Inkman
Address 1127 Taylor Park Rd
City Sykesville
Job Name _____
Location _____
Work Ordered By _____

DATE OF ORDER _____
ORDER TAKEN BY _____
SCHEDULE FOR: ☐ Morning ☐ Afternoon
Job Phone _____
Mobile Phone 443 266 7162
Home Phone _____

| Work Order | Actual Work | DESCRIPTION OF WORK | | | | |
|------------|-------------|---|--|--|--|--------|
| ✓ | | Pump Septic & Back Flush <u>C/O Front Left</u> | | | | 200.00 |
| | | Pump Drywell | | | | |
| | | Pump Grease Trap | | | | |
| ✓ | | Emergency Fee <u>Plays</u> | | | | 125.00 |
| | | Locating System | | | | |
| | | Hand Digging | | | | |
| | | Mini-Excavator <u>System Failing</u> | | | | |
| | | Hand Snaking | | | | |
| | | Electric Snaking | | | | |
| | | Service Call | | | | |
| | | Gallons Removed <u>Pump from road</u> | | | | |
| | | Do we have permission to use driveway <input type="checkbox"/> Yes <input checked="" type="checkbox"/> No | | | | |
| | | We are not responsible for your cleanout cap if we break it when we remove it | | | | |
| | | We are not responsible for any damage to your driveway | | | | |

☐ No One Home Date Completed: 12-22-18 Done By: [Signature]

Signature: _____

Thereby acknowledge the satisfactory completion of the above described work.

| | | |
|---|--|--|
| TANK ACCESS Manhole: Y <input checked="" type="checkbox"/> N <input type="checkbox"/> Cleanout: Y <input type="checkbox"/> N <input checked="" type="checkbox"/> Tank Depth: <u>4 1/2</u> | TANK LEVEL Normal <input type="checkbox"/> Overflow <input checked="" type="checkbox"/> Low <input type="checkbox"/> | TANK CONDITION Good <input checked="" type="checkbox"/> Heavy Solids <input type="checkbox"/> Roots <input type="checkbox"/> Wipes <input type="checkbox"/> Other: _____ |
| TO ENSURE PROPER CLEANING, FOGLE'S SEPTIC RECOMMENDS PUMPING FROM THE MANHOLE AND NOT THE 6" CLEANOUT | | |

NET 30 DAYS

A finance charge of 1.5% will be charged monthly on unpaid balances. And any actual and reasonable collection fees may be added if delinquent. There is a \$25.00 fee for a returned check. PRICES SUBJECT TO CHANGE.

Ivan 443-266-7162

410-746-1704 (cell)

SITE INSPECTION SHEET

JAMES (CALLER-NEIGHBOR)

OWNER: INKMAN / IVAN BONNIE PHONE #: 443 266 7310


ADDRESS: 1127 TAYLOR PARK RD CONTRACTOR: N/A

SYKESVILLE MD 21784 WELL TAG #: H0-73-0295

SUBDIVISION: RIVER PARK LOT: 27 COUNTY #:

PROPOSAL: INVESTIGATE SEPTIC SYSTEM FAILURE

LOCATION DIAGRAM

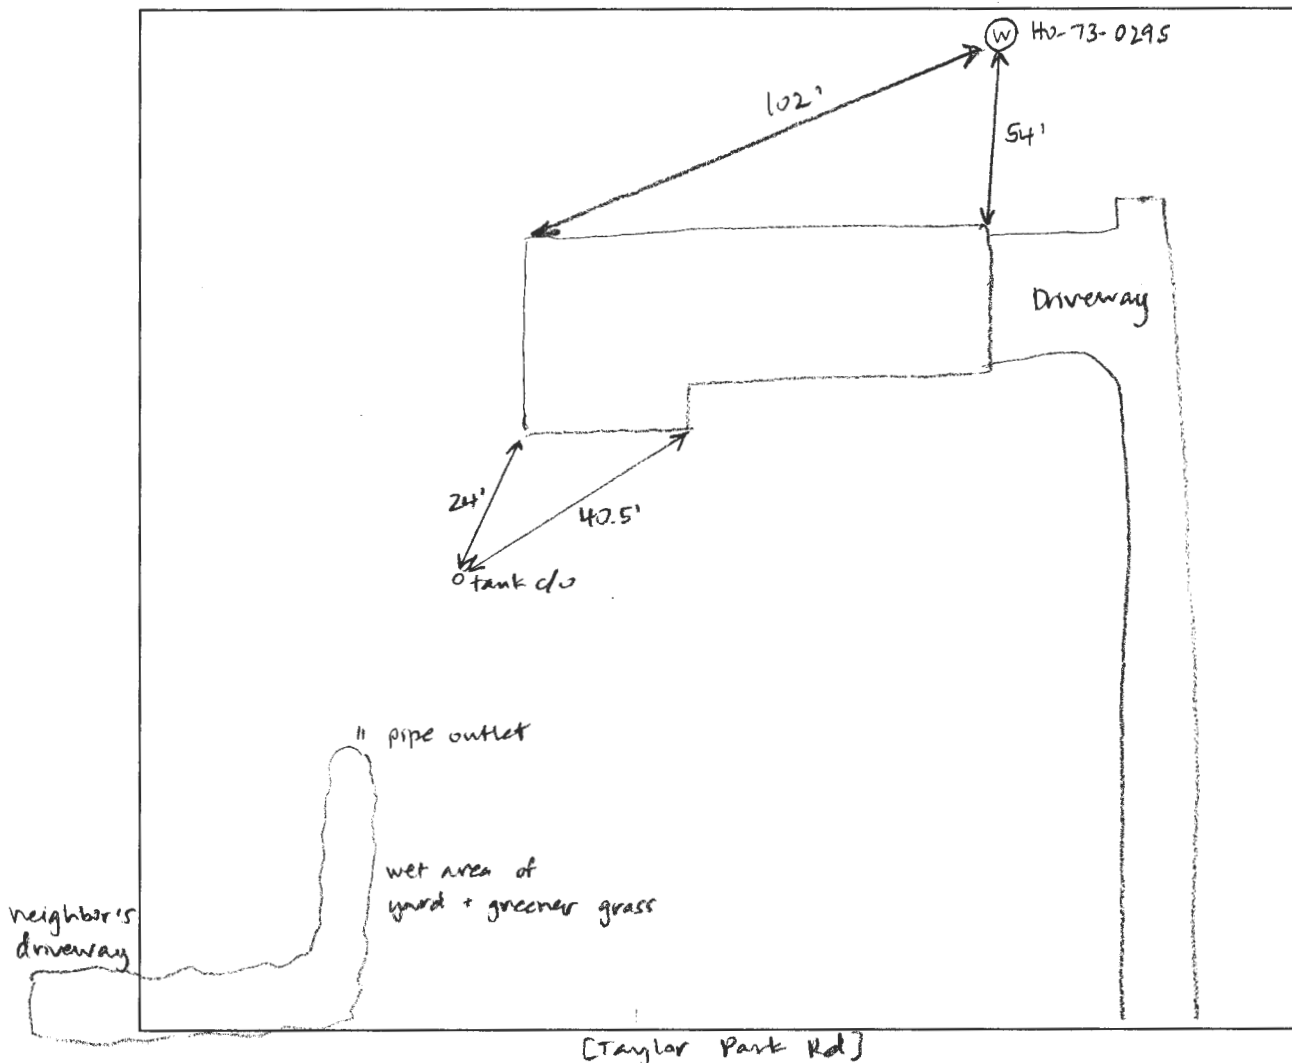

COMMENTS: Site visit ~ 1:30 pm. Area of yard is wet, no odor. Ivan Inkman
showed me a pipe he modified to drain effluent to the ground when liquid
level in septic tank rises.

DATE: 01/08/2019

INSPECTOR: Sarah Collins

FILE INQUIRY NOTES

| DATE | RESULTS OF REVIEW FOR FILE |
|---------|--|
| 1/9/19 | Made a site visit to 1127 Taylor Park Rd. to investigate a complaint. A neighbor said that sewage from the yard at 1127 Taylor Park Rd. is leaking into his yard. The front left corner of the property is wet and the grass is greener. No odor in wet area. Liquid seeping into driveway I spoke with the homeowner, Ivan, and he said that he installed a pipe off the septic tank to allow effluent to drain to the surface when the liquid level in the tank gets high. He shined a light into the tank and I could see the pipe leaving the tank. I can't tell exactly where the pipe is connected, may be a riser. Wet area + green grass originates from where pipe surfaces at ground. I told Ivan he would need to take care of the raw sewage and apply for a septic repair permit (SC) |
| 1/10/19 | Delivered an NOV to Ivan ~ 11 am. Told him that he needs to pump his tank, cap off pipe, spread hydrated lime over sewage in his and his neighbor's yard. He also must apply for a septic repair permit within 7 days and complete the repair within 14 days. Also gave him a list of septic contractors that work in Howard. (SC) |
| 1/11/19 | (~9:30 am) Site visit to see if items listed in NOV have been completed. Outlet of pipe is uncovered, no cap added. No additional liquid seems to have come from pipe (SC) |
| 1/11/19 | (~12:30 pm) Received a call from Ivan. He said he added a cap to the pipe and had purchased a bag of hydrated lime. He didn't |

FILE INQUIRY NOTES

[illegible]

Collins, Sarah

From: Oswald, Hank
Sent: Tuesday, January 08, 2019 2:56 PM
To: Wolf, Kevin
Cc: Cabahug, Joseph; Collins, Sarah
Subject: Failing Septic_1127 Taylor Park Road

Hi Kevin:

I received a call about a failing septic located at 1127 Taylor Park Road in Sykesville. The caller indicated that "its leaking into other peoples yards including his own". The callers' name is James. His # is 443.266.7310.

Thanks,

Hank

Hank Oswald
Licensed Environmental Health Specialist
Howard County Health Department
Bureau of Environmental Health
Well & Septic Program
8930 Stanford Boulevard
Columbia, MD 21045
410.313.1786 (Office)
hoswald@howardcountymd.gov

CONFIDENTIALITY NOTICE

This message and the accompanying documents are intended only for the use of the individual or entity to which they are addressed and may contain information that is privileged, confidential, or exempt from disclosure under applicable law. If the reader of this email is not the intended recipient, you are hereby notified that you are strictly prohibited from reading, disseminating, distributing, or copying this communication. If you have received this email in error, please notify the sender immediately and destroy the original transmission.