


A. 39203

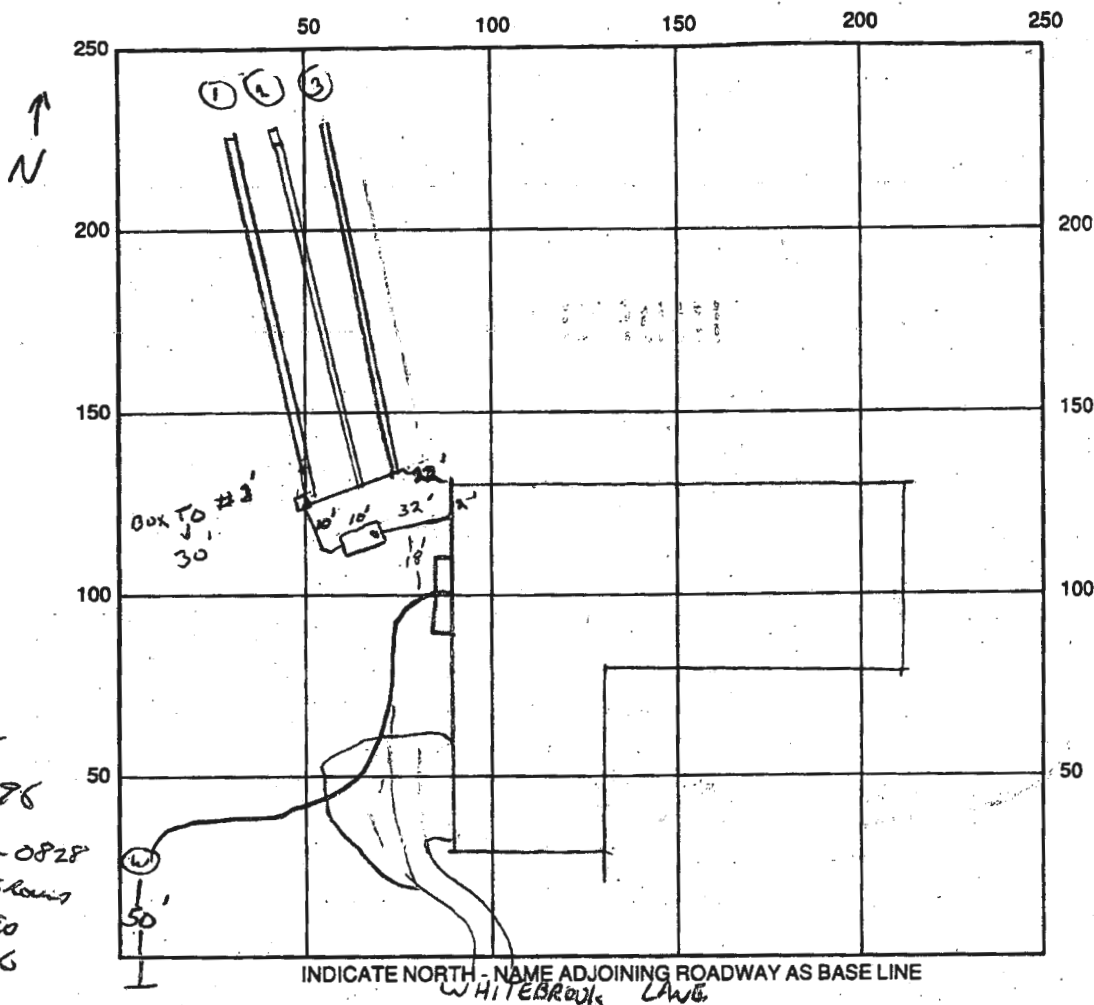

WPI
11-8-96
OK
HO-88-0828
NEEDS GRASS
ATTACHED
TO CALLING

SEPTIC TANK LEVEL OK

CLEANOUTS 1 ON TANK

DISTRIBUTION BOX LEVEL OK

DRAIN FIELD/TITLE DEPTH 5.5-6 FT.

TRENCH WIDTH 3 FT.

INLET DEPTH 3.5 FT.

EFFECTIVE GRAVEL DEPTH 2.5 FT.

TOTAL LENGTH 1, 2, 3
75/75/75 FT. = 285'

NUMBER OF TRENCHES 3

ONE SIDEWALL/BOTTOM AREA 755' SQ. FT.

DRYWALL INSIDE DIAMETER — FT.

EFFECTIVE DEPTH BELOW INLET — FT.

ABSORBENT AREA — SQ. FT.

REMARKS: 11/6/96 OK TO COVER SYSTEM, NEEDS HOUSE CONNECTION

FOR FINAL 11-8-96 HOUSE CONNECTION OK.

DATE SYSTEM APPROVED

11/8/96

INSPECTOR


[Signature]

I wish to resive my ~~current~~ ^{Septic System Plan} septic easement
as shown in red ~~to the proposed easement~~
as shown in ~~black~~ ^{red}.

Approved Septic System Plan
Howard County Health Department

By copy of this approved
plan the Health Dept
accepts the proposed
modifications to the septic
easement.

Blah Blah sign
9-4-76 date

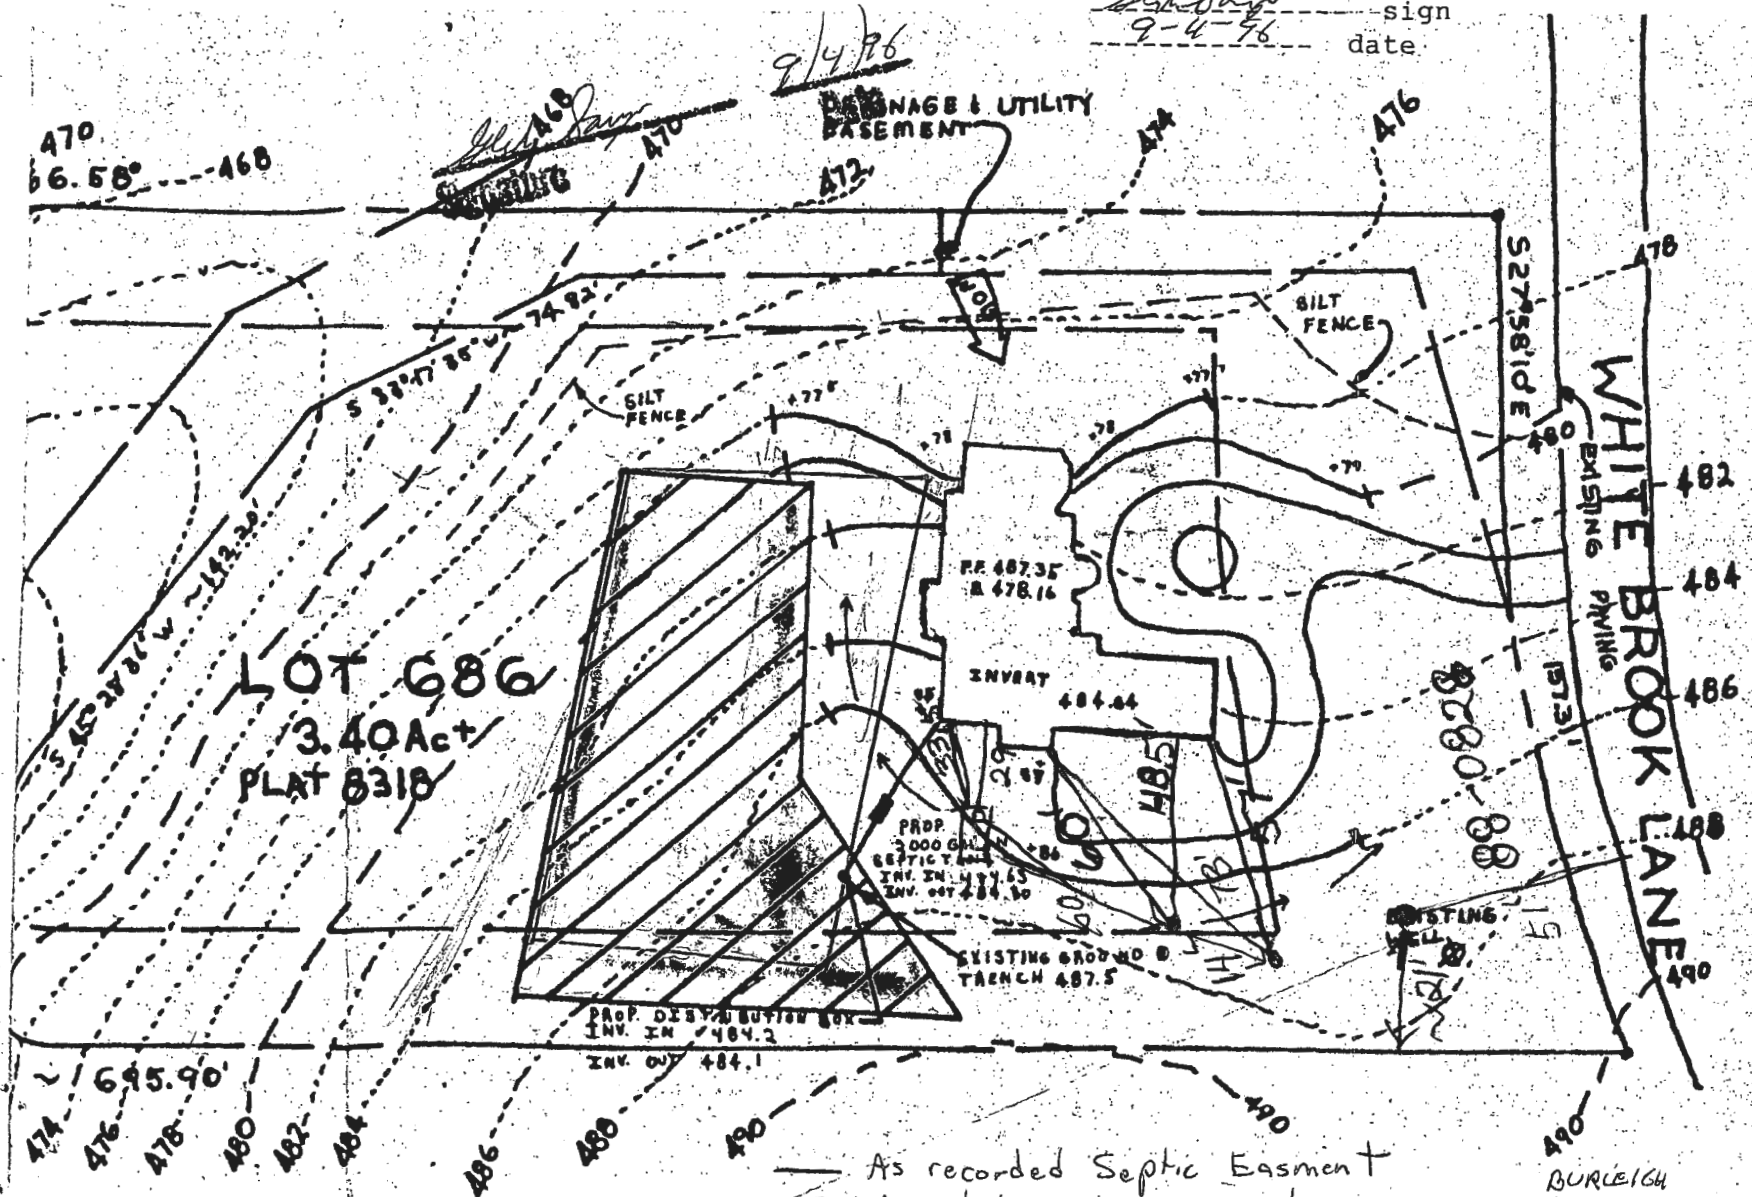

REDUCE BY FOR 1:50 SCALE

As recorded Septic Easement
Amended Septic Easement

BURLEIGH
MANOR
LOT 686

Scale 1"=50'

50' (1" = 25')

WHITE BROOK LANE

NOTE:

- DISTANCE**
1. POOL TO SEPTIC FIELD 10' 0"
 2. POOL TO SEPTIC TANK 50'
 3. POOL TO PROPERTY LINE 60' SIDE
 4. FILTER PAD 40' TO PROPERTY LINE

SPENCE

DRAINAGE UTILITY EASEMENT

FILTER SYSTEM

pool to be adjusted in field to meet minimum requirement from septic field

1-2-97
Pool location to be adjusted in field (see note) OK to proceed
ALM

0.09 = 11

ULTIMATE PLAN

- 1. Since the ultimate is a security drawing subject to the house
- 2. Provide for better pool/landscape plan

CURRENT FIELD NEW FIELD

"Full channels as indicated in the form steps outline in options I-IV"

