

DATE PM

AM
6/15/84

Approved

A. Jacobson

6-15-84

PERMIT

P 33991

A 33172

SEWAGE DISPOSAL SYSTEM

MARYLAND STATE DEPARTMENT OF HEALTH

HOWARD COUNTY

BUREAU OF ENVIRONMENTAL HEALTH
992-2330

04-343220
INDEXED

ELLICOTT CITY

DISTRICT 5th.

PAST Howard & Roxbury, SIGN ON RIGHT, HOUSE IN WOODS,

DATE 6/12/84

Mike Kastner

IS PERMITTED TO INSTALL ☒ ALTER

ADDRESS 13556 Argo Drive, Dayton, MD 21036 PHONE 725-5000

SUBDIVISION Woodpoint ROAD 14920 Triadelphia Road LOT 2

PROPERTY OWNER Gary W. Briggs PHONE: 596-9204

3505 Orion Drive

ADDRESS Dayton, Maryland 21036

IF GARBAGE GRINDER IS USED INCREASE SEPTIC TANK CAPACITY BY 50% AND ABSORPTION AREA BY 22%.

GARBAGE GRINDER? YES NO ☒

SEPTIC TANK CAPACITY 1000 GALLONS NUMBER OF BEDROOMS 3

DRY WELL OR DRY WELL AND TRENCH - 125 sq. ft per bedroom. Inlet 3 feet below original grade. Bottom maximum depth 10 feet below original grade. Effective area begins at 3 feet below original grade. NOTE: If trench is used to make up absorbent area, run the trench on level ground and leave a 5 foot earth buffer between dry well and trench. No trench is to exceed 100 feet in length. Trench inlet to be same as dry well, with 7 feet of stone below distribution pipe. LOCATION: Start the ditch or place the dry well at a point 260 feet from the front lot line and 70 feet from the left lot line as seen when facing the lot from Triadelphia Road, Run the trench toward the right side of the lot as seen when facing the lot from Triadelphia Road.

PLANS APPROVED BY Frank Skinner DATE 1/19/84

COVER NO WORK UNTIL INSPECTED AND APPROVED.

NEITHER THE HOWARD COUNTY COUNCIL NOR THE HEALTH DEPARTMENT IS RESPONSIBLE FOR THE SUCCESSFUL OPERATION OF ANY SYSTEM.

NOTE: IF TRENCH IS USED CALL FOR INSPECTION BEFORE AND AFTER PLACING GRAVEL IN TRENCH.

NOTE: NO DRY WELL SHALL EXCEED 15 FOOT IN DIAMETER. NO ABSORPTION TRENCH TO EXCEED 100 FEET IN LENGTH.

NOTE: ALL PIPE FROM HOUSE TO SEPTIC TANK MUST BE CAST IRON OR SCHEDULE 40 PVC OR ABS.

PERMIT VOID AFTER THREE YEARS.


NOTE: INSTALL STAND PIPE ON SEPTIC TANK AND DRY WELL. STAND PIPES MUST BE 6 INCHES IN DIAMETER. CAST IRON, CONCRETE OR TERRA COTTA, OR PVC OR ABS ACCEPTED. IF TOP OF SEPTIC TANK IS DEEPER THAN 3 FEET MANHOLE TO GRADE REQUIRED.

*INSTALLER IS RESPONSIBLE FOR OBTAINING FINAL APPROVAL ON THIS PERMIT

*CALL 992-2330 FOR INSPECTION OF SEPTIC SYSTEMS.

EH - 2-1082

A 33172

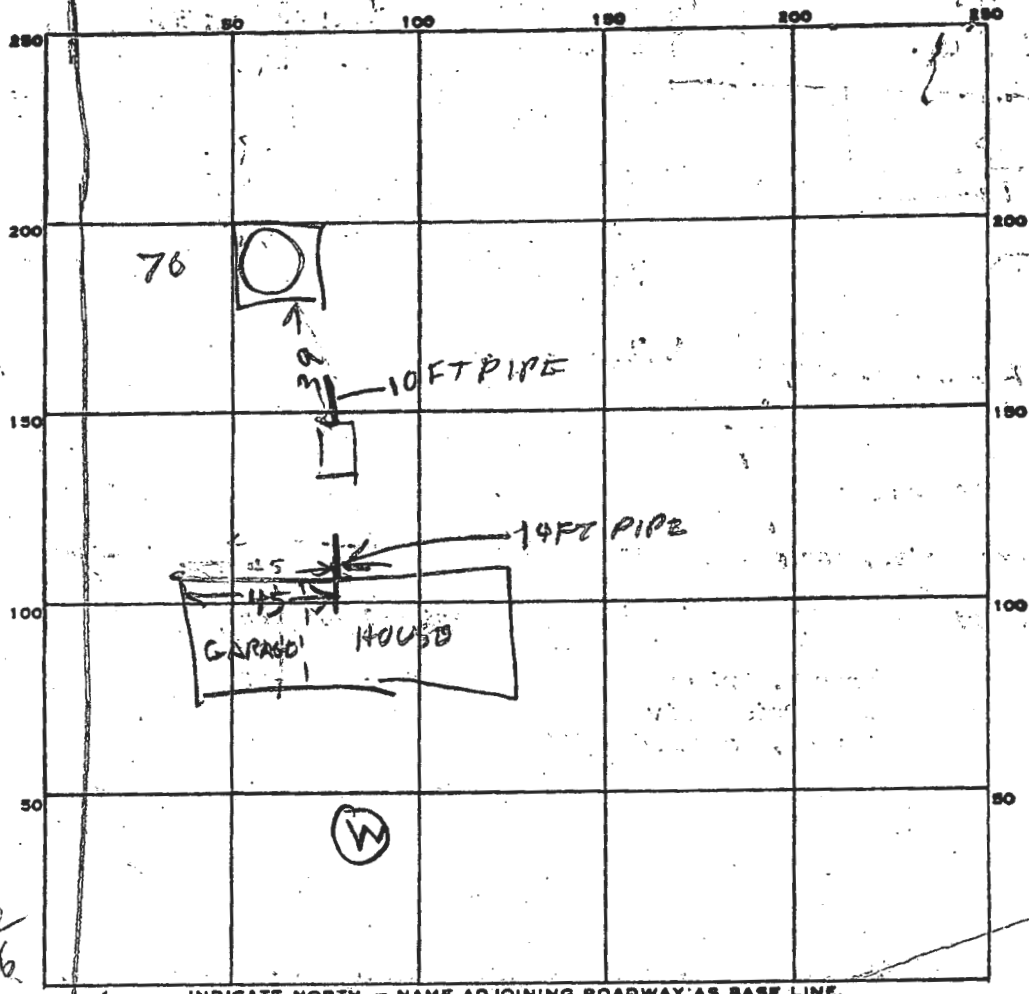

INDICATE NORTH. - NAME ADJOINING ROADWAY AS BASE LINE.

TRINDELPHIA RD

PERMIT CARD ☒

ST. DW.

SEPTIC TANK, LEVEL OK

CLEANOUTS

OK OK

DISTRIBUTION BOX, LEVEL _____

TILE FIELD, DEPTH _____ FT. TRENCH WIDTH _____ FT.

GRAVEL DEPTH _____ IN. TOTAL LENGTH _____ FT.

NUMBER OF TRENCHES _____ TOTAL BOTTOM AREA _____

SEEPAGE PITS, INSIDE DIAMETER PERIMETER 57 FT. DEPTH BELOW INLET 3 FT.

ABSORBENT AREA 456 SQ. FT.

REMARKS

6/14/84 LOCATION OK

6/14/85 OK TO COVER PART OF TANK
& DRY WELL & SOME SEWER LINE
FINISH HOOK UP & PUT PLUGS ON
CLEANOUTS & CALL

6/15/84 O.K. TO COVER ALL WORK

DATE SYSTEM APPROVED

6-15-84

INSPECTOR

A. Jacobson