

preliminary
4-13 Sales
on 10,000. If

APPLICATION

A 24592

SEWAGE DISPOSAL TESTING

P _____

STATE OF MARYLAND - DEPARTMENT OF HEALTH AND MENTAL HYGIENE

HOWARD COUNTY HEALTH DEPARTMENT
ENVIRONMENTAL HEALTH SERVICES

DISTRICT 3rd

P. O. BOX 476, ELLICOTT CITY, MARYLAND 21043
TELEPHONE: 465-5000, EXT. 356

DATE 9/24/76

TO: THE COUNTY HEALTH OFFICER
ELLICOTT CITY, MARYLAND

I, HEREBY, APPLY FOR THE NECESSARY TEST IN ORDER TO CONSTRUCT (OR RECONSTRUCT) A SEWAGE DISPOSAL SYSTEM.

PROPERTY OWNER Fred James Pipes

ADDRESS 13555 Old Frederick Road, Sykesville, Md. PHONE _____
21784

PROPERTY LOCATION:

SUBDIVISION Annandale LOT NO. New 4 ~~27~~ ~~27~~

ROAD AND DESCRIPTION Underwood Road

SIZE OF LOT 42,350 sq. ft. TYPE BLDG. 3 or 4

NUMBER OF BEDROOMS
single family dwelling

IF NOT SINGLE RESIDENCE DESCRIBE _____

THE SYSTEM INSTALLED UNDER THIS APPLICATION IS ACCEPTABLE ONLY UNTIL PUBLIC FACILITIES BECOME AVAILABLE.

SIGNATURE OF APPLICANT /s/ Fred James Pipes

BLDG. PERMIT SIGNED
AND RETURNED 9/21/77
Serial No. 33888

APPROVED BY [Signature] FOR Dial + Tang DATE 8/16/74
(KIND OF SYSTEM)


REJECTED BY _____ FOR _____ DATE _____
(KIND OF SYSTEM)

HOLD PENDING FURTHER TESTS _____ DATE _____

REASONS FOR REJECTION OR HOLDING _____

THIS IS NOT A PERMIT

27

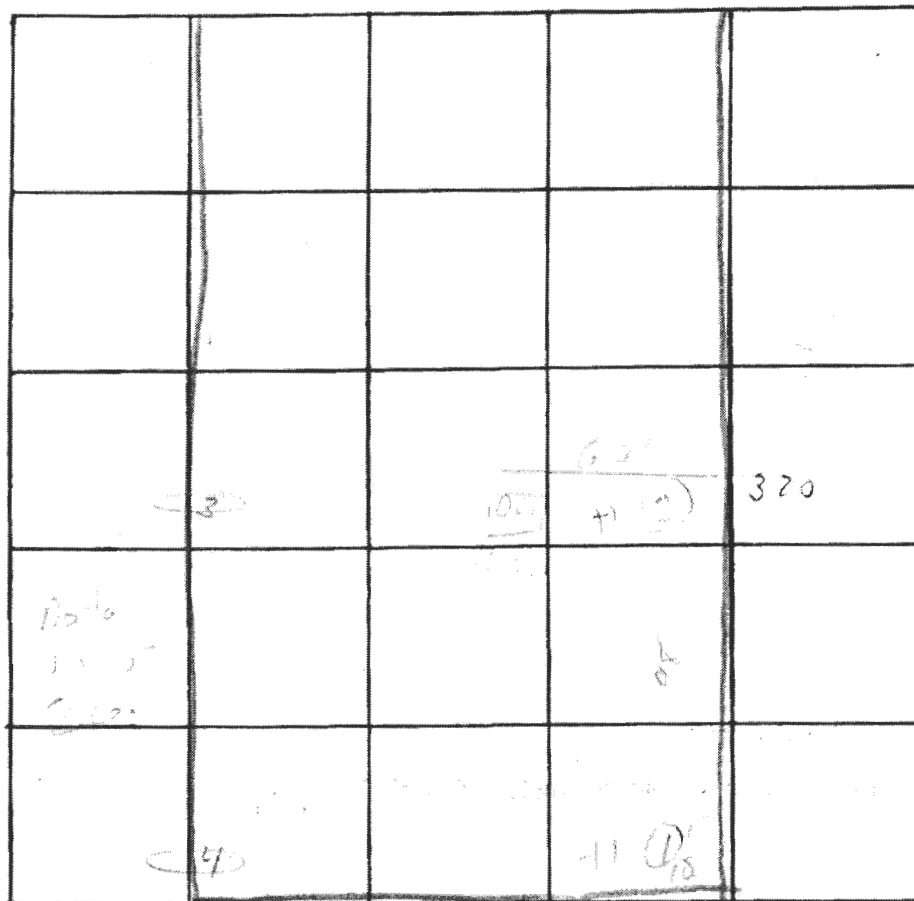

INDICATE NORTH - NAME ADJOINING ROADWAY AS BASE LINE:

125' Road

DATE	TEST NO.	DEPTH	PRE-WET		TEST - 1" DROP		TIME
			START	STOP	START	STOP	
7/10	1	1'	10:15	10:45	10:35	40	15
	2	2'	10:17	10:25	10:34	10:39	12
	3	4'	10:20	10:34	10:34	10:49	15
		13'	10:38	10:50	10:50	11:10	20
	3	6'-12'					1 min 20 min
	4	2 1/2'-13'					13 min 21 min

REMARKS _____

TYPE OF SOIL _____

TESTED BY _____ ALSO PRESENT: _____