

HOWARD COUNTY PERMIT APPLICATION

PERMIT NUMBER

30800043

Building Address 13008 Twelve Trees Ct
Clarksville MD

Suite/Apt. #: _____ SDP/WP/Petition #: _____

Census Tract _____ Subdivision Twelve Hills

Section _____ Area _____ Lot 28 12

Tax Map 28 Parcel _____ Grid _____

Zoning RR Map Coordinates _____ Lot size 3.25 ac

Existing Use Single Fam. Dwelling

Proposed Use Single Fam. Dwelling

Estimated Construction Cost \$ 800,000

Description of Work Extend rear of house 8'

Rebuild EXISTING Screen Porch 8' x 8'

Occupant or Tenant _____

Contact Name _____

Address _____

City _____ State _____ Zip Code _____

Phone _____ Fax _____

Property Owner's Name Ann & Craig Rawnstein

Address 13008 Twelve Trees Ct

City Clarksville State MD Zip Code _____

Home Phone (301) 854-9785 Work Phone (301) 664-4200

Applicant's Name & Mailing Address, (if other than stated hereon):

Phone 301 854 9785 Fax _____

Contractor Company Fred C Dickson Colne

Contact Person Fred Dickson

Address 953 Reed Rd

City MT Air State MD Zip Code 21771

License No 08016087576

Phone (410) 875-2115 Fax (410) 866-8876

Engineer or Architect Company N/A

Contact Person _____

Address _____

City _____ State _____ Zip Code _____

Phone _____ Fax _____

BUILDING DESCRIPTION - COMMERCIAL

BUILDING DESCRIPTION - RESIDENTIAL

Building Characteristics

Utilities

Building Characteristics

Utilities

Height: _____

No. of stories: _____

Gross area, sq. ft. per floor: _____

Use group: _____

Construction type:

☐ Reinforced Concrete

☐ Structural Steel

☐ Masonry

☐ Wood Frame

☐ State Certified Modular

Water Supply:

☐ Public

☐ Private

Sewage Disposal:

☐ Public

☐ Private

Electric Yes ☐ No ☐

Gas Yes ☐ No ☐

Heating System:

Electric ☐ Oil ☐

Natural Gas ☐

Propane Gas ☐

Sprinkler system: N/A ☐

☐ Full

☐ Partial

☐ Other Suppression

☐ # of Heads

SF Dwelling ☐ SF Townhouse ☐

Depth _____ Width _____

1st floor: _____

2nd floor: _____

Basement: _____

Finished Basement ☐ Unfinished Basement ☐

Crawl space ☐ Slab on Grade ☐

No. of Bedrooms: _____

Height: _____

Multi-family dwellings:

No. of efficiency units: _____

No. of 1 BR units: _____

No. of 2 BR units: _____

No. of 3 BR units: _____

Other Structure: _____

Dimensions: _____

Footings: _____

Roof Height: _____

☐ State Certified Modular

☐ Manufactured Home

Water Supply:

☐ Public

☒ Private

Sewage Disposal:

☐ Public

☒ Private

Electric Yes ☐ No ☐

Gas Yes ☐ No ☐

Heating System:

Electric ☐ Oil ☐

Natural Gas ☐

Propane Gas ☐

Sprinkler system: N/A ☐

☐ NFPA #13D

☐ NFPA #13R

☐ Other:

THE UNDERSIGNED HEREBY CERTIFIES AND AGREES AS FOLLOWS: (1) THAT HE/SHE IS AUTHORIZED TO MAKE THIS APPLICATION; (2) THAT THE INFORMATION IS CORRECT; (3) THAT HE/SHE WILL COMPLY WITH ALL REGULATIONS OF HOWARD COUNTY WHICH ARE APPLICABLE THEREON; (4) THAT HE/SHE WILL PERFORM NO WORK ON THE ABOVE REFERENCED PROPERTY NOT SPECIFICALLY DESCRIBED IN THIS APPLICATION; (5) THAT HE/SHE GRANTS COUNTY OFFICIALS THE RIGHT TO ENTER ONTO THIS PROPERTY FOR THE PURPOSE OF INSPECTING THE WORK PERMITTED AND POSTING NOTICES.

Fred C Dickson Colne

Applicant's Signature

Fred C Dickson Colne

Title/Company

Fred Dickson

Print Name

01/09/08

Date

Checks payable to: DIRECTOR OF FINANCE OF HOWARD COUNTY

" PLEASE WRITE NEATLY AND LEGIBLY. "

FOR OFFICE USE ONLY.

AGENCY DATE SIGNATURE APPROVAL

Land Development DPZ _____

State Highway _____

Building Official _____

Dev. Engineering DPZ _____

Health 1-9-08 Heather Stettin

Fire Protection _____

Is Sediment Control approval required prior to issuance?

YES ☐ NO ☐

CONTINGENCY CONSTRUCTION START: ☐

ONE STOP SHOP: ☐

DPZ SETBACK INFORMATION

Front: _____

Rear: _____

Side: _____

Side St: _____

All minimum setbacks met?

YES ☐ NO ☐

Is Entrance Permit required?

YES ☐ NO ☐

Historic District?

YES ☐ NO ☐

Lot Coverage for New Town Zone _____

SDP/Red-line approval date _____

PROPERTY INFO

Filing fee \$ _____

Permit fee \$ _____

Excise tax \$ _____

Add'l per. fee \$ _____

TOTAL FEES \$ _____

Sub-total paid \$ _____

Balance due \$ _____

Check # _____

Validation # _____

Accepted by _____

Distribution of Copies-

White: Building Official

Green: LDO, DPZ

Yellow: DED, DPZ

Pink: Health

Gold: SHA

TWELVE TREES COURT

APPROVED
 WALKTHRU BUILDING PERMIT
 APP# 38530
 DATE: 1-9-08
 DESC. OF WORK: rebuild porch

O well

EXISTING HOUSE

Deck

EXIST'g Porch

EXIST'g Tank

Proposed setback adjustment to 24'

Existing Building Restriction

20' E.T.R.

Proposed One story Garage Addition 314 sq. ft.

3.247 Acres

septic Easement

GAS LINE EASEMENT

LOT 12
 "TWELVE HILLS"
 SEC 2
 5th ELECTION DISTRICT
 HOWARD COUNTY, MD
 Tax Map 28 RR Zoning
 PLAT REFERENCE 1430

SCALE 1" = 1'



FRED C. DICKSON CO., INC.

PH-888 No. 407 www.fcdco.com MS-400 No. 8756
 PO BOX 100 MT. AIRY, MD 21778
 410.875.715 FAX 410.875.6301 PH-888 No. 407


ROSENSTEIN
 SITE PLAN

13008 TWELVE TREES CT.

SCALE: 1" = 100'
 DATE: 8/1/07
 DRAWN BY: FCD
 REVISION:
 APPROVED:

PAGE
 1 OF 1

ITC
GC ESMNT.

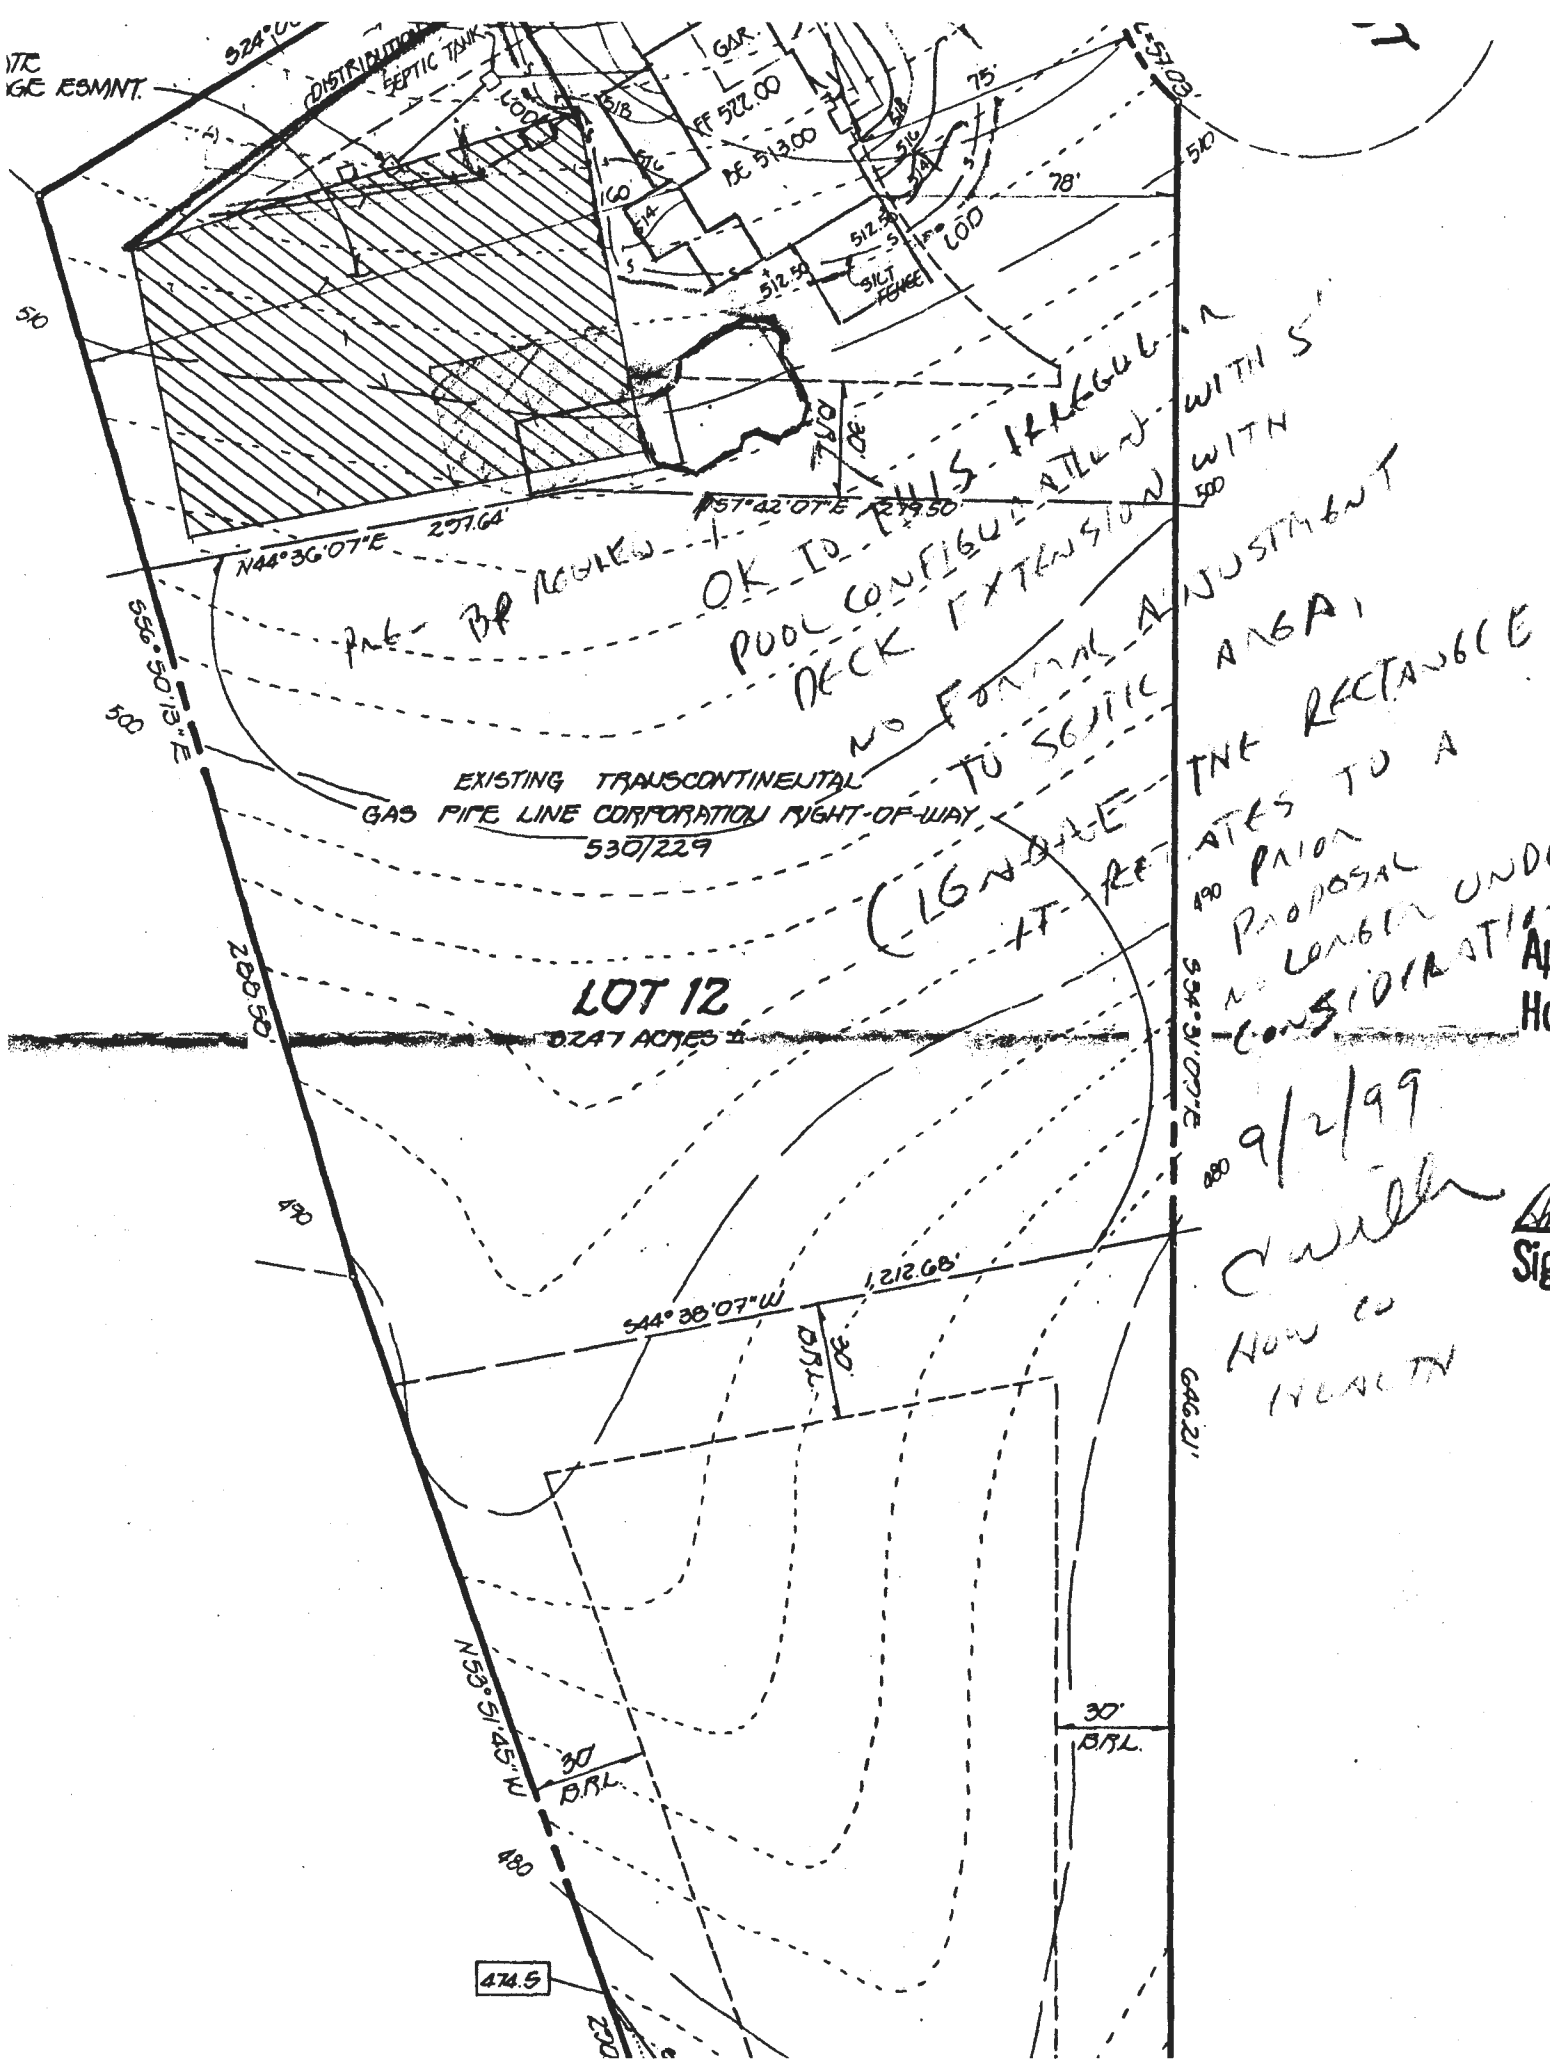

PRE-BP REVIEW

OK TO THIS IRREGULAR
POOL CONFIGURATION WITH 5'
DECK EXTENSION

NO FORMAL ADJUSTMENT
TO 5611C
THE RECTANGLE
ADJUSTS TO A
PRIOR
PROPOSAL
NO CONSIDERATION
UNDER

9/2/99
C. Miller
HOW TO
HEALTHY

Sig