

LAYOUT _____ INSP 4 _____
INSP 2 _____ INSP 5 _____
INSP 3 _____ INSP 6 _____

ISSUE DATE: 3-28-11

APPROVAL DATE: 6/16/11

PERMIT-
Tank ^{UPGRADE} Replacement

P 534532

A UPGRADE

Tax ID # 1405407265

**ON-SITE SEWAGE DISPOSAL SYSTEM
HOWARD COUNTY HEALTH DEPARTMENT
BUREAU OF ENVIRONMENTAL HEALTH**

Baldev Singh & Pushpinder Sandhu IS PERMITTED TO INSTALL ALTER

ADDRESS: 13007 Twelve Hills Rd. PHONE NUMBER: 301 433 4422

SUBDIVISION: Tweleve Hills LOT NUMBER: 23

ADDRESS: 13007 Twelve Hills Rd
Clarksville, MD 21029 PROPERTY OWNER: Baldev Singh

SEPTIC TANK CAPACITY (GALLONS): 1,000 OUTLET BAFFLE FILTER REQUIRED

PUMP CHAMBER CAPACITY (GALLONS): NA COMPARTMENTED TANK REQUIRED

NUMBER OF BEDROOMS: 5

SQUARE FOOTAGE OF HOUSE: +3,501

LOCATION:	Install new 1,000 gallon septic tank in series with existing 1,250 gallon septic tank prior to existing distribution box. See plan details.
NOTES:	Do not order the septic tank until after layout inspection and Sanitarian approval. Call for layout inspection. Mark utilities. A written variance request is required for tanks deeper than 3 feet. A traffic bearing lid is required for tanks deeper than 4 feet.

PLANS APPROVED: Heidi Scott DATE: 3/18/2011

- NOTE: PERMIT VOID AFTER 2 YEARS
- NOTE: CONTRACTOR RESPONSIBLE FOR SCHEDULING A PRE-CONSTRUCTION INSPECTION FOR ALL INSTALLATIONS
- NOTE: WATERTIGHT SEPTIC TANKS REQUIRED
- NOTE: ALL PARTS OF SEPTIC SYSTEM SHALL BE 100 FEET FROM ANY WATER WELL
- NOTE: MANHOLE RISERS REQUIRED ON ALL SEPTIC TANKS AND PUMP CHAMBERS

**NEITHER THE HOWARD COUNTY COUNCIL OR THE HEALTH DEPARTMENT IS
RESPONSIBLE FOR THE SUCCESSFUL OPERATION OF ANY SYSTEM
PERMITTEE RESPONSIBLE FOR OBTAINING FINAL APPROVAL ON THIS PERMIT
CALL 410-313-1771 FOR INSPECTION OF SEPTIC SYSTEM**


100 94-0395

NOT TO SCALE

HO-95-0395

176'

1149'

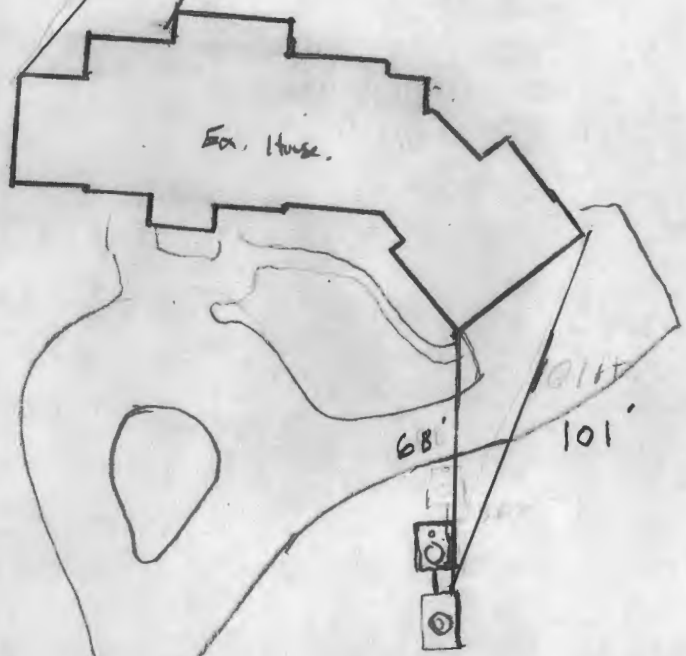

TRENCH/DRAINFIELD DATA

WIDTH	INLET	BOTTOM
_____	_____	_____
NUMBER OF TRENCHES _____		
TOTAL LENGTH _____		
ABSORPTION AREA _____		
DISTRIBUTION BOX LEVEL _____		
DISTRIBUTION BOX BAFFLE _____		
DISTRIBUTION BOX PORT _____		

SEPTIC TANK DATA

SEPTIC TANK I LEVEL _____

MANUFACTURER Babylon

CAPACITY 1,000 GAL

SEAM LOC Top

TANK LID DEPTH 2ft

BAFFLES yes

BAFFLE FILTER N/A

MANHOLE LOC yes/middle

6" PORT LOC N/A

WATERTIGHT TEST N/A

SLOTTED NO

DATE ON LID 5/3/11

~~PUMP/SEPTIC TANK LEVEL _____~~

~~MANUFACTURER _____~~

~~CAPACITY _____ GAL~~

~~SEAM LOC _____~~

~~TANK LID DEPTH _____~~

~~BAFFLES _____~~

~~BAFFLE FILTER _____~~

~~MANHOLE LOC _____~~

~~6" PORT LOC _____~~

~~WATERTIGHT TEST _____~~

~~SLOTTED _____~~

~~DATE ON LID _____~~

PRE-CONSTRUCTION:

6/16/11 Spoke w/ contractor on phone. OK to set 1000g tank
 in old existing 1200. Tank coming from Babylon vault.
 Insp. scheduled for afternoon (10)

INSTALLATION:

6/16/11 (pm) - New tank added in series.
 Existing tank was a mid-seam tank and new
 tank top seam - (MS)

FINAL INSPECTOR

(MS)

DATE OF APPROVAL

6/16/11