

MARYLAND DEPARTMENT OF THE ENVIRONMENT, WATER MANAGEMENT ADMINISTRATION
2500 BROENING HIGHWAY, BALTIMORE, MARYLAND 21224, (410) 631-3784

WATER WELL ABANDONMENT-SEALING REPORT FORM

SUBMIT COPIES OF COMPLETED FORM TO:

- * COUNTY ENVIRONMENT AGENCY (contact MDE, WMA if address needed)
- * WELL OWNER
- * MDE, WATER MANAGEMENT ADMINISTRATION, WELL PROGRAM

DATE WELL ABANDONED: 1/20/11 (month/day/year)

* PERMIT NUMBER OF ABANDONED WELL (if any) N/A

* PERMIT NUMBER OF REPLACEMENT WELL N/A

* PERSON ABANDONING WELL: Pegasus Corp.
(Sams)

WELL DRILLERS LICENSE NUMBER: _____
CIRCLE: MWD/MSD/MGD


* OWNER'S NAME: Sams

* WELL LOCATION:

COUNTY: Howard
NEAREST TOWN: Columbia
TAX MAP 31 BLOCK 19 PARCEL 469
SUBDIVISION: N/A
SECTION: N/A LOT: -
NEAREST ROAD: Tricross Dr.

MARYLAND GRID COORDINATES

BOX NUMBER E 0853
N 557

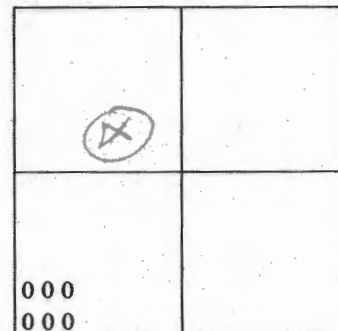

SHOW WELL LOCATION
BY X WITHIN BOX

* TYPE OF WELL BEING ABANDONED:

____ DRILLED _____ JETTED
____ BORED/AUGURED ☒ HAND DUG
____ OTHER (specify) _____

* USE CODE:

☒ DOMESTIC _____ MUNICIPAL/PUBLIC
____ IRRIGATION _____ INDUSTRIAL
____ TEST/OBSERVATION

* TYPE OF CASING:

____ STEEL _____ PLASTIC
____ CONCRETE ☒ OTHER (specify)
Brick

* SIZE OF CASING: 42 INCHES IN DIAMETER

* DEPTH OF WELL: 35 FEET DEEP

* WAS ANY CASING REMOVED? ☒ YES _____ NO
if yes, length removed, in feet: 2

* WAS CASING RIPPED OR PERFORATED? ☒ YES _____ NO

LOG OF SEALING MATERIAL

MATERIAL	FEET	
	FROM	TO
Washed Concrete Aggregate	5'	35'
Concrete Cement Type I II	2'	3'
Fill	0	2'

SIGNATURE-MASTER WELL DRILLER OR SUPERVISING SANITARIAN

LICENSE #

MWD/MSD/MGD
CIRCLE ONE

DATE

Well Filling Proposal


Re: 5616 TRICROSS DR. COLUMBIA MD

Fill existing cavity with double washed clean stone to level shown (5' from ground level)
Then fill with 3' concrete, then fill with 2' topsoil.

KEY

- (A) ^{Double} Washed 3/4" stone (crust or other approved material)
- (B) Concrete
- (C) Topsoil

ELEVATION VIEW

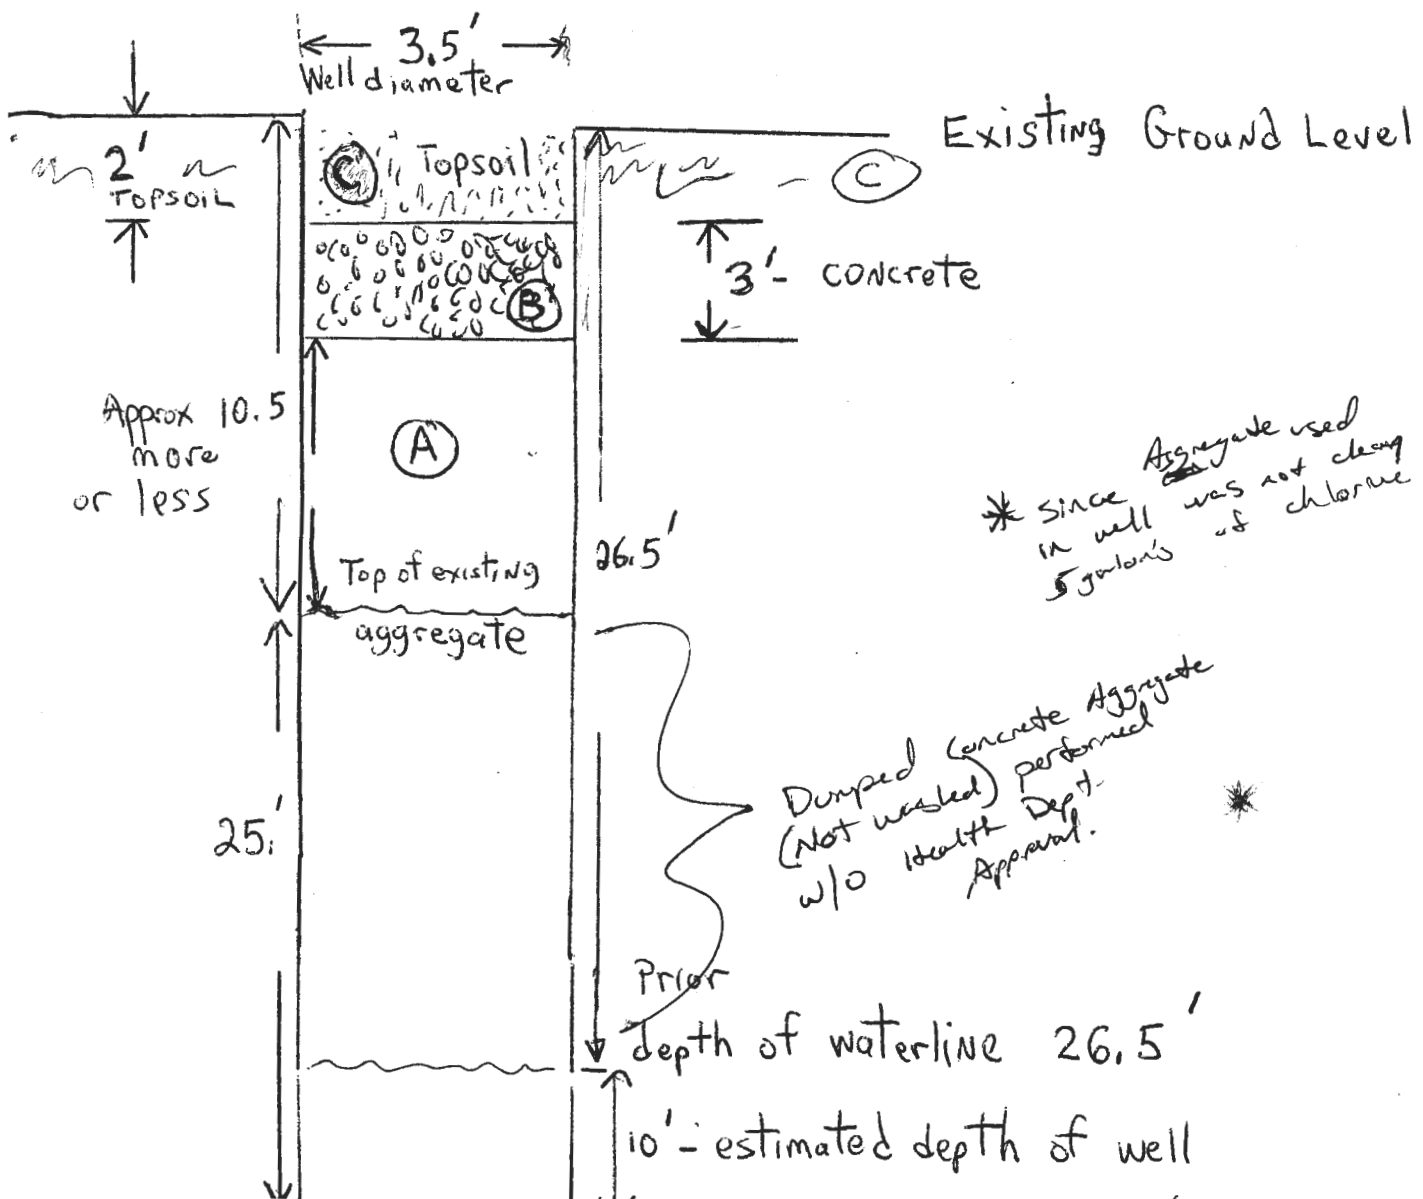

Need to mix 6 cups bleach
w/ 5 gallons of water.

9:30 am

1-18-11

Spoke to David Simard
told him to expose
drywell / trenches (?)

Must expose entire length
of pipe from S.T.

Will call when work is
finished.

James Russell

351-609-1896