

check  
8-29-60

check - 5/11/60 AM

# PERMIT

SEWAGE DISPOSAL SYSTEM

MARYLAND STATE DEPARTMENT OF HEALTH

HOWARD COUNTY

P 02346  
A 01131

ELLICOTT CITY

DISTRICT 5

DATE 4/20/60

INDEXED

Charles Miller IS PERMITTED TO INSTALL  ALTER

ADDRESS Trotter Rd., Clarksville PHONE

A SEWAGE DISPOSAL SYSTEM LOCATED AT Trotter Rd. - about 3/4 mi. from Clarksville Pike on right other houses being built there.

SUBDIVISION Forest Hills ROAD Trotter Rd. LOT 19

PROPERTY OWNER Morris Brown

ADDRESS Fulton

SPECIFICATIONS

DRAIN FIELD  DEPTH FEET, BOTTOM AREA 510 SQ. FT.

SEEPAGE PITS ABSORBENT SIDE-WALL AREA SQ. FT.

SEPTIC TANK CAPACITY 750 GALLONS

FOR GARBAGE GRINDER, INCREASE DISPOSAL AREA 22% & TANK CAPACITY 50%.


OTHER System must be installed in area that passed perc. test.

PLANS APPROVED BY James E. Hennigan DATE 6/16/59

FILL SEPTIC TANK AND DISTRIBUTION BOX WITH WATER BEFORE CALLING FOR AN INSPECTION. COVER NO WORK UNTIL INSPECTED AND APPROVED.

NEITHER THE HOWARD COUNTY COMMISSIONERS NOR THE HEALTH DEPARTMENT IS RESPONSIBLE FOR THE SUCCESSFUL OPERATION OF ANY SYSTEM.

A01131

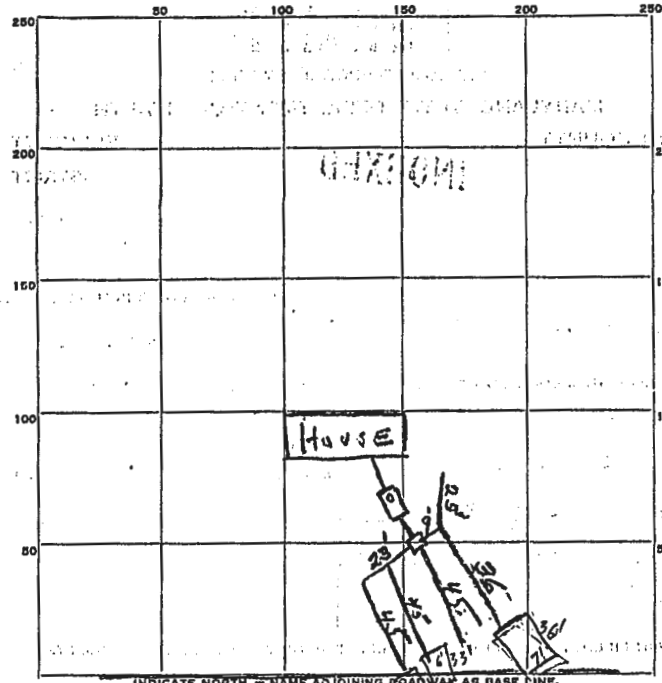

PERMIT CARD Yes No

SEPTIC TANK, LEVEL OK CLEANOUTS \_\_\_\_\_

DISTRIBUTION BOX, LEVEL \_\_\_\_\_

TILE FIELD, DEPTH \_\_\_\_\_ FT. TRENCH WIDTH 2 FT.

GRAVEL DEPTH \_\_\_\_\_ IN. TOTAL LENGTH 228 FT.

NUMBER OF TRENCHES 6 TOTAL BOTTOM AREA 456

SEEPAGE PITS, INSIDE DIAMETER \_\_\_\_\_ FT. DEPTH BELOW INLET \_\_\_\_\_ FT.

198  
188  
242  
6

510  
452  
54

5-11-60 5 hrs 54 sq. FT. of tile field.  
REMARKS outlets of distribution box not level.  
Trenches covered with treated paper. JH  
8/29/60 Trenches covered with red wax paper  
Distribution box level 3 leaching holes.  
contains 242 + 198 + 198 = 638 sq. ft. additional  
of 6 x 5 tile field  
DATE SYSTEM APPROVED 8/29/60 INSPECTOR Raymond Hodges