

DEPARTMENT OF INSPECTIONS, LICENSES AND PERMITS 3430 COURT HOUSE DRIVE ELLCOTT CITY, MD 21043 PERMITS (410)313-2455 INSPECTIONS (410)313-1810 AUTOMATED INFORMATION (410) 313-3800	HOWARD COUNTY PERMIT APPLICATION	PERM. TB0071
--	-------------------------------------	-----------------

Building Address <u>5668 TRUTTER RD</u> <u>LARKSVILLE MD 21029</u>	Property Owner's Name <u>KEVIN & ELIZABETH IVYNN</u>
Suite/Apt. #: _____ SDP/WP/Petition #: _____	Address <u>5668 TRUTTER RD</u>
Census Tract <u>100001</u> Subdivision <u>FOREST HILLS</u>	City <u>LARKSVILLE</u> State <u>MD</u> Zip Code <u>21029</u>
Section _____ Area _____ Lot <u>19</u>	Home Phone <u>410 313-1444</u> Work Phone <u>410 242-7265</u>
Tax Map <u>35</u> Parcel <u>1167</u> Grid <u>2</u>	Applicant's Name & Mailing Address, (if other than stated hereon): _____
Zoning <u>R-20</u> Map Coordinates <u>1446</u> Lot size <u>1 ACRE</u>	Phone _____ Fax _____
Existing Use <u>SINGLE FAMILY DWELLING</u>	Contractor Company <u>WINKER</u>
Proposed Use <u>ADDITION</u>	Contact Person _____
Estimated Construction Cost \$ <u>25,000.00</u>	Address _____
Description of Work <u>3 CAR GARAGE w/</u>	City _____ State _____ Zip Code _____
<u>LIVING SPACE ABOVE - BEDROOM 42x32</u>	License No. _____
<u>SCREENED PORCH 14x16</u>	Phone _____ Fax _____
Occupant or Tenant <u>same</u>	Engineer or Architect Company <u>WINKER</u>
Contact Name _____	Contact Person _____
Address _____	Address _____
City _____ State _____ Zip Code _____	City _____ State _____ Zip Code _____
Phone _____ Fax _____	Phone _____ Fax _____

BUILDING DESCRIPTION - <u>COMMERCIAL</u>		BUILDING DESCRIPTION - <u>RESIDENTIAL</u>	
Building Characteristics	Utilities	Building Characteristics	Utilities
Height: _____	Water Supply: _____ Public _____ Private _____	SF Dwelling ☒ SF Townhouse ☐ Depth _____ Width _____	Water Supply: _____ Public _____ Private ☒
No. of stories: _____	Sewage Disposal: _____ Public _____ Private _____	1st floor: _____	Sewage Disposal: _____ Public _____ Private ☒
Gross area, sq. ft. per floor: _____	Electric Yes ☐ No ☐ Gas Yes ☐ No ☐	2nd floor: <u>32 x 42 (24' x 14')</u>	Electric Yes ☒ No ☐ Gas Yes ☒ No ☐
Use group: _____	Heating System: _____ Electric ☐ Oil ☐ Natural Gas ☐ Propane Gas ☐	Basement: <u>GARAGE 32 x 22</u>	Heating System: _____ Electric ☐ Oil ☐ Natural Gas ☒ Propane Gas ☐
Construction type: _____ Reinforced Concrete _____ Structural Steel _____ Masonry _____ Wood Frame _____	Sprinkler system: <u>N/A</u> ☐ Full _____ Partial _____ Other Suppression _____ # of Heads _____	Finished Basement ☐ Unfinished Basement ☐ Crawl space ☐ Slab on Grade ☐ No. of Bedrooms <u>1</u>	Sprinkler system: <u>N/A</u> ☒ NFPA #13D _____ NFPA #13R _____ Other: _____
State Certified Modular _____		Other Structure: _____ Dimensions: _____ Footings: _____ Roof: _____	State Certified Modular _____ Manufactured Home _____


THE UNDERSIGNED HEREBY CERTIFIES AND AGREES AS FOLLOWS: (1) THAT HE/SHE IS AUTHORIZED TO MAKE THIS APPLICATION; (2) THAT THE INFORMATION IS CORRECT; (3) THAT HE/SHE WILL COMPLY WITH ALL REGULATIONS OF HOWARD COUNTY WHICH ARE APPLICABLE THERETO; (4) THAT HE/SHE WILL PERFORM NO WORK ON THE ABOVE REFERENCED PROPERTY NOT SPECIFICALLY DESCRIBED IN THIS APPLICATION; (5) THAT HE/SHE GRANTS COUNTY OFFICIALS THE RIGHT TO ENTER ONTO THIS PROPERTY FOR THE PURPOSE OF INSPECTING THE WORK PERMITTED AND POSTING NOTICES.

Applicant's Signature <u>WINKER</u>	Print Name <u>ELIZABETH IVYNN</u>
Title/Company _____	Date <u>5/28/02</u>

Checks payable to: **DIRECTOR OF FINANCE OF HOWARD COUNTY**
** PLEASE WRITE NEATLY AND LEGIBLY. **

AGENCY	DATE	SIGNATURE APPROVAL	DPZ SETBACK INFORMATION	PROPERTY ID#
Land Development, DPZ			Front: _____	Filing fee \$ <u>25.00</u>
State Highways			Rear: _____	Permit fee \$ _____
Building Official			Side: _____	Excise tax \$ _____
Dev. Engineering, DPZ			Side St.: _____	Add'l per. fee \$ _____
Health	<u>5/28/02</u>	<u>John</u>	All minimum setbacks met? YES ☐ NO ☐	TOTAL FEES \$ _____
Fire Protection			Is Entrance Permit required? YES ☐ NO ☐	Sub-total paid \$ _____
Is Sediment Control approval required prior to issuance? YES ☐ NO ☐			Historic District? YES ☐ NO ☐	Balance due \$ _____
CONTINGENCY CONSTRUCTION START ☐			Lot Coverage for New Town Zone <u>1:02</u>	Check # <u>3157</u>
ONE STOP SHOP ☐			SDP/Red-line approval date _____	Validation # _____

Distribution of Copies: White: Building Official Green: LDD, DPZ Yellow: DED, DPZ Pink: Health Gold: SHA

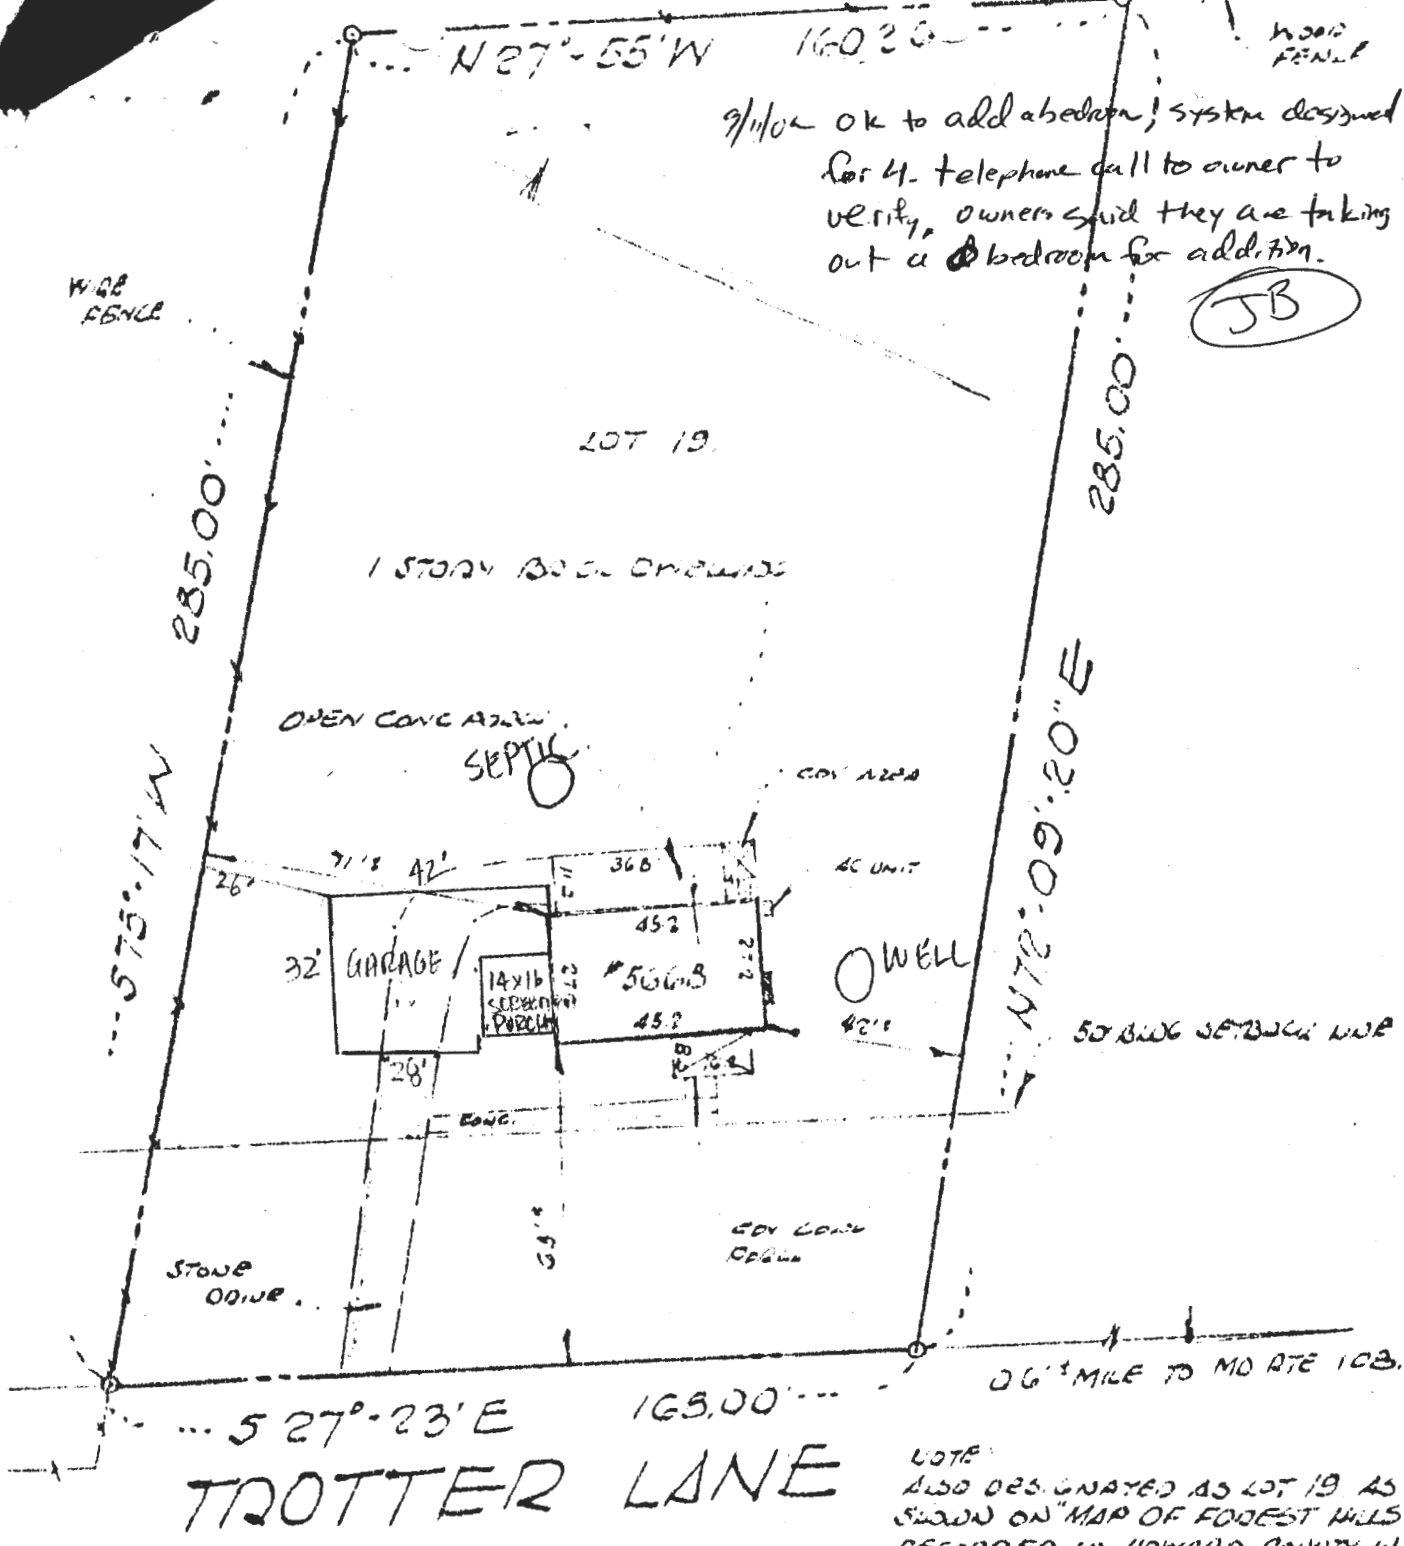

LOCATION SURVEY
5668 TROTTER LANE
HOWARD COUNTY, MD.

I hereby certify that I have made a survey of this lot for the purpose of locating the improvements thereon and that they are located as shown.
 This plat is not intended for use in establishing property lines

Spotts, Stevens and McCoy, Inc.



ENGINEERS • PLANNERS • SURVEYORS

5508 York Road
 Baltimore, MD 21212

1"=40'	101533	83676
SCALE	DATE	JOB NO

RECORDED

A01131
 P02346