

8/23/68
8/30/68
Judy

app-724.68
Judy

PERMIT

SEWAGE DISPOSAL SYSTEM

MARYLAND STATE DEPARTMENT OF HEALTH

HOWARD COUNTY

INDEXED

ELLICOTT CITY

DISTRICT 3

DATE 8/16/68

P 13842

A 11931

Catonsville Plumbing & Heating Co., Inc. IS PERMITTED TO INSTALL X ALTER

ADDRESS 918 Frederick Rd., Catonsville, Md. PHONE RI 7-2293

A SEWAGE DISPOSAL SYSTEM LOCATED AT _____

SUBDIVISION River Park Estates ROAD Taylor Park Rd. LOT 46

PROPERTY OWNER Ben Catchings and wife

ADDRESS _____

SPECIFICATIONS - 3 or 4 bedrooms

DRAIN FIELD _____ DEPTH _____ FEET, BOTTOM AREA _____ SQ. FT.

SEEPAGE PITS _____ ABSORBENT SIDE-WALL AREA _____ SQ. FT.

SEPTIC TANK CAPACITY 750 GALLONS for 3 bedrooms
1,000 " " 4 "

FOR GARBAGE GRINDER, INCREASE DISPOSAL AREA 22% & TANK CAPACITY 50%.

OTHER 3 bedrooms - Dry well - 300 sq. ft. sidewall area below the inlet with
a maximum depth of 13 ft. 4 bedrooms - Dry well - 400 sq. ft. sidewall

area below the inlet with a maximum depth of 13 ft.

Place the dry well 15 ft. to 35 ft. from the front lot line.

PERMIT VOID AFTER THREE YEARS.


PLANS APPROVED BY Raymond Hodges DATE 4/11/67

FILL SEPTIC TANK AND DISTRIBUTION BOX WITH WATER BEFORE CALLING FOR AN INSPECTION. COVER NO WORK UNTIL INSPECTED AND APPROVED.

NEITHER THE HOWARD COUNTY COMMISSIONERS NOR THE HEALTH DEPARTMENT IS RESPONSIBLE FOR THE SUCCESSFUL OPERATION OF ANY SYSTEM.

**NOTIFY THE HEALTH DEPARTMENT 48 HOURS
BEFORE EXCAVATIONS ARE TO BE BACK FILLED.**

11931

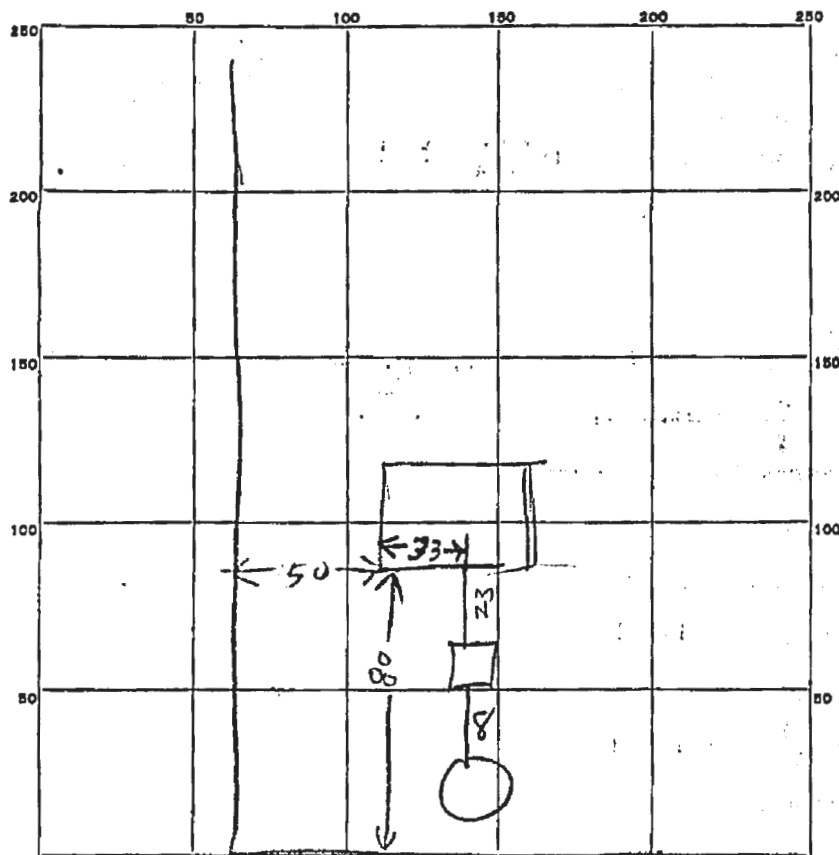

INDICATE NORTH. - NAME ADJOINING ROADWAY AS BASE LINE.
TALOR PARK DR

PERMIT CARD OK

SEPTIC TANK, LEVEL OK 1000 concrete CLEANOUTS 014

DISTRIBUTION BOX, LEVEL _____

TILE FIELD, DEPTH _____ FT. TRENCH WIDTH _____ FT.

GRAVEL DEPTH _____ IN. TOTAL LENGTH _____ FT.

NUMBER OF TRENCHES _____ TOTAL BOTTOM AREA _____

SEEPAGE PITS, INSIDE DIAMETER 13 FT. DEPTH BELOW INLET 10 FT.

ABSORBENT AREA 408 SQ. FT.

REMARKS 24/0668 O/B to cover Tank

DATE SYSTEM APPROVED 8/29/68

INSPECTOR SW. M. 209

Preliminary

APPLICATION

SEWAGE DISPOSAL TESTING

A 119.31

P _____

MARYLAND STATE DEPARTMENT OF HEALTH

HOWARD COUNTY
3 BEDROOMS

4 BEDROOMS

ELLICOTT CITY

DISTRICT Third

750 Gal Tank

1000 Gal Tank

DATE June 20, 1966

Pry Well - 300 sq ft

Dry Well - 400 sq ft

sidewall area below the inlet with a maximum depth of 13 ft

area below the inlet with a maximum depth of 13 ft

Place the dry well 15 ft to 35 ft from the front lot line

TO: THE COUNTY HEALTH OFFICER
ELLICOTT CITY, MARYLAND

I, HEREBY, APPLY FOR THE NECESSARY TESTS IN ORDER TO CONSTRUCT (OR RECONSTRUCT) A SEWAGE DISPOSAL SYSTEM.

PROPERTY OWNER Ben Catchings & Loris S. Catchings, his wife

ADDRESS 1411 Winston Ave., Baltimore, Md. 21212

PHONE ID. 5-8417

PROPERTY LOCATION:

SUBDIVISION Rivier Park Estates

LOT NO. 46

ROAD AND DESCRIPTION West side of Taylor Park Road, per plat

OCCUPANT _____

PHONE _____

PERSON TO CONSTRUCT SYSTEM _____

ADDRESS _____

PHONE _____

SIZE OF LOT 135' by 327' deep

TYPE BLDG. 3 or 4

NUMBER OF BEDROOMS

IF NOT SINGLE RESIDENCE DESCRIBE _____

SIGNATURE OF APPLICANT

Ben Catchings & Loris S. Catchings

APPROVED BY

Raymond Hodges

FOR

Dry Well

(KIND OF SYSTEM)

DATE

11 April 67

REJECTED BY _____

FOR

(KIND OF SYSTEM)

DATE

HOLD PENDING FURTHER TESTS

R 15

DATE


6/22/66

REASONS FOR REJECTION OR HOLDING

6/22/66 - Hold for final plat

11 April 67 - Final Plat OK

THIS IS NOT A PERMIT

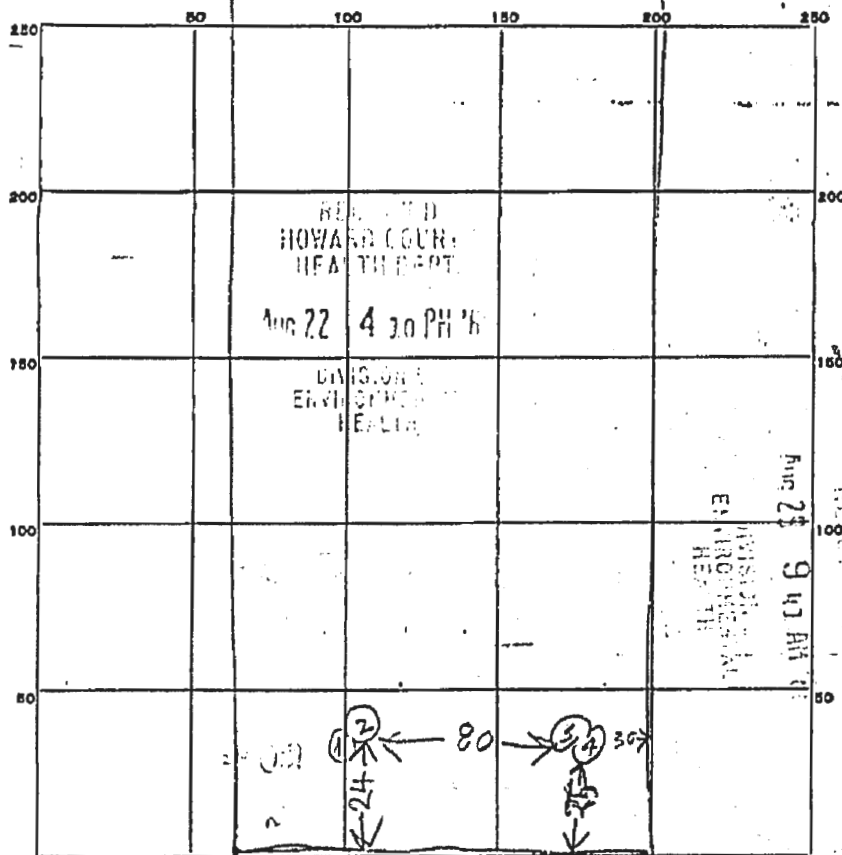

INDICATE NORTH - NAME ADJOINING ROADWAY AS BASE LINE.

TAYLOR PARK DRIVE

DATE	TEST NO.	DEPTH	PRE-WET		TEST - 1" DROP		TIME
			START	STOP	START	STOP	
6/22/66	1	9 1/2	1106	1114	1114	1121	7
6/21/66	2	5	1119	1121	1121	1126	5
6/22/66	3	5 1/2	1133	1137	1137	1141	9
6/21/66	4	4 1/2	1134	1137	1137	1143	6

7 MIN
for both
4.25 INCH
DIN FILE

SOIL AUGER FINDING

TESTED BY

REMARKS

R. Walcott

2-2-96