

APPLICATION

SEWAGE DISPOSAL TESTING

STATE OF MARYLAND - DEPARTMENT OF HEALTH AND MENTAL HYGIENE

HOWARD COUNTY HEALTH DEPARTMENT
ENVIRONMENTAL HEALTH SERVICES

P. O. BOX 476 ELLICOTT CITY, MARYLAND 21043
TELEPHONE: 992-2330

A 34980

P _____

DISTRICT 5th ELECTION

DATE 2-14-85

TO: THE COUNTY HEALTH OFFICER
ELLICOTT CITY, MARYLAND

I, HEREBY, APPLY FOR THE NECESSARY TEST IN ORDER TO CONSTRUCT (OR RECONSTRUCT) A SEWAGE DISPOSAL SYSTEM.

PROPERTY OWNER HUNTINGTON INTERNATIONAL CORPORATION DANIEL CHAN

ADDRESS 4951 ROCKWOOD PARKWAY NW, WASH, D.C. 20016 PHONE (202) 659-2474

PROPERTY LOCATION: WATERFORD Section 2 Pulvin
SUBDIVISION HUNTINGTON ESTATES LOT NO. ~~20~~ 6 LOT 17

ROAD AND DESCRIPTION ON BRIGHTON ROAD 1800' WEST OF TEN OAKS ROAD
INTERSECTION 1295 WATERFORD PARK

SIZE OF LOT ~~2.1~~ 3.11 AC[±] TYPE BLDG. SINGLE FAMILY DWELLING
(NUMBER OF BEDROOMS)

THE SYSTEM INSTALLED UNDER THIS APPLICATION IS ACCEPTABLE ONLY UNTIL PUBLIC FACILITIES BECOME AVAILABLE. I FULLY UNDERSTAND THE
FEE CONNECTED WITH THE FILING OF THIS PERC TEST APPLICATION IS NON-REFUNDABLE UNDER ANY CIRCUMSTANCES. I ALSO AGREE TO COMPLY
WITH ALL M.O.S.H.A. REQUIREMENTS IN TESTING THIS LOT. Charles J. Conrad
(SIGNATURE OF APPLICANT)

APPROVED BY: Sidney Abel FOR Shallow hole field DATE 4-1-87

REJECTED BY: _____ FOR _____ DATE _____

HOLD PENDING FURTHER TESTS _____ DATE _____

REASONS FOR REJECTION OR HOLDING PERC SATISFACTORY, WATER IN T hole, hold for review,
certified subdivision PLAT WITH hole location, house and well size, SAG
SYSTEM FIRST - SHALLOW SYSTEM ONLY S. Abel 12/13/85

BLDG. PERMIT SIGNED
AND RETURNED 5-27-88 BP 18813 SAB

THIS IS NOT A PERMIT

①
SOIL PROFILE


0'	A-3
6"	BROWN CLAY LOAM 10% SAPROLITE
4'	BROWN SILTY SAND LOAM 10-20% SAPROLITE
12'	

②

0'	A-3
6"	BROWN SILTY CLAY LOAM 10% SAPROLITE
3'	BROWN SILTY SAND 10-20% SAPROLITE
12'	

④

0'	A-3
6"	RED BROWN CLAY LOAM 10% SAPROLITE
3'	BROWN SAND LOAM 20-30% SAPROLITE
11'	GRAY BROWN SILTY SAND 20-30% SAPROLITE
12'	

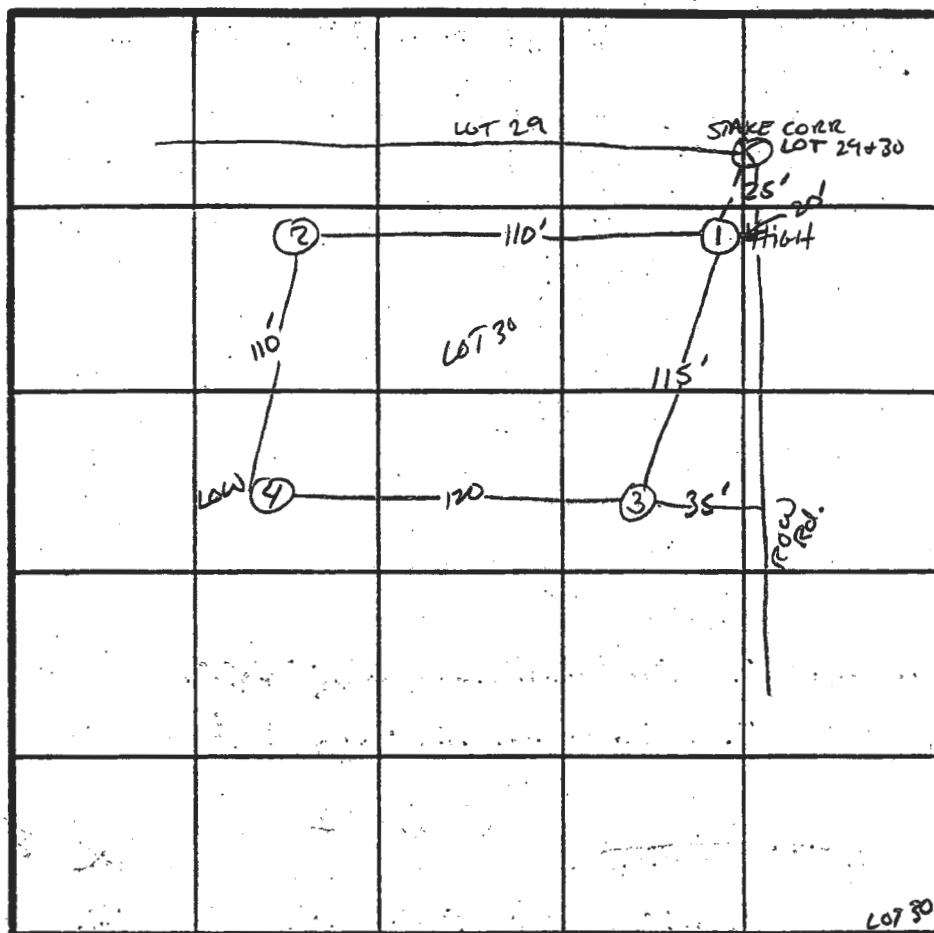

③

0'	A-3
6"	BROWN CLAY LOAM 10% SAPROLITE
3.5'	WHI TE/BROWN SILTY SAND 10-20% SAPROLITE
12'	

X Perc Time
12 min
INLET 3.5'
BOTTOM 5.0'

INDICATE NORTH - NAME ADJOINING ROADWAY AS BASE LINE.
BRIGHTON DAM Rd.

DATE	TEST NO.	DEPTH	PRE-WET		TEST - 1" DROP		TIME
			START	STOP	START	STOP	
4/2/85	1S	4'	2:19	2:40	4 1/2" movement	Shelf 1' deeper	
	1V	12'	UNIFORM SOIL STRUCTURE Below 4'				
	2S	3.5'	2:36	2:38	2:38	2:43	5min
	2V	12.5'	VARYING SOIL STRUCTURE SEE Profile				
	3S	4'	2:58	2:59	2:59	3:02	3min
	3V	12'	UNIFORM SOIL STRUCTURE Below 3.5'				
	4S	4'	2:49	2:52	2:52	2:57	5min
	4V	12'	VARYING SOIL STRUCTURE SEE Profile				
	1M	5'	2:40	2:53	2:53	2:18	25min

REMARKS SYSTEM FIRST - SHALLOW SYSTEM 12-13-85 8464

TYPE OF SOIL

TESTED BY SID Abel

LES, TERRY, DONNY
ALSO PRESENT

LOT 16
6.0739 AC. ±

BUILDING
RESTRICTION L



Howard County
Health Department

7178 Columbia Gateway Drive, Columbia MD 21046
(410) 313-2640 Fax (410) 313-2648
TDD (410) 313-2323 Toll Free 1-866-313-6300
website: www.hchealth.org

Peter L. Beilenson, M.D., M.P.H., Health Officer

MEMORANDUM

TO: Paul Sill
Sill, Adcock & Assoc.

FROM: Heidi Scott
Well and Septic Program
Development Coordination Section

RE: 12925 Wexford Park
Plot Plan

DATE: July 18th, 2008

The following comments apply to the above referenced plan. Please revise and resubmit prior to signature.

- Prior to building permit approval a Percolation Certification Plan must be submitted to our office for approval.
- Original percolation test data is enclosed. Due to the original test locations the sewage area as shown on the plot plan may have to be modified while also maintaining setbacks.
- A new plot plan must also be submitted to reflect the changes on the Perc Cert Plan

HS
Enclosures
Cc:
File