PERMIT

SEWAGE DISPOSAL SYSTEM

HOWARD COUNTY HEALTH DEPARTMENT

BUREAU OF ENVIRONMENTAL HEALTH 410-313-2640

ISSUE DATE

APPROVAL DATE _7-19-71

P_16108


INDEXED

	·	IS PERMIT	TED TO INSTALL	ALTER
ADDRESS			PHONE	
SUBDIVISION	LOT NUMBER	ADDRESS	1459 Underwood R	load
PROPERTY OWNERJohn _Jones	PROPERT	Y OWNER'S ADDR	ESS_Same	
SEPTIC TANK CAPACITY GAL	LONS			
PUMP CHAMBER CAPACITY	GALLONS			*
NUMBER OF BEDROOMS			•	
SQUARE FEET PER BEDROOM				
LINEAR FEET OF TRENCH REQUIRED				
TRENCHES: Trenches to be feet wi	de. Inlet feet bel	low original grade.	Bottom maximum dep	oth ·
feet below original grad LOCATION:	le. feet of stone be	elow distribution box		
	,			
PLANS APPROVED		·	DATE	
PERMIT VOID AFTER 2 YEARS				
NOTE: CONTRACTOR RESPONSIBLE FOR SCHEDU	LING A PRE-CONSTRUCTION	N INSPECTION FOR AL	L INSTALLATIONS	,
NOTE: TOP OF SEPTIC TANKS ARE TO BE NO DEEF	'ER THAN 3.0 FEET BELOW	FINISH GRADE	•	
NOTE: WATERTIGHT SEPTIC TANKS REQUIRED				
NOTE: CLEANOUT REQUIRED EVERY 70 FEET OF S ARE NOT ACCEPTABLE	EWER LINE AND/OR AT 90°	SWEEPS IN LINES FR	OM HOUSE TO DRAIN FI	ELDS, 90° ELBOWS
NOTE: ALL PARTS OF SEPTIC SYSTEMS (I.E. TANK OTHERWISE SPECIFICALLY AUTHORIZED	, DISTRIBUTION BOX, DRAI	NFIELDS) TO BE 100 F	EET FROM ANY WATER	WELL UNLESS
NOTE: NO ABSORPTION TRENCH TO EXCEED 100	FEET IN LENGTH UNLESS S	PECIFICALLY AUTHOR	RIZED	
NOTE: ALL PIPE FROM HOUSE TO SEPTIC TANK M	UST BE CAST IRON OR SCH	HEDULE 35/40 PVC OR	ABS	
NOTE: MANHOLE RISERS REQUIRED ON ALL SEPT	TO TANKS AND PUMP CHAI	MBERS		
NOTE: DISTRIBUTION BOXES MUST HAVE BAFFLE	s ·			
NOTE: IF PUMPED SEPTIC SYSTEM REQUIRED, (1) PERMIT (2) PUMP PERFORMANCE TEST IS I	SEPTIC PUMP DETAIL TO E NECESSARY PRIOR TO HEA	BE PROVIDED BY INSTA LITH DEPARTMENT AP	ALLER PRIOR TO ISSUAI PROVAL OF SEPTIC PE	NCE OF SEPTIC

SUCCESSFUL OPERATION OF ANY SYSTEM PERMITTEE RESPONSIBLE FOR OBTAINING FINAL APPROVAL ON THIS PERMIT CALL 410-313-2640 FOR INSPECTION OF SEPTIC SYSTEM

NEITHER THE HOWARD COUNTY COUNCIL NOR THE HEALTH DEPARTMENT IS RESPONSIBLE FOR THE

U

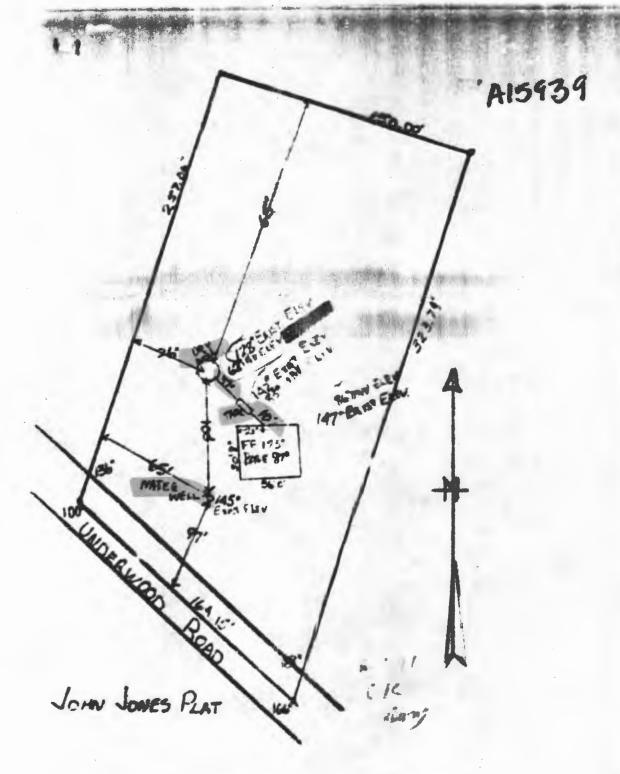

ELEV 2 : CTATED IN INCHES ON A WESSED LOT

If you have inconsuments and a lemetomodulpriones are
it is at first first growing.

489-4605 For 205 mil chely and