

APPLICATION

SEWAGE DISPOSAL TESTING

STATE OF MARYLAND - DEPARTMENT OF HEALTH AND MENTAL HYGIENE

A 31577

P _____

KAIS William
in Abel

HOWARD COUNTY HEALTH DEPARTMENT
ENVIRONMENTAL HEALTH SERVICES

P. O. BOX 476 ELLICOTT CITY, MARYLAND 21043
TELEPHONE: 992-2330

DISTRICT _____

DATE 2/26/86

TO: THE COUNTY HEALTH OFFICER
ELLICOTT CITY, MARYLAND

I, HEREBY, APPLY FOR THE NECESSARY TEST IN ORDER TO CONSTRUCT (OR RECONSTRUCT) A SEWAGE DISPOSAL SYSTEM.

✓ PROPERTY OWNER MICHAEL M RAMINIA

✓ ADDRESS 2823 LINWOOD AVE PHONE 301-668-1868

PROPERTY LOCATION:

✓ SUBDIVISION _____ LOT NO. B

✓ ROAD AND DESCRIPTION DAY ROAD AND UNDERWOOD - BACK ON
DAY ROAD 1000 FT.

✓ SIZE OF LOT 6 ACRES TYPE BLDG. 1 STORY CONTEMPORARY (3)
(NUMBER OF BEDROOMS)

THE SYSTEM INSTALLED UNDER THIS APPLICATION IS ACCEPTABLE ONLY UNTIL PUBLIC FACILITIES BECOME AVAILABLE. I FULLY UNDERSTAND THE
FEE CONNECTED WITH THE FILING OF THIS PERC TEST APPLICATION IS NON-REFUNDABLE UNDER ANY CIRCUMSTANCES. I ALSO AGREE TO COMPLY
WITH ALL M.O.S.H.A. REQUIREMENTS IN TESTING THIS LOT. ✓ Michael M Raminia

(SIGNATURE OF APPLICANT)

APPROVED BY _____ FOR _____ DATE _____

REJECTED BY _____ FOR _____ DATE _____

HOLD PENDING FURTHER TESTS _____ DATE _____

REASONS FOR REJECTION OR HOLDING _____

THIS IS NOT A PERMIT

(P)

SOIL PROFILE

Yellow/
brown
clay loam


chunky
tan brown
clay
loam



12'

no H₂O

(2)

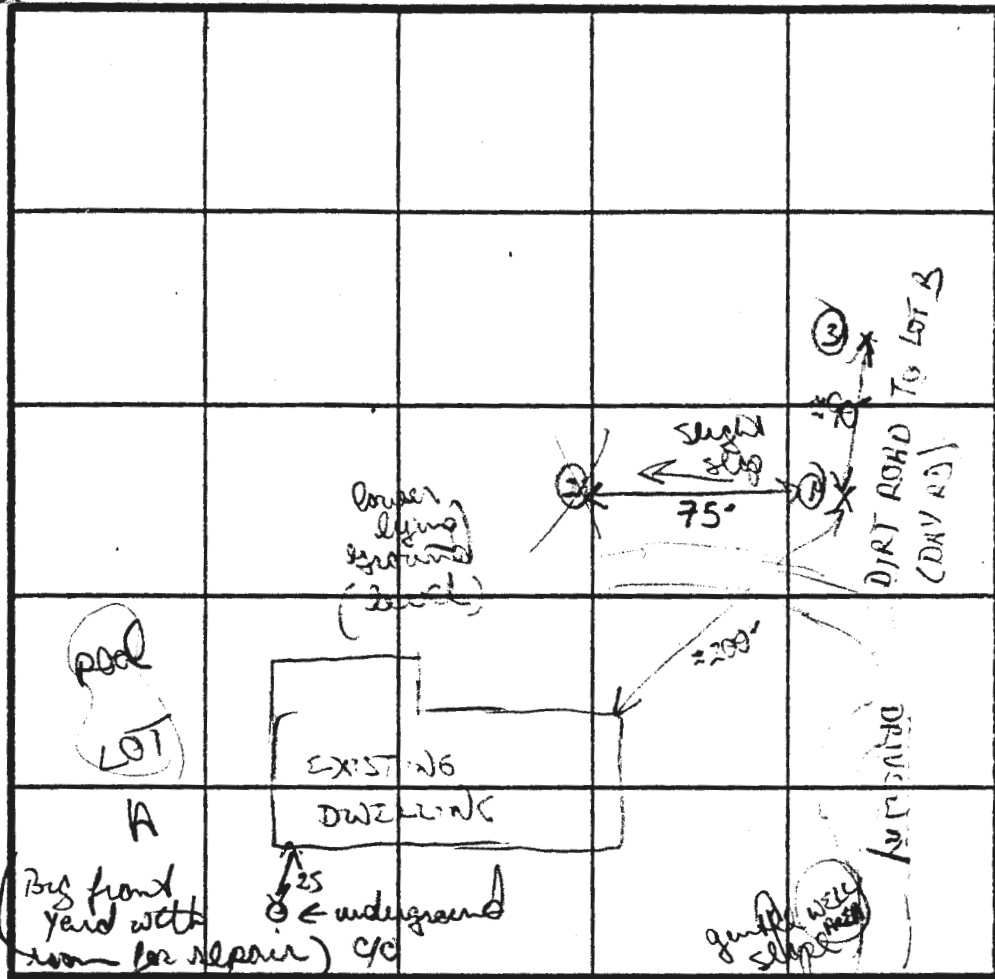

INDICATE NORTH - NAME ADJOINING ROADWAY AS BASE LINE.
 UNDER WOOD RD

DATE	TEST NO.	DEPTH	PRE-WET		TEST - 1" DROP		TIME
			START	STOP	START	STOP	
3/5/86	(5)	4 5	243	247	247	255	8 min
		12' 10'	bottom	(see profile)			
		test hole for Lot B					
3/5/86	(1)	4 1/2	314		Stopped after 30 min		
LOT A		12' 10'	bottom	(see profile)			
TEST HOLE							
	(3)	4 1/2	330		stopped at		
		12'	bottom	(see profile)			

REMARKS

TYPE OF SOIL

TESTED BY

ALSO PRESENT

M. Ramona / digger

Hole 2 no good, hole #1 questionable
 see other page for comments on Lot B perc
 Red/brown clays = clay loams


sandy
clay loam
with
grey mottles
soiled
areas
down
H₂O

12'

H₂O level
 ↑ = 6" after
 2 hours
 3

Red/brown
clay loam
changing
to red
brown
clay loam
w/ 10-15%
silt

NO LISTING FOR 1441 UNDERWOOD
— SELENE SMITH IS 1445 PARCEL 75 —

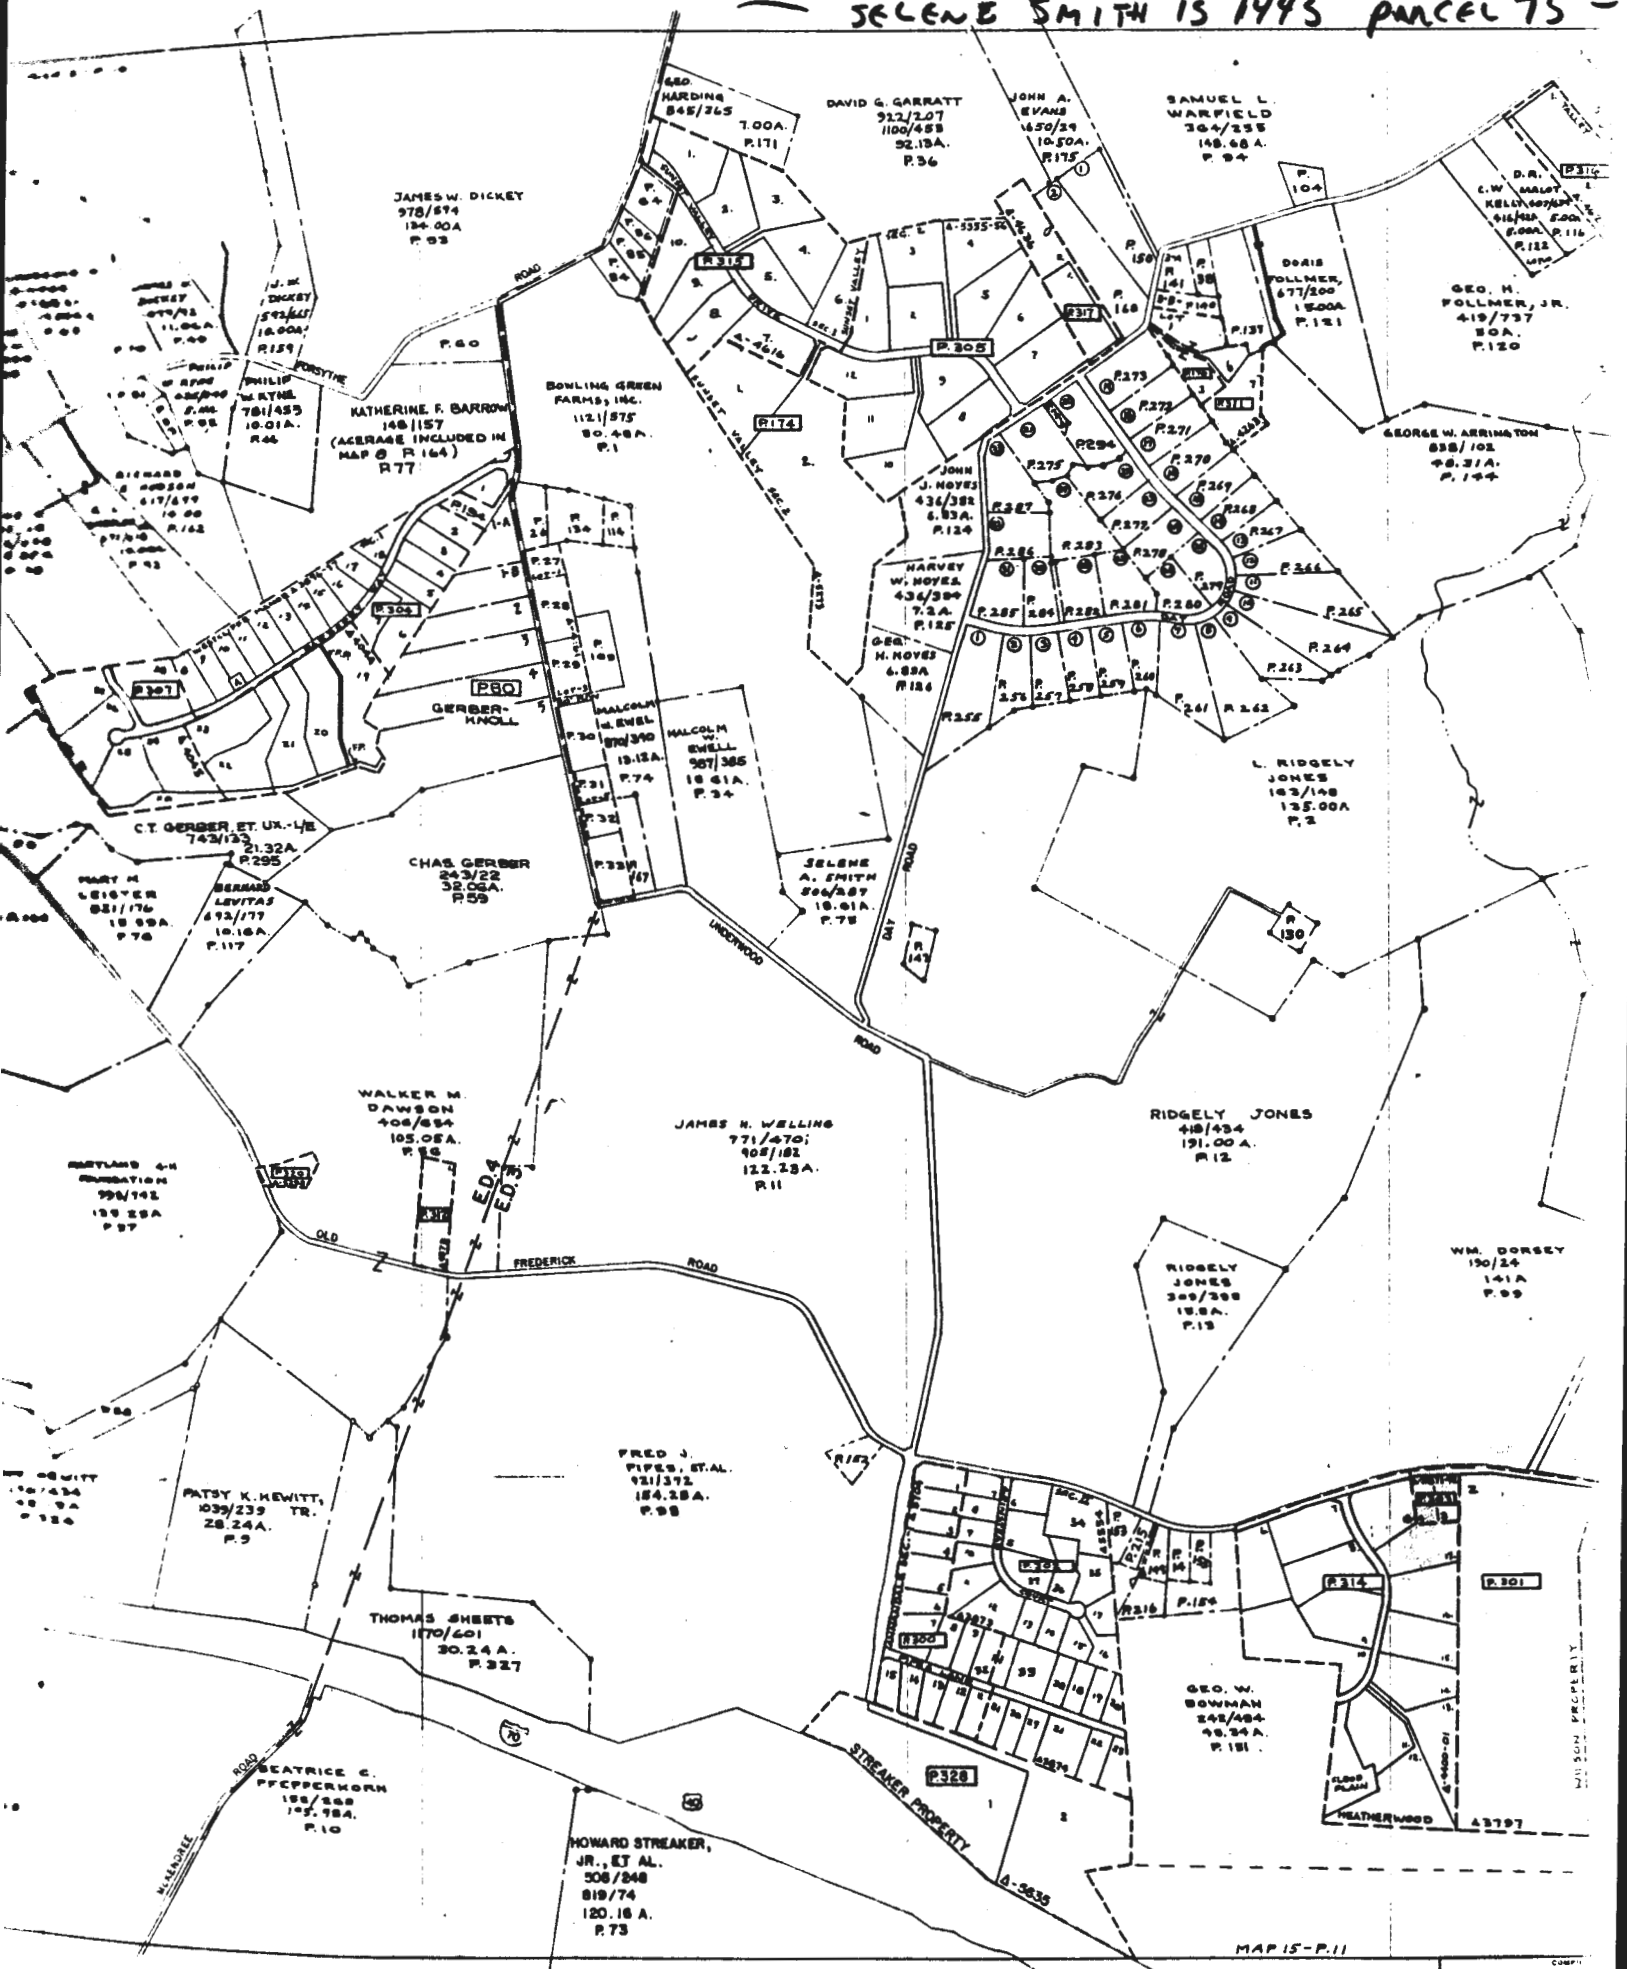

March 10, 1986

Mr. Michel Ramina
2823 Linwood Avenue
Baltimore, Maryland 21234

RE: Percolation Testing
Selene Smith Property
Tax Map 9 - Parcel 75

Dear Mr. Ramina:


Percolation testing conducted March 5, 1986 on the above referenced property indicated satisfactory soil conditions.

Approval of the subdivision is contingent upon submission by a registered engineer of a plat showing certified test hole locations and a suitable house and well site.

This should be submitted within sixty (60) days to allow field verification if necessary.

If you have any questions regarding this matter, please feel free to contact me at the above address or by calling 461-9933.

Very truly yours,

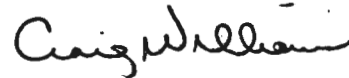

Craig Williams, Director
Water and Sewerage Program

CW:jr

APPLICATION

11/30 PM 86
CRAIG William
in Abel

HOWARD COUNTY HEALTH DEPARTMENT
ENVIRONMENTAL HEALTH SERVICES
P. O. BOX 476 ELLICOTT CITY, MARYLAND 21043
TELEPHONE: 992-2330

SEWAGE DISPOSAL TESTING

STATE OF MARYLAND - DEPARTMENT OF HEALTH AND MENTAL HYGIENE

A 31577

P _____

DISTRICT _____

DATE 2/26/86

3/5/86
P-1516
done
BW

TO: THE COUNTY HEALTH OFFICER
ELLICOTT CITY, MARYLAND

I, HEREBY, APPLY FOR THE NECESSARY TEST IN ORDER TO CONSTRUCT (OR RECONSTRUCT) A SEWAGE DISPOSAL SYSTEM.

✓ PROPERTY OWNER MICHEL M RAMINA

✓ ADDRESS 2823 LINWOOD AVE PHONE 301-668-1868

PROPERTY LOCATION:

✓ SUBDIVISION _____ LOT NO. B

✓ ROAD AND DESCRIPTION DAY ROAD AND UNDERWOOD - BACK ON
DAY ROAD 1000 FT.

✓ SIZE OF LOT 6 ACRES ✓ TYPE BLDG. 1 STORY CONTEMPORARY (3)
(NUMBER OF BEDROOMS)

THE SYSTEM INSTALLED UNDER THIS APPLICATION IS ACCEPTABLE ONLY UNTIL PUBLIC FACILITIES BECOME AVAILABLE. I FULLY UNDERSTAND THE

FEE CONNECTED WITH THE FILING OF THIS PERC TEST APPLICATION IS NON-REFUNDABLE UNDER ANY CIRCUMSTANCES. I ALSO AGREE TO COMPLY

WITH ALL M.O.S.H.A. REQUIREMENTS IN TESTING THIS LOT. ✓ Michel M Ramina
(SIGNATURE OF APPLICANT)

APPROVED BY _____ FOR _____ DATE _____

REJECTED BY _____ FOR _____ DATE _____

HOLD PENDING FURTHER TESTS _____ DATE _____

REASONS FOR REJECTION OR (HOLDING) Need certified plat for approval (LOT B)

3/5/86
NOTE: ATTEMPTS TO GET SUITABLE REPAIR AREA BEHIND HOUSE FOR LOT
NOT SUCCESSFUL; EXISTING SYSTEM IN FRONT; AND AMPLE AREA AVAILABLE
FOR FUTURE REPAIR SHOULD BE PRESENT.

THIS IS NOT A PERMIT

M. Ramina / 1222