

APPLICATION

SEWAGE DISPOSAL TESTING

STATE OF MARYLAND - DEPARTMENT OF HEALTH AND MENTAL HYGIENE

HOWARD COUNTY HEALTH DEPARTMENT
ENVIRONMENTAL HEALTH SERVICES

P.O. BOX 476 ELLICOTT, MARYLAND 21043
TELEPHONE: 992-2330

A 29313

P _____

DISTRICT 5th

DATE 12/6/78

TO: THE COUNTY HEALTH OFFICER
ELLICOTT CITY, MARYLAND

I, HEREBY, APPLY FOR THE NECESSARY TEST IN ORDER TO CONSTRUCT (OR RECONSTRUCT) A SEWAGE DISPOSAL SYSTEM.

PROPERTY OWNER Elmer H. Zederlein + Wife

ADDRESS 13809 Triadelphia Mill Rd. PHONE 596-9404

PROPERTY LOCATION:

SUBDIVISION Zederlein LOT NO. 2

ROAD AND DESCRIPTION 13801 Triadelphia Mill Road - uses this entrance

SIZE OF LOT 3 A.C.P.E. (out of 15 acre residue) TYPE BLDG. 3 or 4 bedroom Rancher

THE SYSTEM INSTALLED UNDER THIS APPLICATION IS ACCEPTABLE ONLY UNTIL PUBLIC FACILITIES BECOME AVAILABLE.

I FULLY UNDERSTAND THE FEE CONNECTED WITH THE FILING OF THIS PERC TEST APPLICATION IS NON-REFUNDABLE UNDER

ANY CIRCUMSTANCES.

SIGNATURE OF APPLICANT Elmer H. Zederlein

APPROVED BY _____ FOR _____ DATE _____

REJECTED BY _____ FOR _____ DATE _____


HOLD PENDING FURTHER TESTS _____ DATE _____

12/17/78 REASONS FOR ~~REASON~~ OR HOLDING for wet season test {possibly for shallow system if water table not too high.} + for signature C.B.A.

THIS IS NOT A PERMIT

SOIL PROFILE

Below
clay
Miss
House
↓

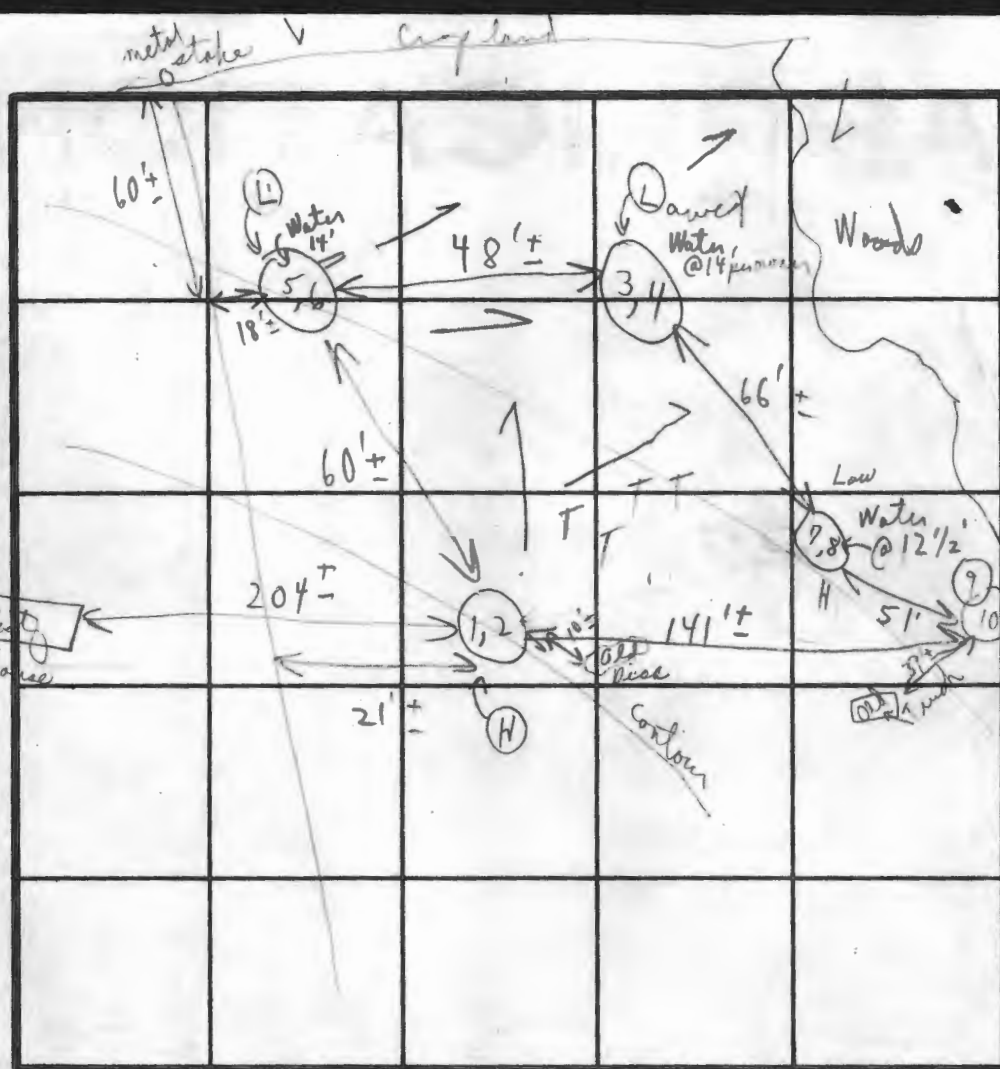

Field
sheet
Tests
not
per
stake

INDICATE NORTH - NAME ADJOINING ROADWAY AS BASE LINE.

DATE	TEST NO.	DEPTH	PRE-WET		TEST - 1" DROP		TIME
			START	STOP	START	STOP	
12/19/78	1	1	:	:	:	:	
	2	14'	10:02	10:20	10:20	10:53	1/2" at mud
	3	1	:	:	:	:	
	4	12'	Holes dry - no water		:	:	
	5	1	:	:	:	:	
	6	1	:	:	:	:	
	7	1	:	:	:	:	
	8	1	:	:	:	:	
	9	1	:	:	:	:	
	10	13 1/2'	10:05	10:15	10:15	10:42	27"

Water
per 2 elevations
that covered
over

} Water
14'

} Water @
12 1/2'

REMARKS

Tests in { brush near road & end memo } + wet season
{ + shallow tests of that time }

TYPE OF SOIL

No shelves dry

TESTED BY

C. B.


ALSO PRESENT

{ Mr. Zebert
Dave Smith
Howard Skinner }

TRIAD DELPHIA

N 10,250

E 5000

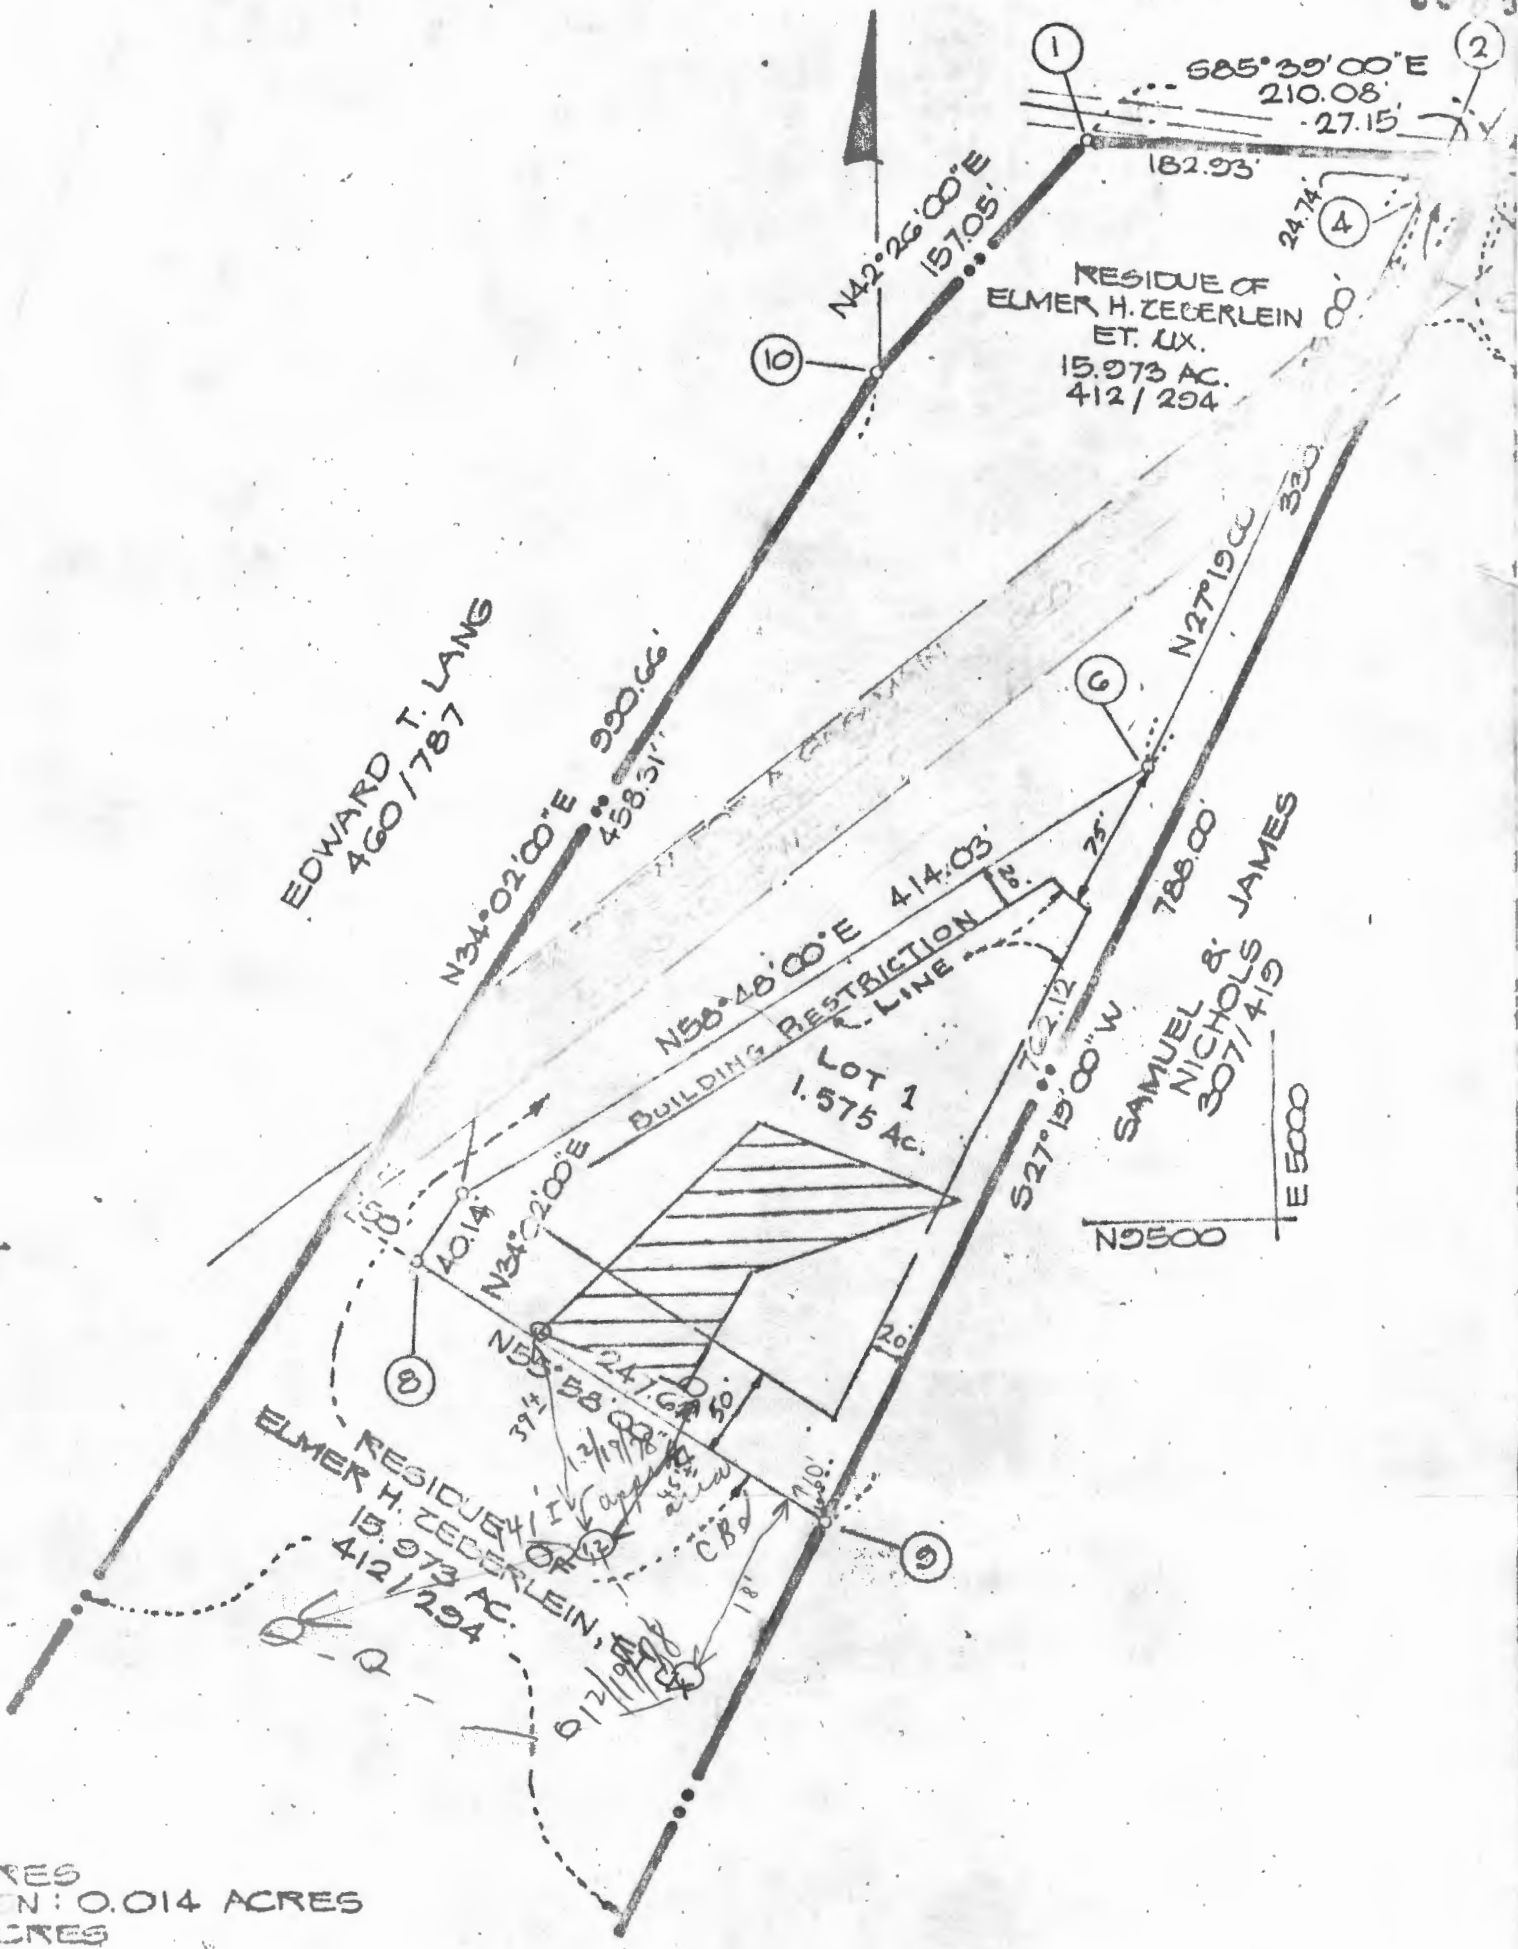


ACRES
ITION: 0.014 ACRES
ACRES

SECT ONE
AREA 2

BRIGHTON PINES LOT 1 & 2 A229313
FORMERLY ZEBER LINE PROP Lot 2

①
BROWN
CLAY
TUBSUL
PINK
BROWN
SAND
MICK
LOAM

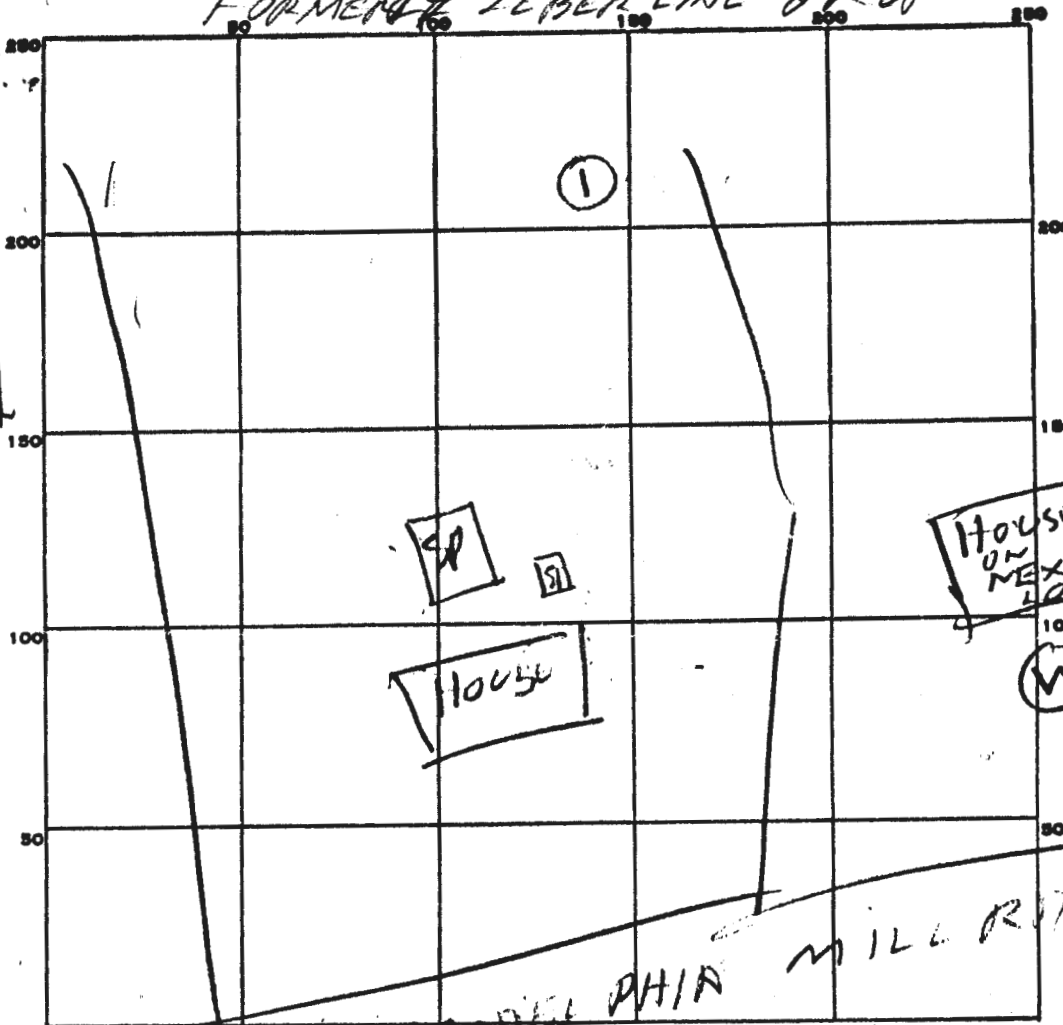


Lot 7

PERMIT CARD _____
SEPTIC TANK, LEVEL _____ CLEANOUTS _____
DISTRIBUTION BOX, LEVEL _____
TILE FIELD, DEPTH _____ FT. TRENCH WIDTH _____ FT.
GRAVEL DEPTH _____ IN. TOTAL LENGTH _____ FT.
NUMBER OF TRENCHES _____ TOTAL BOTTOM AREA _____
SEEPAGE PITS, INSIDE DIAMETER _____ FT. DEPTH BELOW INLET _____ FT.
ABSORBENT AREA _____ SQ. FT.

REMARKS 3/31/86-VISUAL HOLE OK

Lot 27

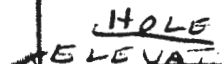

③② = HIGH

①④ = LOW

INDICATE NORTH - NAME ADJOINING ROADWAY AS BASE LINE

REMARKS

HOLE (2) DUG PER SURVEY OR STAKE

TYPE OF SOIL

R HODGES

ALSO PRESENT

Revised

