


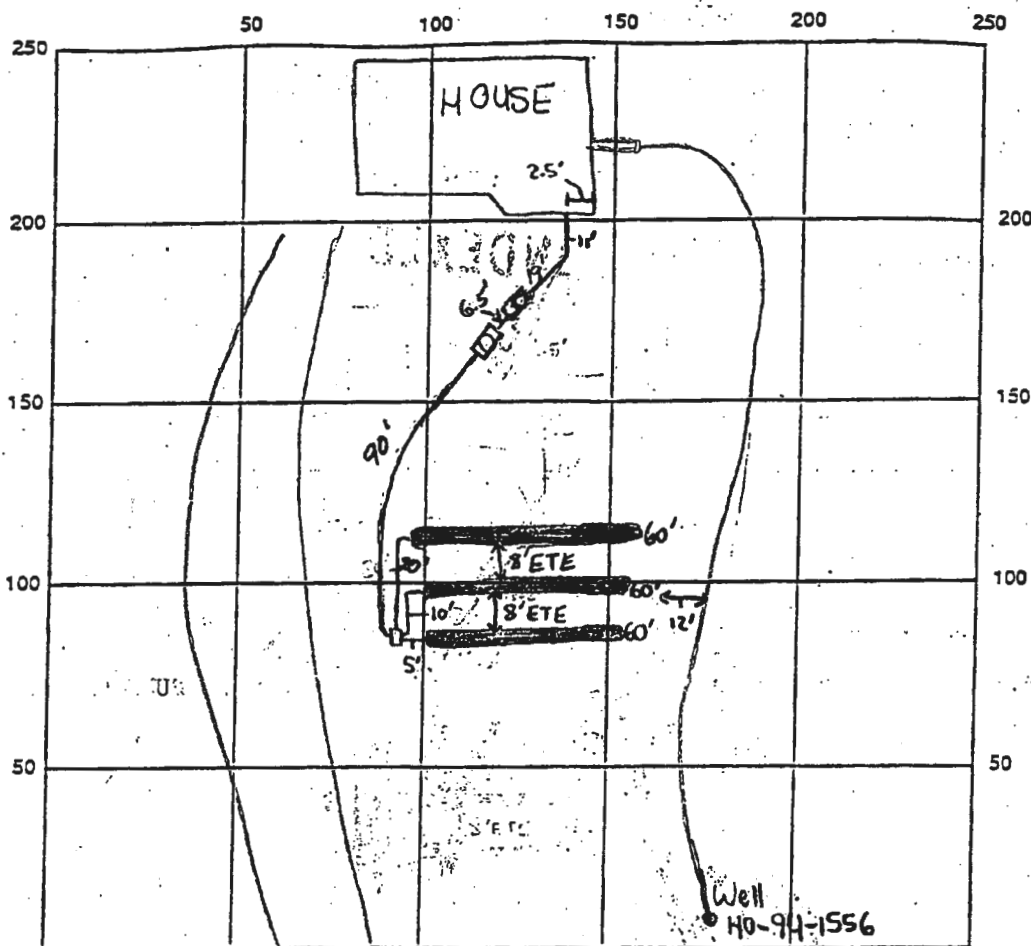

INDICATE NORTH - NAME ADJOINING ROADWAY AS BASE LINE

SEPTIC TANK LEVEL ✓ 1500 gallon topseam tank Manhole on Septic Tank
 CLEANOUTS Manhole on Pump Tank

DISTRIBUTION BOX LEVEL ✓

DRAIN FIELD/TITLE DEPTH 6.5 FT. TRENCH WIDTH 2 FT. INLET DEPTH 2.5 FT.

EFFECTIVE GRAVEL DEPTH 4 FT. TOTAL LENGTH 180 FT.

NUMBER OF TRENCHES 3 ONE SIDEWALL/BOTTOM AREA 720 SQ. FT.

DRYWALL INSIDE DIAMETER N/A FT. EFFECTIVE DEPTH BELOW INLET N/A FT.

ABSORBENT AREA N/A SQ. FT.

REMARKS: 7/17/00 - OK TO CONTINUE WORK (SRK) 7/18/00 System satisfactory. O.K.
to cover. Final approval pending pump and alarm test. (BB)
Pump test OK - minor leak at quick disconnect, but possible. R/P 8/2/00

DATE SYSTEM APPROVED

8/2/00

INSPECTOR

R/P Kelly

$$1'' = 100'$$

8/1/07

TO SERVE AS
PERC CERT PER MJD

NOTE: PUMP CHAMBER TO BE SAME
-- SIZE AS SEPTIC TANK.

NOTE: HEALTH DEPART. APPROVAL
OF THIS BUILDING PERMIT.
PLAN CONSTITUTES APPROVAL
OF THE DEPICTED AMENDMENT
TO THE RECORDED SEWAGE
DISPOSAL EASEMENT.

6/22/99 CW.

Ⓢ DENOTES EXISTING WELL

REVISED

Date: 6-28-99
14969 Philadelphia
Comments: 3001182

moved house &
Health Dept
request -
Septu

OK.
C

S 29°57'57" W 300.00'

100' LEAK FLOOD PLAIN
DRAINAGE & UTILITY EASE


FOREST
CONSERVATION
EASEMENT

A. SEPTIC TANK
*B. PUMP & ...
... PUMP CHAMBER
C. DISTRIBUTION
BOX.

* ALTERNATE ROUTE

DISTRICT 05 Acct# 428211


FOSTER RESIDENCE
14969 TRIADELPHIA ROAD
GLENELG, MD 21737

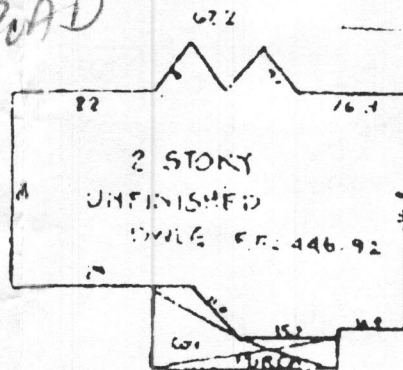


BASE DETAIL

20 X 40 INGROUND POOL W/ 3' DECK
W/ 4' FENCE PER HOWARD COUNTY CODE
X-X-X-X DENOTES FENCE
SETBACKS = REAR = 240'
FRONT = 300'
LEFT = 160'
RIGHT = 100'

MINIMUM DISTANCE TO WELL AND/OR WELL LINE = 140'

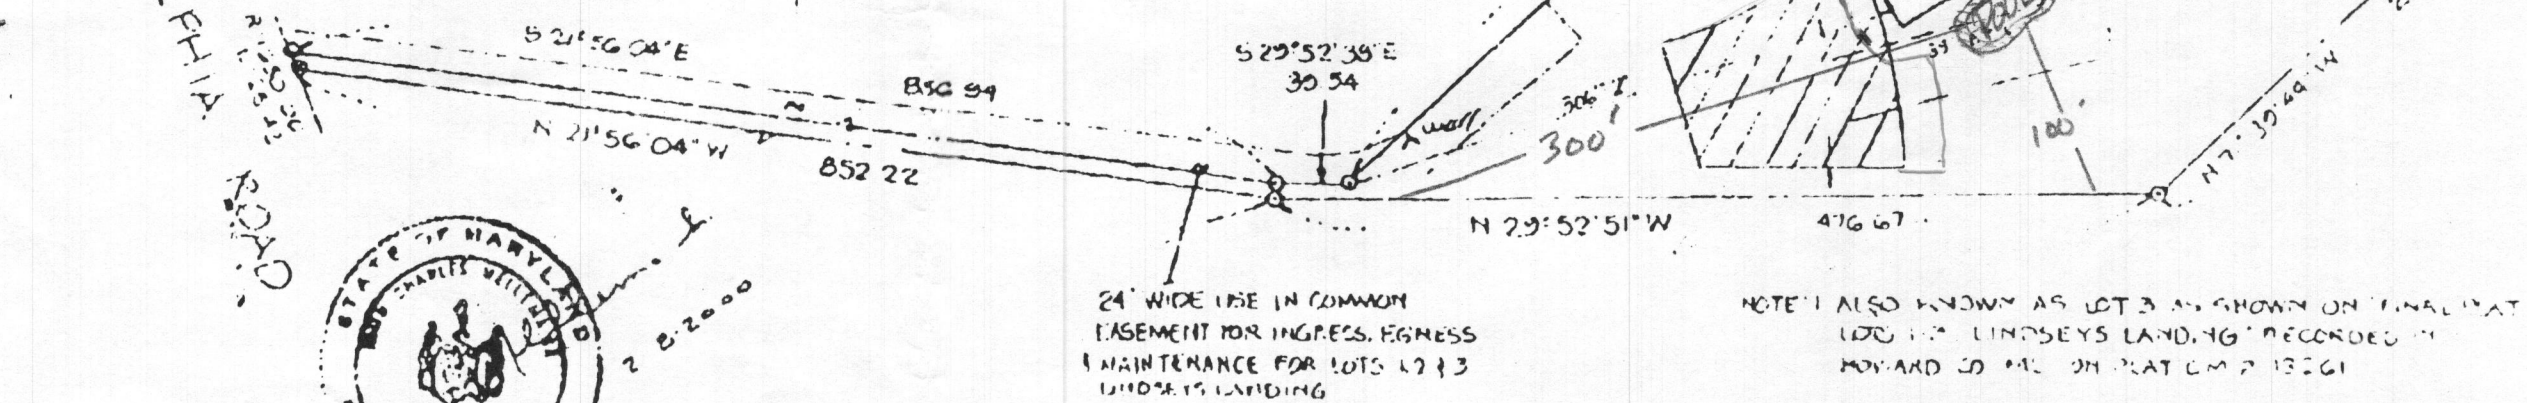

NOTE: ALSO KNOWN AS LOT 3 AS SHOWN ON FINAL PLAT
LOC. FOR LINDSEYS LANDING RECORDED IN
HOWARD CO. PL. ON PLAT CM 2 13261

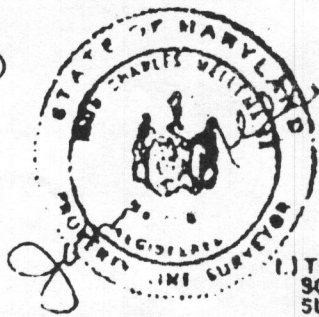

PREPARED BY:
JOHN C. MELLEMA SR., INC.
LAND SURVEYORS
5409 EAST DRIVE BALTO., MD. 21227

- 1.) THE PLAY IS OF BENEFIT TO A CONSUMER ONLY IN-
SO FAR AS IT IS REQUIRED BY A LENDER OR TITLE IN-
SURANCE COMPANY OR ITS AGENT IN CONNECTION OR
WITH CONTEMPLATED TRANSFER, FINANCING OR RE-
FINANCING.
- 2.) THE PLAY IS NOT TO BE RELIED UPON FOR THE ES-
TABLISHMENT OR LOCATION OF FENCES, GARAGES
BUILDING, OR OTHER EXISTING OR FUTURE IMPROVE-
MENTS.

3.)THE PLAT DOES NOT PROVIDE FOR THE ACCURATE IDENTIFICATION OF PROPERTY BOUNDARY LINES BUT SUCH IDENTIFICATION MAY NOT BE REQUIRED FOR THE TRANSFER OF TITLE OR SECURING FINANCING OR RE-FINANCING

LINDSEY'S LANDING

LOCATION	DRAWING
1	
2	
3	
ADDRESS: LOT 3 TRIADELPHIA ROAD

COUNTY: HOWARD CO. SCALE: 1" = 100'

DATE: 2800 IN NO. 2042