

# APPLICATION

SEWAGE DISPOSAL TESTING

STATE OF MARYLAND - DEPARTMENT OF HEALTH AND MENTAL HYGIENE

A 30916

P \_\_\_\_\_

HOWARD COUNTY HEALTH DEPARTMENT  
ENVIRONMENTAL HEALTH SERVICES  
P.O. BOX 476 ELLICOTT, MARYLAND 21043  
TELEPHONE: 992-2330

DISTRICT 2nd

DATE June 28, 1980

TO: THE COUNTY HEALTH OFFICER  
ELLICOTT CITY, MARYLAND

I, HEREBY, APPLY FOR THE NECESSARY TEST IN ORDER TO CONSTRUCT (OR RECONSTRUCT) A SEWAGE DISPOSAL SYSTEM.

PROPERTY OWNER Patapsco Associates Ltd Partnership Nedeljko MARJIC

ADDRESS 12116 Arble Road Silver Spring, Md 20904 PHONE 622-0646

PROPERTY LOCATION:

SUBDIVISION Patapsco Park Estates LOT NO. 8, Sec. 3

ROAD AND DESCRIPTION 9019 Furrow Avenue Extended

SIZE OF LOT 46,900 Sq. Ft. TYPE BLDG. Single Family

THE SYSTEM INSTALLED UNDER THIS APPLICATION IS ACCEPTABLE ONLY UNTIL PUBLIC FACILITIES BECOME AVAILABLE.

I FULLY UNDERSTAND THE FEE CONNECTED WITH THE FILING OF THIS PERC TEST APPLICATION IS NON-REFUNDABLE UNDER

ANY CIRCUMSTANCES.

SIGNATURE OF APPLICANT Simon Rosenberg, General Partner

APPROVED BY F. Skinn FOR Head DATE 9/28/83

REJECTED BY \_\_\_\_\_ FOR \_\_\_\_\_ DATE \_\_\_\_\_

HOLD PENDING FURTHER TESTS \_\_\_\_\_ DATE \_\_\_\_\_

REASONS FOR REJECTION OR HOLDING \_\_\_\_\_

BLDG. PERMIT SIGNED  
AND RETURNED 1-18-88

BP-16376  
SAC

# THIS IS NOT A PERMIT


8

SOIL PROFILE

SEE EACH HOLE BELOW

↓

FIELD SHEET

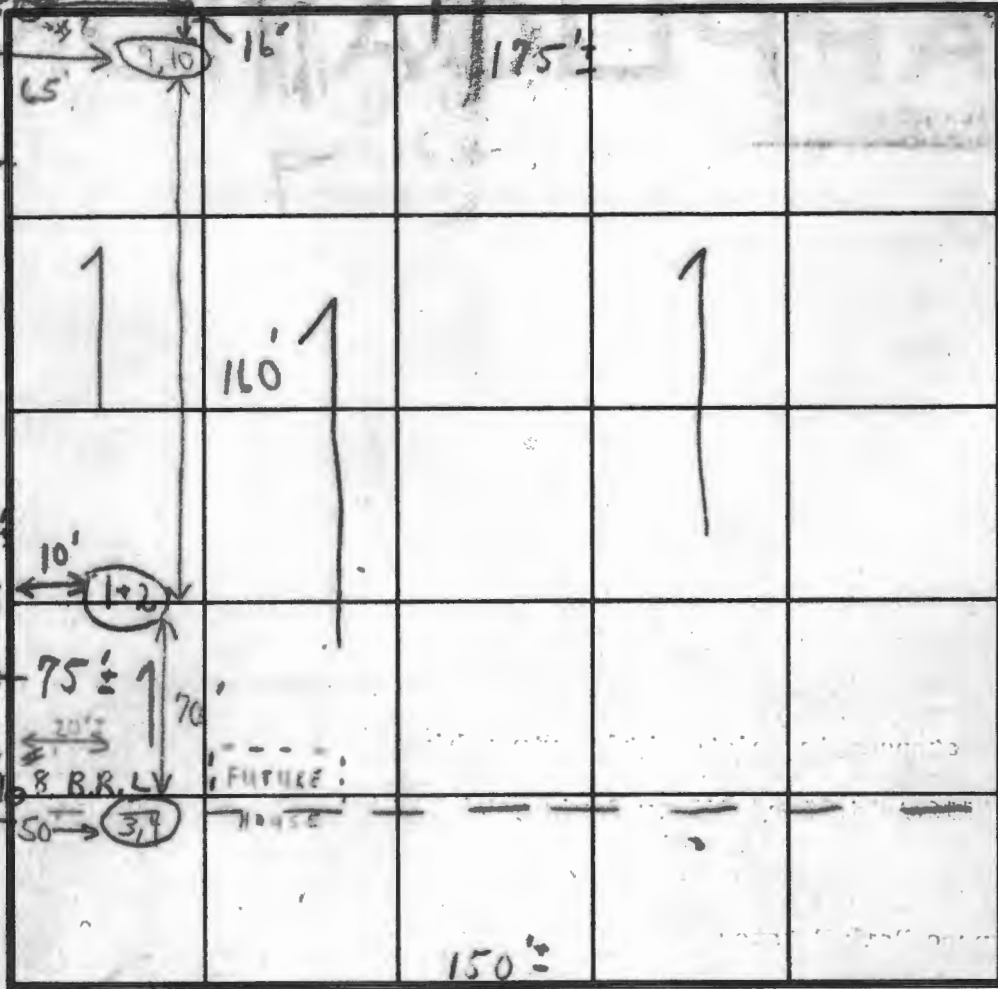

INDICATE NORTH - NAME ADJOINING ROADWAY AS BASE LINE.

FURROW AVENUE

SOIL PROFILE	DATE	TEST NO.	DEPTH	PRE-WET		TEST - 1" DROP		TIME
				START	STOP	START	STOP	
1' - 2' CLAY	9/24/20	1	2'	3:43	3:46	3:46	3:59	13 min
2' - 11' SANDY LOAM	C.B.S.	(M) 2	11'	3:30	3:33	3:33	3:40	7 min
1' - 1 1/2' CLAY	9/24/20	3	2'	1:23	1:25	1:25	1:27	2
1 1/2' - 7' (T.C.)	C.B.S.	(S) 4	9'-3"	1:20	1:25	1:25	1:34	9
1' - 2 1/2' CLAY		5	3'	1:44	1:46	1:46	1:48	2
2 1/2' - 10' LOAM SANDSTONE		6	10'-2"	1:39	1:41	1:41	1:50	9
0' - 7' SILTY		7	1 1/2'	2:21	2:24	2:24	2:28	4
1 1/2' - 10' LOAM SANDSTONE		8	10'	2:07	2:13	2:13	2:20	7
0' - 1' SILTY		9	2'	2:03	2:05	2:05	2:07	2
1' - 7 1/2' LOAM SANDSTONE		10	9 1/2'	2:58	3:02	3:02	3:20	18 min

REMARKS (9/24/20 TESTS IN OPEN-HOLD FOR FURTHER TESTS)

TYPE OF SOIL

TESTED BY C.B.S. ALSO PRESENT LENDRIM

*Pres.*

# APPLICATION

SEWAGE DISPOSAL TESTING

STATE OF MARYLAND - DEPARTMENT OF HEALTH AND MENTAL HYGIENE

A 30916

P \_\_\_\_\_

HOWARD COUNTY HEALTH DEPARTMENT  
ENVIRONMENTAL HEALTH SERVICES  
P.O. BOX 476 ELLICOTT, MARYLAND 21043  
TELEPHONE: 992-2330

DISTRICT 2nd

DATE June 28, 1980

TO: THE COUNTY HEALTH OFFICER  
ELLICOTT CITY, MARYLAND

I, HEREBY, APPLY FOR THE NECESSARY TEST IN ORDER TO CONSTRUCT (OR RECONSTRUCT) A SEWAGE DISPOSAL SYSTEM.

PROPERTY OWNER Patapasco Associates Ltd Partnership

ADDRESS 12116 Arble Road Silver Spring, Md 20904 PHONE 622-0646

PROPERTY LOCATION:

SUBDIVISION Patapasco Park Estates LOT NO. 8, Sec. 3

ROAD AND DESCRIPTION Furrow Avenue Extended

SIZE OF LOT 46,900 Sq. Ft. TYPE BLDG. Single Family

THE SYSTEM INSTALLED UNDER THIS APPLICATION IS ACCEPTABLE ONLY UNTIL PUBLIC FACILITIES BECOME AVAILABLE.

I FULLY UNDERSTAND THE FEE CONNECTED WITH THE FILING OF THIS PERC TEST APPLICATION IS NON-REFUNDABLE UNDER

ANY CIRCUMSTANCES:

SIGNATURE OF APPLICANT: Simon Rosenberg General Partner

APPROVED BY \_\_\_\_\_ FOR \_\_\_\_\_ DATE \_\_\_\_\_


REJECTED BY \_\_\_\_\_ FOR \_\_\_\_\_ DATE \_\_\_\_\_

HOLD PENDING FURTHER TESTS \_\_\_\_\_ DATE \_\_\_\_\_


REASONS FOR REJECTION OR HOLDING \_\_\_\_\_

# THIS IS NOT A PERMIT

8  
VOID - SEE  
SOIL PROFILE NEXT  
PAGE

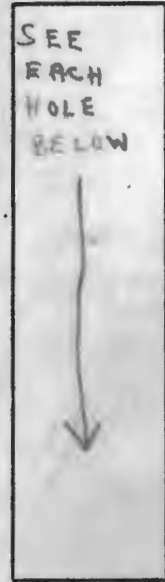

FIELD SHEET

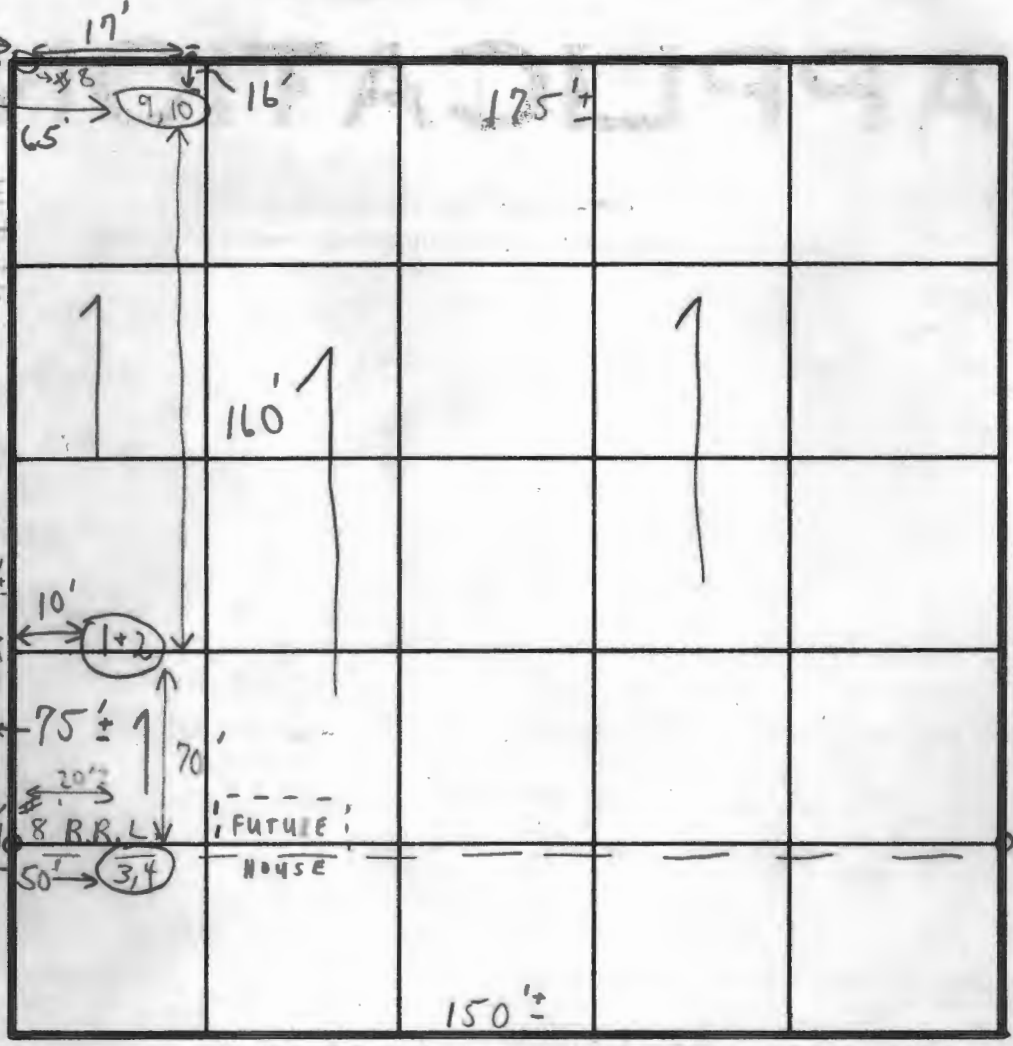

INDICATE NORTH - NAME ADJOINING ROADWAY AS BASE LINE.  
FURROW AVENUE

SOIL PROFILE  
1' - 2' CLAY  
2' - 11' SANDY LOAM  
1' - 14 1/2' CLAY  
MICA LOAM + SANDSTONE  
1 1/2' - 9' - 3' (TOE) (CBSE ALTD BASE)  
1' - 2 1/2' LOAM + SANDSTONE  
2 1/2' 10' - 8"  
0' - 1' CLAYEST  
1 1/2' - 10' LOAM + SANDSTONE  
0' - 1' CLAYEST  
1' - 9 1/2' LOAM + SANDSTONE

SOIL PROFILE	DATE	TEST NO.	DEPTH	PRE-WET		TEST - 1" DROP		TIME
				START	STOP	START	STOP	
1' - 2' CLAY	9/24/80	1	2'	3:43	3:46	3:46	3:59	13 min
2' - 11' SANDY LOAM	C.B.S.	2	11'	3:30	3:33	3:33	3:40	7 min
1' - 14 1/2' CLAY	9/24/80	3 <sup>Hand</sup>	2'	1:23	1:25	1:25	1:27	2 min
1 1/2' - 9' - 3' (TOE) (CBSE ALTD BASE)		4 <sup>M</sup>	9'-3"	1:20	1:25	1:25	1:34	9 min
1' - 2 1/2' LOAM + SANDSTONE		5	3'	1:44	1:46	1:46	1:48	2 min
2 1/2' 10' - 8"		6	10'-8"	1:39	1:41	1:41	1:50	9 min
0' - 1' CLAYEST		7	1 1/2'	2:21	2:24	2:24	2:28	4 min
1 1/2' - 10' LOAM + SANDSTONE		8 <sup>M</sup>	10'	2:09	2:13	2:13	2:20	7 min
0' - 1' CLAYEST		9	2'	3:03	3:05	3:05	3:07	2 min
1' - 9 1/2' LOAM + SANDSTONE		10	9 1/2'	2:58	3:02	3:02	3:20	18 min

REMARKS (9/24/80 TESTS IN OPEN-HOLD FOR FURTHER TESTS)

TYPE OF SOIL \_\_\_\_\_

TESTED BY C.B.S. ALSO PRESENT LENDRIM

1st of year times

2'

120 yft per bedroom

3 min avg.

# APPLICATION

A A 30916

SEWAGE DISPOSAL TESTING

STATE OF MARYLAND - DEPARTMENT OF HEALTH AND MENTAL HYGIENE

P \_\_\_\_\_

HOWARD COUNTY HEALTH DEPARTMENT  
ENVIRONMENTAL HEALTH SERVICES  
P.O. BOX 476 ELLICOTT, MARYLAND 21043  
TELEPHONE: 992-2330

DISTRICT \_\_\_\_\_

DATE \_\_\_\_\_

TO: THE COUNTY HEALTH OFFICER  
ELLICOTT CITY, MARYLAND

I, HEREBY, APPLY FOR THE NECESSARY TEST IN ORDER TO CONSTRUCT (OR RECONSTRUCT) A SEWAGE DISPOSAL SYSTEM.

PROPERTY OWNER \_\_\_\_\_

ADDRESS \_\_\_\_\_ PHONE \_\_\_\_\_

PROPERTY LOCATION:

SUBDIVISION PATAPSCO PARK ESTATES LOT NO. LOT 8

ROAD AND DESCRIPTION \_\_\_\_\_

SIZE OF LOT \_\_\_\_\_ TYPE BLDG. \_\_\_\_\_

THE SYSTEM INSTALLED UNDER THIS APPLICATION IS ACCEPTABLE ONLY UNTIL PUBLIC FACILITIES BECOME AVAILABLE.

I FULLY UNDERSTAND THE FEE CONNECTED WITH THE FILING OF THIS PERC TEST APPLICATION IS NON-REFUNDABLE UNDER ANY CIRCUMSTANCES.

SIGNATURE OF APPLICANT \_\_\_\_\_

APPROVED BY \_\_\_\_\_ FOR \_\_\_\_\_ DATE \_\_\_\_\_

REJECTED BY \_\_\_\_\_ FOR \_\_\_\_\_ DATE \_\_\_\_\_

HOLD PENDING FURTHER TESTS \_\_\_\_\_ DATE \_\_\_\_\_



REASONS FOR REJECTION OR HOLDING 10/7/80 HOLD FOR REVIEW SPECIAL SITUATION

# THIS IS NOT A PERMIT

PERC ON LOT 8 TO BE USED FOR ATTACHE ON LOT 7

Use 8

(A)  
SOIL PROFILE

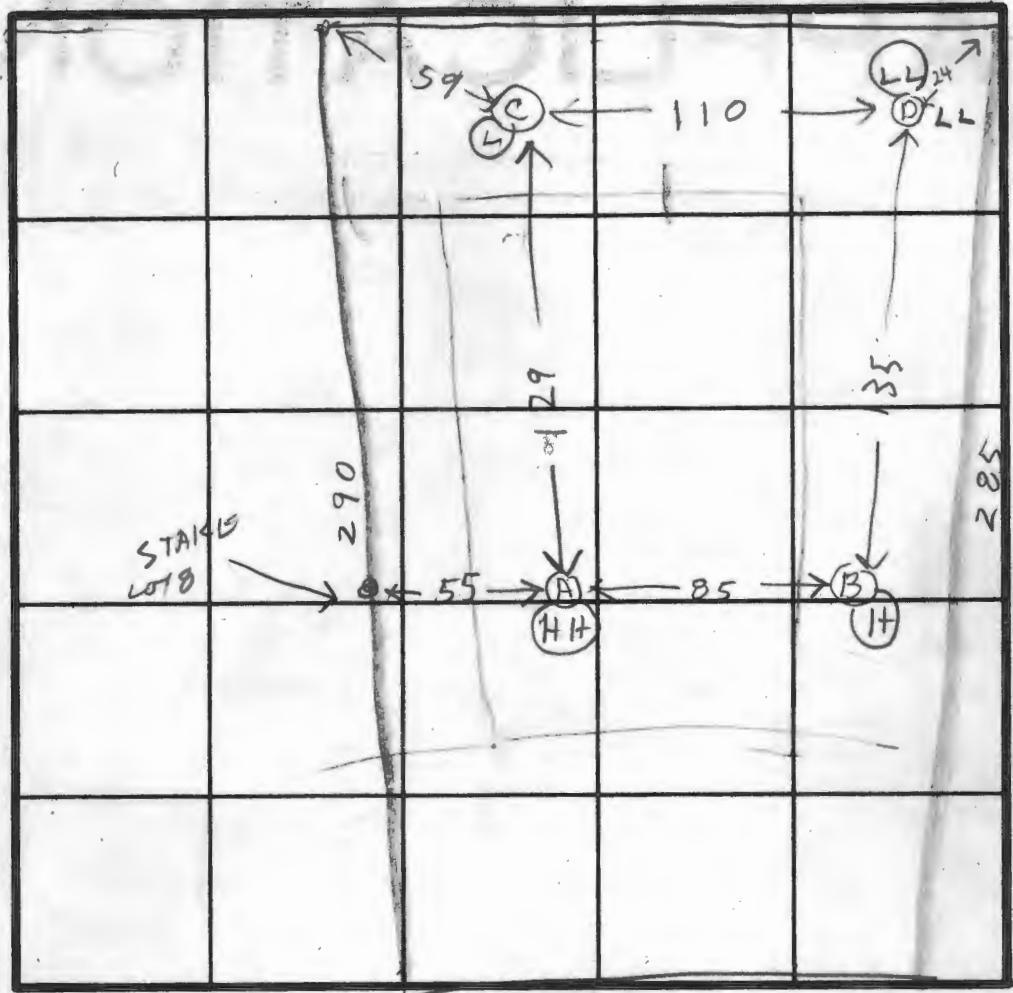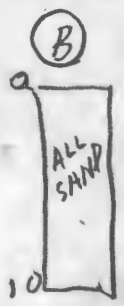

STAKES LOT 7 & 8

INDICATE NORTH - SAME ADJOINING ROADWAY AS BASE LINE.

DATE	TEST NO.	DEPTH	PRE-WET		TEST - 1" DROP		TIME
			START	STOP	START	STOP	
10/7/00	AS	2	1101	1104	1104	1114	10
	AD	8	1101	1104	1104	1107	3
	BS	2	1110	1111	1111	1112	1
	BD	10	1110	1112	1112	1116	4
	CS	2 1/2	1121	1122	1122	1123	1
	CD	10	1121	1126	1126	1140	14
	DS	2 1/2	1132	1137	1137	1144	7
	DD	11	1136	1138	1138	1140	2
						8	42

1 sec of Perc Time

Unlit

6 min avg.

120 yft per bedrock

REMARKS

TYPE OF SOIL


TESTED BY

J STAYER

ALSO PRESENT

P LINDRIN

Permit

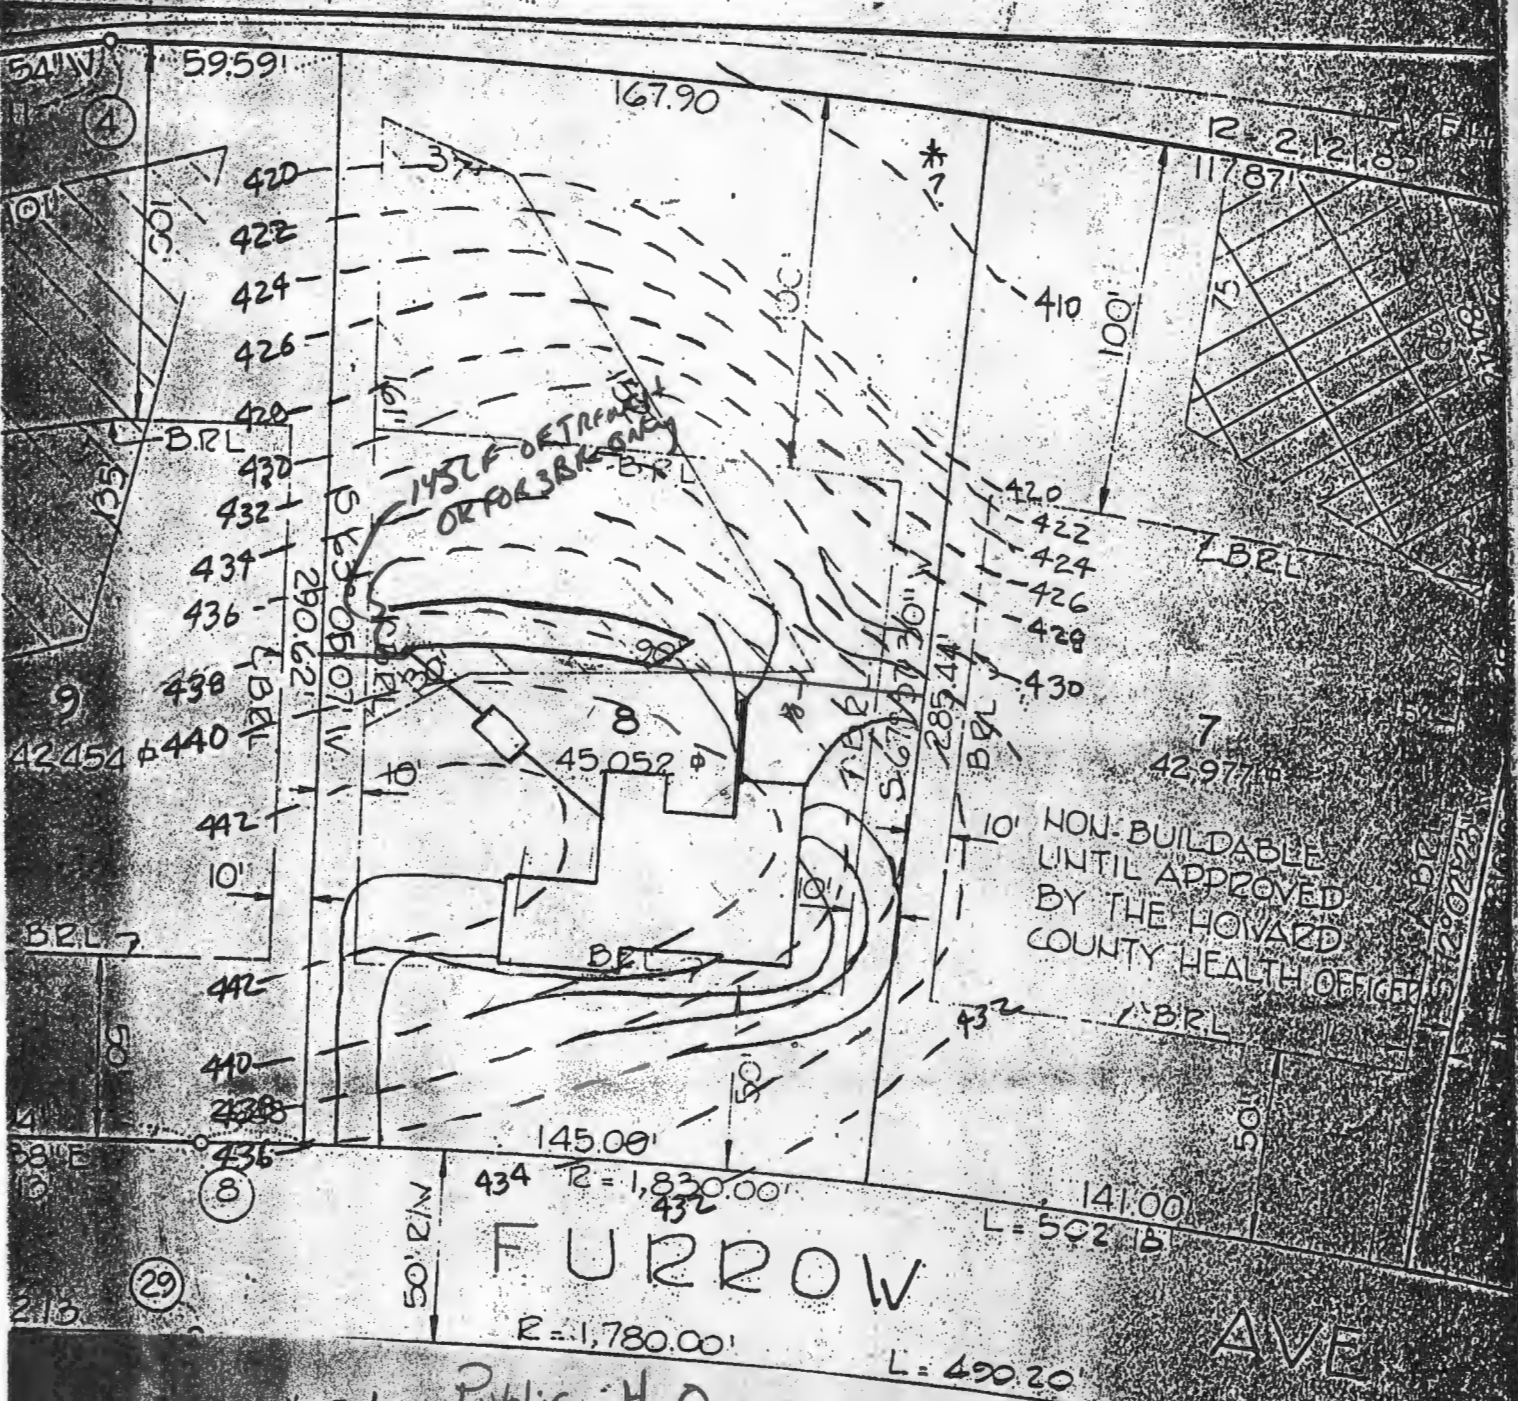

- Scale 1"=50'
- Contour Interval 2'
- First Floor Elev. = 443.0 ✓
- Bsmt Elev. = 439.0 ✓
- Into Field = 435.0 ✓
- Out of Tank = 435.5 ✓
- Into Tank = 435.8 ✓
- Out of House = 437.0 ✓
- Public Water
- Future Sewer

Public H<sub>2</sub>O

NO ESSENTIAL GRAVITY

INSTALL Full SYST


MATESIC Residence  
 Lot B  
 Patapsco Park Estates  
 Furrow Ave.  
 RCM Corporation  
 5520 Cedar Lane  
 Columbia, MD 21044  
 9950133

1/18/88  
 M...  
 OM

BLDG. PERMIT SIGN  
 AND RETURNED  
 BP 163

B.P. # 16376  
adjusted house location

Permit

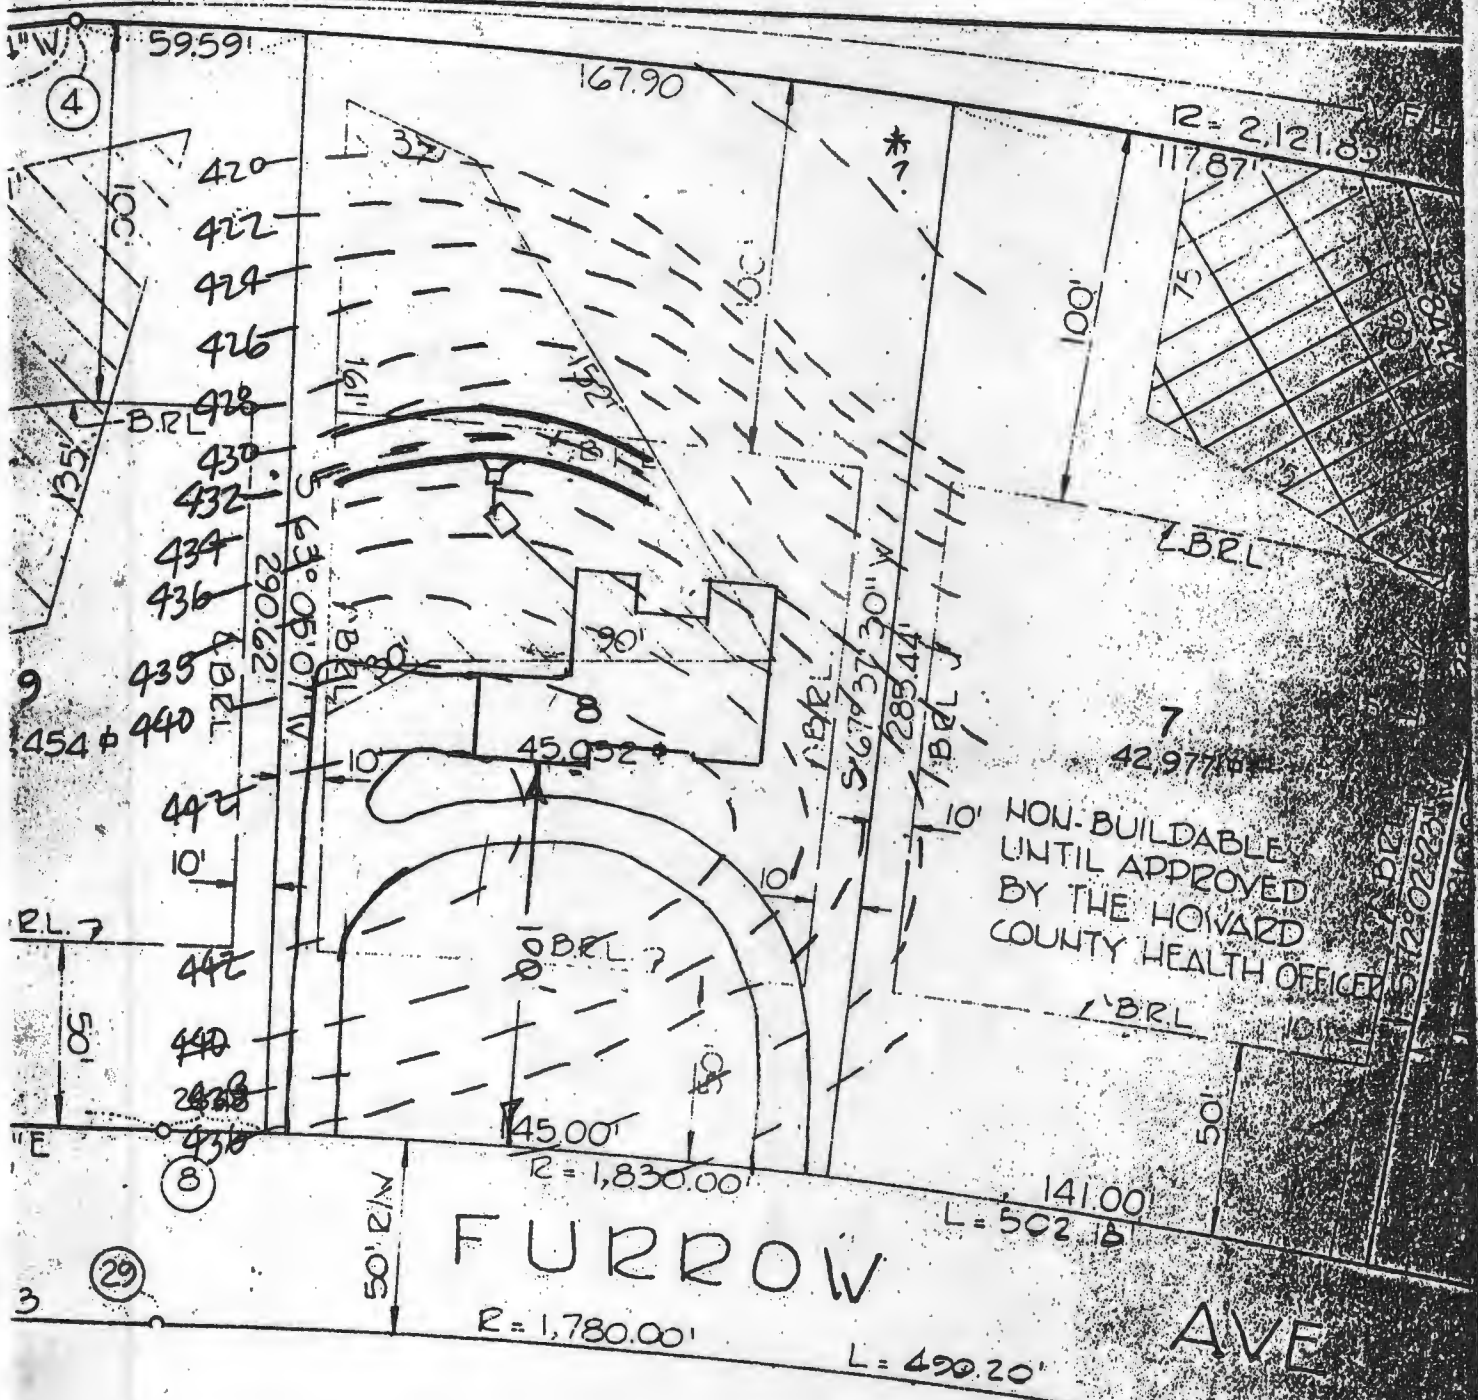

Scale 1" = 50'  
Contour Interval 2'

1" Exist. Gd at Field	= 432.5
Into Field	= 428.5
First Flr. Elev	= 443.0
Bsm <sup>4</sup> Elev.	= 434.0
Out of House	= 432.0
Into Tank	= 431.0
Out of Tank	= 430.5

MATESIC RESIDENCE  
 Lot 8  
 Patapsco Park Estates  
 Furrow Avenue  
 RCM Corporation  
 5520 Cedar Lane  
 Columbia, MD 21044  
 9950133



SUBDIVISION: PATAPSCO PARK EST. SEC 3

LOT NUMBER: 8

DRY WELL OR DRY WELL AND TRENCH

Public Sewer in  
Future. Install Full  
System.

Public H<sub>2</sub>O

	Septic Tank	_____ sq. ft./bedroom	Minimum Total square Feet
3 bedroom	1000 gallon		_____
4 bedroom	1250 gallon		_____
5 bedroom	1500 gallon		_____

Inlet \_\_\_\_\_ feet below original grade.

Bottom maximum depth \_\_\_\_\_ feet below original grade.

Effective area begins at \_\_\_\_\_ feet below original grade.

NOTE: If trench is used to make up absorbent area, run the trench on level ground and leave a 5 foot earth buffer between dry well and trench. No trench is to exceed 100 feet in length. Trench inlet to be same as dry well, with \_\_\_\_\_ feet of stone below distribution pipe.

TRENCHES

158 sq. ft./bedroom

Trench to be 2 wide.

Inlet 4 feet below original grade.

Bottom maximum depth 8 feet below original grade.

Effective area begins at 4 feet below original grade.

4 feet of stone below distribution pipe.

- NOTE:
- (1) No trench to exceed 100 feet in length.
  - (2) If more than one trench used, a distribution box is required.
  - (3) Trenches to be installed on level ground.
  - (4) Call for inspection of trench before gravel is installed.
  - (5) Provide 6"-8" diameter cleanout and cap to grade or above on septic tank and drywell.
  - (6) If a Garbage disposal is used, increase septic tank capacity by 50% and increase absorbant sidewall area by 22%.

LOCATION: START FIRST TRENCH 125' DOWN THE LEFT LOT LINE  
AND 20' FROM THE LEFT LOT LINE AS SEEN WHEN FACING  
THE PROPERTY FROM FURROW AVE. RUN TRENCH ALONG  
LEVEL GROUND TOWARD RIGHT LOT LINE.

9-27-83 C. Williams

UPDATED 1-18-88 S. A. [Signature]

Real Property Data Search ( w3)

Search Result for HOWARD COUNTY

View Map		View GroundRent Redemption			View GroundRent Registration					
<b>Tax Exempt:</b>		<b>Special Tax Recapture:</b>								
<b>Exempt Class:</b>		NONE								
<b>Account Identifier:</b>		District - 02 Account Number - 284367								
Owner Information										
<b>Owner Name:</b>		NICHOLAS AARON A			<b>Use:</b>		RESIDENTIAL			
<b>Mailing Address:</b>		9019 FURROW AVE ELLCOTT CITY MD 21042-1841			<b>Principal Residence:</b>		YES			
					<b>Deed Reference:</b>		/10748/ 00565			
Location & Structure Information										
<b>Premises Address:</b>		9019 E FURROW AVE ELLCOTT CITY 21042-0000			<b>Legal Description:</b>		LOT 8 1.034 A 9019 FURROW AVE PATAPSCO PK EST S 3 AR 1			
<b>Map:</b>	<b>Grid:</b>	<b>Parcel:</b>	<b>Sub District:</b>	<b>Subdivision:</b>	<b>Section:</b>	<b>Block:</b>	<b>Lot:</b>	<b>Assessment Year:</b>	<b>Plat No:</b>	5291
0017	0005	0330		9114			8	2019		<b>Plat Ref:</b>
<b>Special Tax Areas:</b>					<b>Town:</b>		NONE			
					<b>Ad Valorem:</b>		104			
					<b>Tax Class:</b>					
<b>Primary Structure Built</b>		<b>Above Grade Living Area</b>		<b>Finished Basement Area</b>		<b>Property Land Area</b>		<b>County Use</b>		
1988		3,256 SF				1.0300 AC				
<b>Stories</b>	<b>Basement</b>	<b>Type</b>	<b>Exterior</b>	<b>Full/Half Bath</b>	<b>Garage</b>	<b>Last Major Renovation</b>				
1 1/2	YES	STANDARD UNIT	BRICK	3 full/ 1 half	1 Attached					
Value Information										
		<b>Base Value</b>		<b>Value</b>		<b>Phase-in Assessments</b>				
				As of		As of		As of		
				01/01/2019		07/01/2018		07/01/2019		
<b>Land:</b>		168,300		213,900						
<b>Improvements</b>		464,500		520,900						
<b>Total:</b>		632,800		734,800		632,800		666,800		
<b>Preferential Land:</b>		0						0		
Transfer Information										
<b>Seller:</b> WL NICHOLS JR REVOCABLE TRUST			<b>Date:</b> 06/20/2007			<b>Price:</b> \$875,000				
<b>Type:</b> ARMS LENGTH IMPROVED			<b>Deed1:</b> /10748/ 00565			<b>Deed2:</b>				
<b>Seller:</b> MATESIC NEDELJKO			<b>Date:</b> 08/15/2005			<b>Price:</b> \$800,000				
<b>Type:</b> ARMS LENGTH IMPROVED			<b>Deed1:</b> /09395/ 00685			<b>Deed2:</b>				
<b>Seller:</b> WEITZ BENJAMIN B ET AL			<b>Date:</b> 11/30/1982			<b>Price:</b> \$49,400				
<b>Type:</b> ARMS LENGTH IMPROVED			<b>Deed1:</b> /01130/ 00780			<b>Deed2:</b>				
Exemption Information										
<b>Partial Exempt Assessments:</b>		<b>Class</b>		07/01/2018		07/01/2019				
<b>County:</b>		000		0.00						
<b>State:</b>		000		0.00						
<b>Municipal:</b>		000		0.00 0.00		0.00 0.00				
<b>Tax Exempt:</b>		<b>Special Tax Recapture:</b>								
<b>Exempt Class:</b>		NONE								