

APPLICATION

SEWAGE DISPOSAL TESTING

A 16950

P _____

MARYLAND STATE DEPARTMENT OF HEALTH

HOWARD COUNTY

1000 GAL TANK - 3 BR

1250 GAL TANK - 4 BR

ELLICOTT CITY

DRYWELL - 3 BR - 360 SQ FT SIDEWALL AREA BELOW INLET DISTRICT 1

4 BR 480 SQ FT SIDEWALL AREA BELOW INLET DATE 4/24/72

DRY WELL INLET TO BE 5 FT DEEP AND BOTTOM OF DRY WELL TO BE 10 FT DEEP

PLACE THE DRY WELL 160 FT FROM THE FRONT LOT LINE AND 30 FT FROM THE LEFT SIDE OF THE LOT AS SEEN WHEN FACING THE LOT FROM

TO: THE COUNTY HEALTH OFFICER EVERLEA RD
ELLICOTT CITY, MARYLAND

OK to move dry well 10' per DWM

I, HEREBY, APPLY FOR THE NECESSARY TESTS IN ORDER TO CONSTRUCT (OR RECONSTRUCT) A SEWAGE DISPOSAL SYSTEM.

PROPERTY OWNER E. L. Ransburg

John B. Reichenbach, Jr.

ADDRESS 185 Henryton Road, Marriottsville, Md. PHONE 328-2696

PROPERTY LOCATION: 8755-C Town & Country Blvd.
Ellicott City, Md. 21043

SUBDIVISION Everlea LOT NO. 7. Blk. 2, Sec. 1

ROAD AND DESCRIPTION Everlea Road

OCCUPANT _____ PHONE _____

PERSON TO CONSTRUCT SYSTEM _____

ADDRESS _____ PHONE _____

SIZE OF LOT 83' x 503' x 150' x 62' x 156' x 308' TYPE BLDG. 1 or 4

NUMBER OF BEDROOMS

IF NOT SINGLE RESIDENCE DESCRIBE _____ (Single Fmly. Dwlg.)

SIGNATURE OF APPLICANT /s/ E. L. Ransburg

✓ APPROVED BY BH FOR DRYWELL DATE 4/18/75
(KIND OF SYSTEM)


REJECTED BY _____ FOR _____ DATE _____
(KIND OF SYSTEM)

HOLD PENDING FURTHER TESTS _____ DATE _____

REASONS FOR REJECTION OR HOLDING 4/18/75 - FINAL PLAT HAS BEEN

SIGNED R.H.

THIS IS NOT A PERMIT

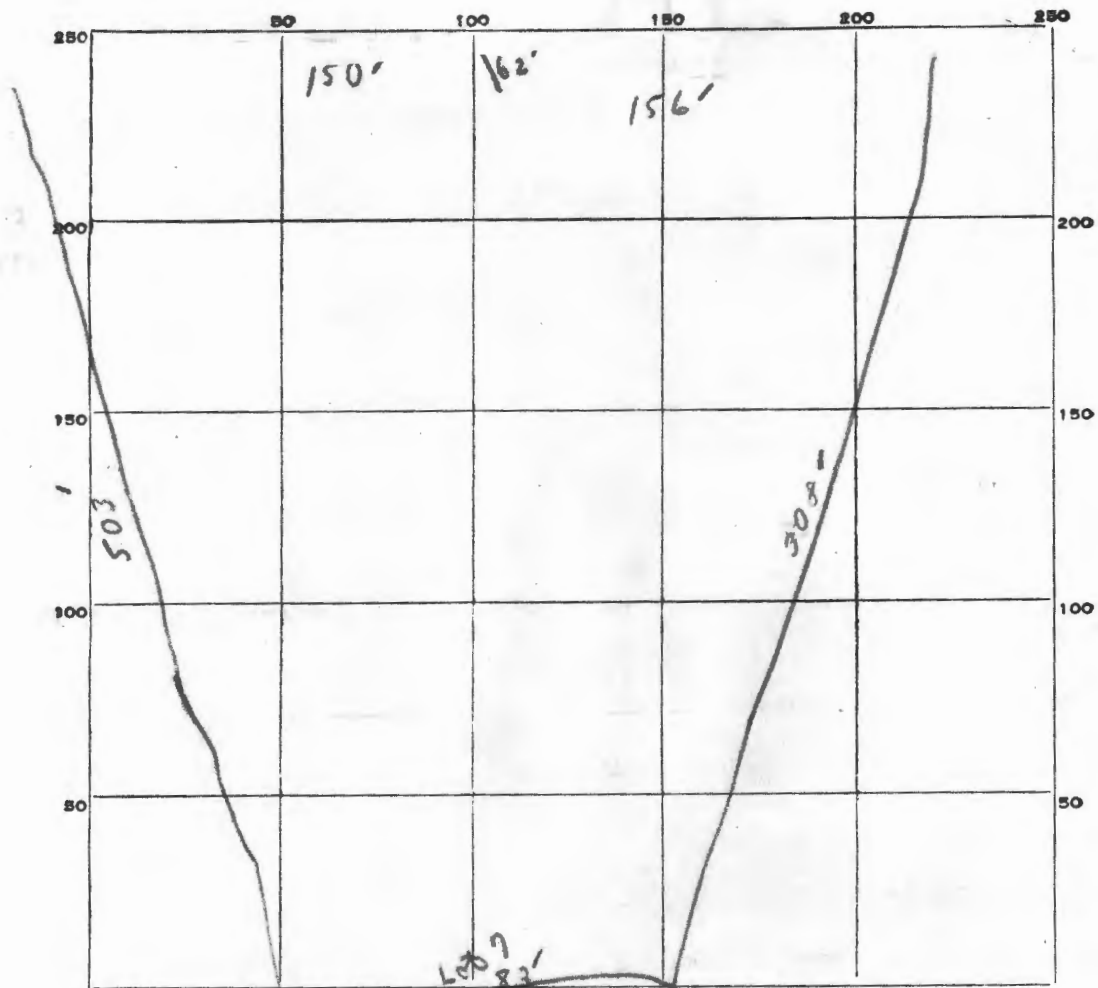

DATE	TEST NO.	DEPTH	PRE-WET		TEST - 1" DROP		TIME
			START	STOP	START	STOP	
5/12/92	1						
	2						
	3						
	4						
	5						
	6						
	7						
	8						

SOIL AUGER FINDING _____

TESTED BY _____

REMARKS _____

APPLICATION

SEWAGE DISPOSAL TESTING

MARYLAND STATE DEPARTMENT OF HEALTH

HOWARD COUNTY

ELLICOTT CITY

DISTRICT 3

DATE 4/24/72

TO: THE COUNTY HEALTH OFFICER
ELLICOTT CITY, MARYLAND

I, HEREBY, APPLY FOR THE NECESSARY TESTS IN ORDER TO CONSTRUCT (OR RECONSTRUCT) A SEWAGE DISPOSAL SYSTEM.

PROPERTY OWNER E. L. Ramsburg

ADDRESS 185 Henryton Road, Marriottsville, Md. PHONE 328-2696

PROPERTY LOCATION:

SUBDIVISION Everlea LOT NO. 7, Blk. B, Sec. 3

ROAD AND DESCRIPTION Everlea Road

OCCUPANT _____ PHONE _____

PERSON TO CONSTRUCT SYSTEM _____

ADDRESS _____ PHONE _____

SIZE OF LOT 83' x 503' x 150' x 62' x 156' x 308' TYPE BLDG. 3 or 4

NUMBER OF BEDROOMS

IF NOT SINGLE RESIDENCE DESCRIBE (Single Faly. Dwllg.)

SIGNATURE OF APPLICANT /s/ E. L. Ramsburg

APPROVED BY _____ FOR _____ DATE _____

(KIND OF SYSTEM)


REJECTED BY _____ FOR _____ DATE _____

(KIND OF SYSTEM)

HOLD PENDING FURTHER TESTS _____ DATE _____

REASONS FOR REJECTION OR HOLDING _____

THIS IS NOT A PERMIT

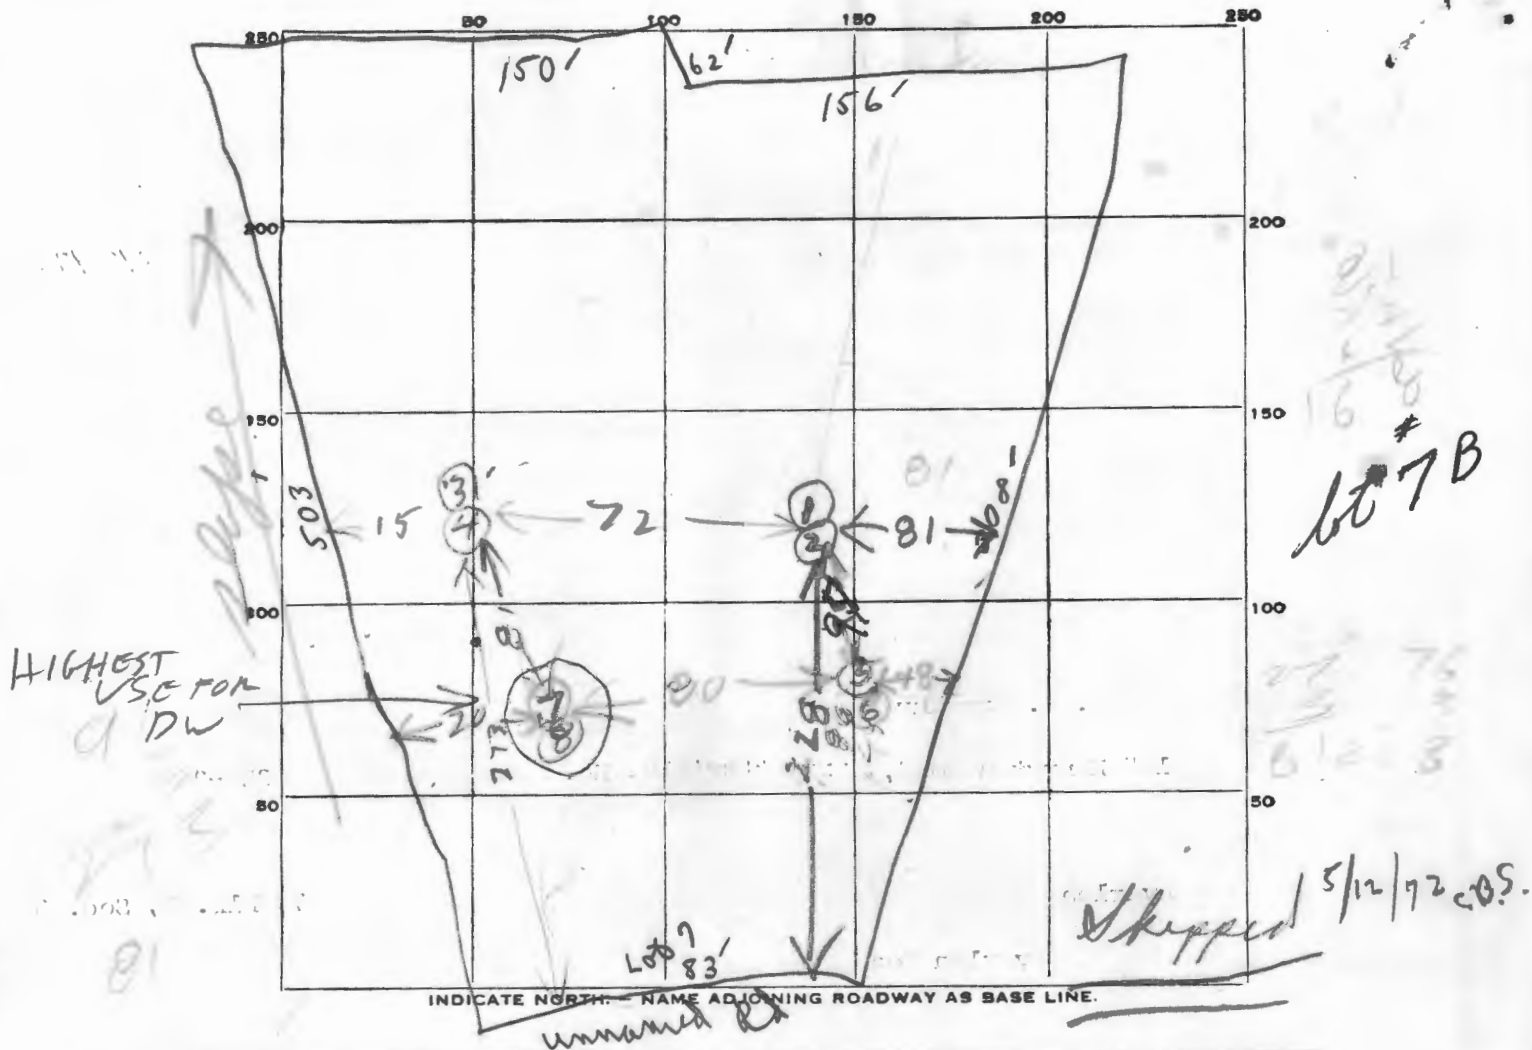

DATE	TEST NO.	DEPTH	PRE-WET		TEST - 1" DROP		TIME
			START	STOP	START	STOP	
6/6/72	1	5	959	1000	1000	1001	1
	2	12	1001	1002	1002	1004	2
	3	11 1/2	1028	1039	1039	1053	14
	4	4 1/2	1029	1035	1035	1048	13
	5	6	1113	1114	1114	1115	1
	6	12	1114	1115	1115	1119	4
	7	6	1140	1142	1142	1145	3
6/6/72	8	12	1140	1142	1142	1145	3
							41


SOIL AUGER FINDING

TESTED BY

REMARKS

USE FOR DW

Lot 7B
 Sect 3
 EVERLEA
 DEV.

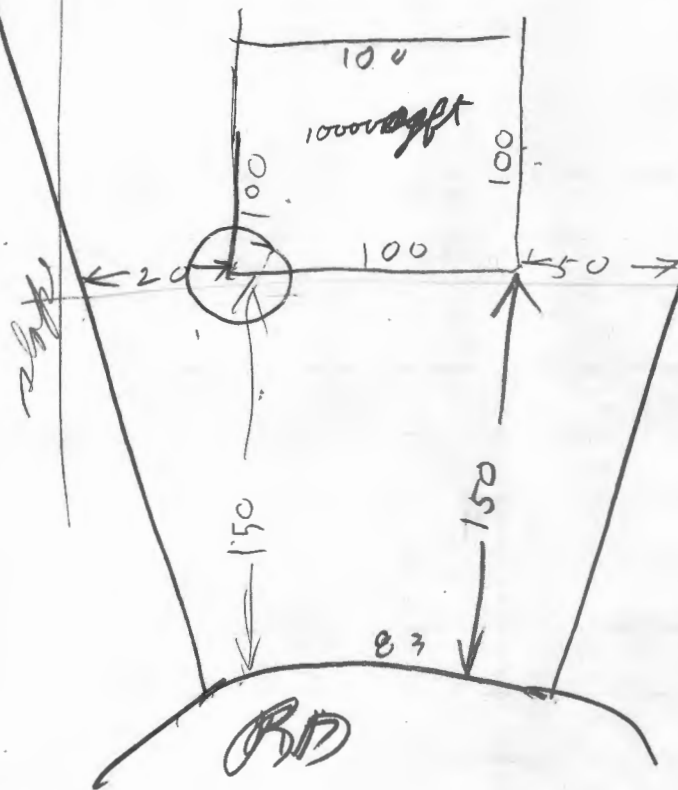

average time
 is 5 Min
 max depth is
5 FT

Make the sewage disposal area
 a 100 X 100 FT square. Place
 this square area 150 FT to 250 FT
 from the front lot line and
 50 FT to 150 ft from the right
 side of the lot as seen when facing
 the lot from the Road

Real Property Data Search (w4)

Search Result for HOWARD COUNTY

View Map		View GroundRent Redemption		View GroundRent Registration	
Tax Exempt:		Special Tax Recapture:			
Exempt Class:		NONE			
Account Identifier:		District - 03 Account Number - 293793			
Owner Information					
Owner Name:		REICHENBACH NADIA KIRSTEN VICTORIA		Use:	RESIDENTIAL NO
Mailing Address:		2280 VASSER LANE THE VILLAGES FL 32162-		Principal Residence:	
				Deed Reference:	/10144/ 00197
Location & Structure Information					
Premises Address:		N EVERLEA RD MARRIOTTSTVILLE 21104-0000		Legal Description:	LOT 7 BL B 1.413 A EVERLEA RD EVERLEA SEC 3
Map:	Grid:	Parcel:	Sub District:	Subdivision:	Section:
0010	0013	0209		0002	
					Block:
					7
					Lot:
					2019
					Assessment Year:
					Plat No:
					Plat Ref:
Special Tax Areas:		Town:		NONE	
		Ad Valorem:		101	
		Tax Class:			
Primary Structure Built	Above Grade Living Area	Finished Basement Area	Property Land Area	County Use	
			1.4100 AC		
Stories	Basement	Type	Exterior	Full/Half Bath	Garage
					Last Major Renovation
Value Information					
		Base Value	Value	Phase-in Assessments	
			As of 01/01/2019	As of 07/01/2018	As of 07/01/2019
Land:		138,000	184,100		
Improvements		0	0		
Total:		138,000	184,100	138,000	153,367
Preferential Land:		0			0
Transfer Information					
Seller: REICHENBACH JOHN G JR		Date: 07/26/2006		Price: \$0	
Type: NON-ARMS LENGTH OTHER		Deed1: /10144/ 00197		Deed2:	
Seller:		Date:		Price:	
Type:		Deed1:		Deed2:	
Seller:		Date:		Price:	
Type:		Deed1:		Deed2:	
Exemption Information					
Partial Exempt Assessments:	Class	07/01/2018		07/01/2019	
County:	000	0.00			
State:	000	0.00			
Municipal:	000	0.00 0.00		0.00 0.00	
Tax Exempt:		Special Tax Recapture:			
Exempt Class:		NONE			
Homestead Application Information					