

GENERAL NOTES



- THE LOT SHOWN HEREON COMPLIES WITH THE MINIMUM OWNERSHIP WIDTH AND LOT AREA AS REQUIRED BY THE MARYLAND STATE DEPARTMENT OF THE ENVIRONMENT.
- THIS AREA DESIGNATES A PRIVATE SEWAGE DISPOSAL AREA OF AT LEAST 10,000 S.F. AS REQUIRED BY THE MARYLAND STATE DEPARTMENT OF THE ENVIRONMENT FOR INDIVIDUAL SEWAGE DISPOSAL. IMPROVEMENTS OF ANY NATURE IN THIS AREA ARE RESTRICTED UNTIL PUBLIC SEWER IS AVAILABLE. THIS EASEMENT SHALL BECOME NULL AND VOID UPON CONNECTION TO A PUBLIC SEWER SYSTEM. THE COUNTY HEALTH OFFICER SHALL HAVE THE AUTHORITY TO GRANT ADJUSTMENTS TO THE PRIVATE SEWAGE EASEMENT. RECORDATION OF A MODIFIED SEWAGE EASEMENT PLAT SHALL NOT BE REQUIRED.
- TOPOGRAPHY SHOWN WITHIN THE LIMIT OF DISTURBANCE IS BASED ON HOWARD COUNTY GIS, 2 FOOT CONTOURS, AND VERIFIED WITH FIELD RUN TOPOGRAPHY BY BENCHMARK ENGINEERING, INC., IN JULY, 2017.
- TO THE BEST OF OUR KNOWLEDGE, ALL WELLS AND SEPTIC SYSTEMS LOCATED WITHIN 100' OF THE PROPERTY BOUNDARIES AND 200' DOWN GRADIENT OF ANY WELL AND/OR SEPTIC HAVE BEEN SHOWN.
- ANY CHANGES TO A PRIVATE SEWAGE EASEMENT SHALL REQUIRE A REVISED PERCOLATION CERTIFICATION PLAN.
- STORMWATER MANAGEMENT FOR THIS LOT COMPLIES WITH THE "MARYLAND DEPARTMENT OF THE ENVIRONMENT STORMWATER MANAGEMENT ACT OF 2007" AND THE "HOWARD COUNTY DESIGN MANUAL VOLUME I, CHAPTER 5". STORMWATER MANAGEMENT IS PROVIDED BY NON-ROOFTOP DISCONNECTION (N-2), TWO (M-6) MICRO BIO-RETENTIONS AND TWO (M-5) DRY WELLS. THEY ARE PRIVATELY OWNED AND PRIVATELY MAINTAINED.
- A DECLARATION OF INTENT FOR SINGLE FAMILY RESIDENTIAL LOT EXEMPTION (CLEARING LESS THAN 20,000 SQUARE FEET OF FOREST) SHALL BE FILED WITH DPZ.
- PROPERTY ACREAGE: (LOT 3) 3.59 AC., ZONED RR-DEO.
- PROPOSED LIMIT OF DISTURBANCE: 3.0 AC.
- FOREST STAND DELINEATION HAS BEEN PERFORMED BY BENCHMARK ENGINEERING, INC. IN FEBRUARY, 2017, AND IS PROVIDED AS PART OF THE SIMPLIFIED ENVIRONMENTAL CONCEPT PLAN SUBMISSION.
- SPECIMEN TREES HAVE BEEN FIELD LOCATED BY BENCHMARK ENGINEERING, INC. AND ARE DEPICTED ON THIS PLAN.
- THE EXISTING WELL SHOWN (TAG #HO-17-0196) SHOWN ON THIS PLAN HAS BEEN FIELD LOCATED BY BENCHMARK ENGINEERING, INC. DECEMBER, 2017 AND IS ACCURATELY SHOWN.
- EXACT LENGTH OF SEPTIC TRENCHES IS TO BE DETERMINED BY THE HEALTH DEPARTMENT AT THE TIME OF TRENCH LAYOUT AND INSPECTION.
- ANY CHANGES TO THE LOCATION OR DEPTHS TO ANY COMPONENTS MUST BE APPROVED BY THE ENGINEER AND THE HOWARD COUNTY HEALTH DEPARTMENT PRIOR TO INSTALLATION. A REVISED SITE PLAN MAY BE REQUIRED.
- THE MAXIMUM EARTH COVER OVER THE SEPTIC TANK IS 3 FEET. GREATER EARTH COVER WILL REQUIRE A HEAVY LOAD BEARING TANK.

REQUIRED BAT SITE PLAN NOTES

- ANY CHANGE TO THE LOCATIONS OR DEPTHS TO ANY COMPONENTS MUST BE APPROVED BY THE ENGINEER AND THE HOWARD COUNTY HEALTH DEPARTMENT PRIOR TO INSTALLATION. A REVISED SIT PLAN MAY BE REQUIRED.
- THE MAXIMUM DEPTH OF THE BAT SHALL BE PER THE MANUFACTURER'S SPECIFICATION.
- THE BLOWER MAY NOT BE LOCATED FURTHER FROM THE TANK THAN THE MANUFACTURER'S SPECIFICATIONS.
- THE BAT SYSTEM SHALL BE MAINTAINED AND OPERATED FOR THE LIFE OF THE SYSTEM.
- THE BAT SHALL BE OPERATED BY AND MAINTAINED BY A CERTIFIED SERVICE PROVIDER.
- WITHIN ONE MONTH OF INSTALLATION, A PERSON INSTALLING THE BAT SYSTEM SHALL REPORT TO THE MARYLAND DEPARTMENT OF THE ENVIRONMENT (MDE) IN A MANNER ACCEPTABLE TO MDE, THE ADDRESS AND DATE OF COMPLETION OF THE BAT INSTALLATION AND THE TYPE OF BAT INSTALLED.
- ELECTRICAL WORK FOR THE BAT INSTALLATION MUST BE PERFORMED BY A LICENSED ELECTRICIAN.
- AN AGREEMENT AND EASEMENT MUST BE COMPLETED AND SIGNED BY ALL APPLICABLE PARTIES, AND RECORDED IN LAND RECORDS OF HOWARD COUNTY.
- THE HEALTH DEPARTMENT REQUIRES DOCUMENTATION FOR THE START-UP CERTIFICATION FROM THE MANUFACTURER PRIOR TO FINAL APPROVAL OF THE INSTALLATION.

INITIAL SYSTEM		
Number of Bedrooms	6	
Application Rate	1.2	gpd/sf
Effective Area Beginning Depth	2	ft
Bottom Max Depth	6	ft
Design Flow	900	gpd
Drainage Field square footage	750	sf
Sidewall reduction credit	0.417	
Trench width	3	
Effective Area Depth	4	
Linear Length of trench Required	104	lf
1st REPLACEMENT SYSTEM		
Number of Bedrooms	6	
Application Rate	1.2	gpd/sf
Effective Area Beginning Depth	2	ft
Bottom Max Depth	6	ft
Design Flow	900	gpd
Drainage Field square footage	750	sf
Sidewall reduction credit	0.417	
Trench width	3	
Effective Area Depth	4	
Linear Length of trench Required	104	lf
2nd REPLACEMENT SYSTEM		
Number of Bedrooms	6	
Application Rate	1.2	gpd/sf
Effective Area Beginning Depth	2	ft
Bottom Max Depth	6	ft
Design Flow	900	gpd
Drainage Field square footage	750	sf
Sidewall reduction credit	0.417	
Trench width	3	
Effective Area Depth	4	
Linear Length of trench Required	104	lf

SOILS LEGEND		
SYMBOL	TYPE	NAME
Co*	C	CODORUS AND HATBORO SILT LOAM, 0 TO 3 PERCENT SLOPES
GgC	B	GLENELG LOAM, 3 TO 8 PERCENT SLOPES
MoC	B	MANOR LOAM, 8 TO 15 PERCENT SLOPES
MoD	B	MANOR LOAM, 15 TO 25 PERCENT SLOPES
* INDICATES ERODIBLE SOILS		
** HIGHLY ERODIBLE, K>0.35, AND/OR 15% OR GREATER SLOPES		
TAKEN FROM THE NRCS WEB SOIL SURVEY, APRIL 2016. PAGE 15		

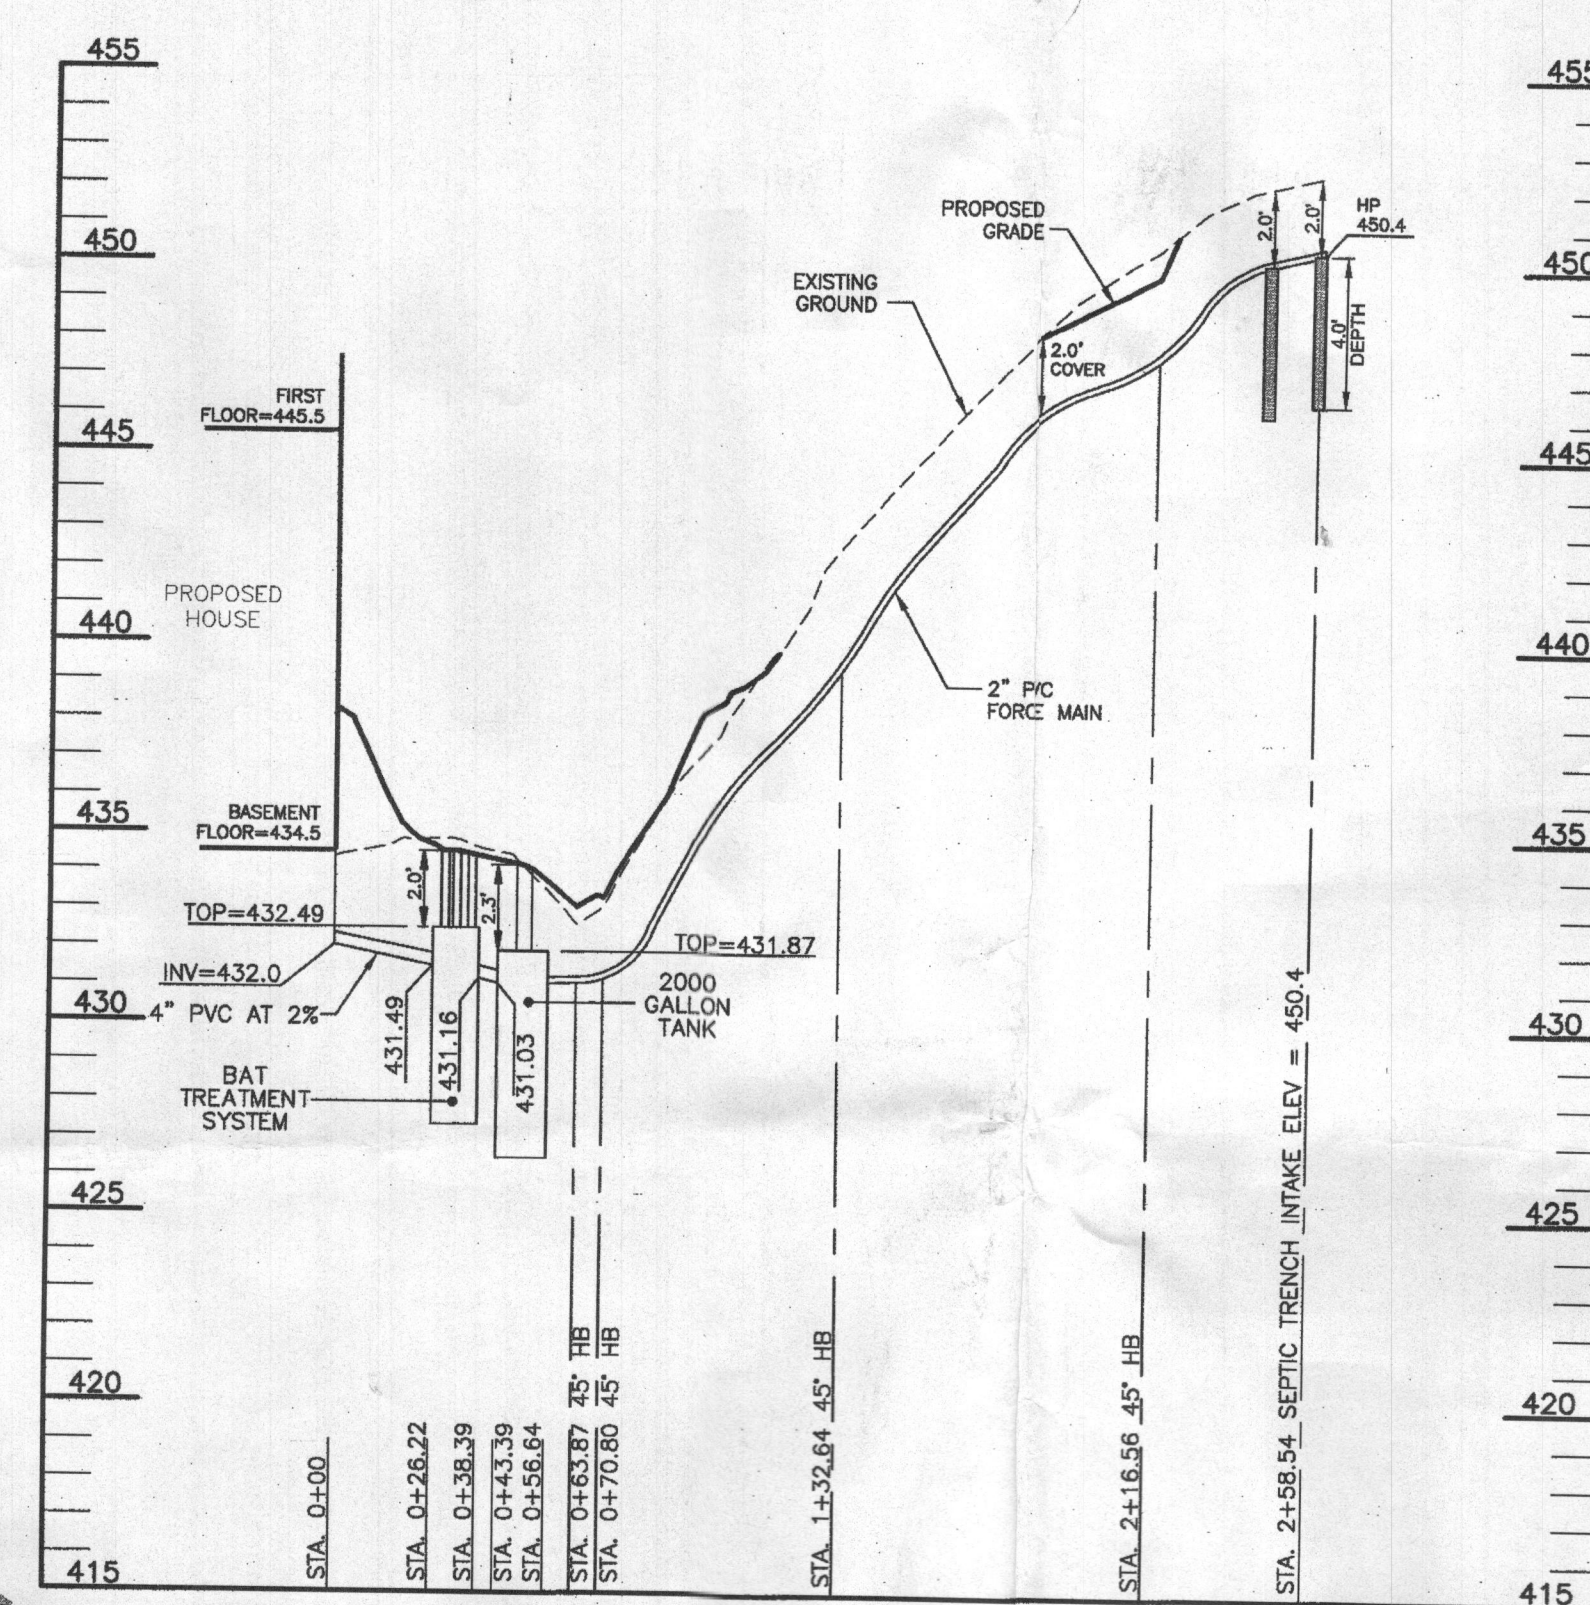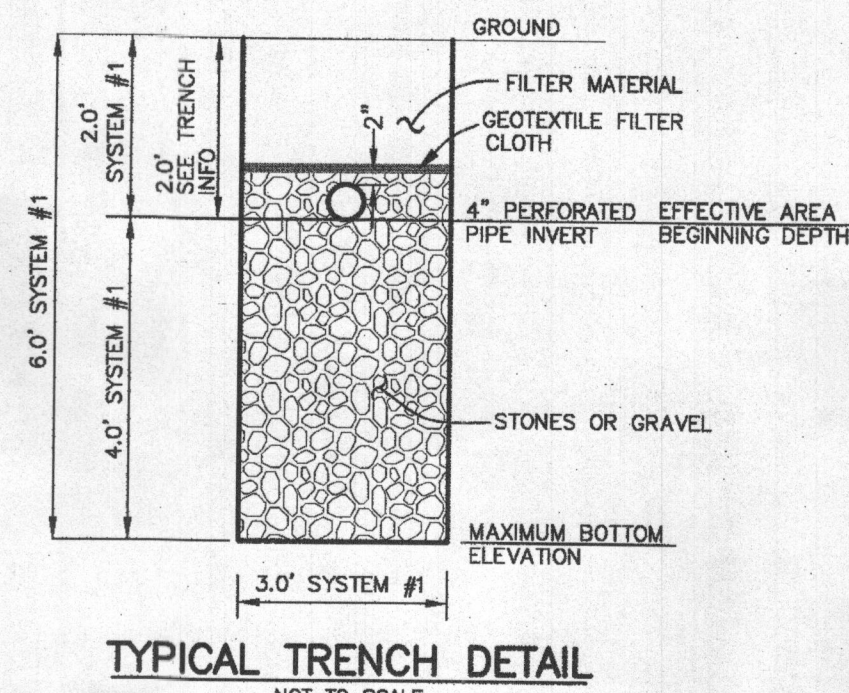

TRENCH 1-1	
TRENCH LENGTH	52 LF
GROUND ELEVATION	552.4
INVERT ELEVATION	550.4
MAX. BOTTOM ELEV.	548.4


TRENCH 1-2	
TRENCH LENGTH	52 LF
GROUND ELEVATION	552.1
INVERT ELEVATION	550.1
MAX. BOTTOM ELEV.	546.1

TRENCH 2-1	
TRENCH LENGTH	52 LF
GROUND ELEVATION	551.5
INVERT ELEVATION	549.5
MAX. BOTTOM ELEV.	545.5

TRENCH 2-2	
TRENCH LENGTH	52 LF
GROUND ELEVATION	551.0
INVERT ELEVATION	549.0
MAX. BOTTOM ELEV.	545.0

TRENCH 3-1	
TRENCH LENGTH	52 LF
GROUND ELEVATION	550.1
INVERT ELEVATION	548.1
MAX. BOTTOM ELEV.	544.1

TRENCH 3-2	
TRENCH LENGTH	52 LF
GROUND ELEVATION	549.8
INVERT ELEVATION	547.8
MAX. BOTTOM ELEV.	542.8

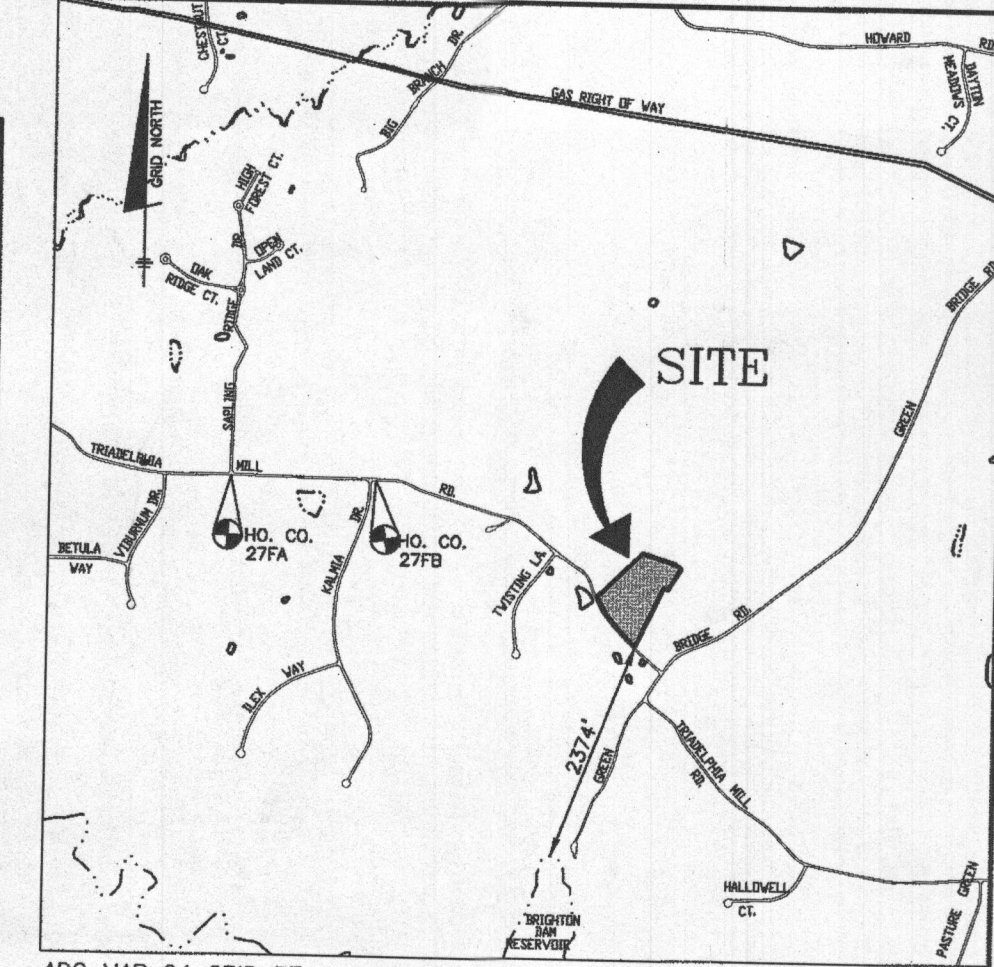

BENCHMARKS (NAD83)	
HO. CO. No. 27FA	ELEV. 496.35
18.2' SOUTH OF THE CENTERLINE OF TRIADAPLHIA MILL RD AT THE INTERSECTION OF SAPLING RIDGE DR.	
N 569002.176	E 1306892.586
HO. CO. No. 27FB	ELEV. 512.22
3.2' SOUTH OF THE EDGE OF PAVING OF TRIADAPLHIA MILL RD 0.1' EAST OF THE CENTERLINE OF KALMIA DR.	
N 568975.151	E 1308421.369

LEGEND



SOILS CLASSIFICATION	GrB
SOILS DELINEATION	---
EXISTING CONTOURS	480 478
EXISTING WOODS LINE	~~~~~
EXISTING WELL	W
PROPOSED WELL	PROPOSED WELL BOX
PASSING PERCOLATION TEST	○
FAILING PERCOLATION TEST	●
EXISTING STRUCTURE	---
PROPOSED STRUCTURE	---
PROPOSED SEWAGE DISPOSAL AREA	---
BETWEEN 20% AND 24.99% SLOPES	---
EX. 100 YEAR FLOODPLAIN	X

Approved Septic System Plan
Howard County Health Department
NORWECO TNT 960 LP
w/ Mayer Bros. 2000-gal Pump Tank
& Zoeller 3/4" (0.5 hp) Pump
R. Buehler 1/12/2018
BAT-LPD system Date


THE CONTRACTOR SHALL NOTIFY THE DEPARTMENT OF PUBLIC WORKS/BUREAU OF ENGINEERING/CONSTRUCTION INSPECTION DIVISION AT 410-313-1880 AT LEAST FIVE (5) WORKING DAYS PRIOR TO THE START OF ANY WORK.

THE CONTRACTOR SHALL NOTIFY "MISS UTILITY" AT 1-800-257-7777 AT LEAST 48 HOURS PRIOR TO ANY EXCAVATION WORK BEING DONE.


BENCHMARK ENGINEERING, INC. 8480 BALTIMORE NATIONAL PIKE & SUITE 315A ELLICOTT CITY, MARYLAND 211043 (P) 410-468-8105 (F) 410-468-8644 WWW.BEI-CHVLENGINEERING.COM		Professional Certification: I hereby certify that these documents were prepared or approved by me, and that I am a duly licensed professional engineer under the laws of the State of Maryland, License No. 45577, Expiration Date: 06-08-2018.
OWNER/DEVELOPERS:	PROJECT:	
ELLEN M. VAWTER, MICHAEL A. VAWTER, NANCY J. VAWTER, LAURA J. LEONARD, DREW B. LEONARD 14170 TRIADAPLHIA MILL ROAD DAYTON, MARYLAND 21036 301-708-6044	VAWTER PROPERTY LOT 3	
DESIGN: LDD	DRAFT: LDD	CHECK: AAM
DATE: DECEMBER, 2017	PROJECT NO. 2766	
SCALE: AS SHOWN	SHEET 1 OF 3	

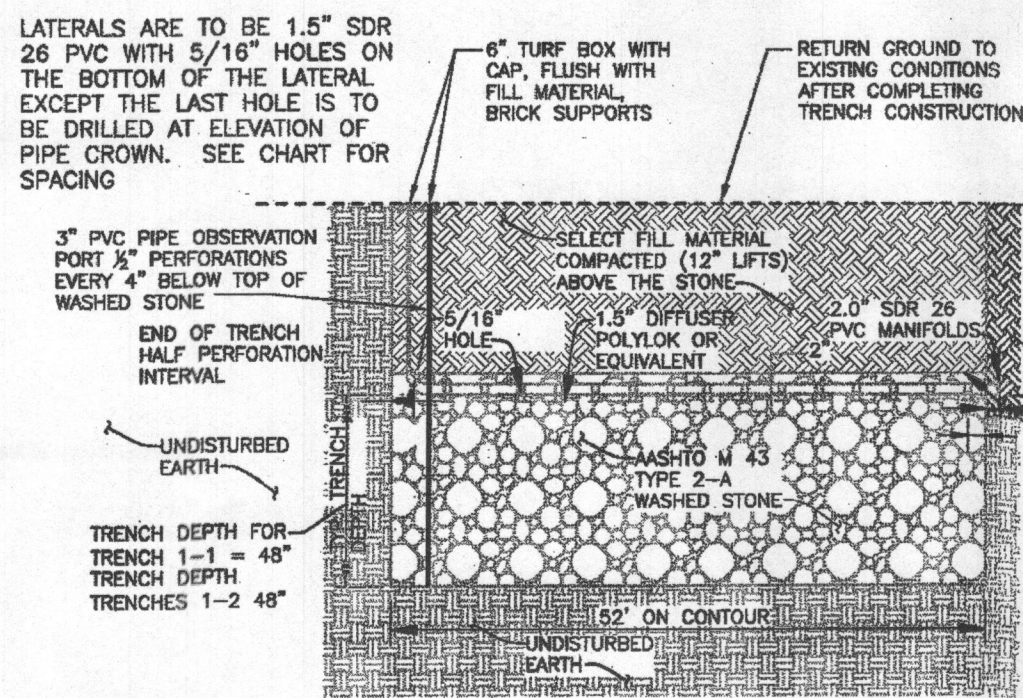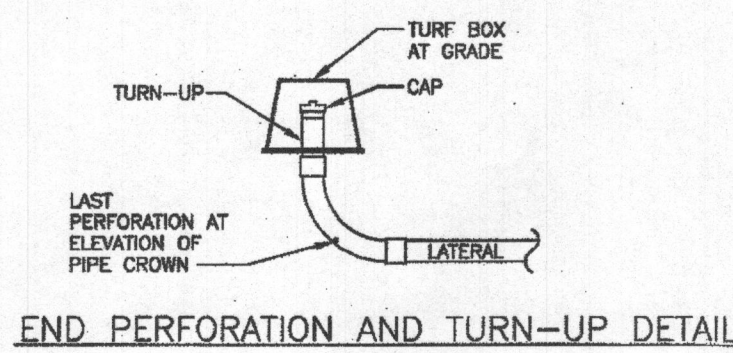


LATERAL AND TRENCH DESIGN

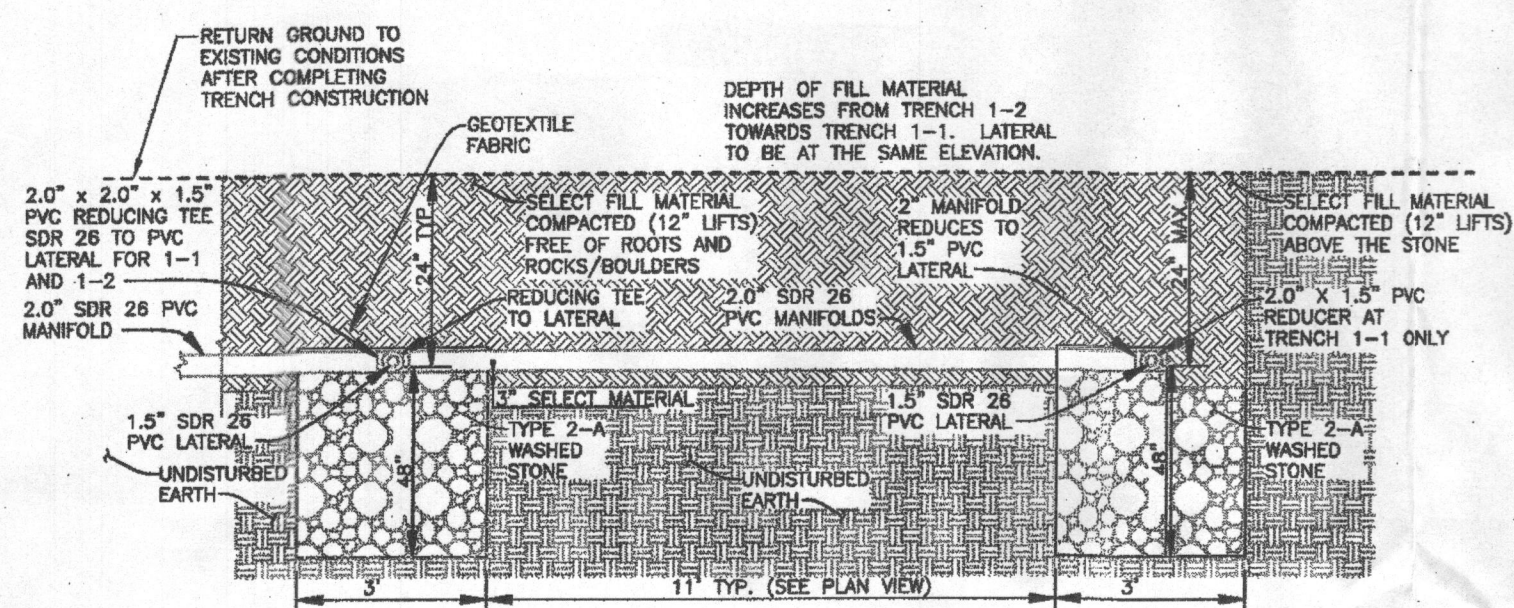

TRENCH AND MANIFOLD SECTION

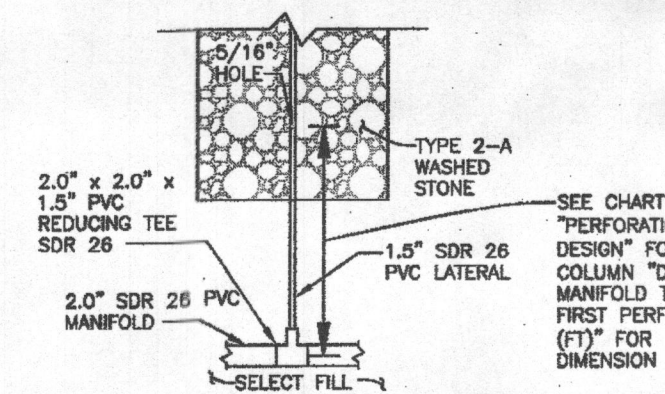

OVERHEAD VIEW OF MANIFOLD AND LATERAL CONNECTION SECTION

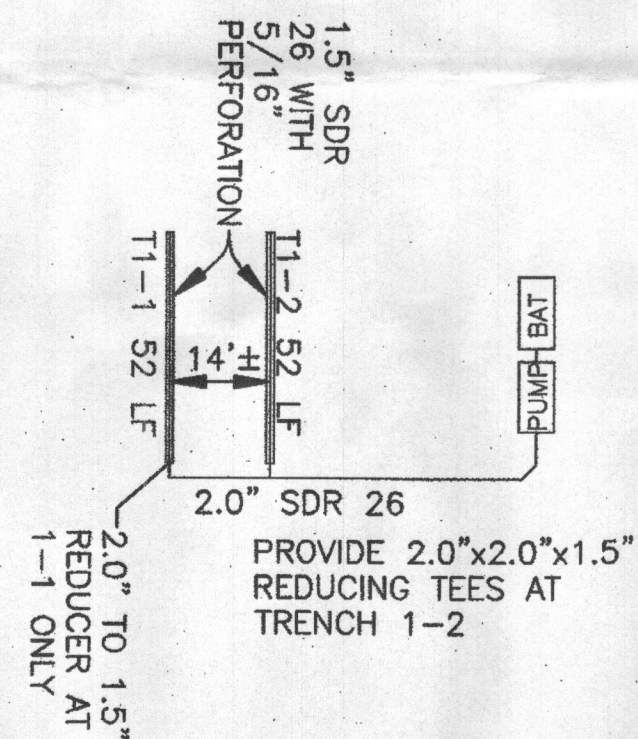

TRENCH SCHEMATIC
NOT TO SCALE

Trench and Lateral Design										
Cell	Trench	Pipe Inv.	Trench	Highest	Lowest	Total Design	Approx. Lateral	Number of	Flow per	Flow per
		Elev.	Bottom Elev.	Ground Over	Ground Over	Head (ft)	Length (ft)	Perforations	Perforation (gpm)	Lateral (gpm)
1	1	450.4	448.4	452.4	452.1	28.2	50.5	11	1.63	17.91
	2	450.1	446.1	452.1	452.1	27.8	55.0	10	1.78	17.78

Perforation Diameter = 5/16 inches Target Flow = 17.91 gpm Cell 1 Flow Rate 35.69

Depth To Effective Sidewall Deep Trench Depth Depth to Inlet
Trench 1 5 ft 4 ft 2 ft
Trench 2 5 ft 4 ft 2 ft

Perforation Design							
Cell	Trench	Number of Perforations	Manifold to Trench (ft)	Trench Length (ft)	Perforation Spacing (ft)	Dist. Manifold to First Perfor. (ft)	Lateral Length (ft)
1	1	11	3.2	52	4.73	5.56	52.84
	2	10	2.5	52	5.20	6.10	51.90

Lateral Pressure Calculations														
Cell	Trench	Pipe Elev.	Beginning Manifold Loss	Gate Valve	Manifold Bends 45D	Manifold Length	Manifold velocity	Manifold thru Tees	Delta Loss	Total Manifold Loss	Lateral 90 degree	Sudden Reduction	Lateral Bends	Lateral Length
1	2	450.1	0.00	0	4	188	35.8	0	4.19	4.19	0.06	0.01	0.00	0.10
1	1	450.4	4.19			14	17.9	1	0.09	4.28	0.06	0.01	0.00	0.09

Perforation Diameter = 5/16 inches Distal Head 2 feet

Friction Head main

Friction Head = Head loss due to pipe friction
2" pipe = 202 feet

45° bends 1 loss for manifold bend
Str. Coupling 1 loss for straight tee
90 deg. Side tee 1 loss for tee bend
Sudden reduction 1 loss for reduction
45° bends 1 loss for lateral bend
Gate Valve 0 loss for valve

Equivalent Manifold Length = 220.0

1.5" lateral 62.00 feet

Total Friction Head = 5.63

Friction loss = 4.52 feet

Friction loss = 1.12 feet

Design Calculations			
Design Input:		Calculations:	
Capacity requirements			
number of lots	1	Max. Daily Flow	900 gpd
bedrooms per lot	6	Average Daily Flow	450 gpd
use rate per bedroom	150 gpd	Maximum Daily Flow	0.63 gpm
		Average Daily Flow	0.31 gpm

Drainfield Requirements			
Application Rate	1.2 gpd/sq ft	Standard Trench Length	250 ft
Trench width	3 ft	Deep Trench Conversion Factor	41.67 %
trench gravel depth	4 ft	Deep Trench Length for MDF	104.18 ft
number of trenches	2	total trench length for 100% capacity	104.18 ft
trench spacing center-center	13 ft	individual trench length	52 ft
		Approx. Lateral Length	48.00 ft

Tanks and Capacities			
BAT tank	2,000	gallons	minimum req. area
2nd settling tank	NA	gallons	req. capacity (1125*(0.75*MDF))
Equalization Tank	NA	gallons	design settling capacity
pump tank size	2,000	gallons	min. pump tank capacity (ADF)
			600 gal.

Distribution system			
number of cells	1	Total Number of Pumps	1
trenches first system	2	laterals served by pump	2
lateral length per pump	104 ft	Vol./100 ft 1.5" SDR 26	12.6 gal.
ID 1.5" SDR 26 PVC	1.75 inches	Vol. of laterals served	13.1 gal.
Max. Force main length	202 ft	Vol./100 ft 2" SDR 26	19.6 gal.
ID 2" SDR 26 PVC	2.17 inches	Max. Main volume	39.6 gal.

Static Hydraulic Profile			
Ground Elev. at BAT tank	434.49 ft	Tank #1 effluent elev	431.16 ft
Tank #1 invert in	431.49 ft		
Cover	2.00 ft		
Tank #1 top	432.49 ft	okay	
Fall in tanks	0.33 ft	Pump Tank effluent elev	431.03 ft
Fall between tanks	0.13 ft	Invert of pump tank	426.78 ft
Ground Elev. at pump tank	434.14 ft		
Pump Tank invert in	431.03 ft		
inv. into pump tank to top	0.84 ft	Pump Elevation	427.28 ft
Pump Tank top	431.87 ft	okay	
Pump Block Height	0.50 ft	pump intake elev.	428.07 ft
Height of Intake	0.79 ft		
Highest lateral	450.00 ft	Cell 1	

Perforation Design:			
Size of Perforation	5/16 inches	Distal Pressure =	2.0 ft
Design Separation	4.73 ft	Flow	1.63 gpm
Use Perforations	11	Perforations per Lateral	11.00
Perforations per field	22	Perforation Actual Spacing	4.73 ft
		Flow rate	35.82 gpm

Dosing volume, flow rates and Pressures			
lateral flow rate per pump	35.82 gpm	Static Head	21.32 ft Cell 1
Friction (C) for PVC	150	Friction Head	5.63 ft Cell 1
Miscellaneous Losses	0 ft	Distal Head	2 ft
Estimated Run Time	2.00 Min.	Max. Total Dynamic Head	28.95 ft
Cells in simultaneous use	1	Minimum Dose Vol.	150.00 gal.
Pump tank Volume	45.49 Gal/in	Min. Runtime	4.19 min.
		Selected Runtime	5.19
		Selected Dose Volume	150.00 gal.
		Average Dose	3.00 per day

Tank and Float Design:			
Ground over Tank =	434.14 ft	Inside Tank Dimensions	
Top of Tank =	431.87 ft	Height =	4.67 ft
Invert of Tank =	426.78 ft	Width =	5.58 ft
Pump Block =	0.50 ft	Length =	13.08 ft
Water End and Motor =	1.34 ft	Number of Tanks =	1
per Mayer Brothers Precast			
minimum Pump off =	428.62 ft		
Pump Off Float =	428.68 ft		

Dose = 20.05 of	Area of Pit 72.99 sf	Use one 2,000 gallon pump tank	
Pump on dist. = 0.27 ft			
Pump on Elev. = 428.95 ft			
Distance between Pump on and Highwater Alarm = 0.5 ft			
Highwater Alarm Elevation = 429.45 ft			
High Water Alarm to Inlet = 1.58			
Volume Above Alarm Float to Inlet = 114.97 of or 859.89 gallons			
One Day Flow = 900.00 gallons		not okay	
90% One Day Flow = 810.00 gallons		okay	

Pump Requirements:	
Performance =	35.82 gpm
Head of Water =	28.95 feet of head

Pump Selection:	
Zoeller Pump BN161	115 Volts Single Phase
1/2 horse power	

Approved Septic System Plan
Howard County Health Department
NORWECO NOT ADOPTED
172000 gal Mayer Bros. Pump
3 Zoeller BN161 (0.5hp) pumps
1/2 per
Signature Date
3AT-LED system

BENCHMARK ENGINEERING, INC.
ENGINEERS LAND SURVEYORS PLANNERS
8480 BALTIMORE NATIONAL PIKE A SUITE 315 A ELICOTT CITY, MARYLAND 21043
(7) 410-465-8108 (P) 410-465-8144
WWW.BE-ONLINEENGINEERING.COM

Professional Certification. I hereby certify that these documents were prepared or approved by me, and that I am a duly licensed professional engineer under the laws of the State of Maryland, License No. 45577, Expiration Date: 06-08-2018.

OWNER/DEVELOPERS:
ELLEN M. VAWTER,
MICHAEL A. VAWTER,
NANCY J. VAWTER,
LAURA J. LEONARD,
DREW B. LEONARD
14170 TRIADAPLHA MILL ROAD
DAYTON, MARYLAND 21038
301-706-6044

PROJECT:
VAWTER PROPERTY
LOT 3


LOCATION:
14176 TRIADAPLHA MILL ROAD
TAX MAP: 27 - GRID: 24 - PARCEL: 68
ZONED: RD-CRD RURAL RESIDENTIAL
ELECTION DISTRICT NO. 5 - HOWARD COUNTY, MARYLAND

TITLE:
SEPTIC SYSTEM DESIGN DETAILS

DATE: DECEMBER, 2017 **PROJECT NO.** 2766


SCALE: NONE **SHEET** 3 **OF** 3

DESIGN: LDD **DRAFT:** LDD **CHECK:** AAM

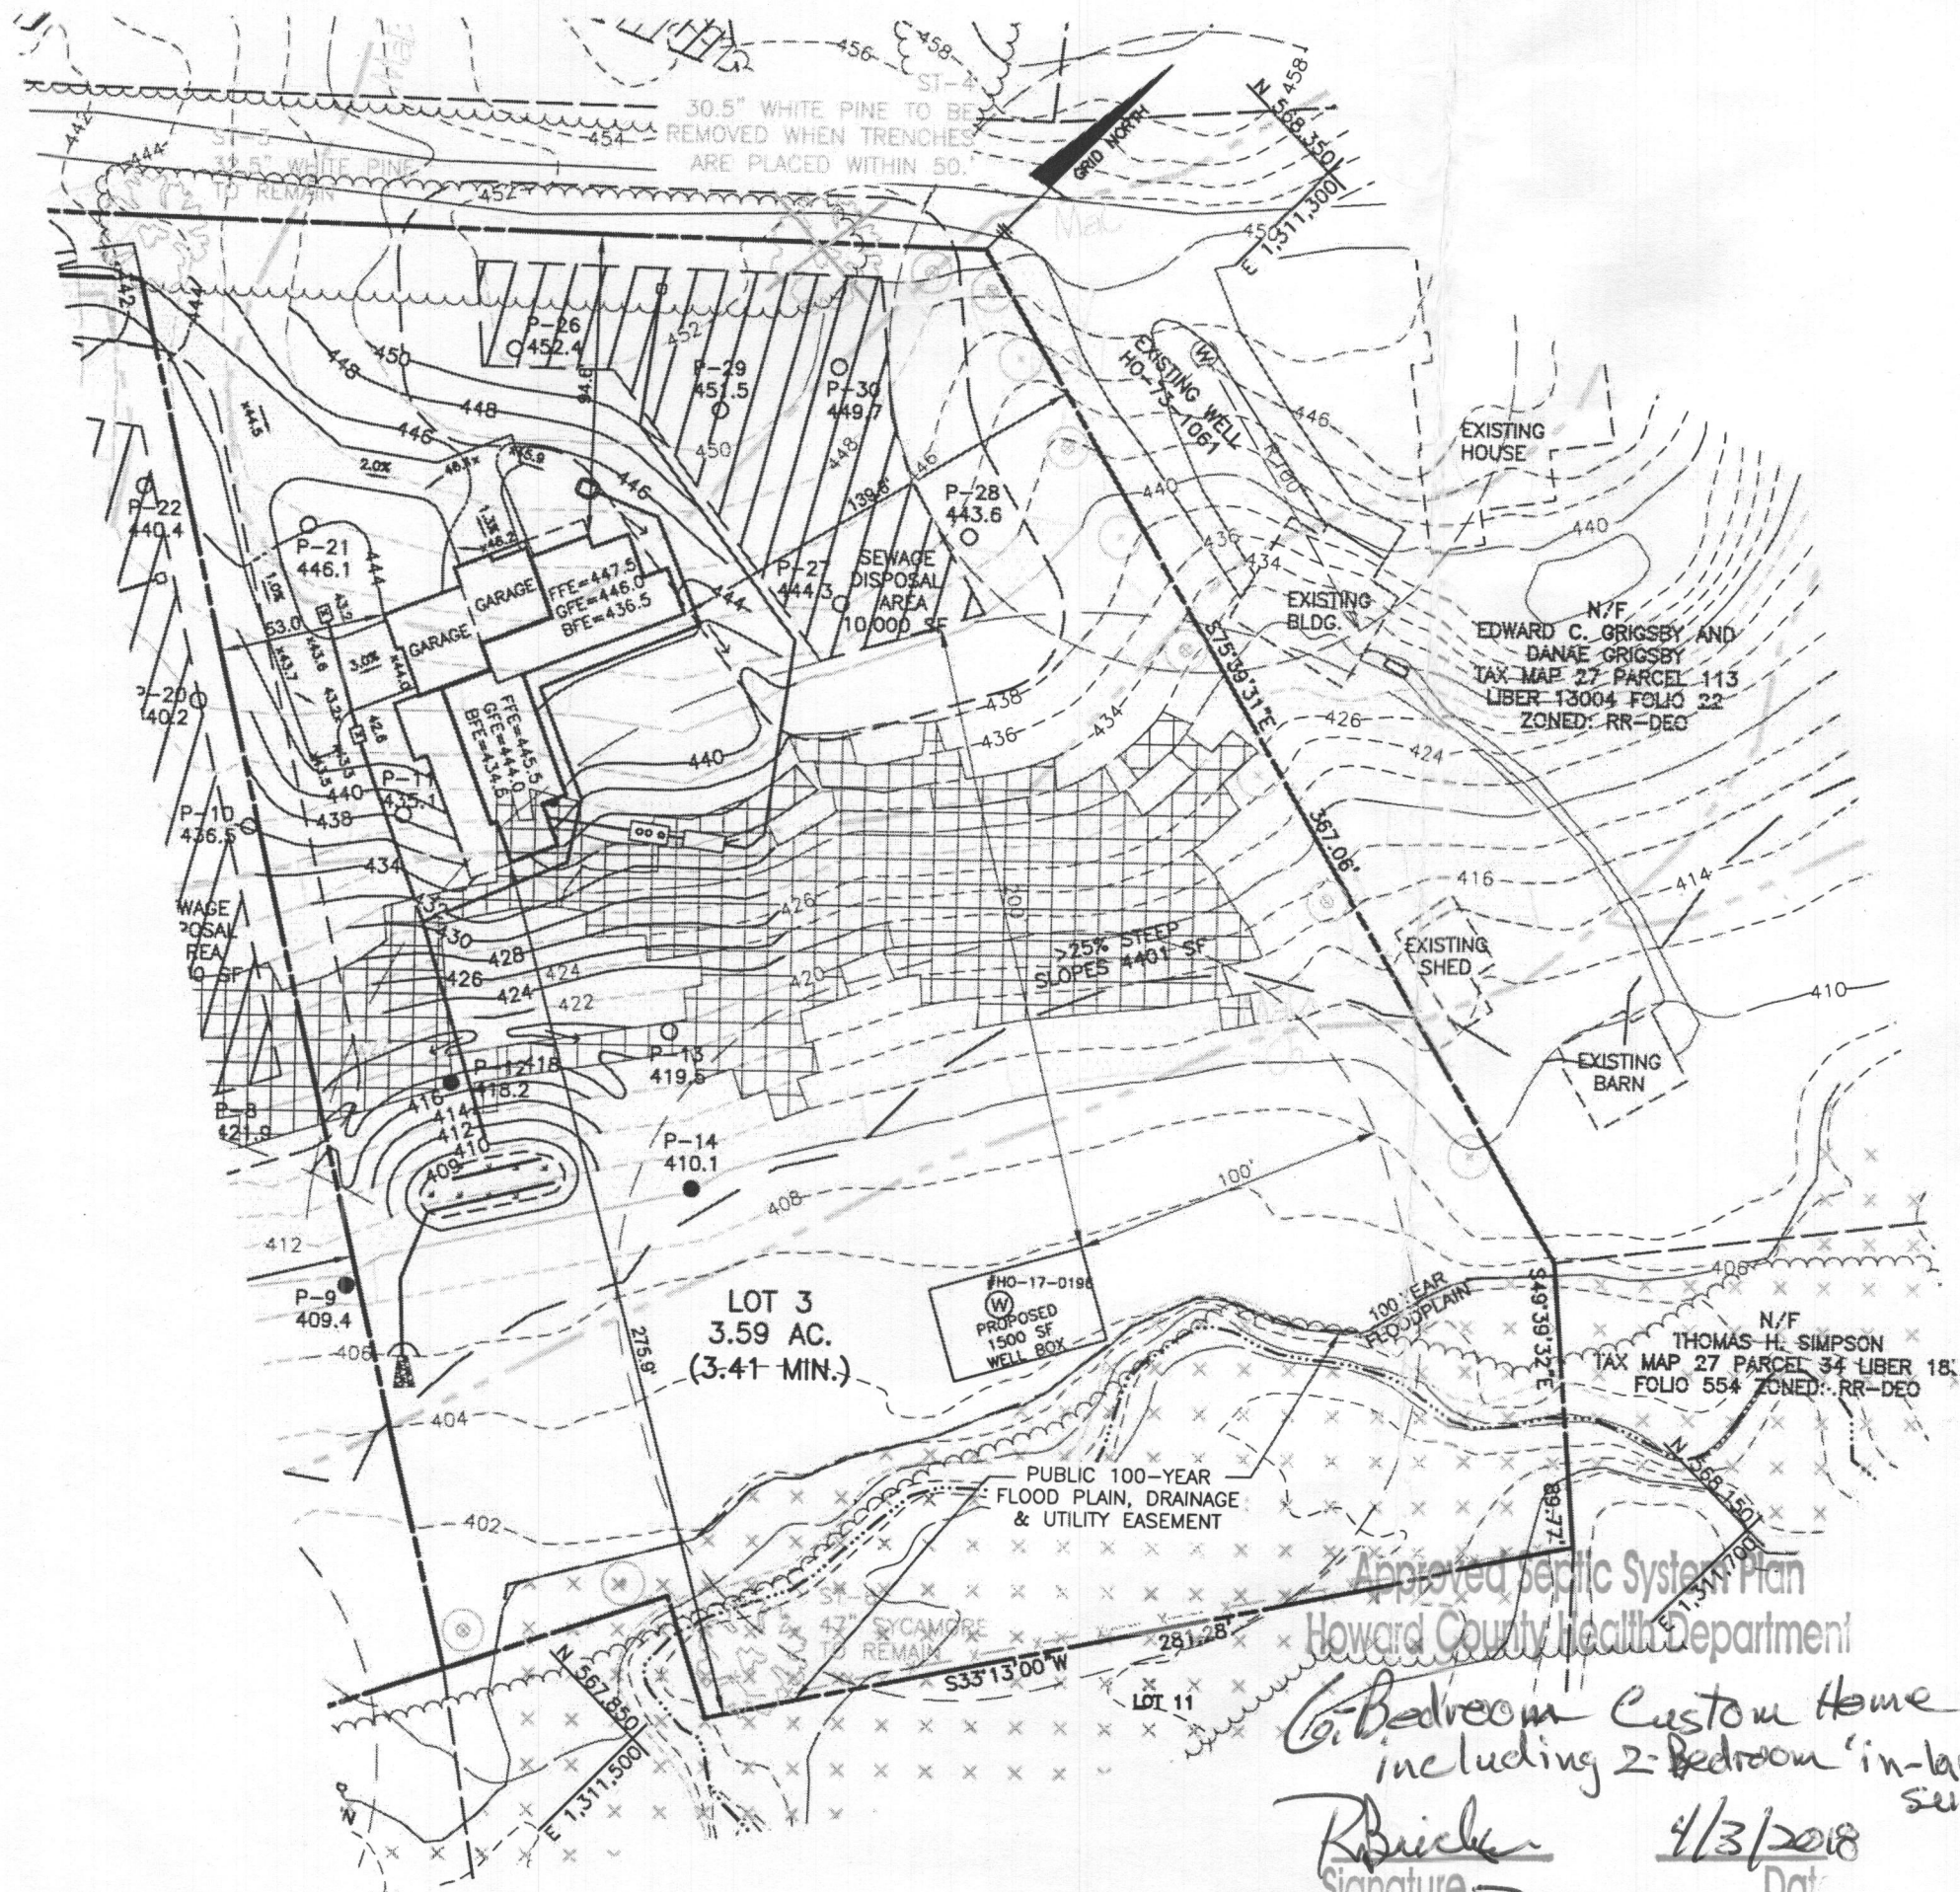

LEGEND	
EXISTING CONTOURS	480 478
EXISTING WOODS LINE	
EXISTING WELL	
PROPOSED WELL	PROPOSED WELL BOX
EXISTING STRUCTURE	
25% OR GREATER SLOPES 10' OR GREATER VERTICAL ERODIBLE SOILS	
100-YR FLOODPLAIN	
BOUNDARY	
PROPOSED SEWAGE	
DISCONNECTION AREA	

14176 Triadelphia Mill Road

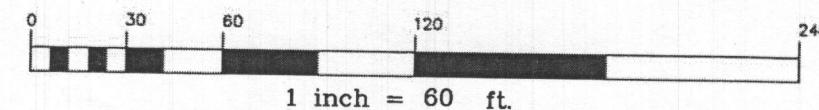

OWNER/BUILDER:

ELLEN M. VAWTER,
MICHAEL A. VAWTER,
NANCY J. VAWTER,
LAURA J. LEONARD,
DREW B. LEONARD
14170 TRIADELPHIA MILL ROAD
DAYTON, MARYLAND 21036
301-706-6044

BENCHMARK

ENGINEERS & LAND SURVEYORS & PLANNERS

ENGINEERING, INC.

8480 BALTIMORE NATIONAL PIKE & SUITE 315
ELLICOTT CITY, MARYLAND 21043
(P) 410-465-6105 & (F) 410-465-6644

WWW.BEI-CIVILENGINEERING.COM

PROJECT:

VAWTER PROPERTY

LOCATION:

14170 TRIADELPHIA MILL ROAD
TAX MAP: 27 - GRID: 24 - PARCEL: 68
ZONED: RR-DEO RURAL RESIDENTIAL
ELECTION DISTRICT NO. 5 - HOWARD COUNTY, MARYLAND

TITLE:

BUILDING PERMIT PLAN
LOT 3

HOUSE TYPE:

DATE:

JANUARY, 2018

PROJECT NO.

2766

SCALE:

AS SHOWN

DRAWING

1 OF 1

Approved Specific System Plan
Howard County Health Department

Co. Bedroom Custom Home
including 2-Bedroom 'in-law suite'

Signature

4/3/2018

Date

B18000818


GENERAL NOTES

- THE LOT SHOWN HEREON COMPLIES WITH THE MINIMUM OWNERSHIP WIDTH AND LOT AREA AS REQUIRED BY THE MARYLAND STATE DEPARTMENT OF THE ENVIRONMENT.
- THIS AREA DESIGNATES A PRIVATE SEWAGE DISPOSAL AREA OF AT LEAST 10,000 S.F. AS REQUIRED BY THE MARYLAND STATE DEPARTMENT OF THE ENVIRONMENT FOR INDIVIDUAL SEWAGE DISPOSAL. IMPROVEMENTS OF ANY NATURE IN THIS AREA ARE RESTRICTED UNTIL PUBLIC SEWER IS AVAILABLE. THIS EASEMENT SHALL BECOME NULL AND VOID UPON CONNECTION TO A PUBLIC SEWER SYSTEM. THE COUNTY HEALTH OFFICER SHALL HAVE THE AUTHORITY TO GRANT ADJUSTMENTS TO THE PRIVATE SEWAGE EASEMENT. RECORDATION OF A MODIFIED SEWAGE EASEMENT PLAT SHALL NOT BE REQUIRED.
- TOPOGRAPHY SHOWN WITHIN THE LIMIT OF DISTURBANCE IS BASED ON HOWARD COUNTY GIS, 2 FOOT CONTOURS, AND VERIFIED WITH FIELD RUN TOPOGRAPHY BY BENCHMARK ENGINEERING, INC., IN JULY, 2017.
- TO THE BEST OF OUR KNOWLEDGE, ALL WELLS AND SEPTIC SYSTEMS LOCATED WITHIN 100' OF THE PROPERTY BOUNDARIES AND 200' DOWN GRADIENT OF ANY WELL AND/OR SEPTIC HAVE BEEN SHOWN.
- ANY CHANGES TO A PRIVATE SEWAGE EASEMENT SHALL REQUIRE A REVISED PERCOLATION CERTIFICATION PLAN.
- STORMWATER MANAGEMENT FOR THIS LOT COMPLIES WITH THE "MARYLAND DEPARTMENT OF THE ENVIRONMENT STORMWATER MANAGEMENT ACT OF 2007" AND THE "HOWARD COUNTY DESIGN MANUAL VOLUME I, CHAPTER 5". STORMWATER MANAGEMENT IS PROVIDED BY NON-ROOFTOP DISCONNECTION (N-2), TWO (M-6) MICRO BIO-RETENTIONS AND TWO (M-5) DRY WELLS. THEY ARE PRIVATELY OWNED AND PRIVATELY MAINTAINED.
- A DECLARATION OF INTENT FOR SINGLE FAMILY RESIDENTIAL LOT EXEMPTION (CLEARING LESS THAN 20,000 SQUARE FEET OF FOREST) SHALL BE FILED WITH DPZ.
- PROPERTY ACREAGE: (LOT 3) 3.59 AC., ZONED RR-DEO.
- PROPOSED LIMIT OF DISTURBANCE: 3.0 AC.
- FOREST STAND DELINEATION HAS BEEN PERFORMED BY BENCHMARK ENGINEERING, INC. IN FEBRUARY, 2017, AND IS PROVIDED AS PART OF THE SIMPLIFIED ENVIRONMENTAL CONCEPT PLAN SUBMISSION.
- SPECIMEN TREES HAVE BEEN FIELD LOCATED BY BENCHMARK ENGINEERING, INC. AND ARE DEPICTED ON THIS PLAN.
- THE EXISTING WELL SHOWN (TAG #HO-17-0196) SHOWN ON THIS PLAN HAS BEEN FIELD LOCATED BY BENCHMARK ENGINEERING, INC. DECEMBER, 2017 AND IS ACCURATELY SHOWN.
- EXACT LENGTH OF SEPTIC TRENCHES IS TO BE DETERMINED BY THE HEALTH DEPARTMENT AT THE TIME OF TRENCH LAYOUT AND INSPECTION.
- ANY CHANGES TO THE LOCATION OR DEPTHS TO ANY COMPONENTS MUST BE APPROVED BY THE ENGINEER AND THE HOWARD COUNTY HEALTH DEPARTMENT PRIOR TO INSTALLATION. A REVISED SIT PLAN MAY BE REQUIRED.
- THE MAXIMUM DEPTH OF THE BAT SHALL BE PER THE MANUFACTURER'S SPECIFICATION.
- THE BLOWER MAY NOT BE LOCATED FURTHER FROM THE TANK THAN THE MANUFACTURER'S SPECIFICATIONS.
- THE BAT SYSTEM SHALL BE MAINTAINED AND OPERATED FOR THE LIFE OF THE SYSTEM.
- THE BAT SHALL BE OPERATED BY AND MAINTAINED BY A CERTIFIED SERVICE PROVIDER.
- WITHIN ONE MONTH OF INSTALLATION, A PERSON INSTALLING THE BAT SYSTEM SHALL REPORT TO THE MARYLAND DEPARTMENT OF THE ENVIRONMENT (MDE) IN A MANNER ACCEPTABLE TO MDE, THE ADDRESS AND DATE OF COMPLETION OF THE BAT INSTALLATION AND THE TYPE OF BAT INSTALLED.
- ELECTRICAL WORK FOR THE BAT INSTALLATION MUST BE PERFORMED BY A LICENSED ELECTRICIAN.
- AN AGREEMENT AND EASEMENT MUST BE COMPLETED AND SIGNED BY ALL APPLICABLE PARTIES, AND RECORDED IN LAND RECORDS OF HOWARD COUNTY.
- THE HEALTH DEPARTMENT REQUIRES DOCUMENTATION FOR THE START-UP CERTIFICATION FROM THE MANUFACTURER PRIOR TO FINAL APPROVAL OF THE INSTALLATION.

REQUIRED BAT SITE PLAN NOTES



- ANY CHANGE TO THE LOCATIONS OR DEPTHS TO ANY COMPONENTS MUST BE APPROVED BY THE ENGINEER AND THE HOWARD COUNTY HEALTH DEPARTMENT PRIOR TO INSTALLATION. A REVISED SIT PLAN MAY BE REQUIRED.
- THE MAXIMUM DEPTH OF THE BAT SHALL BE PER THE MANUFACTURER'S SPECIFICATION.
- THE BLOWER MAY NOT BE LOCATED FURTHER FROM THE TANK THAN THE MANUFACTURER'S SPECIFICATIONS.
- THE BAT SYSTEM SHALL BE MAINTAINED AND OPERATED FOR THE LIFE OF THE SYSTEM.
- THE BAT SHALL BE OPERATED BY AND MAINTAINED BY A CERTIFIED SERVICE PROVIDER.
- WITHIN ONE MONTH OF INSTALLATION, A PERSON INSTALLING THE BAT SYSTEM SHALL REPORT TO THE MARYLAND DEPARTMENT OF THE ENVIRONMENT (MDE) IN A MANNER ACCEPTABLE TO MDE, THE ADDRESS AND DATE OF COMPLETION OF THE BAT INSTALLATION AND THE TYPE OF BAT INSTALLED.
- ELECTRICAL WORK FOR THE BAT INSTALLATION MUST BE PERFORMED BY A LICENSED ELECTRICIAN.
- AN AGREEMENT AND EASEMENT MUST BE COMPLETED AND SIGNED BY ALL APPLICABLE PARTIES, AND RECORDED IN LAND RECORDS OF HOWARD COUNTY.
- THE HEALTH DEPARTMENT REQUIRES DOCUMENTATION FOR THE START-UP CERTIFICATION FROM THE MANUFACTURER PRIOR TO FINAL APPROVAL OF THE INSTALLATION.

INITIAL SYSTEM			
Number of Bedrooms	6		
Application Rate	1.2	gpd/sf	
Effective Area Beginning Depth	2	ft	
Bottom Max Depth	6	ft	
Design Flow	900	gpd	
Drainage Field square footage	750	sf	
Sidewall reduction credit	0.417		
Trench width	3		
Effective Area Depth	4		
Linear Length of trench Required	104	lf	
1st REPLACEMENT SYSTEM			
Number of Bedrooms	6		
Application Rate	1.2	gpd/sf	
Effective Area Beginning Depth	2	ft	
Bottom Max Depth	6	ft	
Design Flow	900	gpd	
Drainage Field square footage	750	sf	
Sidewall reduction credit	0.417		
Trench width	3		
Effective Area Depth	4		
Linear Length of trench Required	104	lf	
2nd REPLACEMENT SYSTEM			
Number of Bedrooms	6		
Application Rate	1.2	gpd/sf	
Effective Area Beginning Depth	2	ft	
Bottom Max Depth	6	ft	
Design Flow	900	gpd	
Drainage Field square footage	750	sf	
Sidewall reduction credit	0.417		
Trench width	3		
Effective Area Depth	4		
Linear Length of trench Required	104	lf	

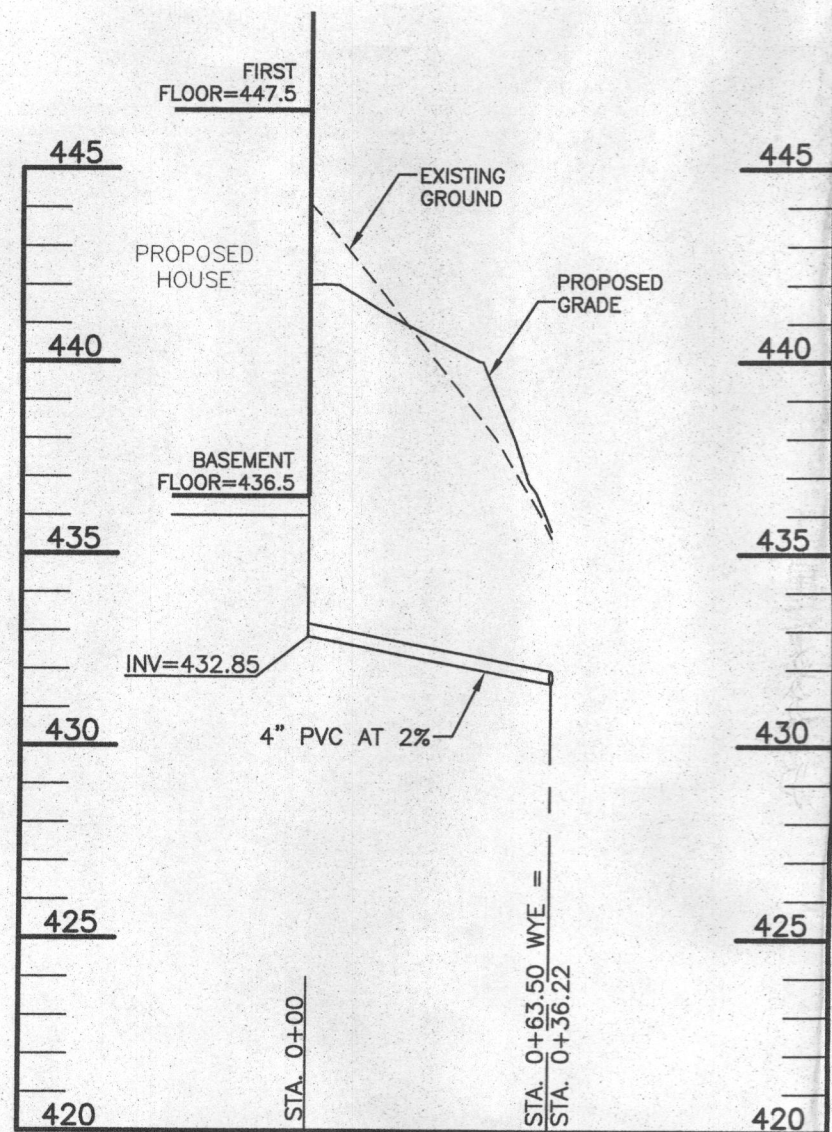


LOT 3 SEPTIC PROFILE - HOUSE
SCALE: 1"=50' HORIZ., 1"=5' VERT.

SYMBOL	TYPE	K _f FACTOR	NAME
C _o *	C	3.7**	CODORUS AND HATBORO SILT LOAM, 0 TO 3 PERCENT SLOPES
C _g *	B	.28	GLENELG LOAM, 3 TO 8 PERCENT SLOPES
M _{sc} *	B	.32	MANOR LOAM, 8 TO 15 PERCENT SLOPES
M _{cd} *	B	.32**	MANOR LOAM, 15 TO 25 PERCENT SLOPES
* INDICATES HYDRIC SOILS			
** HIGHLY ERODIBLE, K>0.35, AND/OR 15% OR GREATER SLOPES			
TAKEN FROM THE NRCS WEB SOIL SURVEY, APRIL 2016. PAGE 15			

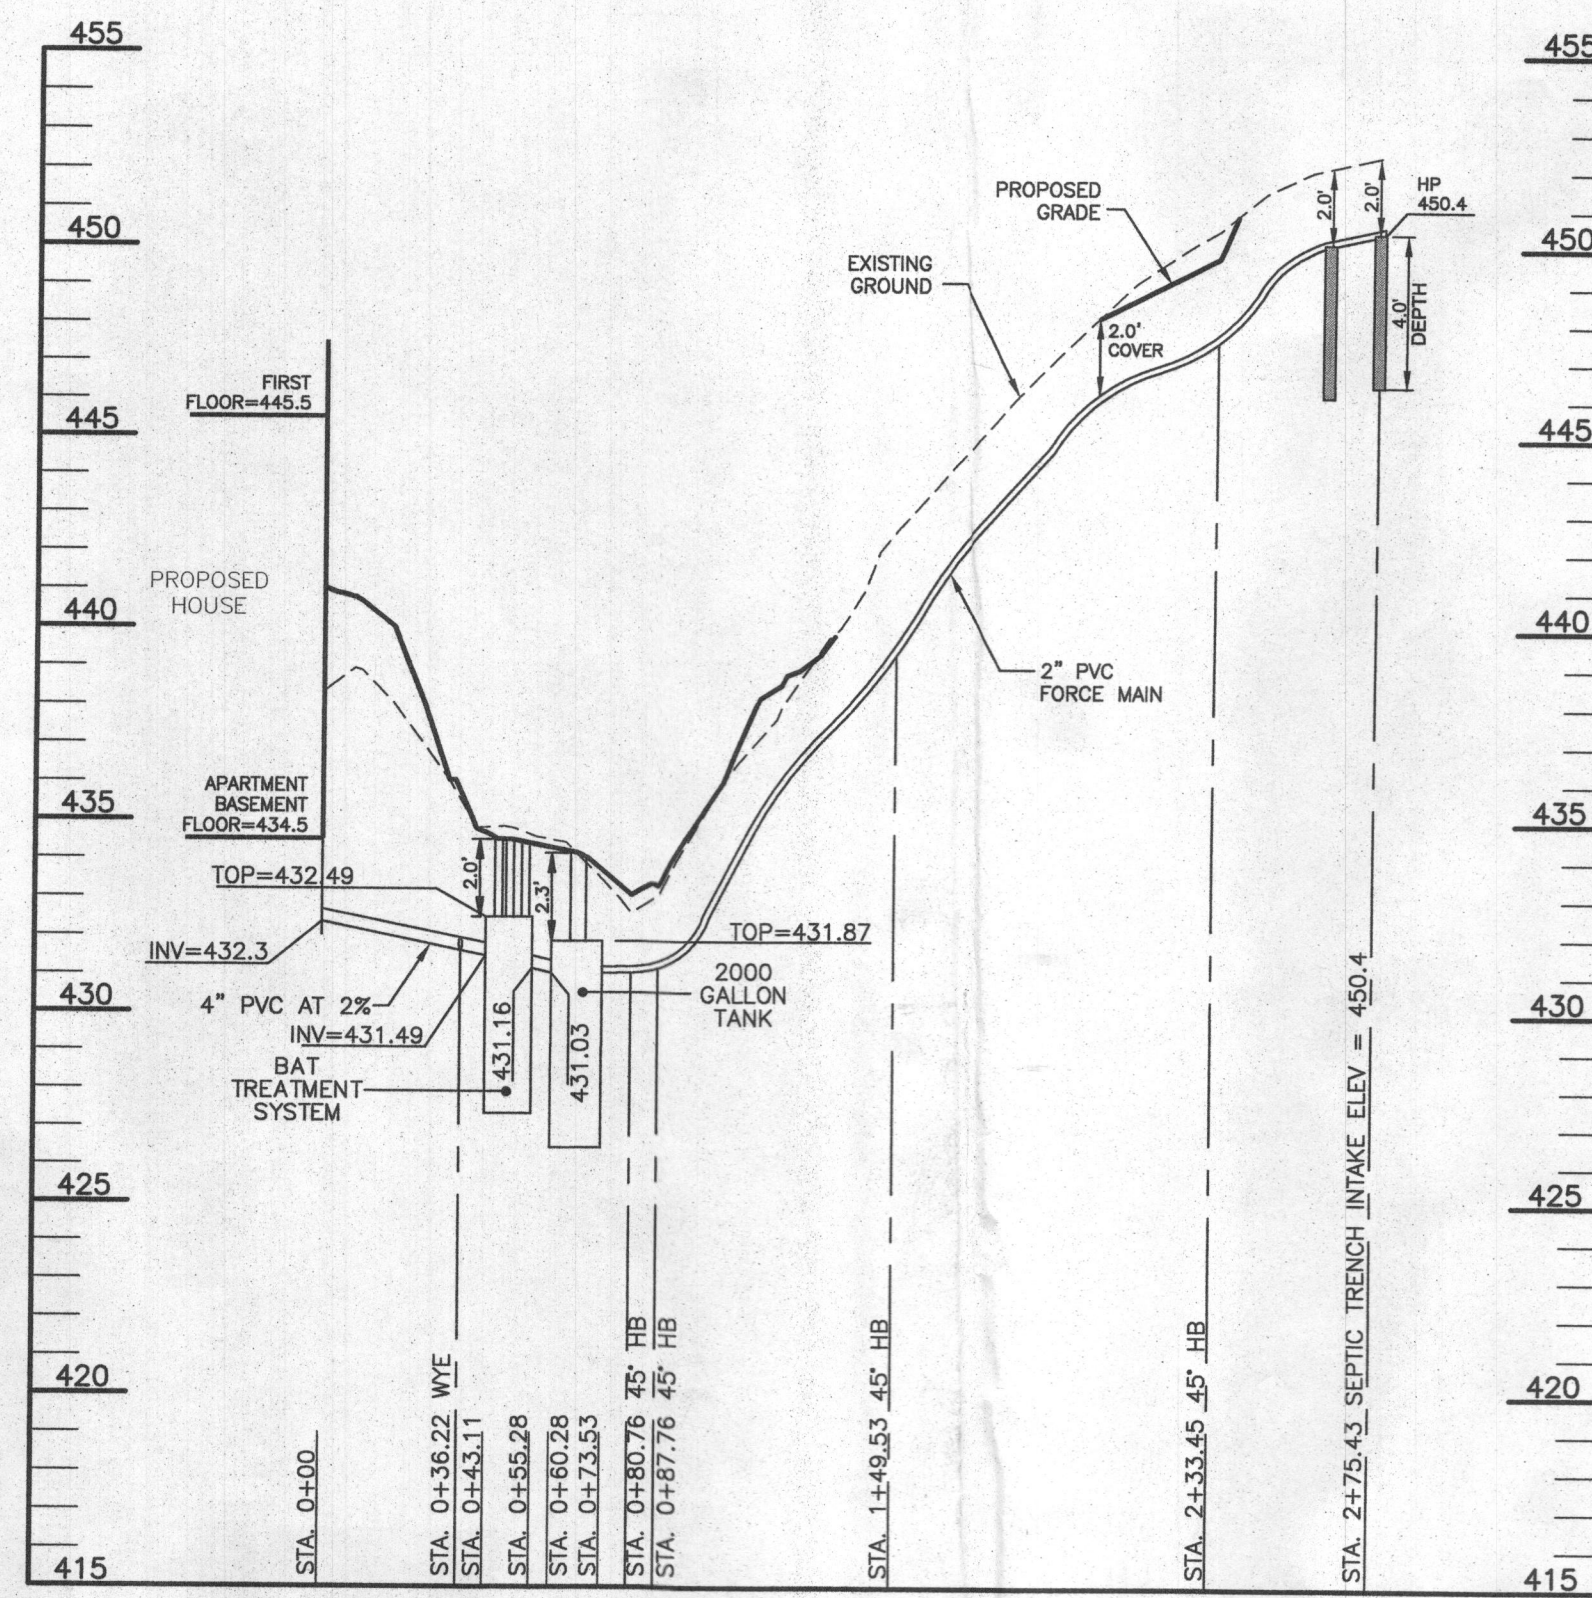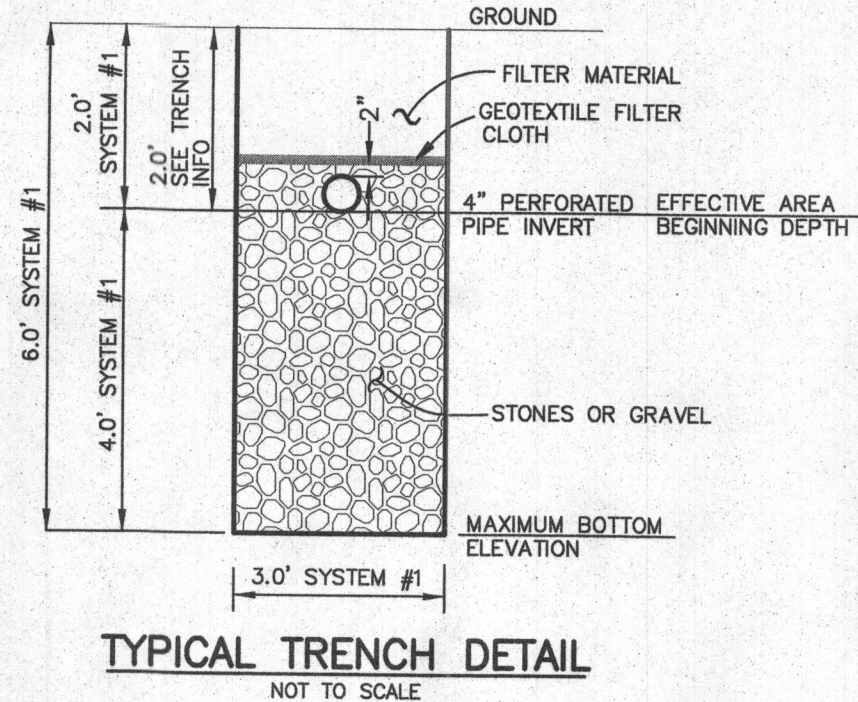

LOT 3 SEPTIC PROFILE - APARTMENT
SCALE: 1"=50' HORIZ., 1"=5' VERT.

TRENCH INFORMATION			
TRENCH 1-1			
TRENCH LENGTH	52 LF		
GROUND ELEVATION	552.4		
INVERT ELEVATION	550.4		
MAX. BOTTOM ELEV.	546.4		
TRENCH 1-2			
TRENCH LENGTH	52 LF		
GROUND ELEVATION	552.1		
INVERT ELEVATION	550.1		
MAX. BOTTOM ELEV.	546.1		
TRENCH 2-1			
TRENCH LENGTH	52 LF		
GROUND ELEVATION	551.5		
INVERT ELEVATION	549.5		
MAX. BOTTOM ELEV.	545.5		
TRENCH 2-2			
TRENCH LENGTH	52 LF		
GROUND ELEVATION	551.0		
INVERT ELEVATION	549.0		
MAX. BOTTOM ELEV.	545.0		
TRENCH 3-1			
TRENCH LENGTH	52 LF		
GROUND ELEVATION	550.1		
INVERT ELEVATION	548.1		
MAX. BOTTOM ELEV.	544.1		
TRENCH 3-2			
TRENCH LENGTH	52 LF		
GROUND ELEVATION	548.8		
INVERT ELEVATION	546.8		
MAX. BOTTOM ELEV.	542.8		

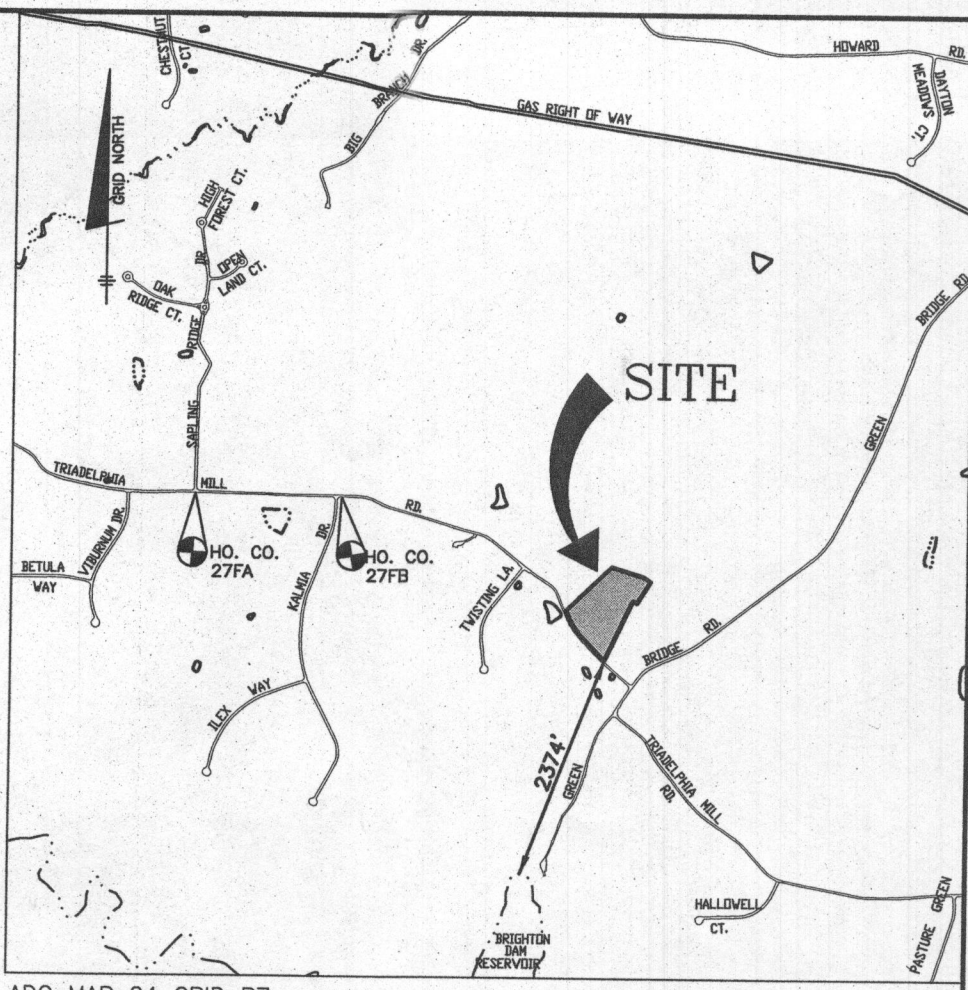

VICINITY MAP
SCALE: 1"=2000'

BENCHMARKS (NAD83)			
HO. CO. No. 27FA	ELEV. 498.35		
18.2' SOUTH OF THE CENTERLINE OF TRIADELPHIA MILL RD AT THE INTERSECTION OF SARLING RIDGE DR.			
N 569002.176	E 1306892.586		
HO. CO. No. 27FB	ELEV. 512.22		
3.2' SOUTH OF THE EDGE OF PAVING OF TRIADELPHIA MILL RD 61' EAST OF THE CENTERLINE OF KALMIA DR.			
N 568975.151	E 1308421.369		

LEGEND

SOILS CLASSIFICATION	AmB
SOILS DELINEATION	---
EXISTING CONTOURS	480 478
EXISTING WOODS LINE	~~~~~
EXISTING WELL	W
PROPOSED WELL	PROPOSED WELL BOX
PASSING PERCOLATION TEST	○
FAILING PERCOLATION TEST	●
EXISTING STRUCTURE	---
PROPOSED STRUCTURE	---
PROPOSED SEWAGE DISPOSAL AREA	---
BETWEEN 20% AND 24.99% SLOPES	---
EX. 100 YEAR FLOODPLAIN	---

THE CONTRACTOR SHALL NOTIFY THE DEPARTMENT OF PUBLIC WORKS/BUREAU OF ENGINEERING/CONSTRUCTION INSPECTION DIVISION AT 410-313-1880 AT LEAST FIVE (5) WORKING DAYS PRIOR TO THE START OF ANY WORK.

THE CONTRACTOR SHALL NOTIFY "MISS UTILITY" AT 1-800-257-7777 AT LEAST 48 HOURS PRIOR TO ANY EXCAVATION WORK BEING DONE.

REDLINE OK
12/17/2018

BENCHMARK ENGINEERING, INC.
ENGINEERS LAND SURVEYORS PLANNERS
8480 BALTIMORE NATIONAL PIKE & SUITE 315 A ELLICOTT CITY, MARYLAND 21043
(P) 410-465-8102 (F) 410-465-8944
WWW.BE-CVLENGINEERING.COM

Professional Certification. I hereby certify that these documents were prepared or approved by me, and that I am a duly licensed professional engineer under the laws of the State of Maryland, License No. 45577, Expiration Date: 06-08-2018.

John M. Vawter
JOHN M. VAWTER
No. 45577
PROFESSIONAL ENGINEER

OWNER/DEVELOPERS:
ELLEN M. VAWTER,
MICHAEL A. VAWTER,
NANCY J. VAWTER,
LAURA J. LEONARD,
DREW B. LEONARD
14170 TRIADELPHIA MILL ROAD
DAYTON, MARYLAND 21036
301-706-6044

PROJECT:
VAWTER PROPERTY LOT 3
LOCATION: 14176 TRIADELPHIA MILL ROAD
TAX MAP: 27 - GRID: 24 - PARCEL: 68
ZONED: RR-DEO RURAL RESIDENTIAL
ELECTION DISTRICT NO. 5 - HOWARD COUNTY, MARYLAND
TITLE: SEPTIC SYSTEM DESIGN PLAN
DATE: DECEMBER, 2017 PROJECT NO. 2766
SCALE: AS SHOWN SHEET 1 OF 3

NO.	DATE	REVISION
1	11/29/18	REVISED TO DOCUMENT ADDITIONAL HOUSE CONNECTION AS-BUILT

DESIGN: LDD DRAFT: LDD CHECK: AAM