

Vawter Property L3243

AP

P-6

dk brn sl, 1/2" blk
red-brn L
2-3 blk common mica
red-brn L
2 musbk
yel-red & pale brn
sl, thin platy
many mica
grey ls, platy
csp (ye-red)
csp (dk brn)
water

P-8

dk grey-brn sl
1/2" blk
brn sl, 1/2" blk
pale brn
& pale yellow
ls, thin platy
10-12% channels
many mica
red-brn ls
platy, many mica
pale brn
ls, thin platy
10-12% channels

P-14

dk grey-brn
sl, 1/2" blk
brn L, 2 blk
red-brn sl
thin platy
common mica
red-brn sl
thin platy
red-vel & pale yellow
ls, platy, many mica
grey ls, water seeps

North

Lot 2

P-7
Pass

P-8
Pass

P-6
Hold

Undulating

P-9
Fail

P-10
Pass

P-11
Pass

P-12
Fail

P-13
Pass

P-14
Fail

Cadonius soil Map unit

P-12

brn sl, 1/2" blk
brn sl, 1/2" blk
many mica
pale brn
& pale yellow
ls, thin platy
10-12% channels
many mica
red-vel
vch ls, thin platy
(spp. lite, dense)
air

P-13

dk brn sl, 1/2" blk
brn chsl, 2 blk
brn sl, 2 blk
yel-red & brn
sl, 2 musbk
many mica
yel-red & pale brn
ls, thin platy
many mica
pale brn ls, dry

34

34

DATE	TEST #	DEPTH	START	BREAK 1" DROP	STOP 2" DROP	TIME OF 2ND INCH	P/F/H
7/7/16	P-6	4.5' / 1.5'	11:08	11:11	11:17	6	H
7/7/16	P-9	4.3' / 1.5'	11:28	1:5	3.2	1.7 min	F
7/7/16	P-8	4.5' / 1.5'	11:51	11:53	11:56	3	P
7/7/16	P-12	3' / 1.3'	12:02	12:05	12:06	—	Report
7/7/16	Repair P-12	3' / 1.3'	12:07:20	12:08:12	12:09:30	1.2	2.95
7/7/16	Repair P-12	3' / 1.3'	12:10:35	12:11:50	12:13:45	1.2	3.5
7/7/16	P-13	4.5' / 1.3'	12:22	12:28	12:32	10	P
7/7/16	P-14	5.3' / 1.8'	12:44	1:14	within 10.7	—	F

REMARKS

SANITARIAN

R Bricker

BACKHOE

Not Ricks

OTHERS

John

TEST HOLES USED IN SDA

AVG. PERC TIME

SQ. FT/BR

TRENCH WIDTH

INLET DEPTH

MAX. BOT DEPTH

EFFECTIVE SW

Vawter Property
Lot 2

AP

P-24

Mixed
Shredded
organic mat.
d rope, decapod
PIC

2.5' olive & grey
L, 0m

3.5' red-brn
to H-brn
thick platy
many mica

4.5' In-brn & red-yel

13' No platy
many mica
10% channers
below 0'

P-25

Mixed
shredded
organic mat.
board
plastic

olive & grey
L, 0m

brn. 2msk

4' H. red-brn
fsl, thick platy
many mica

4' H. red-brn
fsl, platy

to pale brn
fsl, thin platy
many mica
5 to channers

DRIVE WAY

P

P-31

P-24

P-25

P-23
Fail

Stake

Swale
(Fill?)

North

P-23

sh red
organic
material
dk grey brn
L on fsl, 0m

P-31

black
shredded
organic materials
brn. 2msk
red-brn
2msk
red-brn
fsl, thick
platy

4.5' In-brn
red-yel
pale brn
fsl, thin platy
many mica
10% channers

DATE	TEST #	DEPTH	START	BREAK 1" DROP	STOP 2" DROP	TIME OF 2ND INCH	P/F/H
7/8/11	P-24	6'10"	1:08	1:11	1:15	4	P
7/8/11	P-25	6'2"	1:23	1:30	1:33	3	P
7/8/11	P-23	4.5'	Visual	Organic fsl	to 5' 2"		F
7/8/11	P-31	6'5"	1:44	1:46	1:49	3	P

REMARKS

Stake P-24 is SDA corner

SANITARIAN

K. Bricker

BACKHOE

Hot Field

OTHERS

John Curry

TEST HOLES USED IN SDA

AVG. PERC TIME

SQ. FT/BR

TRENCH WIDTH

INLET DEPTH

MAX. BOT DEPTH

EFFECTIVE SW

Lots 2 & 3

AP

0.8
2.4
12.8

P-11
dk grey-brn
to brn sl, 1 vlsbk
red-brn sl
2 vlsbk common mica
lt. brn & pale brn
ls, thin plat
many mica
incl. common coarse mica
5%-8% clammers

0.3
1.5
2.2

P-10
dk grey-brn
to brn sl, 1 vlsbk
brn sl, 2 vlsbk
brn & gel-red
chls, thin plat
many mica

11


P-7
pale brn
& red-yel
chls, platy
15% rock
many mica
few clammers & boulders

0.3
1.4
2.4

P-7
dk grey-brn
sl, 1 vlsbk
brn chsl
1 vlsbk
lt. brn & gel-red
chls, thin plat
many mica


11

P-7
red-brn
& pale brn
ls, thin plat
many mica
incl. common coarse mica
few stones

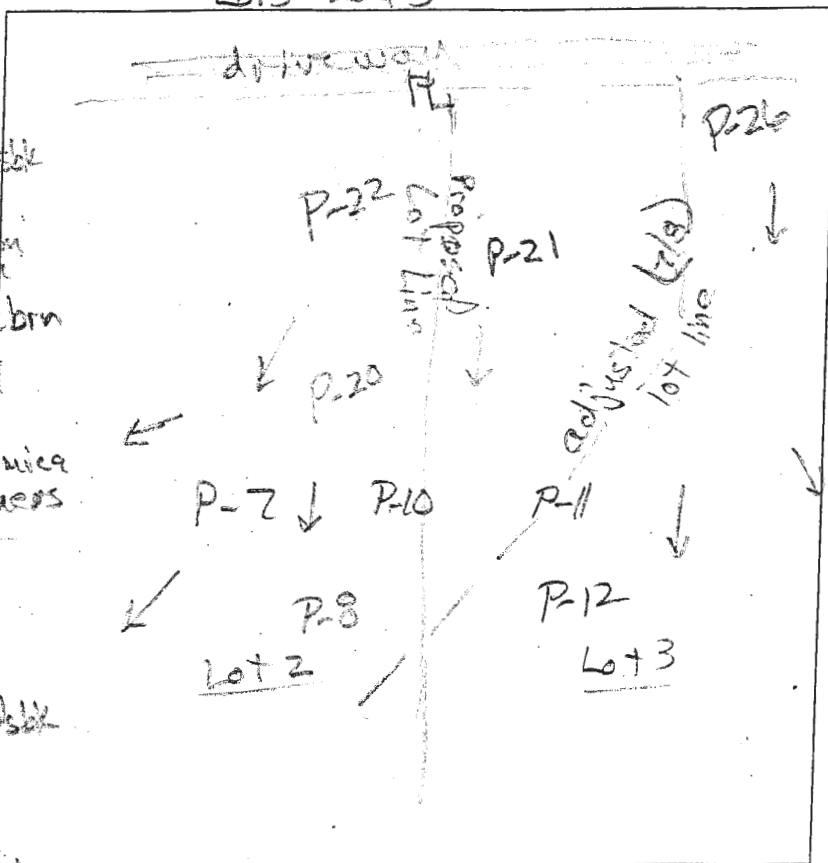

DATE	TEST #	DEPTH	START	BREAK 1" DROP	STOP 2" DROP	TIME OF 2ND INCH	P/F/H
7/7/16	P-11	4'5" / 12.8'	1:25	1:28	1:31	3	P
7/7/16	P-10	4'0" / 11'	1:35	1:37	1:40	3	P
7/7/16	P-7	4'3" / 11'	1:44	1:51	1:54	3	P

REMARKS
SANITARIAN R. Bricker BACKHOE Hot Child's OTHERS John Carney
TEST HOLES USED IN SDA Donnie & Pedro AVG. PERC TIME SQ. FT/BR
TRENCH WIDTH INLET DEPTH MAX. BOT DEPTH EFFECTIVE SW

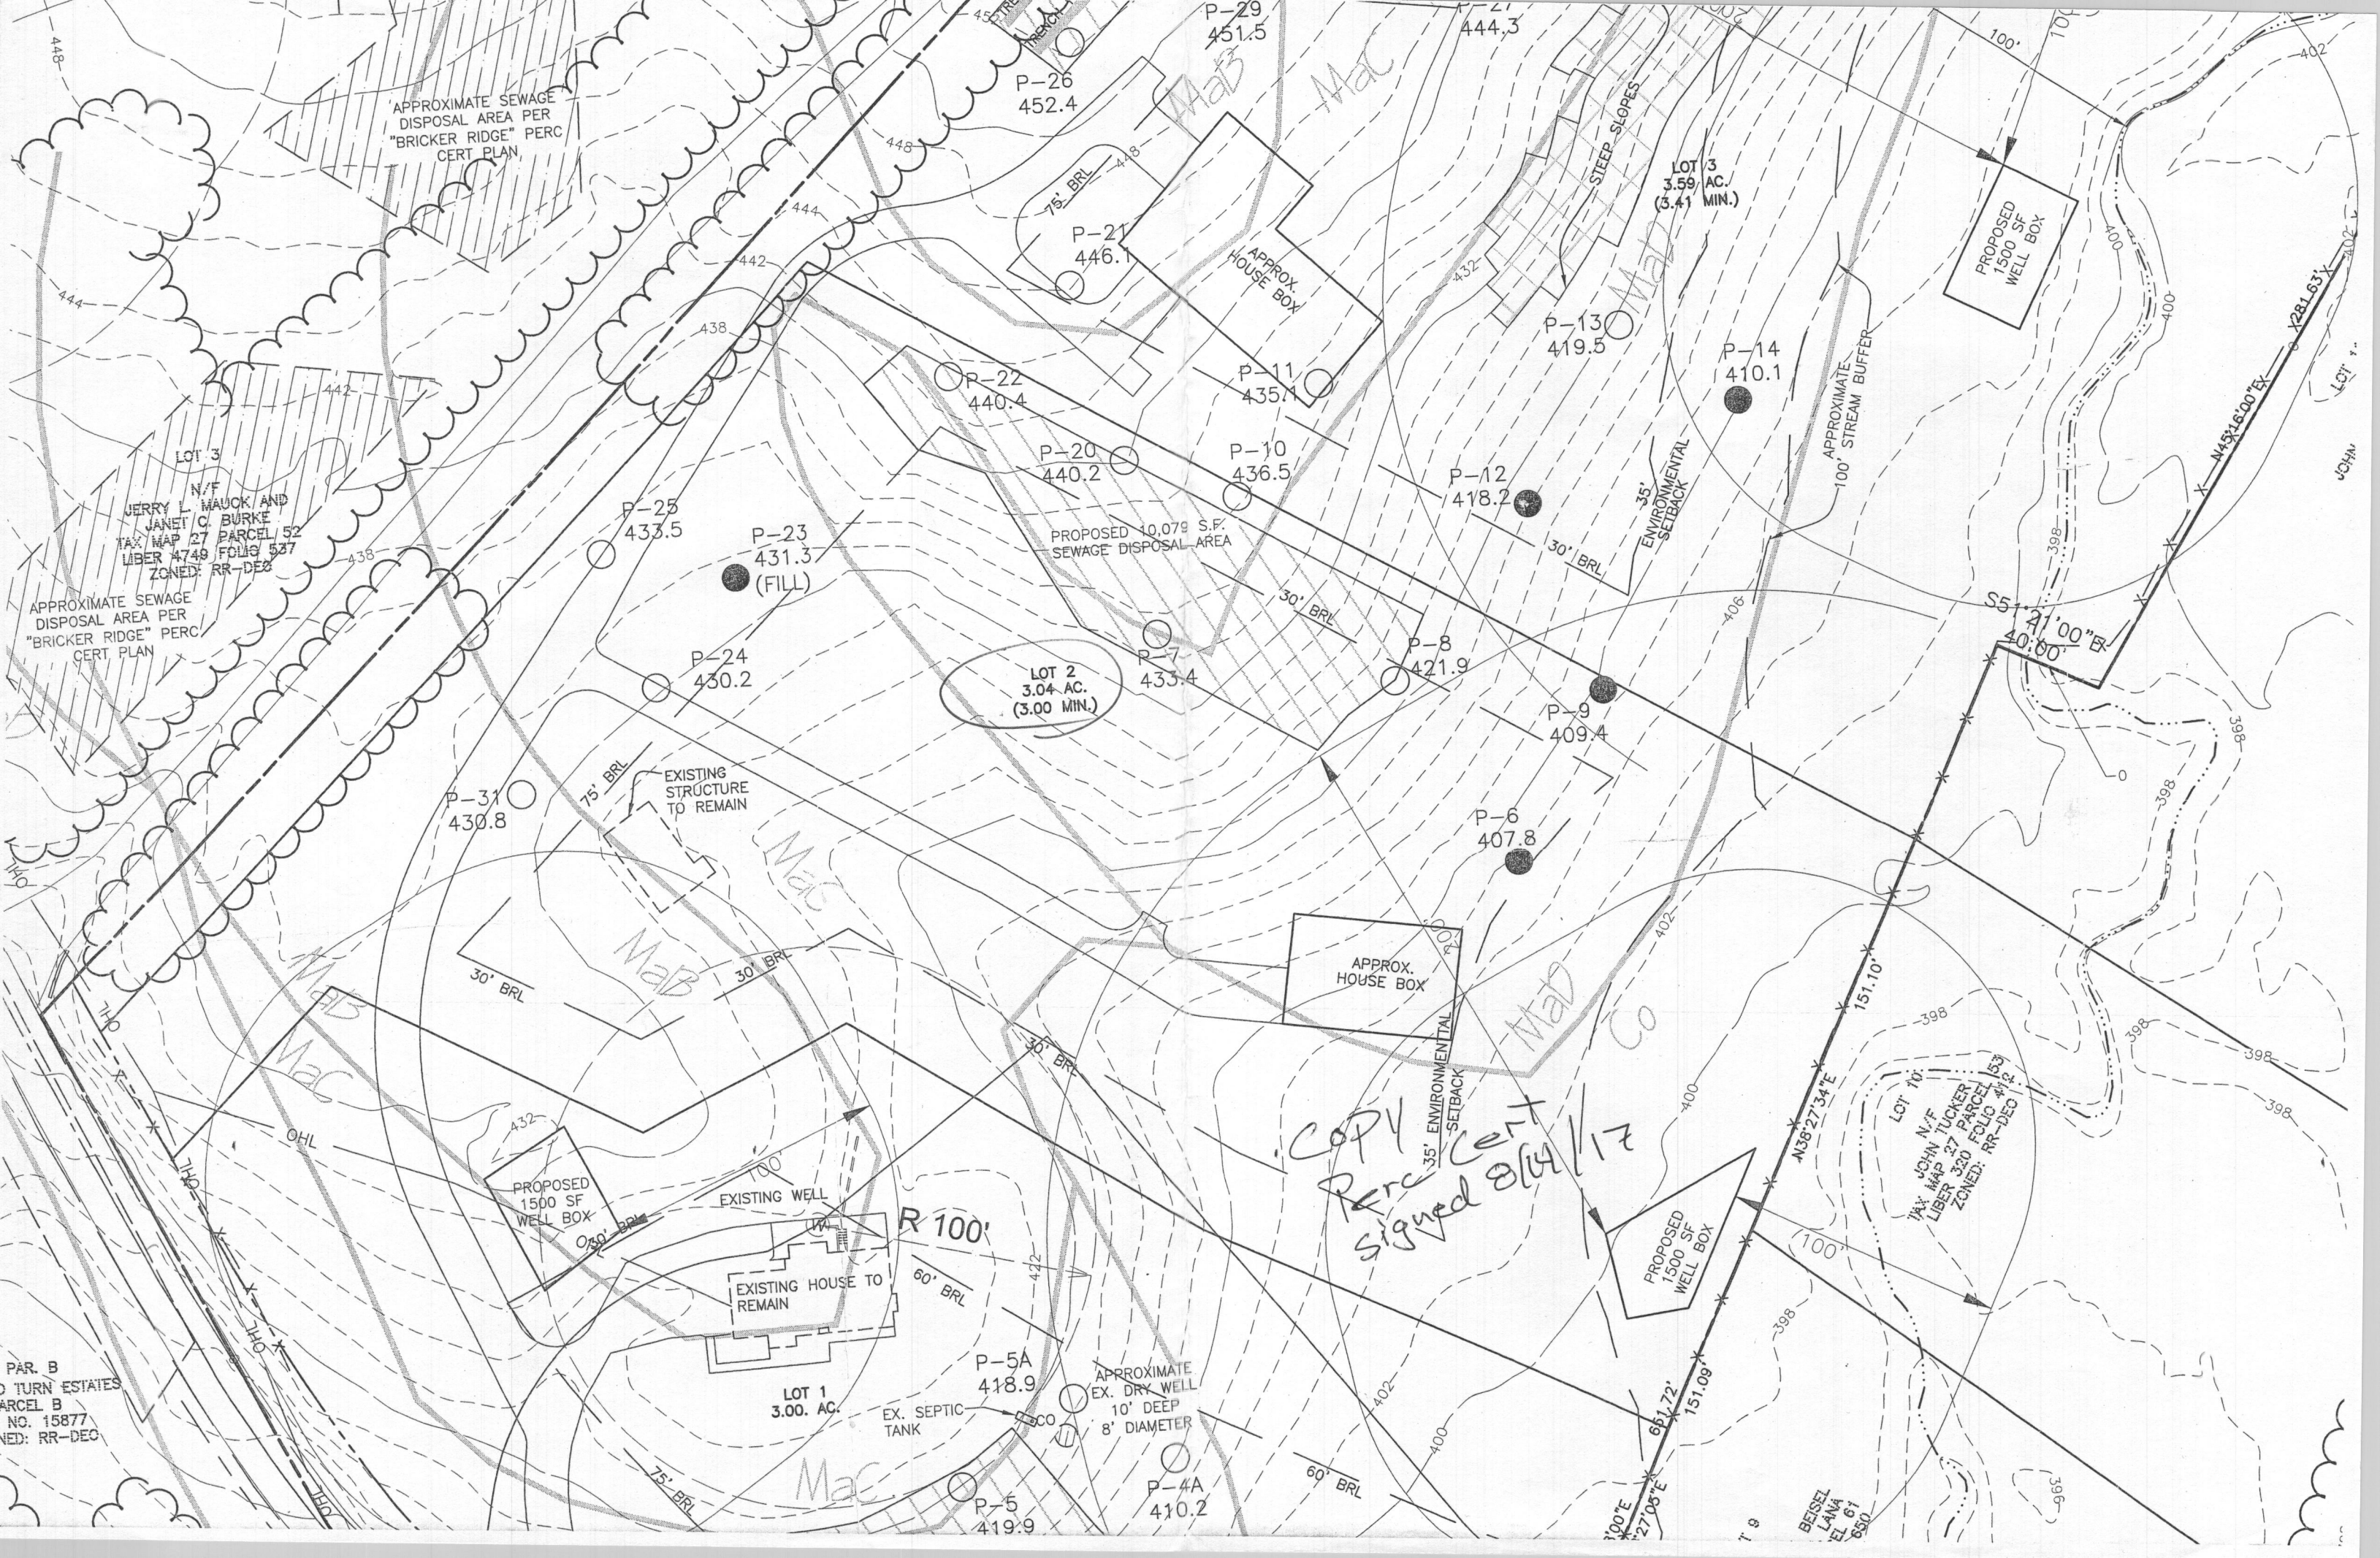

APPROXIMATE SEWAGE DISPOSAL AREA PER "BRICKER RIDGE" PERC CERT PLAN

LOT 3
N/F
JERRY L. MAUCK AND
JANET C. BURKE
TAX MAP 27 PARCEL 52
LIBER 4749 FOLIO 537
ZONED: RR-DEC

APPROXIMATE SEWAGE DISPOSAL AREA PER "BRICKER RIDGE" PERC CERT PLAN

LOT 2
3.04 AC.
(3.00 MIN.)

LOT 3
3.59 AC.
(3.41 MIN.)

PROPOSED
1500 SF
WELL BOX

APPROX.
HOUSE BOX

PROPOSED
1500 SF
WELL BOX

EXISTING WELL

EXISTING HOUSE TO
REMAIN

LOT 1
3.00 AC.

EX. SEPTIC
TANK

APPROXIMATE
EX. DRY WELL
10' DEEP
8' DIAMETER

PROPOSED
1500 SF
WELL BOX

LOT 10
N/F
JOHN TUCKER
TAX MAP 27 PARCEL 153
LIBER 330 FOLIO 412
ZONED: RR-DEC

COPY
Rec Cert
signed 8/14/17

PAR. B
TURN ESTATES
PARCEL B
NO. 15877
ZONED: RR-DEC

BEISEL
LANA
EL 6'1"
850