

Repair perc
5/22/79
1:30 p.m.
~~2~~

APPLICATION

SEWAGE DISPOSAL TESTING

STATE OF MARYLAND - DEPARTMENT OF HEALTH AND MENTAL HYGIENE

A _____

P Repair

HOWARD COUNTY HEALTH DEPARTMENT
ENVIRONMENTAL HEALTH SERVICES
P.O. BOX 476 ELLICOTT, MARYLAND 21043
TELEPHONE: 992-2330

DISTRICT 4th

DATE 5/18/79

TO: THE COUNTY HEALTH OFFICER
ELLICOTT CITY, MARYLAND

I HEREBY APPLY FOR THE NECESSARY TEST IN ORDER TO CONSTRUCT (OR RECONSTRUCT) A SEWAGE DISPOSAL SYSTEM.

PROPERTY OWNER Hobart L. Delph *Phone: 489-4426*

ADDRESS 589 Woodbine Road, Woodbine, Md, 21797 PHONE Arnold - 795-7873

PROPERTY LOCATION

SUBDIVISION _____ LOT NO _____

ROAD AND DESCRIPTION 589 Woodbine Road

SIZE OF LOT ? TYPE BLDG ?

THE SYSTEM INSTALLED UNDER THIS APPLICATION IS ACCEPTABLE ONLY UNTIL PUBLIC FACILITIES BECOME AVAILABLE.

I FULLY UNDERSTAND THE FEE CONNECTED WITH THE FILING OF THIS PERC TEST APPLICATION IS NON-REFUNDABLE UNDER

ANY CIRCUMSTANCES.

SIGNATURE OF APPLICANT /s/ Bud Arnold for Hobart L. Delph



APPROVED BY _____ FOR _____ DATE _____

REJECTED BY G Keller FOR ANY/ANYWHERE DATE 22 MAY 79

HOLD PENDING FURTHER TESTS _____ DATE _____

REASONS FOR REJECTION OR HOLDING 22 MAY 79 poor soil; ground water encountered
shallow depths (GLK)
discussed with FFC

THIS IS NOT A PERMIT

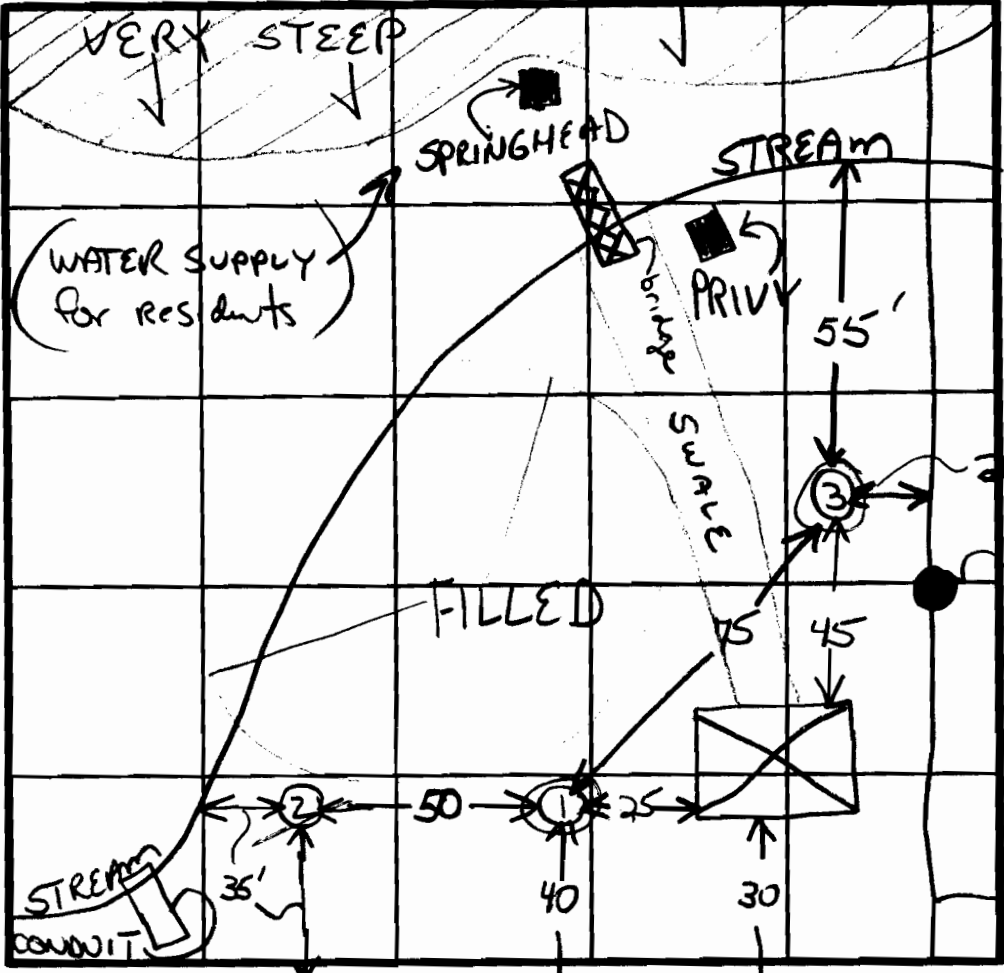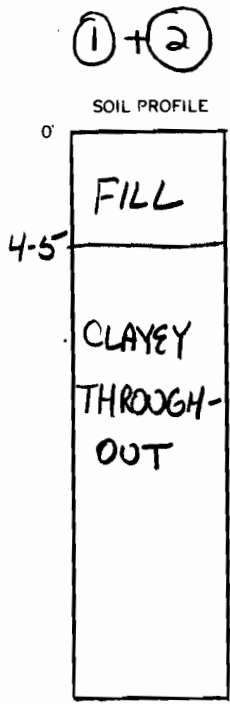

Elevation
① = ②
③ 5' lower than ①-②
C&P TELEPHONE POLE

HOLE ③

TOP SOIL 0.6 Storm

1/2-2' GRAYISH MOTTLED CLAY
7' RED CLAY
12'

INDICATE NORTH - NAME ADJOINING ROADWAY AS BASE LINE
BELOW EXISTING GRADE WOODRINE ROAD E → US. 70

DATE	TEST NO.	DEPTH	PRE-WET		TEST - 1" DROP		TIME
			START	STOP	START	STOP	
5/22/79	① ⑩	⑥ ⑬	326 326	341 341	NO MOVEMENT		FAILS
	②	12'	WATER		AT 10'		
	③	12'	WATER		AT 5 1/2'		

REMARKS Lot filled certain areas - relatively level

TYPE OF SOIL see profile

TESTED BY GLK

ALSO PRESENT Arnold, Delphi's Saw