

## Real Property Data Search ( w4)

## Search Result for HOWARD COUNTY

View Map		View GroundRent Redemption		View GroundRent Registration	
Tax Exempt:		Special Tax Recapture:			
Exempt Class:		NONE			
Account Identifier:		District - 04 Account Number - 327055			
Owner Information					
Owner Name:		RUPPALT MATTHEW H & WF		Use: RESIDENTIAL	
Mailing Address:		467 W WATERSVILLE RD MT AIRY MD 21771-3643		Principal Residence: YES	
				Deed Reference: /00653/ 00359	
Location & Structure Information					
Premises Address:		467 W WATERSVILLE RD MT AIRY 21771-0000		Legal Description: 5.000 ACRES 467 W WATERSVILLE RD MT AIRY	
Map:	Grid:	Parcel:	Sub District:	Subdivision:	Section: Block: Lot: Assessment Year: Plat No: Plat Ref:
0002	0014	0121		0000	2017
Special Tax Areas:		Town:		NONE	
		Ad Valorem:		100	
		Tax Class:			
Primary Structure Built		Above Grade Living Area		Finished Basement Area	
1977		1,712 SF		364 SF	
Property Land Area		County Use		5.0000 AC	
Stories	Basement	Type	Exterior	Full/Half Bath	Garage Last Major Renovation
Split Foyer	YES	SPLIT FOYER	SIDING	2 full	1Att/1Det
Value Information					
Base Value		Value		Phase-in Assessments	
		As of 01/01/2017		As of 07/01/2018 As of 07/01/2019	
Land:		235,000		215,000	
Improvements		156,100		142,300	
Total:		391,100		357,300 357,300	
Preferential Land:		0		0	
Transfer Information					
Seller:		Date:		Price:	
Type:		Deed1:		Deed2:	
Seller:		Date:		Price:	
Type:		Deed1:		Deed2:	
Seller:		Date:		Price:	
Type:		Deed1:		Deed2:	
Exemption Information					
Partial Exempt Assessments:		Class		07/01/2018 07/01/2019	
County:		000		0.00	
State:		000		0.00	
Municipal:		000		0.00 0.00 0.00 0.00	
Tax Exempt:		Special Tax Recapture:			
Exempt Class:		NONE			
Homestead Application Information					

# HOWARD COUNTY HEALTH DEPARTMENT



## Receipt

Date September 13, 1995

Name Fisher, Collins and Carter, Inc.

Telephone No. 461-2855

**DETAILED LOCATION OF SITE, DEVELOPMENT, SECTION,  
ROAD, LOT NO. & ELECTION DISTRICT**

Delagrang Property  
West Watersville Road

1 New Perc. - \$ 225.00

2 Existing Dwellings \$ 50.00

Percolation Testing Application

\$ 275.00

Received VR  
Payment CK# 1667

ORIGINAL

A-50870

MARYLAND BUSINESS FORMS, INC. R-16468

THIS RECEIPT IS NOT  
A PERMIT AND IT IS  
NOT A WARRANTY OF  
PERFORMANCE OF  
THE SYSTEM THAT  
IS INSTALLED

Howard County Health Department

To: \_\_\_\_\_

*Per letter*

*West Watersville Rd*

*Limit Satis*

*Further Review contingent, , ,*

From: \_\_\_\_\_

Date: \_\_\_\_\_

HD-170

# APPLICATION

PERCOLATION TESTING

A 50870C

P \_\_\_\_\_

HOWARD COUNTY HEALTH DEPARTMENT  
BUREAU OF ENVIRONMENTAL HEALTH  
3525-H ELLICOTT MILLS DRIVE/ELLICOTT CITY, MARYLAND 21043  
TELEPHONE: 313-2640

DISTRICT FOURTH

DATE 9/13/95

TO: THE COUNTY HEALTH OFFICER  
ELLICOTT CITY, MARYLAND

I HEREBY APPLY FOR THE NECESSARY TEST PRIOR TO APPLICATION FOR PERMIT TO CONSTRUCT (OR RECONSTRUCT) A SEWAGE DISPOSAL SYSTEM.

PROPERTY OWNER ARTHUR AND JANICE DELAGRANGE

ADDRESS 437 WEST WATERSVILLE ROAD PHONE 301 829 2430

AGENT OR PROSPECTIVE BUYER \_\_\_\_\_

ADDRESS \_\_\_\_\_ PHONE \_\_\_\_\_

PROPERTY LOCATION:

SUBDIVISION WATERSVILLE ROAD LOT NO. 3 EXISTING DWELLING

ROAD AND DESCRIPTION WEST WATERSVILLE ROAD

TAX MAP 2 PARCEL # 103#121

SIZE OF LOT 2.9 AC± TYPE BLDG. SINGLE FAMILY  
(SINGLE FAMILY DWELLING OR COMMERCIAL)

THE SYSTEM INSTALLED UNDER THIS APPLICATION IS ACCEPTABLE ONLY UNTIL PUBLIC FACILITIES BECOME AVAILABLE. I FULLY UNDERSTAND THE  
FEE CONNECTED WITH THE FILING OF THIS PERC TEST APPLICATION IS NON-REFUNDABLE UNDER ANY CIRCUMSTANCES. I ALSO AGREE TO  
COMPLY WITH ALL M.O.S.H.A. REQUIREMENTS IN TESTING THIS LOT.

(SIGNATURE OF APPLICANT)

APPROVED BY \_\_\_\_\_ FOR \_\_\_\_\_ DATE \_\_\_\_\_

DISAPPROVED BY \_\_\_\_\_ FOR \_\_\_\_\_ DATE \_\_\_\_\_

HOLD PENDING FURTHER TESTS \_\_\_\_\_

REASONS FOR REJECTION OR HOLDING \_\_\_\_\_

PERCOLATION TEST PLAT/PRELIMINARY PLAT - TITLE OR I.D. # \_\_\_\_\_ DATE \_\_\_\_\_

SITE DEVELOPMENT PLAN/FINAL PLAT - TITLE OR I.D. # \_\_\_\_\_ DATE \_\_\_\_\_

# THIS IS NOT A PERMIT



6+3?

## SOIL PROFILE

0'

2

ち

9

yellow  
 chsil  
 -asil  
 pale yellow  
 -Tn  
 chsil  
 25 ± %  
 dense  
 (1/2" by 1/2")

>70%  
Large Flagg  
+ Channels

Refusal



## SOIL PROFILE

0:

INDICATE NORTH - NAME ADJOINING ROADWAY AS BASE LINE.

[illegible]

REMARKS

TYPE OF SOIL

TESTED BY

## ALSO PRESENT

TRENCH DESIGN DATA: AVERAGE PERCOLATION TIME

TRENCH WIDTH

INLET DEPTH

MAXIMUM BOTTOM DEPTH

SQ. FT./BEDROOM



---

## HOWARD COUNTY HEALTH DEPARTMENT

---

*Joyce M. Boyd, M.D., County Health Officer*

September 12, 1995

Mr. and Mrs. Arthur & Janice Delagrang  
437 West Watersville Road  
Mt. Airy, Maryland 21771-3643

*Paid - A 50870*

RE: PERCOLATION TESTING  
Proposed 3 Lot Subdivision  
Delagrang Property  
Tax Map 2, Parcels 103 & 121  
West Watersville Road

Dear Mr. and Mrs. Delagrang:

A percolation test date has been reserved for 10 a.m. Friday, October 6, 1995 contingent upon payment of test fees (\$225.00 for the new lot and \$25.00 for each of the two existing houses) no later than two weeks prior to the scheduled test date.

You will be responsible for having a contractor on-site to excavate test holes at the corners of proposed percolation area.

Please call this office between 8:30 a.m. and 4:30 p.m., Monday through Friday, to confirm your acceptance of this percolation test date.

Thank you for your cooperation in this matter.

Very truly yours,

Craig Williams, Program Director  
Water and Sewerage Program

CW:vr

cc: Chuck Crovo - Fisher, Collins & Carter  
File

cc:



---

## HOWARD COUNTY HEALTH DEPARTMENT

---

Joyce M. Boyd, M.D., County Health Officer  
October 24, 1995

Arthur & Janice Delagrang  
437 West Watersville Road  
Mt. Airy, MD 21771-3643

RE: PERCOLATION TEST RESULTS  
Application #A50870 A,B,C  
Proposed Use: Proposed 3 lot  
subdivision  
Delagrang Property  
West Watersville Road  
Tax Map 2 Parcel 103 & 121

Dear Mr. & Mrs. Delagrang:

Percolation testing conducted October 6, 1995 on the above referenced property indicated limited satisfactory soil conditions.


Limiting soil conditions were excessively slow percolation rates at shallow soil depths, and high percentage of rock fragments combined with excessively fast percolation rates at moderate depth. Copies of the test results are enclosed.

The area with the most favorable results is somewhat compromised by 3 site defects which may or may not be solvable. The 3 problems were (1) proximity of an excessively rocky test hole near one side of the suitable area, (2) existing well site less than 100ft from the rear property line (another side) and, (3) that this best site is on the high point of this proposed lot, thus limiting the possibility of obtaining a suitable well site for this property.

Further review is contingent upon submission by a registered engineer of a percolation certification plat showing actual locations and elevations of all excavated test holes and a suitable house and well site. the plat should also include the location of all existing wells and septic systems on the property as well as the location of any other relevant features such as streams, swales, or existing structures. A note must be included certifying that all wells and septic systems within 100' of property boundaries have been shown.

This should be submitted within sixty (60) days to allow field verification if necessary. If you have any questions regarding this matter, please feel free to contact me at the above address or by calling 313-2640.

Very truly yours.

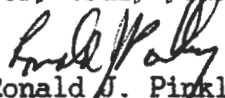  
Ronald J. Pinkley, R. S.  
Water and Sewerage Program

RP:rc  
Enclosures  
cc: Matthew & Bernice Ruppalt

File

---

Bureau of Environmental Health  
3525-H Ellicott Mills Drive Ellicott City, Maryland 21043-4544  
Water and Sewerage, Permits (410) 313-2640 Community Environmental Health (410) 313-2644  
Food Protection Program (410) 313-2642 TDD (410) 313-2323

# APPLICATION

PERCOLATION TESTING

A 50870 A

P \_\_\_\_\_

DISTRICT FOURTH

DATE 9/13/95

HOWARD COUNTY HEALTH DEPARTMENT

BUREAU OF ENVIRONMENTAL HEALTH

3525-H ELLICOTT MILLS DRIVE/ELLICOTT CITY, MARYLAND 21043  
TELEPHONE: 313-2640

TO: THE COUNTY HEALTH OFFICER  
ELLICOTT CITY, MARYLAND

I HEREBY APPLY FOR THE NECESSARY TEST PRIOR TO APPLICATION FOR PERMIT TO CONSTRUCT (OR RECONSTRUCT) A SEWAGE DISPOSAL SYSTEM.

PROPERTY OWNER ARTHUR AND JANICE DELAGRANGE

ADDRESS 437 WEST WATERSVILLE ROAD PHONE 301 829 2430

AGENT OR PROSPECTIVE BUYER \_\_\_\_\_

ADDRESS \_\_\_\_\_ PHONE \_\_\_\_\_

PROPERTY LOCATION:


SUBDIVISION WATERSVILLE ROAD LOT NO. 2

ROAD AND DESCRIPTION WEST WATERSVILLE ROAD

TAX MAP 2 PARCEL # 1036121

SIZE OF LOT 2.9 AC± TYPE BLDG. SINGLE FAMILY DETACHED  
(SINGLE FAMILY DWELLING OR COMMERCIAL)

THE SYSTEM INSTALLED UNDER THIS APPLICATION IS ACCEPTABLE ONLY UNTIL PUBLIC FACILITIES BECOME AVAILABLE. I FULLY UNDERSTAND THE FEE CONNECTED WITH THE FILING OF THIS PERC TEST APPLICATION IS NON-REFUNDABLE UNDER ANY CIRCUMSTANCES. I ALSO AGREE TO COMPLY WITH ALL M.O.S.H.A. REQUIREMENTS IN TESTING THIS LOT.

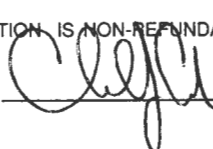

(SIGNATURE OF APPLICANT)

APPROVED BY \_\_\_\_\_ FOR \_\_\_\_\_ DATE \_\_\_\_\_

DISAPPROVED BY \_\_\_\_\_ FOR \_\_\_\_\_ DATE \_\_\_\_\_

HOLD PENDING FURTHER TESTS \_\_\_\_\_


REASONS FOR REJECTION OR HOLDING \_\_\_\_\_

PERCOLATION TEST PLAT/PRELIMINARY PLAT - TITLE OR I.D. # \_\_\_\_\_ DATE \_\_\_\_\_

SITE DEVELOPMENT PLAN/FINAL PLAT - TITLE OR I.D. # \_\_\_\_\_ DATE \_\_\_\_\_

## THIS IS NOT A PERMIT

F, E  
4/1 B1  
K SIL-SICU  
2 1/2 - 3' -  
4/1 B1 - 4/1 B1  
ch SIL  
30% ±  
1" pipe channels  
5 1/2' -  
v ch  
9' -  
rhd 200

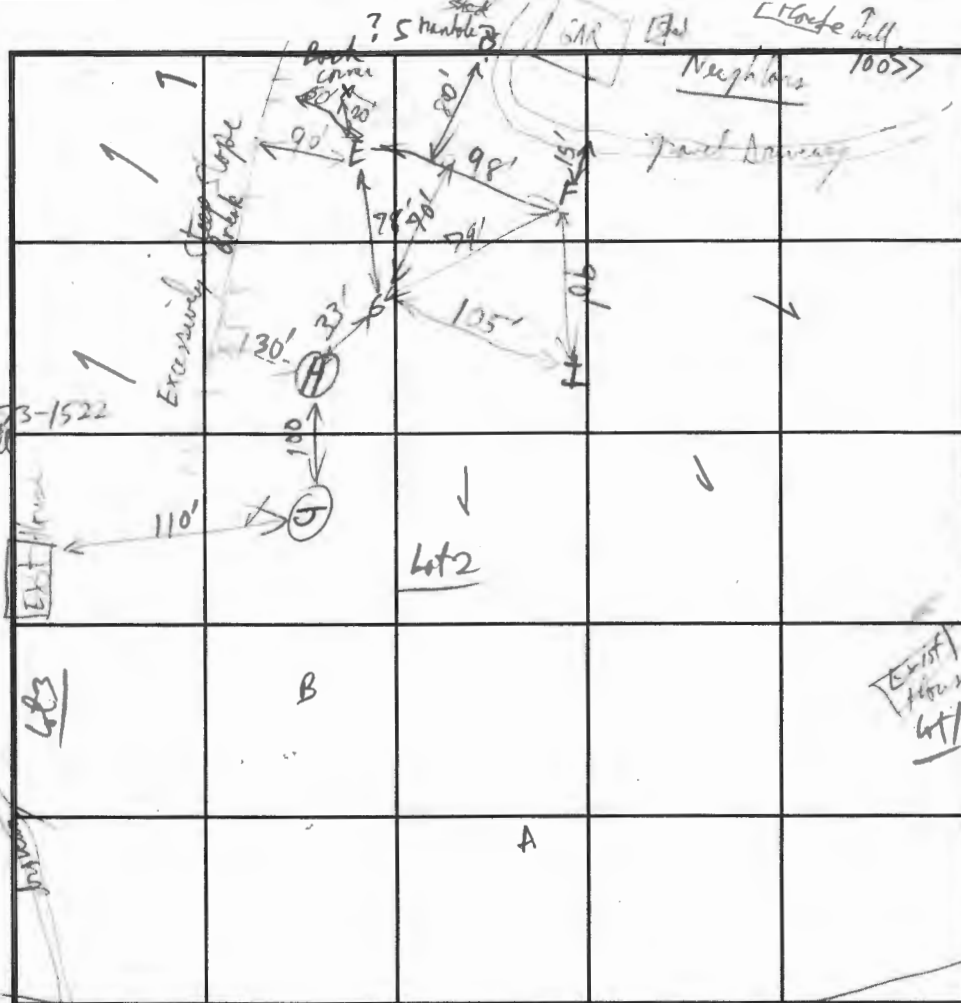

0' J  
 3' 2  
 6' 3  
 9½' 4

yp/bn  
 2 sil - sil  
 v. cl sil  
 y/bn - Tan  
 Midargel  
 30-45%  
 v. cl sil - l  
 50%-70%  
 large cl  
 Flage  
 Refractal

DATE	TEST NO.	DEPTH	PRE-WET		TEST - 1" DROP		TIME	
			START	STOP	START	STOP		
10/6/95	E	v9' 3'	11:51:00	1:45:00	1:45:00	2:25:00	40min	Prot at 4'
		40-60% channeling 7 1/2'	1:06:29 1:09:15	1:06:50 1:09:51		1:07:50 1:11:40	1min 1min 50 sec	
	F	v9' 3'	1:29:25	1:29:45	1:29:45	1:32:15	2 1/2 min	
		7'	1:24:36 repaired 1:32:00	1:37:30		1:29:45 1:43:30	6 min	OK
	(H)	Refused at 5' 10" v. channeling below 2 ft					Fail	
	G	v7 1/2' 4'	2:26:15	2:28:00	2:28:00	2:34:00	6 min	in 80th Drained away in 20 seconds
	I	v9 1/2' 2 1/2'	2:47:13	2:59:00			too slow	
		6 1/2'	2:46:30	2:47:00 2:50:50	2:48:15 2:53:00		2 min	
		6'	3:03:00	3:15:50				
		6 1/2-7'	3:16:00	3:17:40	3:17:40	3:19:59	10 sec Test Fail	
	J	v9 1/2' Recheck @ 9 1/2'						

REMARKS Confirmed steel plate over Neighbor's well & only 80 ft from Septic line.

TYPE OF SOIL Mt. Airy

TESTED BY R. P. Kelly ALSO PRESENT \_\_\_\_\_

TRENCH DESIGN DATA: AVERAGE PERCOLATION TIME \_\_\_\_\_ TRENCH WIDTH \_\_\_\_\_

INLET DEPTH \_\_\_\_\_ MAXIMUM BOTTOM DEPTH \_\_\_\_\_ SQ. FT./BEDROOM \_\_\_\_\_

# APPLICATION

PERCOLATION TESTING

A 50870B

HOWARD COUNTY HEALTH DEPARTMENT  
BUREAU OF ENVIRONMENTAL HEALTH  
3525-H ELLICOTT MILLS DRIVE/ELLICOTT CITY, MARYLAND 21043  
TELEPHONE: 313-2640

*PERVIEW OK  
TO SUBDIVIDE 3 LOTS  
FROM 2,  
2 EXISTING DWELLINGS  
(CW)*

P \_\_\_\_\_  
DISTRICT FOURTH

DATE 9/15/95 9-15-95  
13

TO: THE COUNTY HEALTH OFFICER  
ELLICOTT CITY, MARYLAND

I HEREBY APPLY FOR THE NECESSARY TEST PRIOR TO APPLICATION FOR PERMIT TO CONSTRUCT (OR RECONSTRUCT) A SEWAGE DISPOSAL SYSTEM.

PROPERTY OWNER ARTHUR AND JANICE DELAGRANGE

ADDRESS 437 WEST WATERSVILLE ROAD, MR. AIN PHONE 301 829 2430  
MD 21741-3643

AGENT OR PROSPECTIVE BUYER \_\_\_\_\_

ADDRESS \_\_\_\_\_ PHONE \_\_\_\_\_

PROPERTY LOCATION:

SUBDIVISION WATERSVILLE ROAD LOT NO. 1 EX. DWELLING

ROAD AND DESCRIPTION WEST WATERSVILLE ROAD

TAX MAP 2 PARCEL # 1038121

SIZE OF LOT 2.9 AC TYPE BLDG. SINGLE FAMILY  
(SINGLE FAMILY DWELLING OR COMMERCIAL)

THE SYSTEM INSTALLED UNDER THIS APPLICATION IS ACCEPTABLE ONLY UNTIL PUBLIC FACILITIES BECOME AVAILABLE. I FULLY UNDERSTAND THE  
FEE CONNECTED WITH THE FILING OF THIS PERC TEST APPLICATION IS NON-REFUNDABLE UNDER ANY CIRCUMSTANCES. I ALSO AGREE TO  
COMPLY WITH ALL M.O.S.H.A. REQUIREMENTS IN TESTING THIS LOT.

*C. C. C.*

(SIGNATURE OF APPLICANT)

APPROVED BY \_\_\_\_\_ FOR \_\_\_\_\_ DATE \_\_\_\_\_

DISAPPROVED BY \_\_\_\_\_ FOR \_\_\_\_\_ DATE \_\_\_\_\_

HOLD PENDING FURTHER TESTS \_\_\_\_\_

REASONS FOR REJECTION OR HOLDING \_\_\_\_\_

PERCOLATION TEST PLAT/PRELIMINARY PLAT - TITLE OR I.D. # \_\_\_\_\_ DATE \_\_\_\_\_

SITE DEVELOPMENT PLAN/FINAL PLAT - TITLE OR I.D. # \_\_\_\_\_ DATE \_\_\_\_\_

## THIS IS NOT A PERMIT

COUNTY #

SOIL PROFILE

0' Lot 2 B  
yellow-brown  
ch. silty cl

2' yellow-brown  
v. ch sil  
(large)  
Med fly  
35-60%  
ch. silty

Refused

Lot 2 A

Strong  
yellow  
silty silty

5' v. ch / stoney  
> 70%


Refused

C

Same or  
Hole E+P  
on Lot 2

SOIL PROFILE

0'

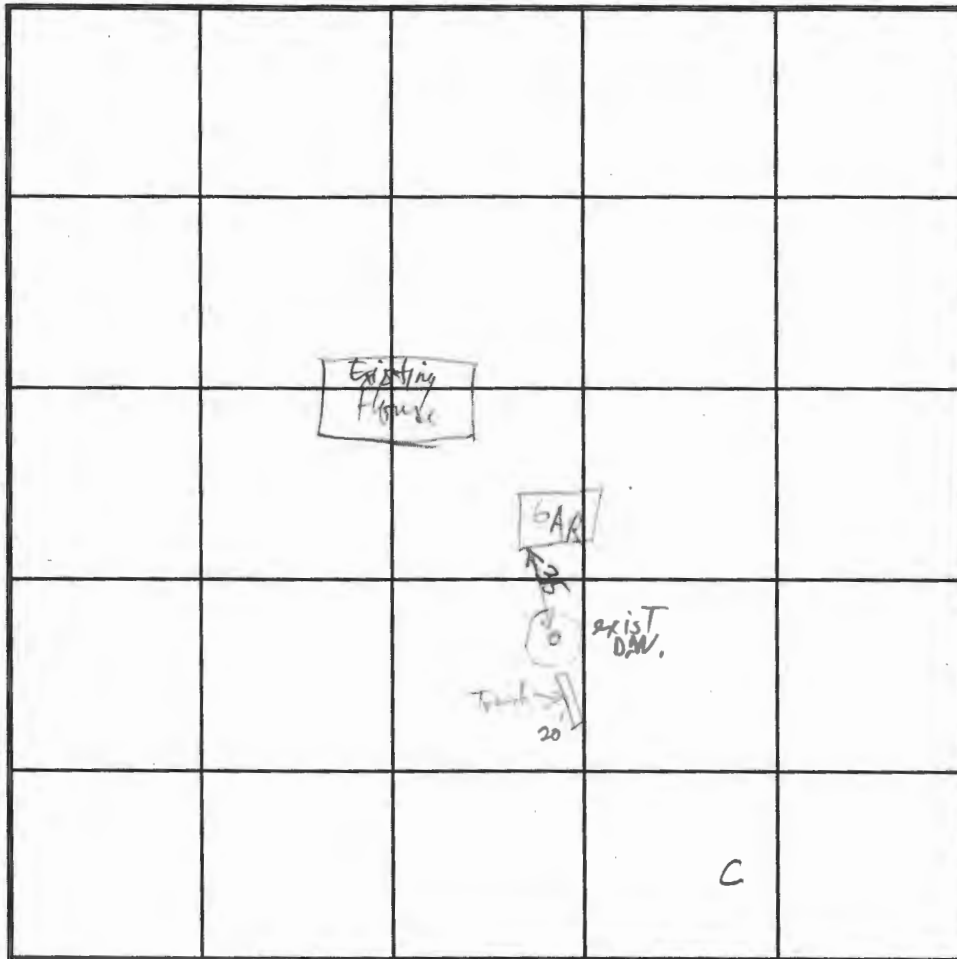

INDICATE NORTH - NAME ADJOINING ROADWAY AS BASE LINE.

DATE	TEST NO.	DEPTH	PRE-WET		TEST - 1" DROP		TIME
			START	STOP	START	STOP	
10/6/95	Lot 2 B	7'	Refused @ 7'	v. stoney	> 2-3'	Not Tested	?
	Lot 2 A	7'	v. ch. stoney	& stoney	below 5 ft.	Not Tested	?
	Lot 1 C	4'	4:47:00	5:01:00	5:15:00		14 min
		7'	4:50:30	4:51:10	4:52:10		
		(4 1/2 min) 7'	4:53:00	4:55:12	4:56:30		3 min

REMARKS

TYPE OF SOIL

TESTED BY

ALSO PRESENT

TRENCH DESIGN DATA: AVERAGE PERCOLATION TIME

TRENCH WIDTH


INLET DEPTH

MAXIMUM BOTTOM DEPTH

SQ. FT./BEDROOM



SOILS LEGEND		
SOIL	NAME	CLASS
GIB2	Glencig loam, 3 to 8 percent slopes, moderately eroded	B
GIC2	Glencig loam, 8 to 15 percent slopes, moderately eroded	B
MtD2	Mt. Airy channery loam, 15 to 25 percent slopes, moderately eroded	A
MtE	Mt. Airy channery loam, 25 to 45 percent slopes	A

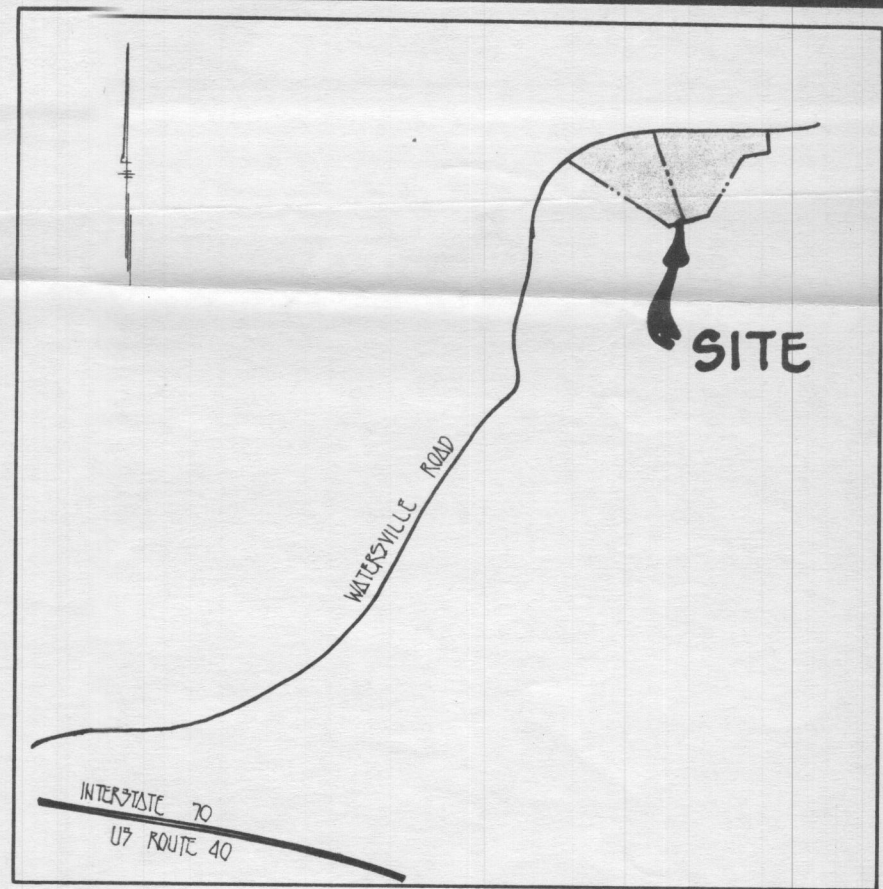

VICINITY MAP  
SCALE: 1" = 1200'

GENERAL NOTES:

- THIS AREA DESIGNATES A PRIVATE SEWERAGE EASEMENT OF 10,000 SQUARE FEET AS REQUIRED BY THE MARYLAND STATE DEPARTMENT OF THE ENVIRONMENT FOR INDIVIDUAL SEWERAGE DISPOSAL. IMPROVEMENTS OF ANY NATURE IN THIS AREA ARE RESTRICTED UNTIL PUBLIC SEWERAGE IS AVAILABLE. THESE EASEMENTS SHALL BECOME NULL AND VOID UPON CONNECTION TO A PUBLIC SEWERAGE SYSTEM. THE COUNTY HEALTH OFFICER SHALL HAVE THE AUTHORITY TO GRANT VARIANCES FOR ENCROACHMENT INTO THE PRIVATE SEWERAGE EASEMENT. RECORDATION OF A MODIFIED SEWERAGE EASEMENT SHALL NOT BE NECESSARY.
- THE LOT SHOWN HEREON COMPLY WITH THE MINIMUM OWNERSHIP WIDTH AND LOT AREA AS REQUIRED BY THE MARYLAND STATE DEPARTMENT OF THE ENVIRONMENT.
- ⊙ DENOTES WELL LOCATION.
- ⊠ DENOTES PROPOSED HOUSE.
- ▭ DENOTES EXISTING PRIVATE SEWERAGE EASEMENT.
- BOUNDARY OUTLINE BASED ON SURVEY BY FISHER, COLLINS, & CARTER, INC. PERFORMED ON OR ABOUT JUNE 1995.
- ▨ DENOTES SLOPES 15% TO 24%.
- ▩ DENOTES SLOPES GREATER THAN 25%.
- OWNER & DEVELOPER:

ARTHUR & JANICE DELAGRANGE  
437 WEST WATERSVILLE ROAD  
MOUNT AIRY, MARYLAND 21771-3643

MATTHEW & BERNICE RUPPALT  
467 WEST WATERSVILLE ROAD  
MOUNT AIRY, MARYLAND 21771-3643

PERC APPLICATION PLAN

WATERSVILLE ROAD

LOTS 1-3

TAX MAP 2 ZONED: RC  
FOURTH ELECTION DISTRICT  
SCALE: 1"=100'

PARCEL(S): 103 & 121  
HOWARD COUNTY, MARYLAND  
DATE: 7-12-95

APPROVED FOR PRIVATE WATER AND PRIVATE SEWERAGE SYSTEMS,  
HOWARD COUNTY HEALTH DEPARTMENT.


COUNTY HEALTH OFFICER \_\_\_\_\_

DATE \_\_\_\_\_

FISHER, COLLINS & CARTER, INC.  
CIVIL ENGINEERING CONSULTANTS & LAND SURVEYORS  
CENTENNIAL SQUARE OFFICE PARK - 10272 BALTIMORE NATIONAL PIKE  
ELLICOTT CITY, MARYLAND 21042  
(410) 461 - 2955



SOILS LEGEND		
SOIL	NAME	CLASS
GIB2	Glenelg loam, 3 to 8 percent slopes, moderately eroded	B
GIC2	Glenelg loam, 8 to 15 percent slopes, moderately eroded	B
MID2	Mt. Airy channery loam, 15 to 25 percent slopes, moderately eroded	A
MIE	Mt. Airy channery loam, 25 to 45 percent slopes	A

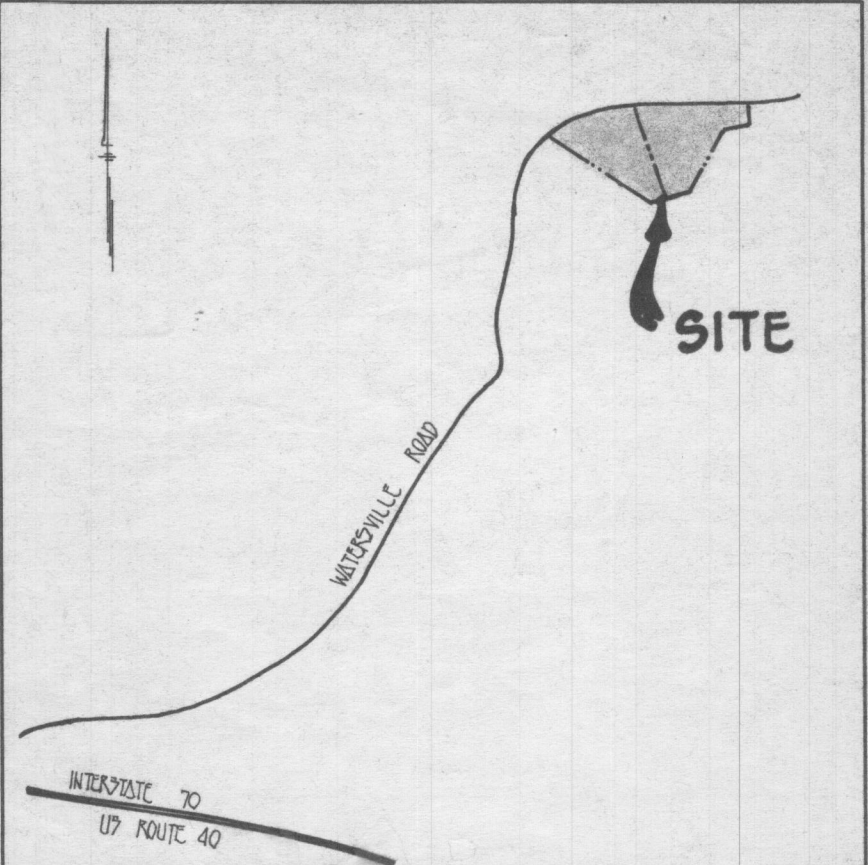

VICINITY MAP  
SCALE : 1" = 1200'

GENERAL NOTES:

- THIS AREA DESIGNATES A PRIVATE SEWERAGE EASEMENT OF 10,000 SQUARE FEET AS REQUIRED BY THE MARYLAND STATE DEPARTMENT OF THE ENVIRONMENT FOR INDIVIDUAL SEWERAGE DISPOSAL. IMPROVEMENTS OF ANY NATURE IN THIS AREA ARE RESTRICTED UNTIL PUBLIC SEWERAGE IS AVAILABLE. THESE EASEMENTS SHALL BECOME NULL AND VOID UPON CONNECTION TO A PUBLIC SEWERAGE SYSTEM. THE COUNTY HEALTH OFFICER SHALL HAVE THE AUTHORITY TO GRANT VARIANCES FOR ENCROACHMENT INTO THE PRIVATE SEWERAGE EASEMENT. RECORDATION OF A MODIFIED SEWERAGE EASEMENT SHALL NOT BE NECESSARY.
- THE LOT SHOWN HEREON COMPLY WITH THE MINIMUM OWNERSHIP WIDTH AND LOT AREA AS REQUIRED BY THE MARYLAND STATE DEPARTMENT OF THE ENVIRONMENT.
- ⊙ DENOTES WELL LOCATION.
- ⊠ DENOTES PROPOSED HOUSE.
- ▭ DENOTES EXISTING PRIVATE SEWERAGE EASEMENT.
- BOUNDARY OUTLINE BASED ON SURVEY BY FISHER, COLLINS, & CARTER, INC. PERFORMED ON OR ABOUT JUNE 1995.
- ▨ DENOTES SLOPES 15% TO 24%.
- ▩ DENOTES SLOPES GREATER THAN 25%.
- OWNER & DEVELOPER:

ARTHUR & JANICE DELAGRANGE  
437 WEST WATERSVILLE ROAD  
MOUNT AIRY, MARYLAND 21771-3643

MATTHEW & BERNICE RUPPALT  
467 WEST WATERSVILLE ROAD  
MOUNT AIRY, MARYLAND 21771-3643

PERC APPLICATION PLAN  
WATERSVILLE ROAD  
LOTS 1-3

TAX MAP 2      ZONED: RC  
FOURTH ELECTION DISTRICT  
SCALE: 1"=100'

PARCEL(S): 103 & 121  
HOWARD COUNTY, MARYLAND  
DATE: 7-12-95

FISHER, COLLINS & CARTER, INC.  
CIVIL ENGINEERING CONSULTANTS & LAND SURVEYORS  
CENTENNIAL SQUARE OFFICE PARK - 10272 BALTIMORE NATIONAL PIKE  
ELLICOTT CITY, MARYLAND 21042  
(410) 461 - 2855

APPROVED FOR PRIVATE WATER AND PRIVATE SEWERAGE SYSTEMS,  
HOWARD COUNTY HEALTH DEPARTMENT.

COUNTY HEALTH OFFICER

DATE