



# Building Permit Application

Howard County Maryland  
Department of Inspections, Licenses and Permits  
3430 Court House Drive  
Permits: 410-313-2455  
www.howardcountymd.gov

Date Received: \_\_\_\_\_

Permit No.: **B19000584**

Building Address: 1040 Thunderbird Dr  
City: Woodbine State: MD Zip Code: 21797  
Suite/Apt. #: \_\_\_\_\_ SDP/WP/BA #: GP-18-35  
Census Tract: \_\_\_\_\_ Subdivision: Fairlane Farms  
Section: \_\_\_\_\_ Area: \_\_\_\_\_ Lot: 36  
Tax Map: \_\_\_\_\_ Parcel: \_\_\_\_\_ Grid: \_\_\_\_\_  
Zoning: \_\_\_\_\_ Map Coordinates: \_\_\_\_\_ Lot Size: \_\_\_\_\_

Existing Use: Vacant lot  
Proposed Use: Single Family house  
Estimated Construction Cost: \$ 230,000  
Description of Work: New 2 story "Longwood" EW'A, with 2 car garage, 1 car side attached garage, and finished lower level (Poc rm, Bathroom + Bedroom)  
Occupant or Tenant: \_\_\_\_\_

Was tenant space previously occupied? ☐ Yes ☐ No

Contact Name: \_\_\_\_\_

Address: \_\_\_\_\_

City: \_\_\_\_\_ State: \_\_\_\_\_ Zip Code: \_\_\_\_\_

Phone: \_\_\_\_\_ Fax: \_\_\_\_\_

Email: \_\_\_\_\_

Commercial Building Characteristics	Residential Building Characteristics
Height:	<input checked="" type="checkbox"/> SF Dwelling <input type="checkbox"/> SF Townhouse
No. of stories:	Depth Width
Gross area, sq. ft./floor:	1 <sup>st</sup> floor: <u>47</u> x <u>64</u>
Area of construction (sq. ft.):	2 <sup>nd</sup> floor: <u>39</u> x <u>50</u>
Use group:	Basement: <u>47</u> x <u>50</u>
Construction type:	<input type="checkbox"/> Finished Basement
<input type="checkbox"/> Reinforced Concrete	<input type="checkbox"/> Unfinished Basement
<input type="checkbox"/> Structural Steel	<input type="checkbox"/> Crawl Space
<input type="checkbox"/> Masonry	<input type="checkbox"/> Slab on Grade
<input type="checkbox"/> Wood Frame	No. of Bedrooms: <u>5</u>
<input type="checkbox"/> State Certified Modular	Multi-family Dwelling
<input checked="" type="checkbox"/> Roadside Tree Project Permit	No. of efficiency units:
<input type="checkbox"/> Yes <input checked="" type="checkbox"/> No	No. of 1 BR units:
Roadside Tree Project Permit #	No. of 2 BR units:
	No. of 3 BR units:
	Other Structure:
	Dimensions:
	Footings:
	Roof:
	<input type="checkbox"/> State Certified Modular
	<input type="checkbox"/> Manufactured Home

Property Owner's Name: NVR Inc  
Address: 9720 Patuxent Woods Drive  
City: Columbia State: MD Zip Code: 21046  
Phone: 410-379-5956 Fax: \_\_\_\_\_  
Email: \_\_\_\_\_

Applicant's Name &amp; Mailing Address, (If other than stated herein)

Applicant's Name: Decatur Building Services  
Address: PO Box 552  
City: Woodbine State: MD Zip Code: 21797  
Phone: 443-309-7792 Fax: \_\_\_\_\_  
Email: Jim@DecaturbuildingServices.com

Contractor Company: NV HomesContact Person: Clint GagleAddress: 9720 Patuxent Woods DriveCity: Columbia State: MD Zip Code: 21046License No.: 56Phone: 410-379-5956 Fax: \_\_\_\_\_Email: CGagle@NVRInc.com

Engineer/Architect Company: \_\_\_\_\_

Responsible Design Prof.: \_\_\_\_\_

Address: \_\_\_\_\_

City: \_\_\_\_\_ State: \_\_\_\_\_ Zip Code: \_\_\_\_\_

Phone: \_\_\_\_\_ Fax: \_\_\_\_\_

Email: \_\_\_\_\_

Utilities	
<u>Water Supply</u>	
<input type="checkbox"/> Public	
<input checked="" type="checkbox"/> Private	
<u>Sewage Disposal</u>	
<input type="checkbox"/> Public	
<input checked="" type="checkbox"/> Private	
Electric: <input checked="" type="checkbox"/> Yes <input type="checkbox"/> No	
Gas: <input checked="" type="checkbox"/> Yes <input type="checkbox"/> No	
<u>Heating System</u>	
<input checked="" type="checkbox"/> Electric <input type="checkbox"/> Oil	
<input type="checkbox"/> Natural Gas <input checked="" type="checkbox"/> Propane Gas	
<input type="checkbox"/> Other:	
<u>Sprinkler System:</u>	
<input checked="" type="checkbox"/> Yes <input type="checkbox"/> No	
Grading Permit Number: <u>G19000051</u>	
Building Shell Permit Number:	

THE UNDERSIGNED HEREBY CERTIFIES AND AGREES AS FOLLOWS: (1) THAT HE/SHE IS AUTHORIZED TO MAKE THIS APPLICATION; (2) THAT THE INFORMATION IS CORRECT; (3) THAT HE/SHE WILL COMPLY WITH ALL REGULATIONS OF HOWARD COUNTY WHICH ARE APPLICABLE THERETO; (4) THAT HE/SHE WILL PERFORM NO WORK ON THE ABOVE REFERENCED PROPERTY NOT SPECIFICALLY DESCRIBED IN THIS APPLICATION; (5) THAT HE/SHE GRANTS COUNTY OFFICIALS THE RIGHT TO ENTER ONTO THIS PROPERTY FOR THE PURPOSE OF INSPECTING THE WORK PERMITTED AND POSTING NOTICES.

Applicant's Signature: Jim Kerwin  
Email Address: Jim@DecaturbuildingServices.com

Print Name: Jim KerwinDate: 3/6/2019

RECEIVED

MAR 06 2019

LICENSES & PERMITS  
DIVISION

Checks Payable to: DIRECTOR OF FINANCE OF HOWARD COUNTY

\*\*PLEASE WRITE NEATLY &amp; LEGIBLY\*\*

-FOR OFFICE USE ONLY-

AGENCY	DATE	SIGNATURE OF APPROVAL
State Highways		
Building Officials		
PSZA (Zoning)		
PSZA (Engineering)		
Health	<u>3/18/19</u>	<u>W. G. S. S. S.</u>

Is Sediment Control approval required for Issuance? ☒ Yes ☐ No  
☐ CONTINGENCY CONSTRUCTION START

DPZ SETBACK INFORMATION
Front:
Rear:
Side:
Side St.:
All minimum setbacks met? <input type="checkbox"/> Yes <input type="checkbox"/> No
Is Entrance Permit Required? <input type="checkbox"/> Yes <input type="checkbox"/> No
Historic District? <input type="checkbox"/> Yes <input type="checkbox"/> No
Lot Coverage for New Town Zone:
SDP/Red-line approval date:

Filing Fee	\$ <u>100</u>
Permit Fee	\$
Tech Fee	\$
Excise Tax	\$
PSFS	\$
Guaranty Fund	\$ <u>50</u>
Add'l per Fee	\$
Total Fees	\$
Sub-Total Paid	\$
Balance Due	\$
Check	# <u>241422</u>

Distribution of Copies: White: Building Officials

Green: PSZA, Zoning

Yellow: PSZA, Engineering


Pink: Health

Gold: SHA



NV HOMES  
 9720 PATUXENT WOODS DRIVE  
 COLUMBIA, MD 21046  
 410-379-5956

STORMWATER MANAGEMENT FOR LOT 36 IS  
BEING PROVIDED BY MICRO-BIORETENTION  
FACILITY #14 (M-6).

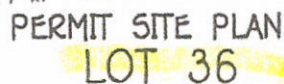

TAX MAP NO.: 0 GRID NO.: 2 PARCEL NO.: 0  
5TH ELECTION DISTRICT HOWARD COUNTY, MARYLAND  
SCALE: 1"=30' DATE: FEB. 15, 2019  
SHEET 1 OF 1

Scale  
PLAN 40

**FISHER, COLLINS & CARTER, INC.**  
CIVIL ENGINEERING CONSULTANTS & LAND SURVEYORS  
CENTENAL SQUARE OFFICE PARK - 10272 BALTIMORE NATIONAL PIKE  
ELLSWORTH CITY, MARYLAND 21042  
(410) 481 - 2995

Approved B19002144  
RAK 7/19/2019



B 19000580  
On line Permit  
Approved DB

Approved  
for Pool  
Only!

SCALE 1"=100'

Automatic  
Cover  
To meet  
Removal by others  
only by others

6011  
Scale

Lot 18

ACCESS

children  
parents and teachers  
S. Moore

SST No. 505124-1016			
Inventory of Assets - 10/10/01			
ST. CODE	ST. NAME	DESCRIPTION	AMOUNT
100	100	100	100
200	200	200	200
300	300	300	300
400	400	400	400
500	500	500	500
600	600	600	600
700	700	700	700
800	800	800	800
900	900	900	900
1000	1000	1000	1000

BUCKSKIN LAKE DRIVE  
50' R/W

SITE PLAN

LOT 19

BACKSKIN WOOLPS

PLAT # CC97.


6-3-87

SILVANA BERGER 1 LANE  
8726 TOWN & COUNTRY BLVD  
ELKOT CITY, MD 21043  
461-9563





Approved for  
Pool Only

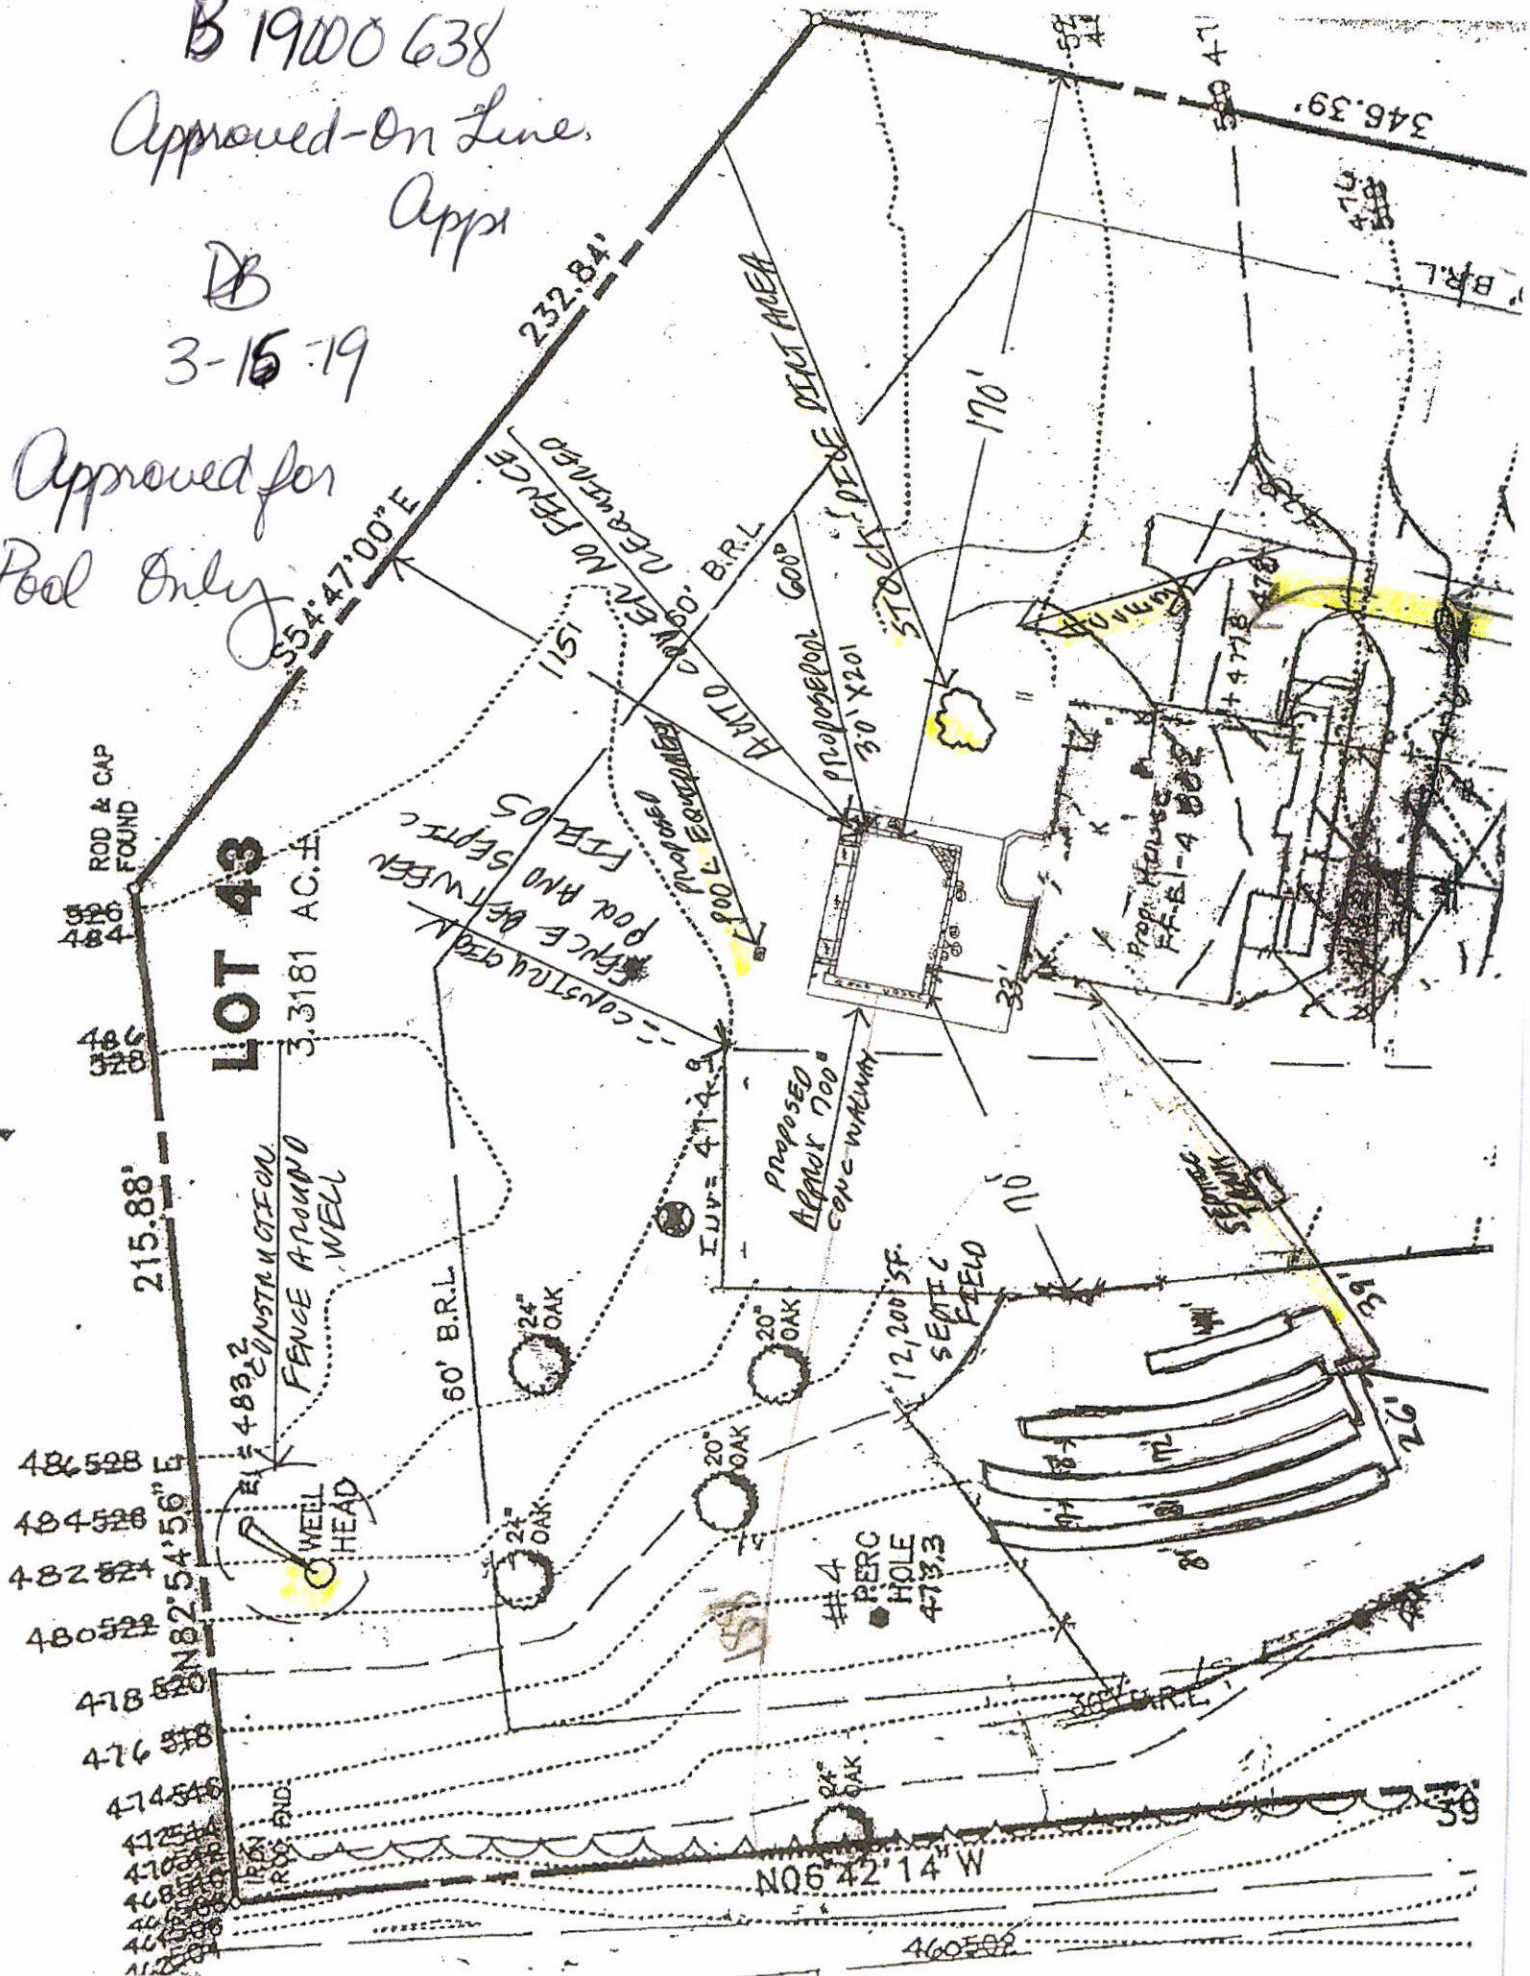



1040 Thunderbird Drive  
Lot 36

LONGWOOD

Health Dept

B19000584



NVR, Inc.  
Architectural Services  
Architects  
5285 Westview Drive, Suite 100  
Frederick, MD 21703

	FULL BASEMENT										STANDARD DETAILS
	STD. DIVS.										
SPEC SHEET	55-1										AD-1
ELEVATIONS	5										DR-1
FOUNDATIONS	14										DR-2
FOUNDATION HOLD DOWNS	19/20										DR-3
PLUMBING	21										ET-1
BASEMENT FLOOR PLAN	22										ET-1b
FIRST FLOOR PLAN	24										ET-1c
SECOND FLOOR PLAN	26										ET-1d
BUILDING SECTIONS	30/32										ET-1e
STAIR SECTIONS	34										ET-1f
KITCHEN LAYOUT	37										ET-1g
LAUNDRY CABINET LAYOUT	39										ET-2
CABINET LAYOUT (OPTIONAL)	40										ET-3
BATH ELEVATIONS	41										ET-3b
BASEMENT ELECTRICAL	42										F-1
FIRST FLOOR ELECTRICAL	44										FC-1
SECOND FLOOR ELECTRICAL	46										FC-2
FIRST FLOOR FRAMING	50										FC-4
SECOND FLOOR FRAMING	51										FD-1
ROOF FRAMING	53										FD-2
ROOF FRAMING (OPTIONAL)	54										FD-2b
TRUSS BRACING	58										FD-3
WALL BRACING LAYOUT	60										FP-1
BASEMENT HVAC LAYOUT	64/65										FP-1b
GRAVL SPACE HVAC LAYOUT	66/67										GB-1
FIRST FLOOR HVAC LAYOUT	68/69/70/71										IT-1
SECOND FLOOR HVAC LAYOUT	72/73										IT-1b
											IT-1c
											IT-2
											JT-1
											JT-3
											JT-3b
											KT-1
											RF-1
											RF-1b
											SEP-1
											SEP-2
											SEP-3
											SEP-4
											SP-1
											SP-2
											SP-3
											ST-1
											ST-2
											ST-3b
											WB-1
											WB-2
											WD-1
											WD-2
											WD-3
											WS-1

FIRST FLOOR SQUARE FOOTAGE

DESCRIPTION	TOTAL SQ. FT.
1ST FLOOR (BASE SF)	1654 SF

SECOND FLOOR SQUARE FOOTAGE

DESCRIPTION	TOTAL SQ. FT.
2ND FLOOR (BASE SF)	1861 SF

GARAGE SQUARE FOOTAGE

DESCRIPTION	TOTAL SQ. FT.
GARAGE	460 SF
ONE CAR SIDE ATTACHED GARAGE	324 SF
	784 SF

BASEMENT SQUARE FOOTAGE

DESCRIPTION	TOTAL SQ. FT.
FINISHED BASEMENT	NA SF
	0 SF

UNFINISHED SQUARE FOOTAGE

DESCRIPTION	TOTAL SQ. FT.
UNFINISHED BASEMENT STORAGE	323 SF
MECHANICAL	242 SF
	565 SF

TOTAL FINISHED SQUARE FOOTAGE


DESCRIPTION	TOTAL SQ. FT.
1ST FLOOR (BASE SF)	1654 SF
2ND FLOOR (BASE SF)	1861 SF
	3515 SF

SET - VERSION

14000 - 01

CS-1



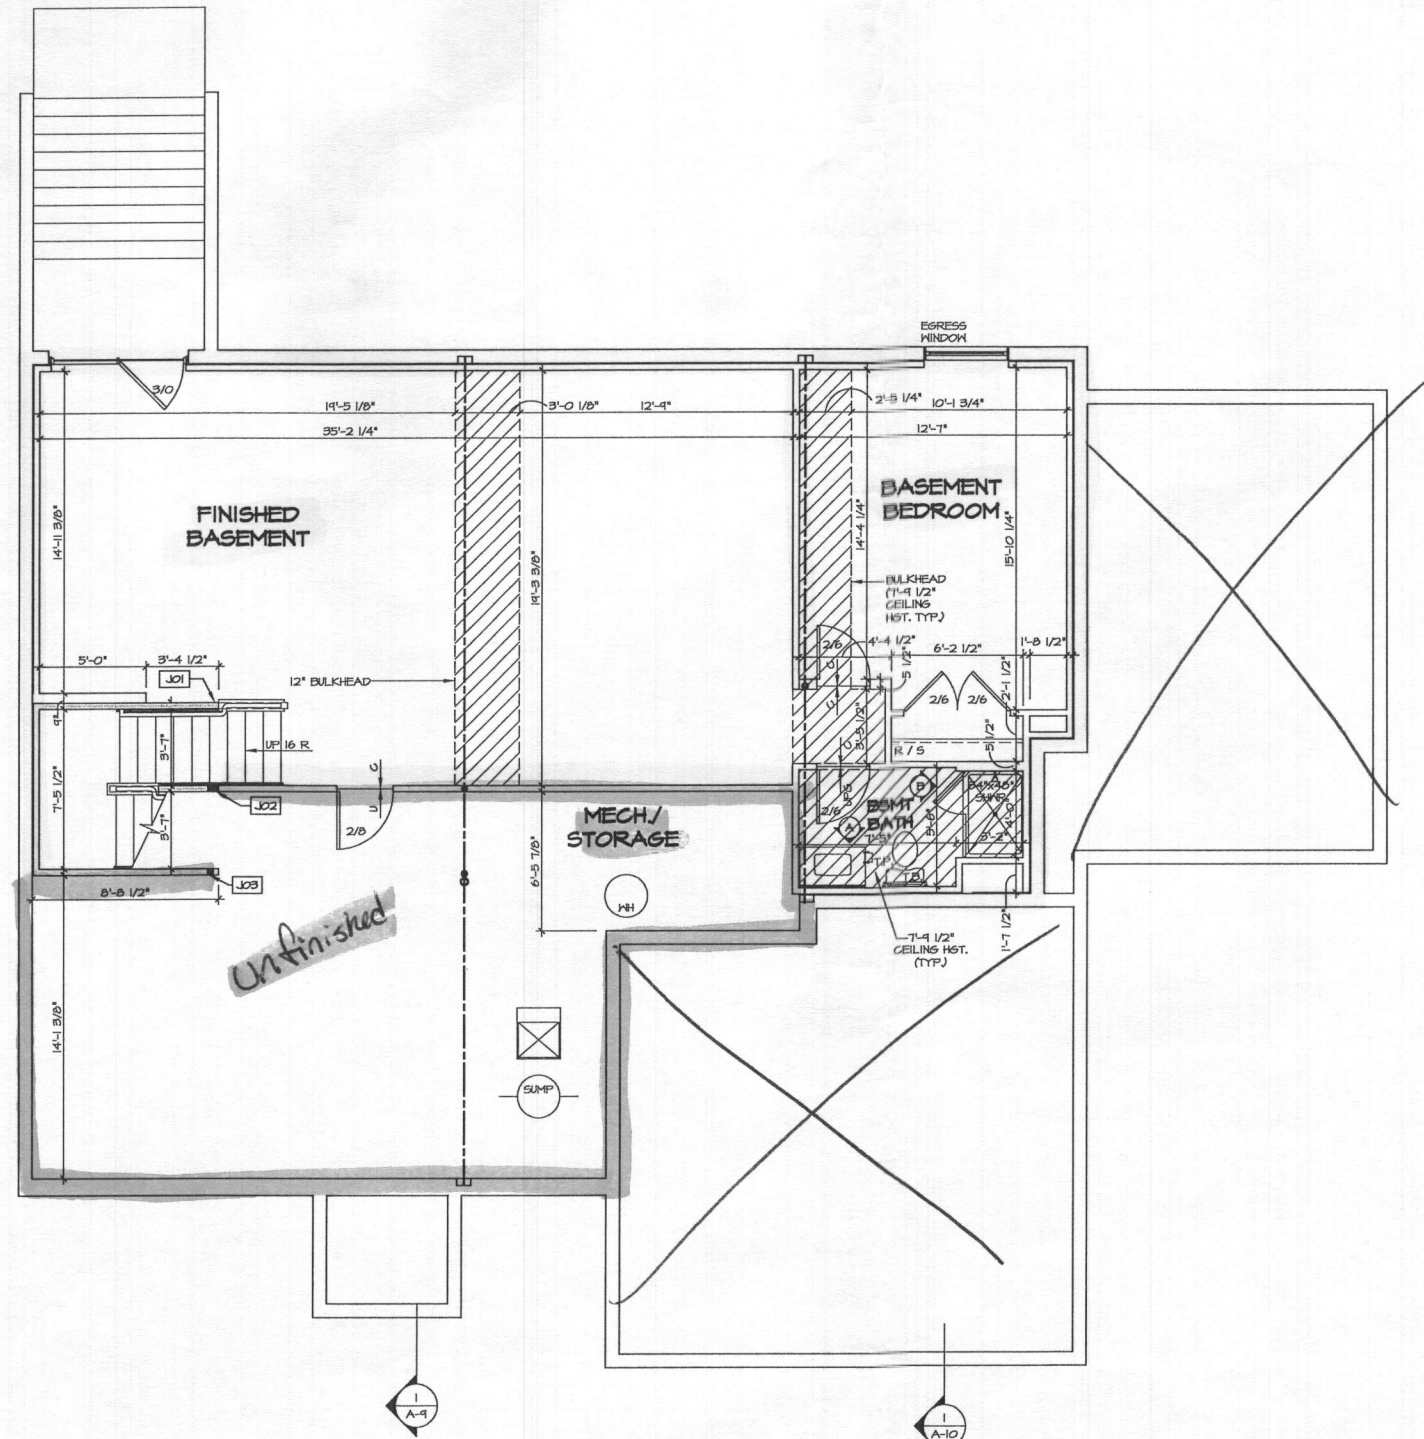

FLOOR PLAN NOTES

1. ALL HEADERS ARE (2) 2x6 w/ 2x4 WALLS OR (3) 2x6 w/ 2x6 WALLS, UNLESS OTHERWISE NOTED.
2. ALL HEADERS TO HAVE (1) 2x4 OR 2x6 JACK EACH END, UNLESS OTHERWISE NOTED.
3. ALL EXTERIOR WALLS TO BE 4" AND ALL INTERIOR WALLS TO BE 3 1/2", UNLESS OTHERWISE NOTED.
4. HATCHED AREAS INDICATE DROPPED CEILINGS. ALL DROPPED CEILINGS ARE 12" UNLESS OTHERWISE NOTED.
5. SEE "BRACED WALL PANEL DETAIL SHEET" FOR SPECIAL WALL FRAMING LOCATIONS AND HEADER SIZES, IF APPLICABLE.
6. SEE STANDARD DETAIL CATEGORY "I" SHEETS(S) FOR INTERIOR TRIM DETAILS.
7. SEE ARCHITECTURAL DETAIL SHEET "AD" FOR HOUSE SPECIFIC INTERIOR TRIM OPTION TABLE.
8. ALL WINDOWS HAVE T-O 1/2" HEADER HEIGHT UNLESS OTHERWISE NOTED.
9. ALL CASED OPENINGS AT T-11", UNLESS OTHERWISE NOTED.

GYPSUM NOTES

AT GARAGE:  
5/8" DRYWALL ON COMMON WALLS, CEILING, AND BEARING WALLS AS REQUIRED.

AT STAIRS:  
1/2" GYPSUM BOARD AT UNDERSIDE OF STAIRS AND WALLS IN CLOSET

WITH OPTION "SG1" - DRYWALL UNFINISHED BASEMENT CEILING AREA

NOTES:

- 1/2" GYPSUM WALL BOARD REQUIRED ON CEILING IN UNFINISHED AREAS WHEN NO SPRINKLER SYSTEM IS INSTALLED
- A MAXIMUM AREA OF 80 SQ FT MAY BE OMITTED AS NEEDED FOR INSTALLATION OF PLUMBING, ELECTRICAL, AND/OR HVAC (TYPICALLY AN 8'-0"x8'-0" CEILING SPACE ABOVE MECHANICAL AREA).
- PROVIDE FIRE BLOCKING AS REQUIRED AT PERIMETER OF ANY AREAS WHERE DRYWALL HAS BEEN OMITTED.

LEGEND


- BEARING WALL
  - NON BEARING WALL
  - INDICATES BEARINGS FROM POINT-LOAD ABOVE
  - JACKS
  - BEAM/HEADER
  - PAD FOOTING
  - STEEL COLUMN
  - PORTAL FRAME
  - JOIST/TRUSS
  - LVL
  - ENGINEERING PAGE NUMBER
- SEE FG DETAILS FOR FRAMING CONNECTORS

BASEMENT JACK SCHEDULE

IDENTIFIER	DESCRIPTION	OPTIONS	ENG. NUM.	REMARKS
J01	JACK - (2) 2X4 SFF STUD GRADE	MAG	B0020	
J02	JACK - (4) 2X4 SFF STUD GRADE	MAG	B0016	
J03	JACK - (2) 2X4 SFF STUD GRADE	MAG	B0016	

1 A-6 BASEMENT FLOOR PLAN  
SCALE: 1/4" = 1'-0"

NVR, Inc. owner, architect, and other property rights in these drawings, designs, specifications, and any other documents prepared by or for NVR, Inc. are hereby assigned to NVR, Inc. without further compensation or release of NVR, Inc.

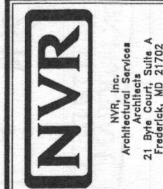

SHEET NO.	MODEL	SET NO.	VERSION	DRAWING TITLE	DATE	OPTION
A-6	LONGWOOD	14000-01	01	BASEMENT FLOOR PLAN		
22						



ALL WINDOWS HAVE  
8'-0" 1/2" HEADER HEIGHT  
UNLESS OTHERWISE NOTED.

### FLOOR PLAN NOTES

1. ALL HEADERS ARE (2) 2x6 W/ 2x4 WALLS OR (3) 2x6 W/ 2x6 WALLS, UNLESS OTHERWISE NOTED.
2. ALL HEADERS TO HAVE (1) 2x4 OR 2x6 JACK EACH END, UNLESS OTHERWISE NOTED.
3. ALL EXTERIOR WALLS TO BE 4" AND ALL INTERIOR WALLS TO BE 3 1/2", UNLESS OTHERWISE NOTED.
4. HATCHED AREAS INDICATE DROPPED CEILINGS. ALL DROPPED CEILINGS ARE 12" UNLESS OTHERWISE NOTED.
5. SEE "BRACED WALL PANEL DETAIL SHEET" FOR SPECIAL WALL FRAMING LOCATIONS AND HEADER SIZES, IF APPLICABLE.
6. SEE STANDARD DETAIL CATEGORY "IT" SHEET(S) FOR INTERIOR TRIM DETAILS.
7. SEE ARCHITECTURAL DETAIL SHEET "AD" FOR HOUSE SPECIFIC INTERIOR TRIM OPTION TABLE.
8. ALL WINDOWS HAVE T-O 1/2" HEADER HEIGHT UNLESS OTHERWISE NOTED.
9. ALL CASED OPENINGS AT T-11", UNLESS OTHERWISE NOTED.

### GYPSUM NOTES

AT GARAGE:

5/8" DRYWALL ON COMMON WALLS, CEILING, AND BEARING WALLS AS REQUIRED.

AT STAIRS:

1/2" GYPSUM BOARD AT UNDERSIDE OF STAIRS AND WALLS IN CLOSET.

WITH OPTION "SGI" - DRYWALL UNFINISHED BASEMENT CEILING AREA.

### NOTES:

- 1/2" GYPSUM WALL BOARD REQUIRED ON CEILING IN UNFINISHED AREAS WHEN NO SPRINKLER SYSTEM IS INSTALLED.
- A MAXIMUM AREA OF 80 SQ FT MAY BE OMITTED AS NEEDED FOR INSTALLATION OF PLUMBING, ELECTRICAL, AND/OR HVAC (TYPICALLY AN 8'-0"X8'-0" CEILING SPACE ABOVE MECHANICAL AREA).
- PROVIDE FIRE BLOCKING AS REQUIRED AT PERIMETER OF ANY AREAS WHERE DRYWALL HAS BEEN OMITTED.

### LVL PLY TO PLY FASTENING SCHEDULE: (WHERE APPLICABLE BASED ON LVL USAGE)

- 1A - (2) PLY UP TO AND INCLUDING 11 7/8" TALL: FASTEN PLYS W/ (2) ROWS 16D NAILS AT 12" O.C.
- 2A - (2) PLY 14" TO AND 18" TALL (INCLUSIVE): FASTEN PLYS W/ (3) ROWS 16D NAILS AT 12" O.C.
- 3A - (2) PLY 20" TALL AND OVER: FASTEN PLYS W/ (4) ROWS 16D NAILS AT 12" O.C.
- 4A - (3) PLY UP TO AND INCLUDING 11 7/8" TALL: FASTEN PLYS W/ (2) ROWS 16D NAILS AT 12" O.C. FROM EACH SIDE.
- 5A - (3) PLY 14" TO AND 18" TALL (INCLUSIVE): FASTEN PLYS W/ (3) ROWS 16D NAILS AT 12" O.C. FROM EACH SIDE.
- 6A - (3) PLY 20" TALL AND OVER: FASTEN PLYS W/ (4) ROWS 16D NAILS AT 12" O.C. FROM EACH SIDE.

### FIRST FLOOR BEAM/HEADER SCHEDULE

IDENTIFIER	DESCRIPTION	LENGTH	OPTIONS	ENG. NUM.	REMARKS
B103	INT. HEADER - 2X6 - 2 PLY	5'-4"	GAA	1031	
B108	BEAM STEEL - W10X44	22'-5"	GCC	1071, 1075, 1079	
PF104-2	LVL - 11-04	13'-4"	GAA	1085	PORTAL FRAME - 1A
PF115-3	LVL - 22	22'-4 1/2"	GCC/GAA	1081, 1084, 1091	PORTAL FRAME - 6A

### STEEL COLUMN SCHEDULE


IDENTIFIER	STYLE	HEIGHT	OPTIONS	ENG. NUM.	REMARKS
C103	STANCHION - 3 IN SCHED 40	8'-1 5/8"	GCC	1071, 1075, 1079	

### FIRST FLOOR JACK SCHEDULE

IDENTIFIER	DESCRIPTION	OPTIONS	ENG. NUM.	REMARKS
J101	JACK - (1) 2X4 SFF STUD GRADE		1021	
J102	JACK - (1) 2X4 SFF STUD GRADE		1021	
J103	JACK - 2X4 SFF STUD GRADE		1052	
J104	JACK - (2) 2X4 SFF STUD GRADE		1052	
J109	JACK - (3) 2X4 SFF STUD GRADE	ELA	1039, 1041	
J110	JACK - (3) 2X4 SFF STUD GRADE	ELA	1039, 1041	
J114	JACK - (2) 2X4 SFF STUD GRADE	GAA	1085	
J120	JACK - (2) 2X4 SFF STUD GRADE	GAA	1085	
J121	JACK - (2) 2X4 SFF STUD GRADE	GAA	1031	
J124	JACK - (2) 2X4 SFF STUD GRADE	GAA	1031	
J125	JACK - (2) 2X4 SFF STUD GRADE	GAA	1011	
J126	JACK - (2) 2X4 SFF STUD GRADE		1013	
J131	JACK - (2) 2X6 SFF STUD GRADE	GCC	1081, 1084, 1091	
J136	JACK - (3) 2X6 SFF STUD GRADE	GCC	1081, 1084, 1091	
J134	JACK - (2) 2X4 SFF STUD GRADE		1050	
J140	JACK - (2) 2X4 SFF STUD GRADE		1050	

### LEGEND

- BEARING WALL
  - NON BEARING WALL
  - INDICATES BEARING FROM POINT-LOAD ABOVE
  - JACKS
  - BEAM/HEADER
  - PAD FOOTING
  - STEEL COLUMN
  - PORTAL FRAME
  - JOIST/TRUSS
  - LVL
  - ENGINEERING PAGE NUMBER
- SEE FC DETAILS FOR FRAMING CONNECTORS

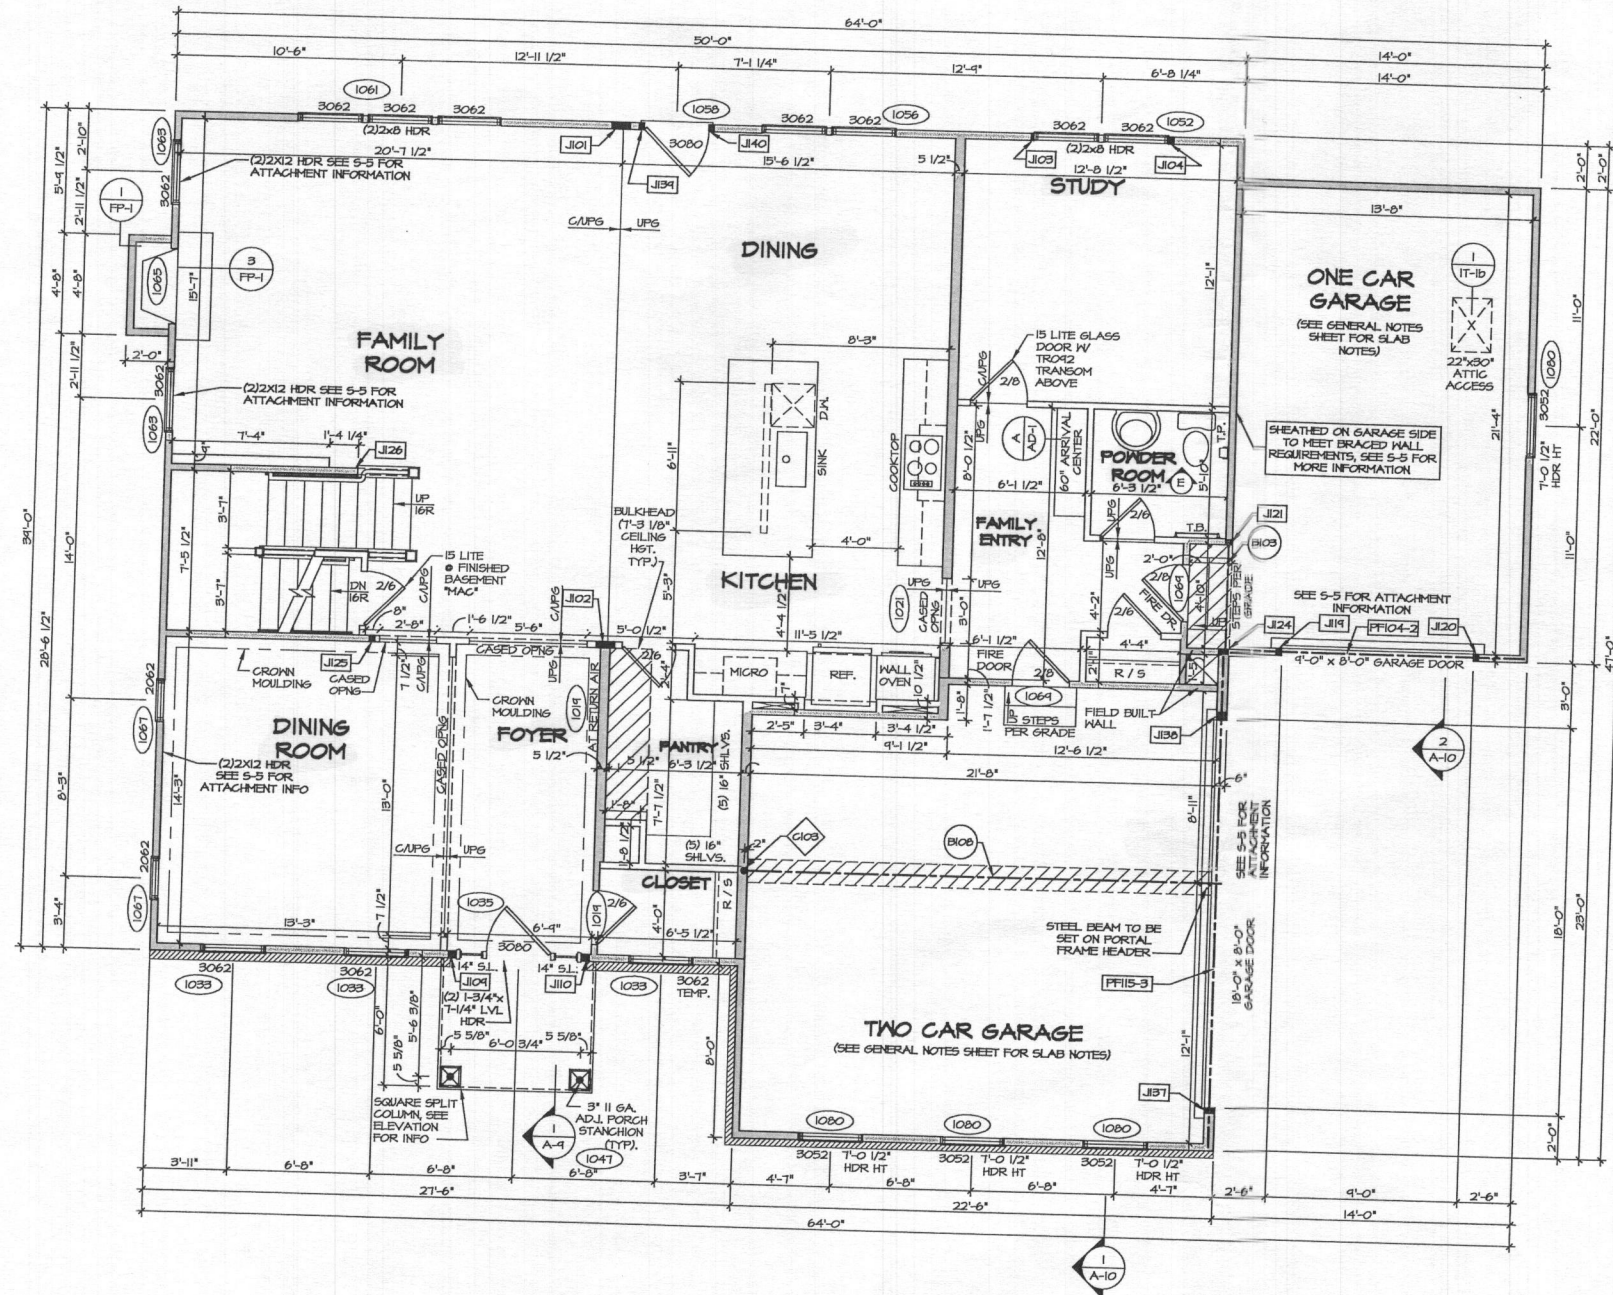

**FIRST FLOOR PLAN**  
SCALE: 1/4" = 1'-0"

NVR, Inc. and its affiliates  
reserve the copyright in these  
drawings and all other rights in these  
drawings. No part of these drawings  
may be reproduced, stored in a retrieval  
system, or transmitted in any form or  
by any means, without prior written  
consent of NVR, Inc.


**NVR**  
Architectural Services  
21 Bay Architects  
Frederick, MD 21702

MODEL  
**LONGWOOD**  
DRAWING TITLE  
**FIRST FLOOR PLAN**  
OPTION DESCRIPTION

SHEET NO.  
**A-7**  
24

C:\NVR\Software\LONGWOOD-14000\_01\NVR-FE-00363-1124899\Sheet\1st Floor\1st Floor.dwg 07/22/19 - 4:27 PM



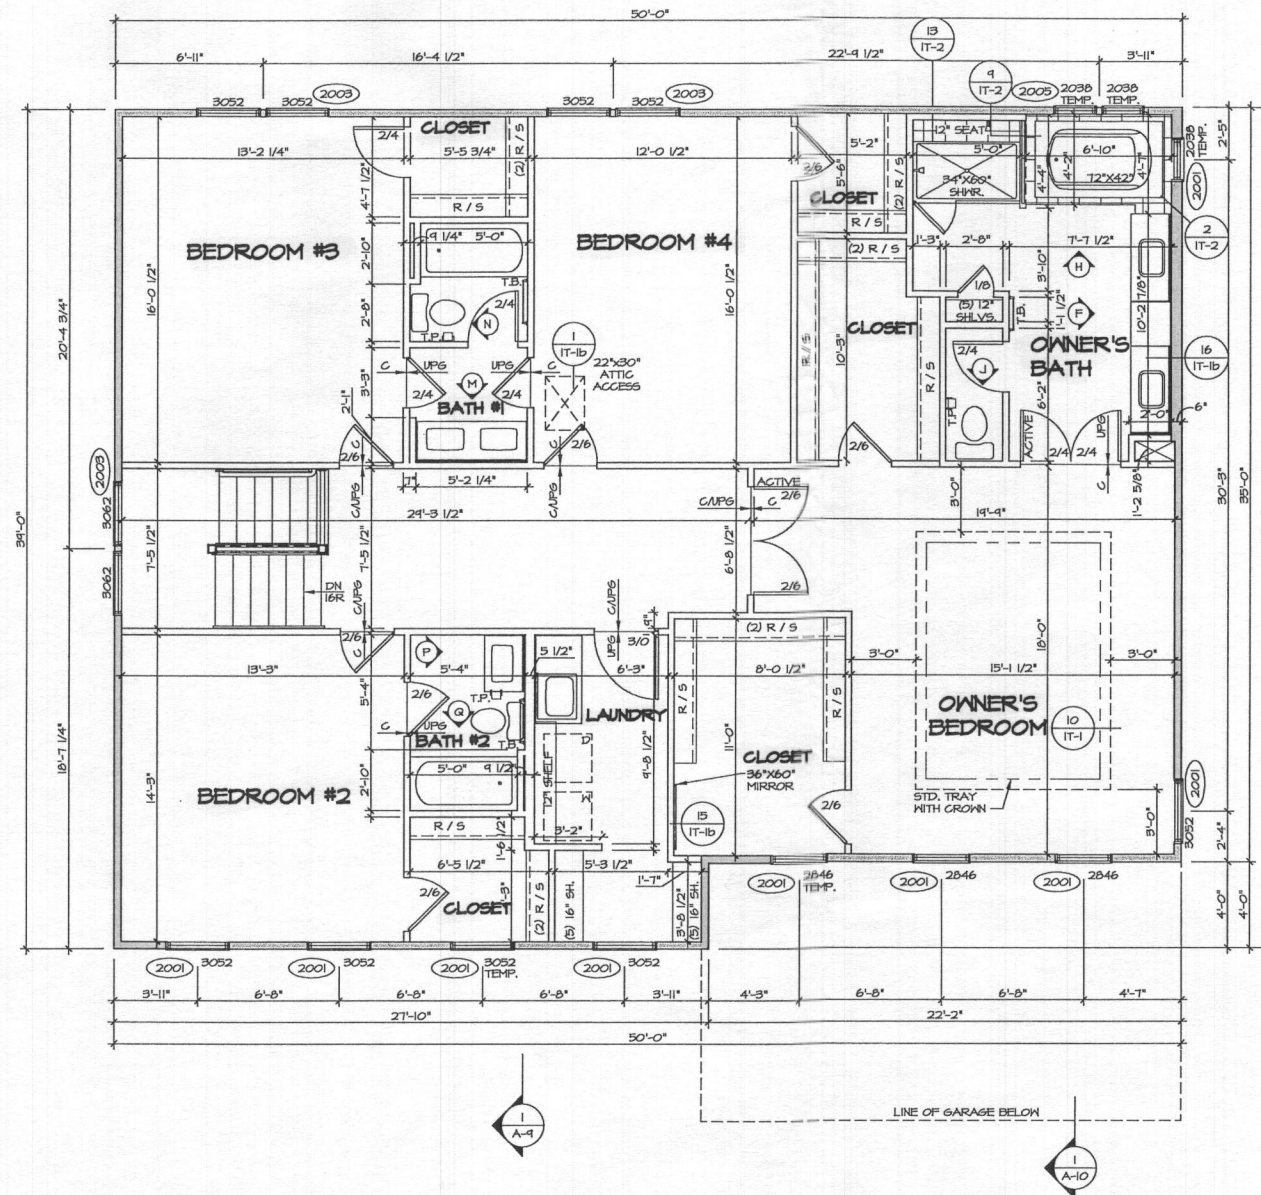

SECOND FLOOR PLAN  
SCALE: 1/4" = 1'-0"

FLOOR PLAN NOTES

1. ALL HEADERS ARE (2) 2x6 W 2x4 WALLS OR (3) 2x6 W 2x6 WALLS, UNLESS OTHERWISE NOTED.
2. ALL HEADERS TO HAVE (1) 2x4 OR 2x6 JACK EACH END, UNLESS OTHERWISE NOTED.
3. ALL EXTERIOR WALLS TO BE 4" AND ALL INTERIOR WALLS TO BE 3 1/2", UNLESS OTHERWISE NOTED.
4. HATCHED AREAS INDICATE DROPPED CEILINGS. ALL DROPPED CEILINGS ARE 12" UNLESS OTHERWISE NOTED.
5. SEE "BRACED WALL PANEL DETAIL SHEET" FOR SPECIAL WALL FRAMING LOCATIONS AND HEADER SIZES, IF APPLICABLE.
6. SEE STANDARD DETAIL CATEGORY "IT" SHEET(S) FOR INTERIOR TRIM DETAILS.
7. SEE ARCHITECTURAL DETAIL SHEET "AD" FOR HOUSE SPECIFIC INTERIOR TRIM OPTION TABLE.
8. ALL WINDOWS HAVE T-O 1/2" HEADER HEIGHT UNLESS OTHERWISE NOTED.
9. ALL CASED OPENINGS AT T-11", UNLESS OTHERWISE NOTED.

GYPSUM NOTES

AT GARAGE:

5/8" DRYWALL ON COMMON WALLS, CEILING, AND BEARING WALLS AS REQUIRED.

AT STAIRS:

1/2" GYPSUM BOARD AT UNDERSIDE OF STAIRS AND WALLS IN CLOSET

LEGEND

- BEARING WALL
  - NON BEARING WALL
  - INDICATES BEARING FROM POINT-LOAD ABOVE
  - JACKS
  - BEAM/HEADER
  - PAD FOOTING
  - STEEL COLUMN
  - PORTAL FRAME
  - JOIST/TRUSS
  - LVL
  - ENGINEERING PAGE NUMBER
- SEE FG DETAILS FOR FRAMING CONNECTORS

SECOND FLOOR JACK SCHEDULE

IDENTIFIER	DESCRIPTION	OPTIONS	ENG. NUM.	REMARKS
------------	-------------	---------	-----------	---------

SHEET NO.	MODEL	SET NO.	VERSION	DRAWN BY	DATE	OPTION
A-8	LONGWOOD	14000	01	CAP		
	DRAWING TITLE					
	SECOND FLOOR PLAN					
	OPTION DESCRIPTION					



NVR, Inc. is a registered architect and other property rights in these drawings, designs, or specifications, reproduced, stored, or copied in any form or by any means without the written consent of NVR, Inc.

NVR, Inc. is a registered architect and other property rights in these drawings, designs, or specifications, reproduced, stored, or copied in any form or by any means without the written consent of NVR, Inc.

REV. NO.	DATE	REMARKS
----------	------	---------