

APPLICATION

FOR PERCOLATION TESTING AND SITE EVALUATION

TEST DATE(S) _____ TEST TIME _____ A/P _____

AGENCY REVIEW: _____ DATE _____

DO NOT WRITE ABOVE THIS LINE

I HEREBY APPLY FOR THE NECESSARY TESTING/EVALUATION PRIOR TO ISSUANCE OF SEWAGE DISPOSAL SYSTEM PERMIT(S) TO:

CHECK AS NEEDED:

- ☒ CONSTRUCT NEW SEPTIC SYSTEM(S)
☐ REPAIR/ADD TO AN EXISTING SEPTIC SYSTEM
☐ REPLACE AN EXISTING SEPTIC SYSTEM

CHECK AS NEEDED:

- ☒ NEW STRUCTURE(S)
☐ ADDITION TO AN EXISTING STRUCTURE
☐ REPLACE AN EXISTING STRUCTURE

CHECK ONE:

- ☒ CREATE NEW LOT(S)
☐ BUILD ON AN EXISTING LOT IN A SUBDIVISION
☐ BUILD ON AN EXISTING PARCEL OF RECORD

IS THE PROPERTY WITHIN 2500' OF ANY RESERVOIR?

- ☐ YES
☒ NO

THE TYPE OF STRUCTURE IS:

- ☒ RESIDENTIAL WITH 4 to 5 PROPOSED BEDROOMS IN THE COMPLETED STRUCTURE (NOTE UNKNOWN IF APPROPRIATE)
☐ COMMERCIAL (PROVIDE DETAIL OF NUMBERS AND TYPES OF EMPLOYEES/ CUSTOMERS ON ACCOMPANYING PLAN)
☐ INSTITUTIONAL/GOVERNMENT (PROVIDE DETAIL OF NUMBERS AND TYPES OF EMPLOYEES/USERS ON ACCOMPANYING PLAN)

PROPERTY OWNER(S) PERRY & BARBARA WESTLAND

DAYTIME PHONE 6443-367-0422 CELL _____ FAX _____

MAILING ADDRESS 12525 LIME KILN ROAD SW FULTON, MD. 20759
STREET CITY/TOWN STATE ZIP

APPLICANT DONALD L. REOWER

DAYTIME PHONE 443-367-0422 CELL _____ FAX _____

MAILING ADDRESS 5300 BOSEY HALL DR. ELLICOTT CITY, MD 21042
STREET CITY/TOWN STATE ZIP

APPLICANT'S ROLE: DEVELOPER BUILDER BUYER RELATIVE/FRIEND REALTOR CONSULTANT

PROPERTY LOCATION
SUBDIVISION/PROPERTY NAME WESTLAND PROPERTY LOT NO. 7 ^{7 percent lot 8}

PROPERTY ADDRESS 12525 LIME KILN ROAD SW FULTON, MD 20759
STREET TOWN/POST OFFICE

TAX MAP PAGE(S) 45 GRID 5 PARCEL(S) 28 & 30 PROPOSED LOT SIZE 3.34 ac

AS APPLICANT, I UNDERSTAND THE FOLLOWING: THE SYSTEM INSTALLED SUBSEQUENT TO THIS APPLICATION IS ACCEPTABLE ONLY UNTIL PUBLIC SEWERAGE IS AVAILABLE. THIS APPLICATION IS COMPLETE WHEN ALL APPLICABLE FEES AND A SUITABLE SITE PLAN HAVE BEEN RECEIVED. I ACCEPT THE RESPONSIBILITY FOR COMPLIANCE WITH ALL M.D.S.H.A. AND "MISS UTILITY" REQUIREMENTS. APPROVAL IS BASED UPON SATISFACTORY REVIEW OF A PERC CERTIFICATION PLAN.


TEST RESULTS WILL BE MAILED TO APPLICANT. _____
SIGNATURE OF APPLICANT

HOWARD COUNTY HEALTH DEPARTMENT, BUREAU OF ENVIRONMENTAL HEALTH, WELL AND SEPTIC PROGRAM
3525-H ELLICOTT MILLS DRIVE, ELLICOTT CITY, MARYLAND 21043-4544 (410) 313-1771 FAX (410) 313-2648
TDD (410) 313-2323 TOLL FREE 1-877-4MD-DHMH

AVP
530
WKR rdbn
CL
ribbons
2" - 3'
per hole @ 4 1/3"
Ry ledge
strybrn
micac
sap date
Loam
few rx
pockets
overall
rx ~ 15%
Bottom 10'

531
rdbn
micac
SCL 2'
micac
SL rdbn 4'
WKRd
LS
v. micac
overall
SAP
~ 10-15%
Bottom 11'

532
Rdbn
hwy L
↑ SAND med gr. 3'
CLAY
v. micac
greyish
CLAY
Newell
wk
rdbn
v. micac
Loam
wk saprolite
w/ Mn
faced
Rx % ~ 20-25%
Bottom 10'

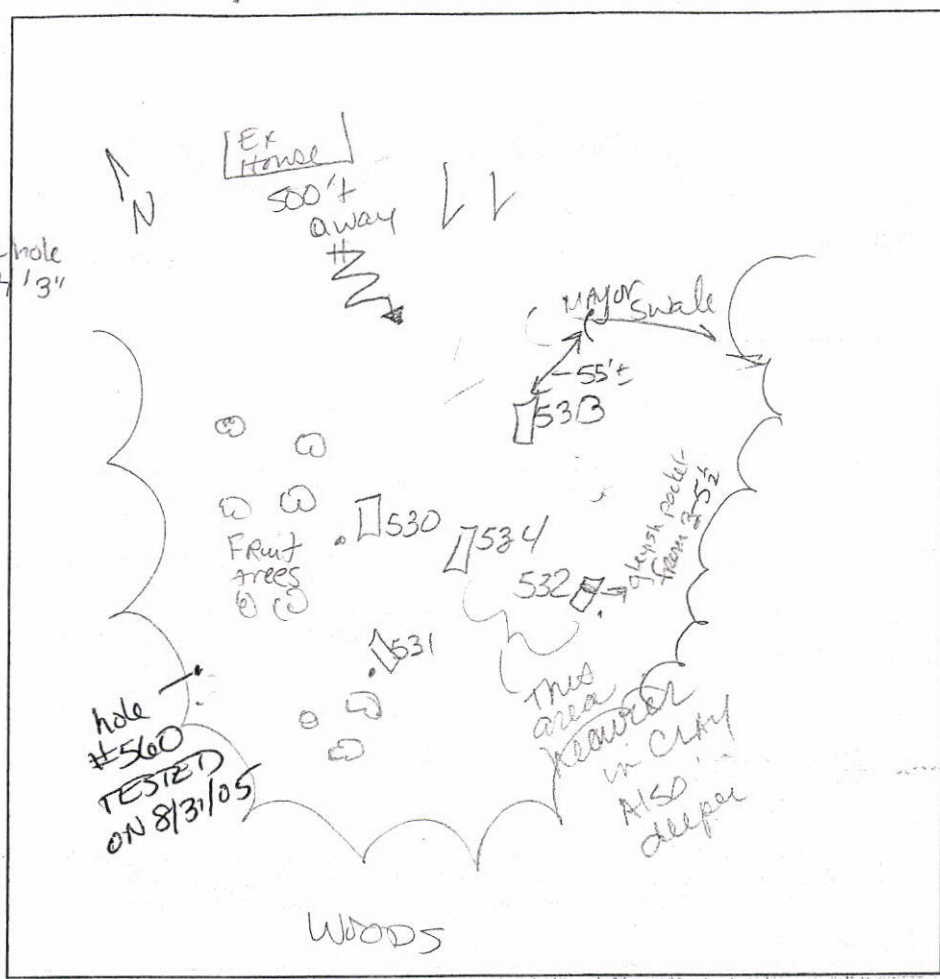

DATE	TEST #	DEPTH	START	BREAK 1" DROP	STOP 2" DROP	TIME OF 2nd INCH	P/F/H
8-10-05	530	4' / 10'	11:15	11:19	11:24	4+ 5	P
	531	4 1/2' / 11'	11:18	11:21	11:25	4+	P
	532	5 1/2' / 9 1/2'	11:24	11:25	11:28	3 Major pass	
		Grey CLAY pocket an anomaly for					
	534	5' 6"	11:33	11:34	11:36	2+	P
	533	tested in SAP on NE WALL @ 4 1/2'	11:36	11:37	11:39	2+	P
	#560 Refusal @ 6' 10"						

534
argbms
WKRd
brn
SL
dry
SCL 2'
WKRd
v. micac
Loam 5'

533
WKRd
brn
micac
SL
WKRd
brn
strybrn
saprolite
ON
NE
wall
tested
OK v. micac
WKRd
F-med gr
Bottom 10'

REMARKS 6" test pit holes

SANITARIAN Kacie BACKHOE Mr. Johnson OTHERS Mr. Webster


TEST HOLES USED IN SDA _____ AVG. PERC TIME _____ SQ. FT/BR _____

TRENCH WIDTH _____ INLET DEPTH _____ MAX. BOT DEPTH _____ EFFECTIVE SW _____

AVP
530
WKRdbm
CL
ribbons
2"
3'
per hole
Rx ledge
@ 4 1/3"
Strybrn
mucac
Loam
few rx
pockets
overall
rx ~ 15%
Bottom 10'

531
rdbrn
mucac
SCL
2'
mucac
SL rdbrn
4'
WKRd
LS
v. mucac
overall
SIP
~ 10-15%
Bottom 11'

532
Rdbm
hvy L
↑ SAND med
CLAY gr. 3'
v. mucac
greyish
CLAY
Newell
10'
wk
rdbrn
v. mucac
Loam
wk saproete
w/Min on
faced
Rx% ~ 20-25%
Bottom 10'

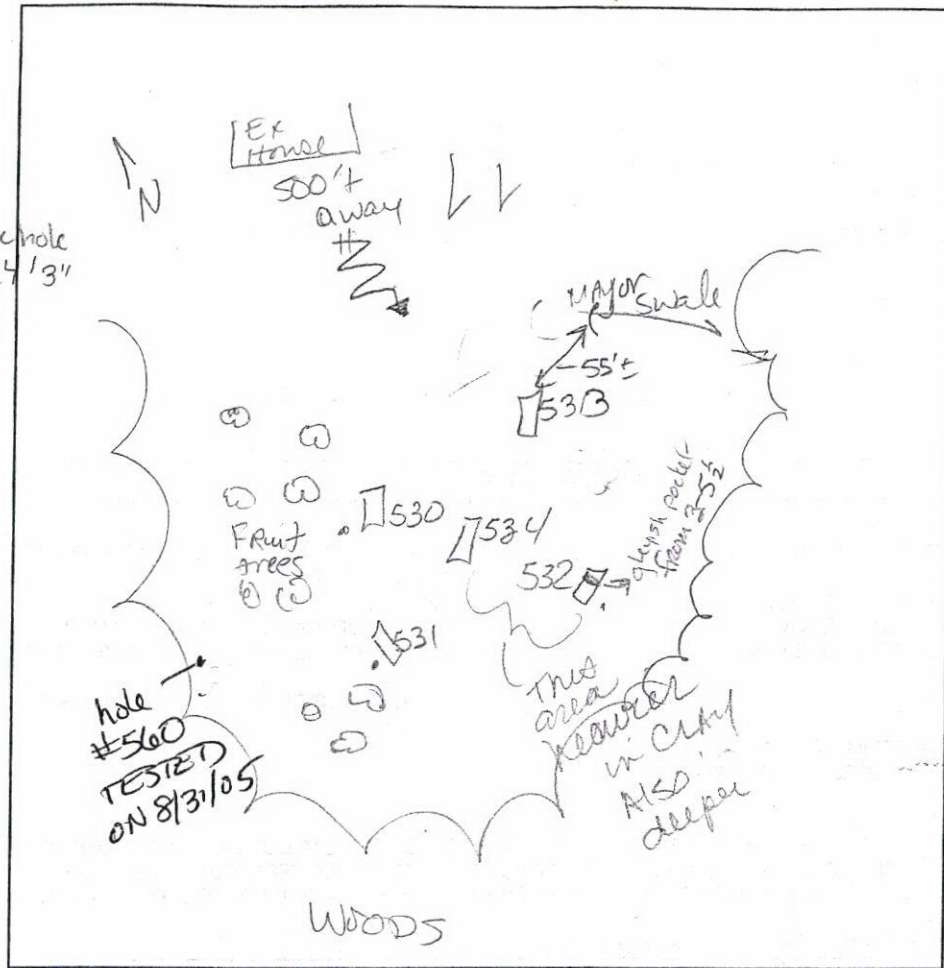

DATE	TEST #	DEPTH	START	BREAK 1" DROP	STOP 2" DROP	TIME OF 2nd INCH	P/F/H
8-10-05	530	4' / 10'	11:15	11:19	11:24	4+5	P
	531	4 1/2' / 11'	11:18	11:21	11:25	4+	P
	532	5 1/2' / 9 1/2'	11:24	11:25	11:28	3 Max pass	
		Grey CLAY Pocket an anomaly for					
	534	5'6"	11:33	11:34	11:36	2+	P
	533	tested in SAP. ON NE WALL @ 4 1/2'	11:36	11:37	11:39	2+	P
	#560	Refusal @ 6'10"					

534
org brn
WKRd
brn
SL
2'
Stry
SCL
5'
WKRd
v. mucac
Loam
10 1/2'

533
WKRd
brn
mucac
SL
3 1/2' brn
WKRd
brn
Stry
ON
NE
wall
tested
OK
v. mucac
in
LS and
F. med gr
10' Bottom

REMARKS 6" test pit holes

SANITARIAN Kacie

BACKHOE M. Johnson

OTHERS Mr. Webster

TEST HOLES USED IN SDA

AVG. PERC TIME

SQ. FT/BR

TRENCH WIDTH

INLET DEPTH

MAX. BOT DEPTH

EFFECTIVE S/W



Perc cert Signed
6/8/16