



Building Permit Application

Howard County Maryland
Department of Inspections, Licenses and Permits
3430 Court House Drive
Permits: 410-313-2455
www.howardcountymd.gov

Date Received: _____

Permit No.: _____

Building Address: 12504 Triadelphia Rd
City: Ellicott City State: MD Zip Code: 21042
Suite/Apt. #: _____ SDP/WP/BA #: _____
Subdivision: _____
Lot: _____ Tax Map: 22 Parcel: 528

Existing Use: Residential
Proposed Use: Residential
Estimated Construction Cost: \$20,000
Description of Work: A deck in the back of the house

Occupant/Tenant Name: _____
Was tenant space previously occupied? ☐ Yes ☐ No
Contact Name: _____
Address: _____
City: _____ State: _____ Zip Code: _____
Phone: _____ Fax: _____
Email: _____

Property Owner's Name: Yuanji Xu & Jia Wang
Address: 12504 Triadelphia Rd
City: Ellicott City State: MD Zip Code: 21042
Phone: 240-319-1309 Fax: _____
Email: wangj509@hotmail.com

Applicant's Name & Mailing Address, (If other than stated herein)
Applicant's Name: Jia Wang
Address: 12504 Triadelphia Rd
City: Ellicott City State: MD Zip Code: 21042
Phone: 240-319-1309 Fax: _____
Email: wangj509@hotmail.com

Contractor Company: _____
Contact Person: _____
Address: _____
City: _____ State: _____ Zip Code: _____
License No.: _____
Phone: _____ Fax: _____
Email: _____

Engineer/Architect Company: _____
Responsible Design Prof.: _____
Address: _____
City: _____ State: _____ Zip Code: _____
Phone: _____ Fax: _____
Email: _____

Commercial Building Characteristics	Residential Building Characteristics
Height:	<input type="checkbox"/> SF Dwelling <input type="checkbox"/> SF Townhouse
No. of stories:	Depth Width
Gross area, sq. ft./floor:	1 st floor:
	2 nd floor:
Area of construction (sq. ft.):	Basement:
	<input type="checkbox"/> Finished Basement
Use group:	<input type="checkbox"/> Unfinished Basement
	<input type="checkbox"/> Crawl Space
Construction type:	<input type="checkbox"/> Slab on Grade
<input type="checkbox"/> Reinforced Concrete	No. of Bedrooms:
<input type="checkbox"/> Structural Steel	Multi-family Dwelling
<input type="checkbox"/> Masonry	No. of efficiency units:
<input type="checkbox"/> Wood Frame	No. of 1 BR units:
<input type="checkbox"/> State Certified Modular	No. of 2 BR units:
	No. of 3 BR units:
	Other Structure:
	Dimensions:
> Roadside Tree Project Permit	Footings:
<input type="checkbox"/> Yes <input type="checkbox"/> No	Roof:
Roadside Tree Project Permit #	<input type="checkbox"/> State Certified Modular
	<input type="checkbox"/> Manufactured Home

Utilities	
Electric: <input type="checkbox"/> Yes <input type="checkbox"/> No	
Gas: <input type="checkbox"/> Yes <input type="checkbox"/> No	
Water Supply	
<input type="checkbox"/> Public	
<input checked="" type="checkbox"/> Private	
Sewage Disposal	
<input type="checkbox"/> Public	
<input checked="" type="checkbox"/> Private	
Heating System	
<input type="checkbox"/> Electric <input type="checkbox"/> Oil	
<input type="checkbox"/> Natural Gas <input type="checkbox"/> Propane Gas	
<input type="checkbox"/> Other:	
Sprinkler System:	
<input type="checkbox"/> Yes <input type="checkbox"/> No	
Grading Permit Number:	
Building Shell Permit Number:	

THE UNDERSIGNED HEREBY CERTIFIES AND AGREES AS FOLLOWS: (1) THAT HE/SHE IS AUTHORIZED TO MAKE THIS APPLICATION; (2) THAT THE INFORMATION IS CORRECT; (3) THAT HE/SHE WILL COMPLY WITH ALL REGULATIONS OF HOWARD COUNTY WHICH ARE APPLICABLE THERETO; (4) THAT HE/SHE WILL PERFORM NO WORK ON THE ABOVE REFERENCED PROPERTY NOT SPECIFICALLY DESCRIBED IN THIS APPLICATION; (5) THAT HE/SHE GRANTS COUNTY OFFICIALS THE RIGHT TO ENTER ONTO THIS PROPERTY FOR THE PURPOSE OF INSPECTING THE WORK PERMITTED AND POSTING NOTICES.

Applicant's Signature: [Signature]
Email Address: wangj509@hotmail.com
Title/Company: _____

Print Name: Jia Wang
Date: _____

Checks Payable to: DIRECTOR OF FINANCE OF HOWARD COUNTY

PLEASE WRITE NEATLY & LEGIBLY

-FOR OFFICE USE ONLY-

AGENCY	DATE	SIGNATURE OF APPROVAL
State Highways		
Building Officials		
PSZA (Zoning)		
PSZA (Engineering)		
Health	<u>7/24/2019</u>	<u>[Signature]</u>

Is Sediment Control approval required for issuance? ☐ Yes ☐ No
☐ CONTINGENCY CONSTRUCTION START

DPZ SETBACK INFORMATION
Front:
Rear:
Side:
Side St.:
All minimum setbacks met? <input type="checkbox"/> Yes <input type="checkbox"/> No
Is Entrance Permit Required? <input type="checkbox"/> Yes <input type="checkbox"/> No
Historic District? <input type="checkbox"/> Yes <input type="checkbox"/> No
Lot Coverage for New Town Zone:
SDP/Red-line approval date:

Filing Fee	\$
Permit Fee	\$
Tech Fee	\$
Excise Tax	\$
PSFS	\$
Guaranty Fund	\$
Add'l per Fee	\$
Total Fees	\$
Sub- Total Paid	\$
Balance Due	\$
Check	#

Distribution of Copies: White: Building Officials

Green: PSZA,Zoning


Yellow: PSZA,Engineering

Pink: Health

Gold: SHA

STATE OF MARYLAND
MICHAEL J. PROFFER
PROFESSIONAL LAND SURVEYOR
NO. 21175
Michael J. Proffer

FLOOD INSURANCE NOTE: By graphics plotting only, this property is in ZONE "X" of the Flood Insurance Rate Map, Community Panel No. 24027C0065D effective date of 11/06/2013. Exact designations can only be determined by an Elevation Certificate. Based on the above information, this property IS NOT in a Special Flood Hazard Area.

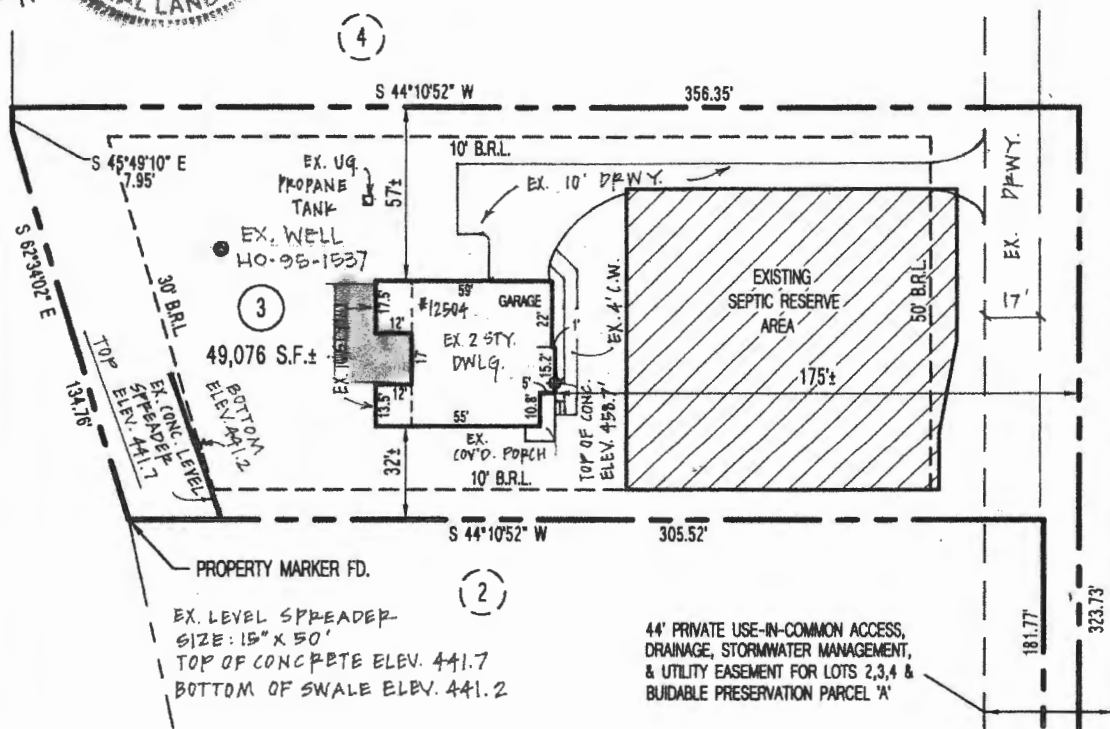


GENERAL NOTES

The plat is a benefit to the consumer only insofar as it is required by the lender or a title insurance company or its agent in connection with contemplated transfer, financing or refinancing.

The plat is not to be relied upon for the establishment or location of fences, garages, buildings, or other existing or future improvements.

The plat does not provide for the accurate identification of property lines, but such identification may not be required for the transfer of title or securing financing or refinancing.

(ACCURACY OF SETBACKS: 1'±)

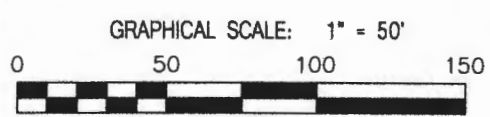

SITERITE
SURVEYING INC.
200 E. JOPPA ROAD
SHELL BUILDING, SUITE 101
TOWSON, MD. 21286
410-828-9060

REVISED MARCH 24, 2017
FINAL LOCATION SURVEY
REVISED FOUNDATION DRAWING
MARCH 22, 2017

10-25-16 : PLOTTED WELL LOCATION MVM

FOUNDATION CERTIFICATION

#12504 TRIADELPHIA ROAD

LOT-3 MDR PLAT No. 19926

"THE WOODS AT TRIADELPHIA"

TAX MAP: 22 GRID: 5 & 6 PARCEL: 528

DEED REFERENCE: 15436/388

3RD ELECTION DISTRICT

HOWARD COUNTY, MARYLAND

Scale: 1" = 50'	Date: 07/13/2016	JOB #10459
Drawn: M.V.M.	Checked: B.L.M.	SURVEY'D: DTW,JK

APPROVED
WALK-THRU BUILDING PERMIT
BP#

A#

APP. SAN Robert Freeman DATE: 7/24/2015
DESC. OF WORK: New Deck

As Shown