



Building Permit Application
Howard County Maryland
Department of Inspections, Licenses and Permits
3430 Court House Drive
Permits 410-313-2455
www.howardcountymd.gov

Date Received

Permit No.

Building Address: 1043 THUNDERBOLT DR
City: WOODBINE State: MD Zip Code: 21797
Suite/Apt. # SDP/WP/BA #:
Subdivision: FAIRLANE FARMS
Lot: 34 Tax Map: N23 Parcel:

Existing Use: N/A
Proposed Use: OUTDOOR LIVING SPACE
Estimated Construction Cost: \$ 45K
Description of Work: 18'x16' DECK WITH
Red. DECK TO BE 9'-0" ABOVE
GRADE. DECK TO HAVE STAIRS
LEADING DOWN TO GRADE LEVEL

Open-porch
Occupant/Tenant Name: MICHAEL MURRAY

Was tenant space previously occupied? Yes No
Contact Name:
Address:
City: State: Zip Code:
Phone: Fax:
Email:

Property Owner's Name: MICHAEL J. MURRAY
Address: 1043 THUNDERBOLT DR
City: WOODBINE State: MD Zip Code: 21797
Phone: 781-670-4242 Fax:
Email: MICHAEL-J. MURRAY10@gmail.com

Applicant's Name & Mailing Address, (If other than stated herein)
Applicant's Name: Same

Address:
City: State: Zip Code:
Phone: Fax:
Email:

Contractor Company: Professional Porch & Deck
Contact Person: Harold Lopez
Address: 738 Elmhurst P.O.
City: Severn State: M.D. Zip Code: 21144
License No.: 117138
Phone: 301-792-7852 Fax:
Email: ProfessionalPorch@gmail.com

Engineer/Architect Company:
Responsible Design Prof.:
Address:
City: State: Zip Code:
Phone: Fax:
Email:

Commercial Building Characteristics	Residential Building Characteristics
Height:	☒ SF Dwelling ☐ SF Townhouse
No. of stories:	40 Depth 60 Width
Gross area, sq. ft./floor:	1 st floor:
Area of construction (sq. ft.):	2 nd floor:
Use group:	Basement:
Construction type:	☒ Finished Basement
☐ Reinforced Concrete	☐ Unfinished Basement
☐ Structural Steel	☐ Crawl Space
☐ Masonry	☐ Slab on Grade
☐ Wood Frame	No. of Bedrooms: 4
☐ State Certified Modular	Multi-family Dwelling
☐ Roadside Tree Project Permit	No. of efficiency units:
☐ Yes ☐ No	No. of 1 BR units:
Roadside Tree Project Permit #	No. of 2 BR units:
	No. of 3 BR units:
	Other Structure:
	Dimensions:
	Footings:
	Roof:
	☐ State Certified Modular
	☐ Manufactured Home

Utilities
Electric: ☒ Yes ☐ No
Gas: ☒ Yes ☐ No
Water Supply
☐ Public
☒ Private
Sewage Disposal
☐ Public
☒ Private
Heating System
☐ Electric ☐ Oil
☐ Natural Gas ☒ Propane Gas
☐ Other:
Sprinkler System:
☒ Yes ☐ No
Grading Permit Number:
Building Shell Permit Number:

THE UNDERSIGNED HEREBY CERTIFIES AND AGREES AS FOLLOWS: (1) THAT HE/SHE IS AUTHORIZED TO MAKE THIS APPLICATION, (2) THAT THE INFORMATION IS CORRECT, (3) THAT HE/SHE WILL COMPLY WITH ALL REGULATIONS OF HOWARD COUNTY WHICH ARE APPLICABLE THERETO, (4) THAT HE/SHE WILL PERFORM NO WORK ON THE ABOVE REFERENCED PROPERTY NOT SPECIFICALLY DESCRIBED IN THIS APPLICATION, (5) THAT HE GRANTS COUNTY OFFICIALS THE RIGHT TO ENTER ONTO THIS PROPERTY FOR THE PURPOSE OF INSPECTING THE WORK PERMITTED AND POSTING NOTICES

Applicant's Signature: [Signature]
Print Name: MICHAEL J. MURRAY
Date: 9/19/19
Title/Company: [Signature]

Print Name: Harold Lopez
Date: 9/19/19

Checks Payable to: DIRECTOR OF FINANCE OF HOWARD COUNTY

PLEASE WRITE NEATLY & LEGIBLY
-FOR OFFICE USE ONLY-

AGENCY	DATE	SIGNATURE OF APPROVAL
State Highways		
Building Officials		
PSZA (Zoning)		
PSZA (Engineering)		
Health		
Sediment Control approval required for issuance?	Yes No	
CONTINGENCY CONSTRUCTION START		

DPZ SETBACK INFORMATION
Front:
Rear:
Side:
Side St.:
All minimum setbacks met? ☐ Yes ☐ No
Entrance Permit Required? ☐ Yes ☐ No
Historic District? ☐ Yes ☐ No
Lot Coverage for New Town Zone:
SDP/Red-line approval date:

Filing Fee	\$ 25.00
Permit Fee	\$
Tech Fee	\$
Excise Tax	\$
PSFS	\$
Guaranty Fund	\$
Add'l per Fee	\$
Total Fees	\$
Sub- Total Paid	\$
Balance Due	\$
Check	#

Distribution of Copies: White- Building Officials


Green: PSZA, Zoning

Yellow: PSZA, Engineering


Pink: Health

Gold: SHA

Updated Form (Building Permit Application) 10/2018.docx

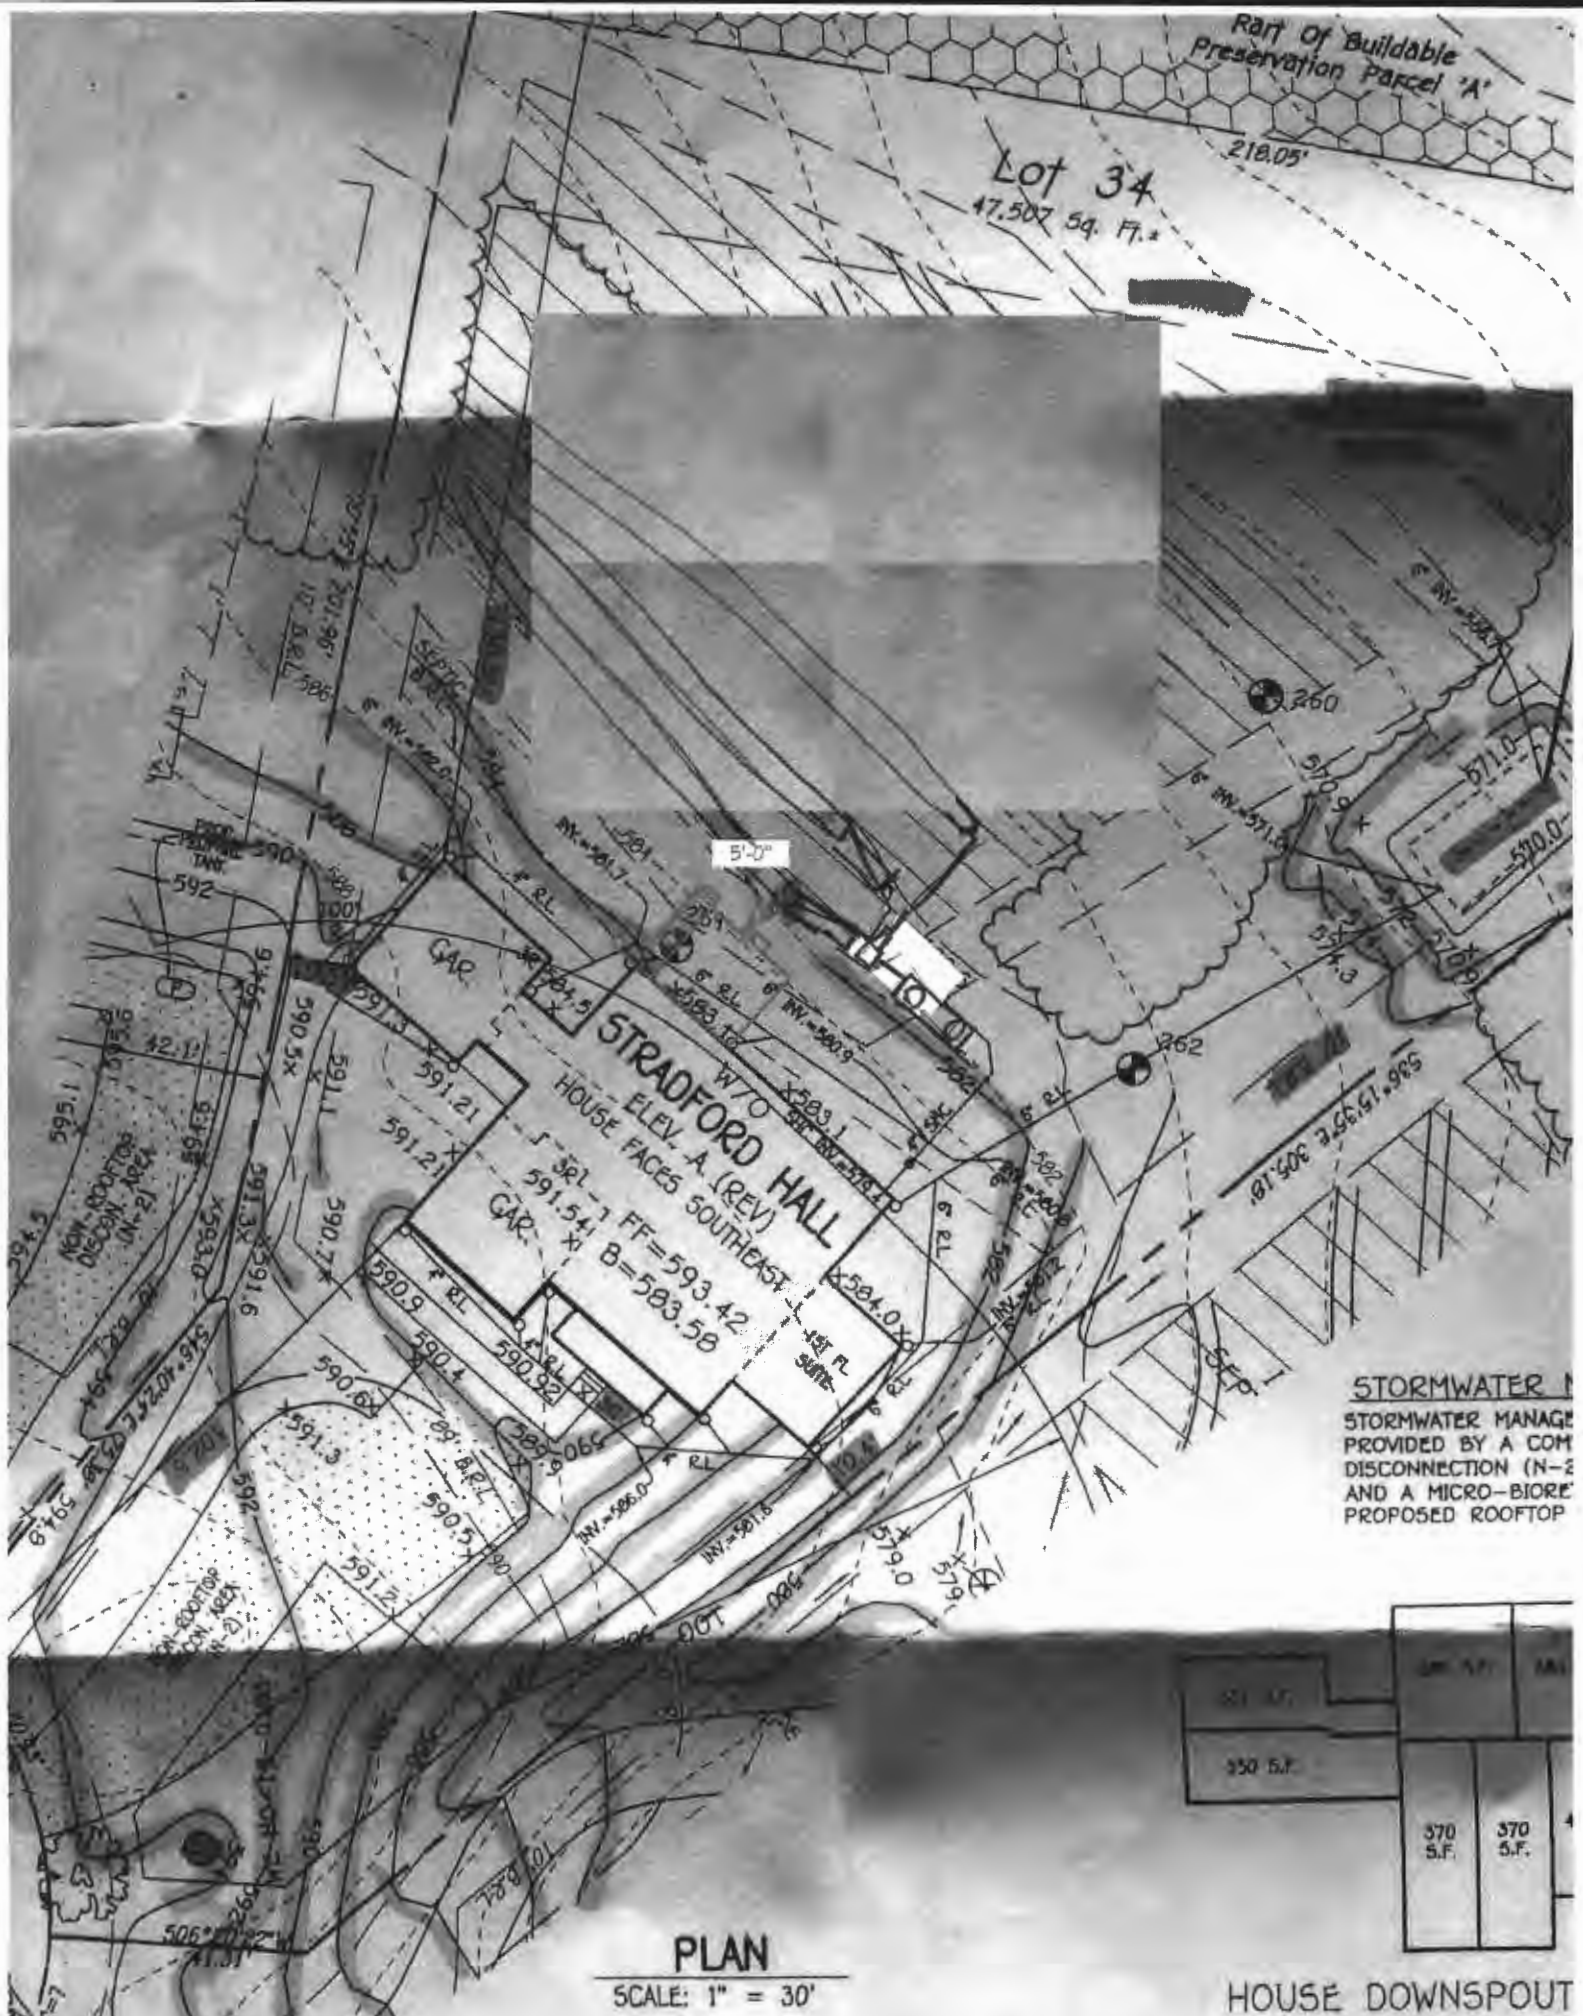

PLAN
SCALE: 1" = 30'

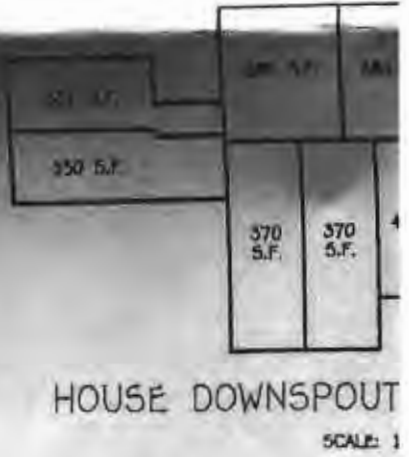

APPROVED
WALK-THRU BUILDING PERMIT
BP# _____ A# _____
APP. SAN *K. L. White* DATE: *8/24/19*
DESC. OF WORK: *proposed 18'x16'*
Deck w/ ramp to as shown
5' setback to SDA

PERMIT SITE
LOT :
1043 THUNDER
FAIRLANE I
PHASE IV
ZONED: RC-
TAX MAP NO.: 8 GRID NO.
5TH ELECTION DISTRICT HOW
SCALE: 1"=30' DATE: OCT 1
SHEET 1 OF

FISHER, COLLINS & CARTER, INC.
CIVIL ENGINEERING CONSULTANTS & LAND SURVEYORS
CENTENNIAL SQUARE OFFICE PARK - 10072 BALTIMORE NATIONAL PIKE
BALTIMORE CITY, MARYLAND 21042
(410) 481 - 2005

OWNER/DEVELOPER
NV HOMES
9720 PATUXENT WOODS DRIVE
COLUMBIA, MD 21046
410-379-5956

SHEFF