

**COMPLETE THIS FORM WHEN DROPPING OFF ANY  
CORRESPONDENCE AND/OR PLANS TO THE HOWARD COUNTY  
DEPARTMENT OF INSPECTIONS, LICENSES AND PERMITS COUNTER:**

Date: 4/3/19

To: Ryan - HEALTH DEPT  
(Person's Name and Division)

From: Michelle Clancy 443.610.7514  
(Your Name, Company Name and Telephone Number)

Subject: Project name TECH AIR

Project site address 12541 Westland Ct

Permit # B19000703 SDP # \_\_\_\_\_

Other information pertinent to this project \_\_\_\_\_

RECEIVED  
APR 03 2019  
PLAN REVIEW DIVISION

✓ Please check the attachments below that you are submitting with this transmittal:

- ☒ Letter of response to address plan review comment letter
- ☒ Revised plans and/or revised details: When submitting for a complete re-review, duplicate sets shall be submitted.
- ☐ Letter Summarizing Changes Site plan w/ location change
- ☐ Energy conservation calculations
- ☒ Copies of revised plot plan (be specific).
- ☐ Health Department Request ☐ DPZ/ DED Request ☐ Applicant's Request
- ☐ Two sets of single family dwelling model plans to be placed on permanent file: Model name and/or # \_\_\_\_\_
- ☐ Other \_\_\_\_\_

**Contact Person Information: (Required)**

Michelle Clancy  
Please Print Name

Telephone No: 443.610.7514


E-Mail Address: michelle@approvedandapproved.com

**PLEASE ASSURE ALL DOCUMENTS AND/OR REVISIONS ARE APPROPRIATELY SIGNED AND SEALED, IF NECESSARY, BY A LICENSED ARCHITECT OR ENGINEER. PLEASE BE ADVISED THAT INSUFFICIENT INFORMATION MAY RESULT IN THE DELAY OF REVIEW BY THE PLANS EXAMINER. THE DEPARTMENT OF INSPECTIONS, LICENSES AND PERMITS WILL CONTACT YOU IF THERE IS A PROBLEM. IN ADDITION, ONCE THE BUILDING PERMIT IS APPROVED BY THE PLAN REVIEW DIVISION AND ALL OTHER REQUIRED SIGNATORY AGENCIES, AND THE BUILDING PERMIT IS READY FOR ISSUANCE, THE PERMIT DIVISION WILL NOTIFY THE APPROPRIATE CONTACT PERSON FOR PERMIT PICK UP. ALL PERMIT STATUS INQUIRIES SHALL BE DIRECTED TO THE PERMIT DIVISION AT 410-313-2455. CODE RELATED QUESTIONS AND PLAN REVIEW INQUIRIES SHALL BE DIRECTED TO THE PLAN REVIEW DIVISION AT 410-313-2436. PLEASE ALLOW A MINIMUM OF FIVE (5) WORKING DAYS FOR ANY PLAN SUBMITTALS TO BE REVIEWED. THANK YOU.**

Received by AKH

cc: Bldg  
P+Z  
DED

LOCATION CHANGE  
PER HEALTH DEPT - R. [signature]  
4/5/19

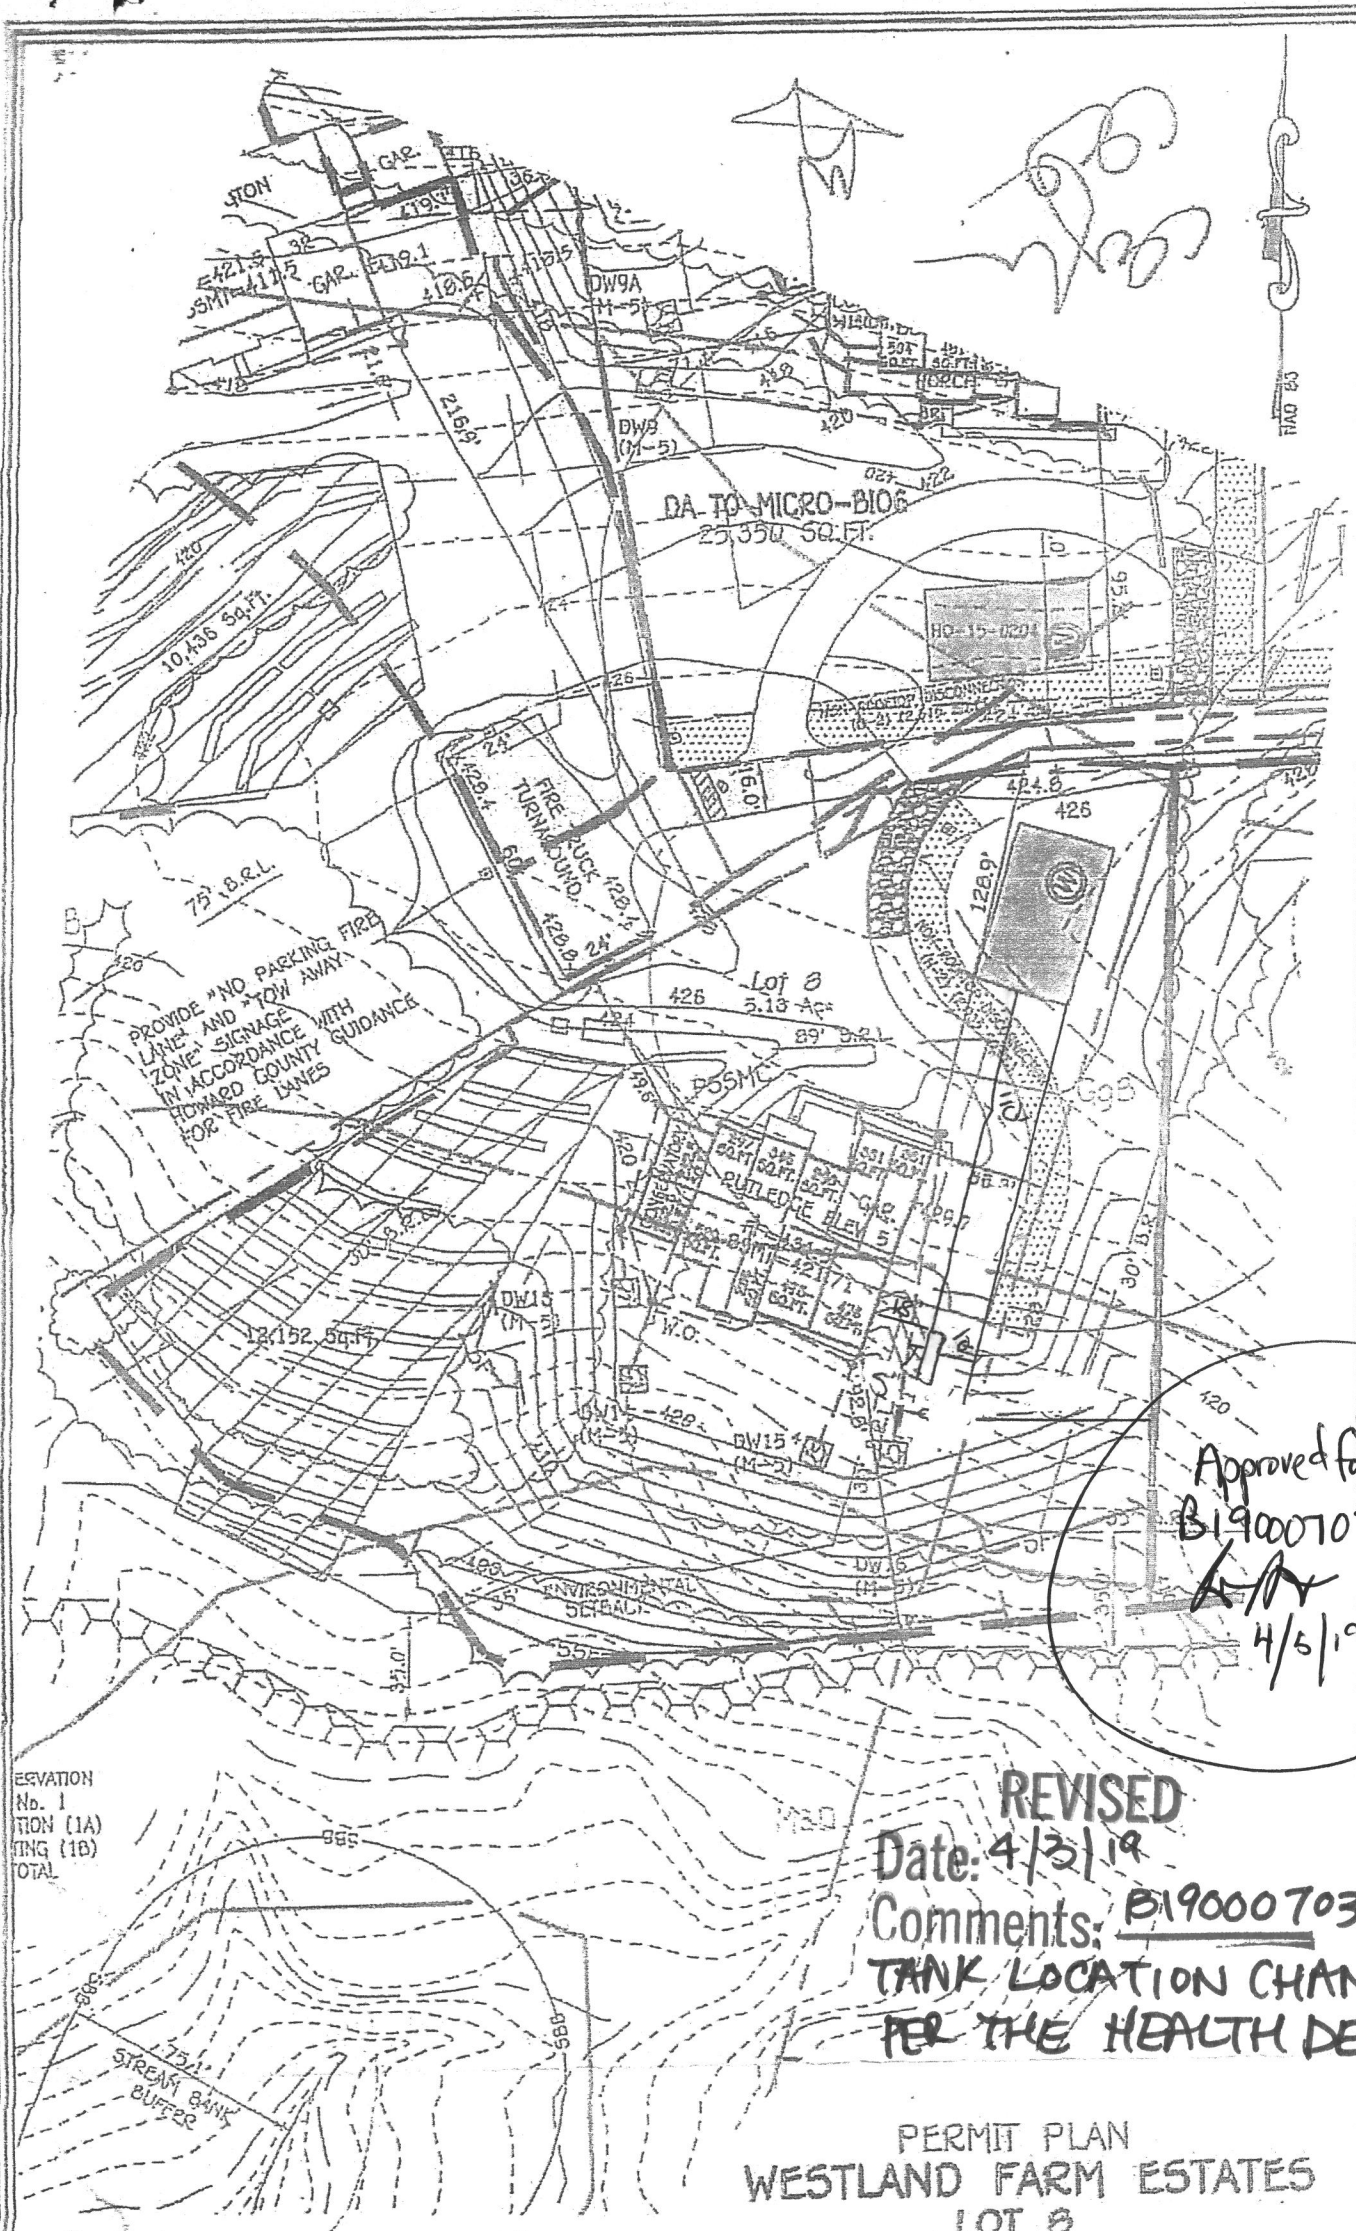

under ground Tank

ELEVATION  
No. 1  
TION (1A)  
TING (1B)  
TOTAL

REVISED  
Date: 4/3/19  
Comments: B19000703  
TANK LOCATION CHANGE  
PER THE HEALTH DEPT

PERMIT PLAN  
WESTLAND FARM ESTATES  
LOT 8  
12541 WESTLAND COURT

FISHER, COLLINS & CARTER, INC.  
CIVIL ENGINEERING CONSULTANTS & LAND SURVEYORS  
CENTENNIAL SQUARE OFFICE PARK - 10272 BALTIMORE NATIONAL PIKE  
ELLCOTT CITY, MARYLAND 21042  
(410) 461 - 2855

TAX MAP #45 PARCEL: 20  
ZONED: RR-DEO  
THIRD ELECTION DISTRICT HOWARD COUNTY, MARYLAND  
SCALE: 1" = 60' DATE: MARCH, 2016