

RB  
2/28/2020

Search Result for HOWARD COUNTY

[View Map](#)      [View GroundRent Redemption](#)      [View GroundRent Registration](#)

Special Tax Recapture: None

Account Identifier:      District - 04 Account Number - 323092

Owner Information

Owner Name:      GIDDINGS RICHARD WESTLEY      Use:      RESIDENTIAL  
Principal Residence:      NO  
Mailing Address:      4910 FEESER RD W      Deed Reference:      /11324/ 00715  
TANEYTOWN MD 21787-

Location & Structure Information

Premises Address:      1310 WOODBINE RD      Legal Description:      .28 ACRE  
WOODBINE 21797-0000      1310 WOODBINE RD  
WOODBINE

Map:	Grid:	Parcel:	Neighborhood:	Subdivision:	Section:	Block:	Lot:	Assessment Year:	Plat No:
0007	0011	0096	4010102.14	1002				2020	Plat Ref:

Town: None

Primary Structure Built      Above Grade Living Area      Finished Basement Area      Property Land Area      County Use  
1950      600 SF           12,196 SF

Stories	Basement	Type	Exterior	Quality	Full/Half Bath	Garage	Last Notice of Major Improvements
1	YES	STANDARD UNIT	SIDING/	2	1 full		

Value Information

	Base Value	Value	Phase-in Assessments	
		As of	As of	As of
		01/01/2020	07/01/2019	07/01/2020
Land:	170,500	242,300		
Improvements	35,500	41,500		
Total:	206,000	283,800	206,000	231,933
Preferential Land:	0			0

Transfer Information

Seller: MANCILLAS PETER      Date: 08/13/2008      Price: \$185,000  
Type: ARMS LENGTH IMPROVED      Deed1: /11324/ 00715      Deed2:  
Seller: CAMPBELL DONALD L      Date: 06/26/2003      Price: \$140,000  
Type: ARMS LENGTH IMPROVED      Deed1: /07307/ 00410      Deed2:  
Seller: GARDNER JANET R.      Date: 01/16/2001      Price: \$107,000  
Type: ARMS LENGTH IMPROVED      Deed1: /05315/ 00115      Deed2:

Exemption Information

Partial Exempt Assessments:	Class	07/01/2019	07/01/2020
County:	000	0.00	
State:	000	0.00	
Municipal:	000	0.00 0.00	0.00 0.00

Special Tax Recapture: None

Homestead Application Information

Homestead Application Status: Approved 10/09/2008

Homeowners' Tax Credit Application Information

Homeowners' Tax Credit Application Status: No Application      Date:

4-12 ft. holes  
40 ft. apart  
skip off

# APPLICATION

A 16354

SEWAGE DISPOSAL TESTING

P \_\_\_\_\_

MARYLAND STATE DEPARTMENT OF HEALTH

HOWARD COUNTY

ELLICOTT CITY

DISTRICT 4

DATE 10/4/71

TO: THE COUNTY HEALTH OFFICER  
ELLICOTT CITY, MARYLAND

I, HEREBY, APPLY FOR THE NECESSARY TESTS IN ORDER TO CONSTRUCT (OR RECONSTRUCT) A SEWAGE DISPOSAL SYSTEM.

PROPERTY OWNER Humble Oil Co. (Contract Purchaser)

ADDRESS Dundalk Avenue near Eastern Avenue PHONE ME 3-9550

PROPERTY LOCATION:

SUBDIVISION \_\_\_\_\_ LOT NO. \_\_\_\_\_

ROAD AND DESCRIPTION Corner of Route 144 & Rt. 94 - Lisbon, Md.

(area between TV shop and next two houses - almost to Lisbon Fire House)

OCCUPANT \_\_\_\_\_ PHONE \_\_\_\_\_

PERSON TO CONSTRUCT SYSTEM \_\_\_\_\_

ADDRESS \_\_\_\_\_ PHONE \_\_\_\_\_

SIZE OF LOT 300' x 147' TYPE BLDG. Filling Station  
NUMBER OF BEDROOMS \_\_\_\_\_

IF NOT SINGLE RESIDENCE DESCRIBE \_\_\_\_\_

SIGNATURE OF APPLICANT Francis Bavellio


APPROVED BY \_\_\_\_\_ FOR \_\_\_\_\_ DATE \_\_\_\_\_  
(KIND OF SYSTEM)

REJECTED BY \_\_\_\_\_ FOR \_\_\_\_\_ DATE \_\_\_\_\_  
(KIND OF SYSTEM)

HOLD PENDING FURTHER TESTS \_\_\_\_\_ DATE \_\_\_\_\_

REASONS FOR REJECTION OR HOLDING \_\_\_\_\_

# THIS IS NOT A PERMIT

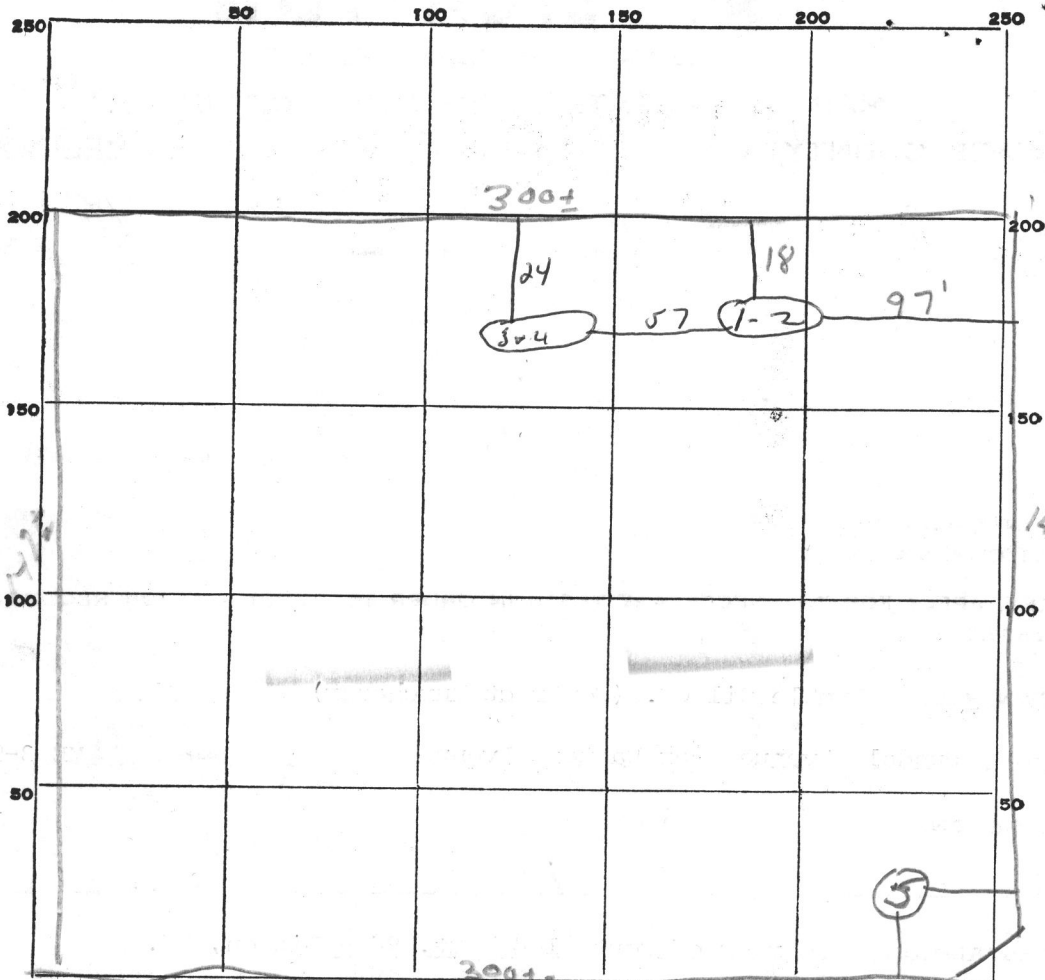

INDICATE NORTH. - NAME ADJOINING ROADWAY AS BASE LINE.

RT 94

DATE	TEST NO.	DEPTH	PRE-WET		TEST - 1" DROP		TIME
			START	STOP	START	STOP	
10/13/71	1	4ft	9 <sup>52</sup>	overtime - no perc			
	2	water breaking in at 10ft					
	3	4ft	10 <sup>13</sup>	overtime - no perc.			
	4	water at 9 1/2 ft					
	5	water at 9ft					

SOIL AUGER FINDING \_\_\_\_\_

TESTED BY Dum \_\_\_\_\_

REMARKS \_\_\_\_\_

# APPLICATION

A 16354

P \_\_\_\_\_

SEWAGE DISPOSAL TESTING

MARYLAND STATE DEPARTMENT OF HEALTH

HOWARD COUNTY

ELLICOTT CITY

DISTRICT 4

DATE 10/4/71

*4-12 ft. holes  
40 ft. shelf off  
10/13/71  
9:30*

TO: THE COUNTY HEALTH OFFICER  
ELLICOTT CITY, MARYLAND

I, HEREBY, APPLY FOR THE NECESSARY TESTS IN ORDER TO CONSTRUCT (OR RECONSTRUCT) A SEWAGE DISPOSAL SYSTEM.

PROPERTY OWNER Humble Oil Co. (Contract Purchaser)

ADDRESS Dundalk Avenue near Eastern Avenue PHONE ME 3-9550

PROPERTY LOCATION:

SUBDIVISION \_\_\_\_\_ LOT NO. \_\_\_\_\_

ROAD AND DESCRIPTION Corner of Route 144 & Rt. 94 - Lisbon, Md.

(area between TV shop and next two houses - almost to Lisbon Fire House)

OCCUPANT \_\_\_\_\_ PHONE \_\_\_\_\_

PERSON TO CONSTRUCT SYSTEM \_\_\_\_\_

ADDRESS \_\_\_\_\_ PHONE \_\_\_\_\_

SIZE OF LOT 300' x 147' TYPE BLDG. Filling Station  
NUMBER OF BEDROOMS \_\_\_\_\_

IF NOT SINGLE RESIDENCE DESCRIBE \_\_\_\_\_

SIGNATURE OF APPLICANT Francis Baverlin


APPROVED BY \_\_\_\_\_ FOR \_\_\_\_\_ DATE \_\_\_\_\_  
(KIND OF SYSTEM)

REJECTED BY D.W. Monaghan FOR Septic DATE 10/13/71  
(KIND OF SYSTEM)

HOLD PENDING FURTHER TESTS \_\_\_\_\_ DATE \_\_\_\_\_

REASONS FOR REJECTION OR HOLDING 10/13/71 - no perc. - high water table

# THIS IS NOT A PERMIT

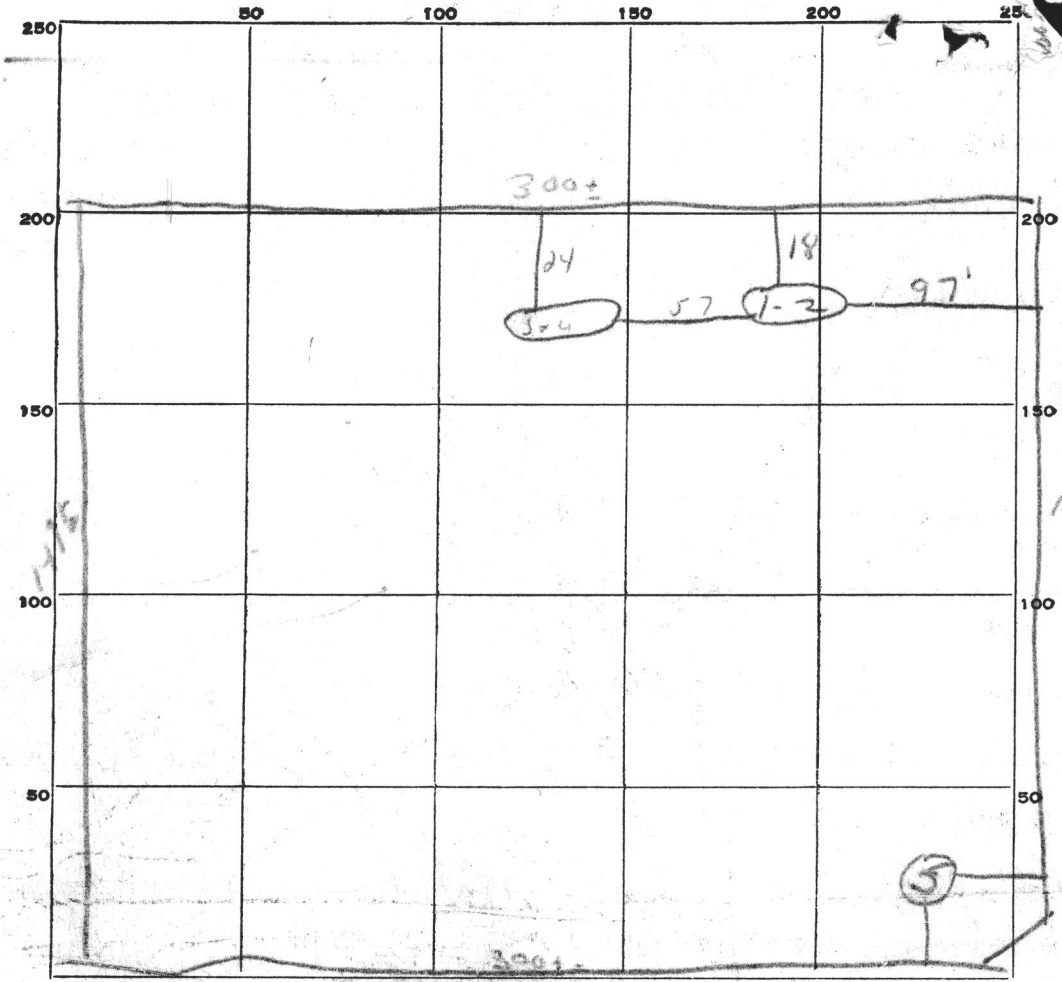

INDICATE NORTH. - NAME ADJOINING ROADWAY AS BASE LINE.

RT 94

DATE	TEST NO.	DEPTH	PRE-WET		TEST - 1" DROP		TIME
			START	STOP	START	STOP	
10/13/71	1	4ft	9 <sup>52</sup>				
	2						
	3	4ft	10 <sup>13</sup>				
	4						
	5						

SOIL AUGER FINDING \_\_\_\_\_

TESTED BY AWM

REMARKS \_\_\_\_\_

# MARYLAND SURVEYING AND ENGINEERING CO., INC.

Subsidiary of LYON ASSOCIATES, INC.

6707 WHITESTONE ROAD

BALTIMORE, MARYLAND 21207

TELEPHONE: 301-944-9291

ENGINEERING

SURVEYING

PLANNING



MD RT. 144

N 63° 15' W

147' ±

P.O.B.

DENIARD  
Vehicle Shop

G. HANSEN WATKINS

469/28

TOTAL AREA = 1.0 AC ±

S 75° 15' W

300' ±

CLYDE GUE & WF.

300' ±

N 25° 15' E

R.F. MILLS & WF.


147' ±

S 63° 15' E

MD RT 94

LISBON, MD.

HOWARD CO.

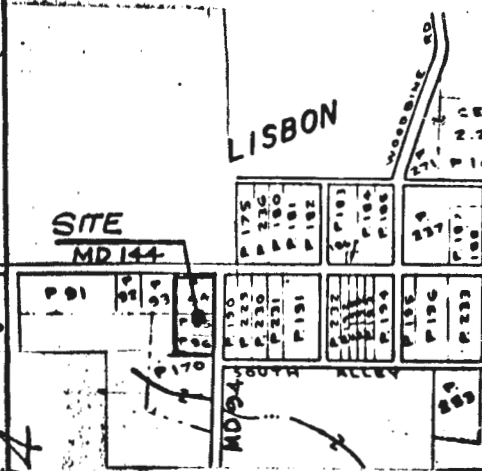

SITE LOCATION  
NO SCALE

NOTE:  
COMPILED FROM DEEDS  
SUBJECT TO SURVEY.


1" = 50'

Signed This \_\_\_\_\_ day \_\_\_\_\_ 19\_\_\_\_

SCALE 50 ft. = 1 inch








File No. \_\_\_\_\_

*[Handwritten signatures and initials]*

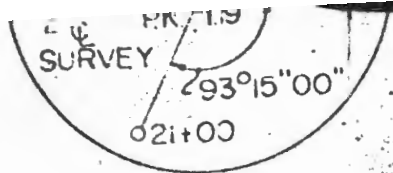

RELOCATED MD. RTE. 94  
STA. 28+70.51

POPLAR SPRINGS

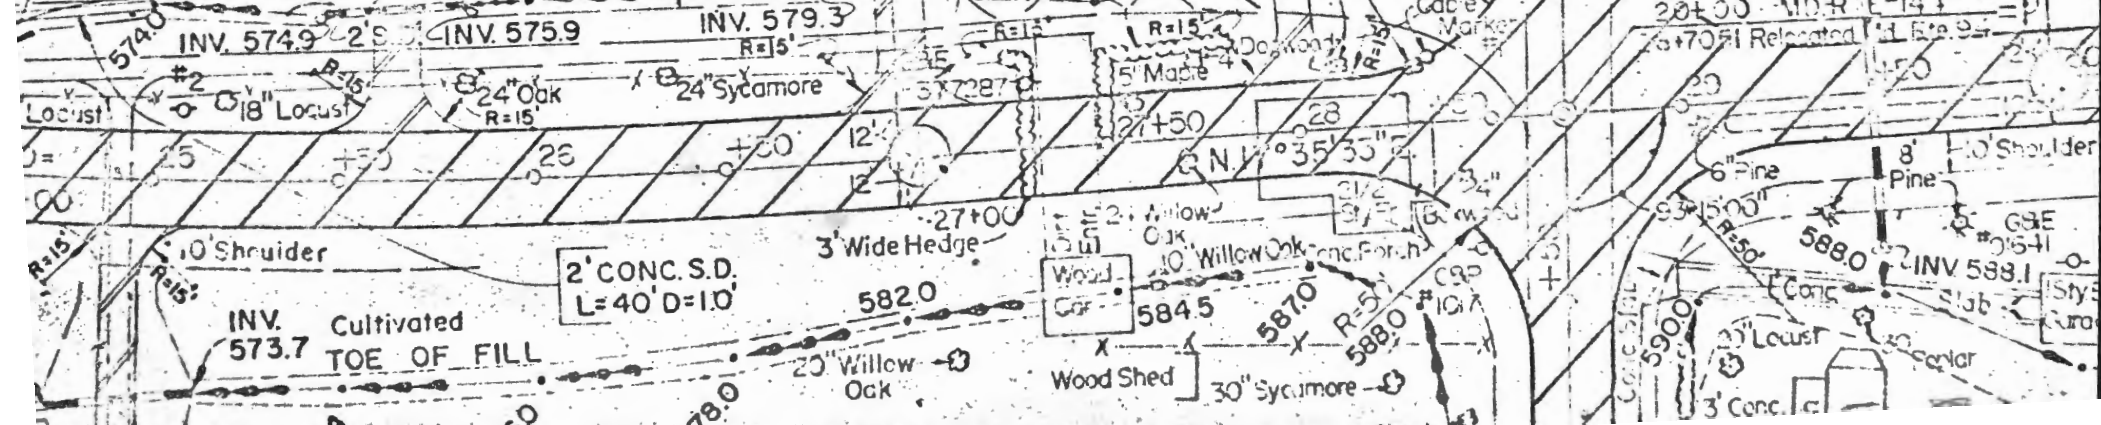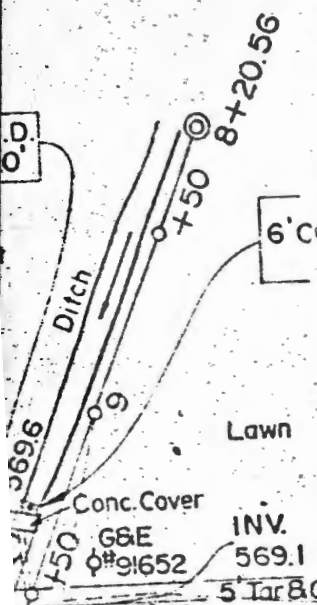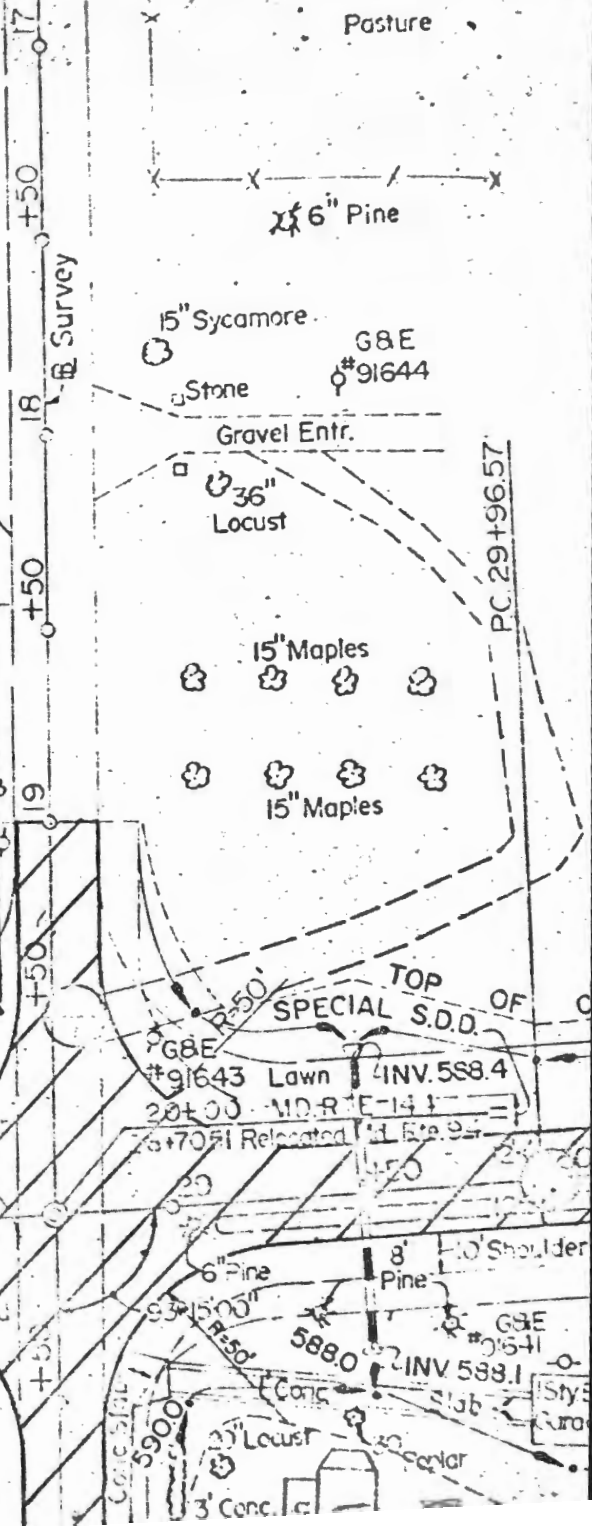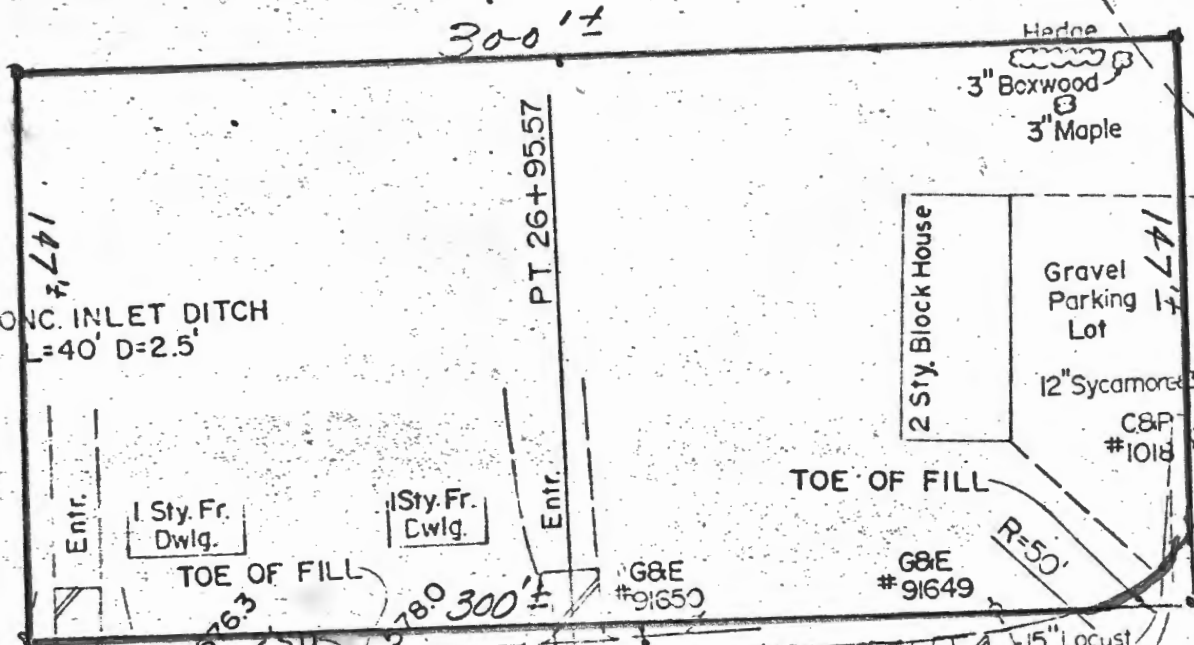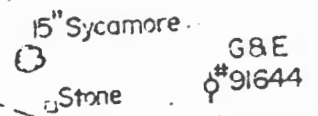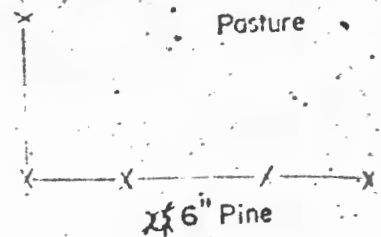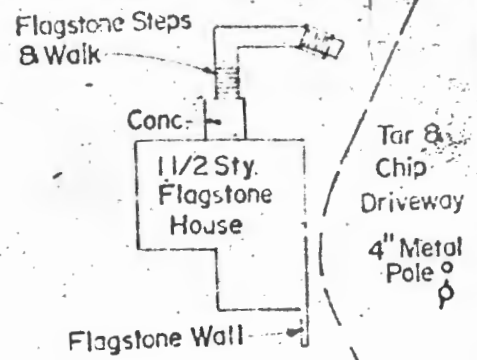



# HUMBLE OIL & REFINING COMPANY

BALTIMORE, MARYLAND 21224

MARKETING DEPARTMENT  
EASTERN REGION  
BALTIMORE DISTRICT

DUNDALK AVENUE NEAR EASTERN AVENUE

OCTOBER 1, 1971

PROPOSED LOCATION:  
I-70N & MD. RT. #01  
LISBON, MARYLAND

TO WHOM IT MAY CONCERN:

THIS IS TO ADVISE THAT WE WILL NOT WASH CARS AT THE ABOVE LOCATION.

  
Smith N. Stathem, Jr.