



7612 Browns Bridge Road
Highland, MD 20777
301-776-2666
info@TransformingArchitecture.com
www.TransformingArchitecture.com



STAMP

CERTIFY THAT THESE DOCUMENTS WERE
PREPARED OR APPROVED BY ME, AND THAT I
AM A DULY LICENSED ARCHITECT UNDER THE
LAWS OF THE STATE OF MARYLAND, LICENSE
NUMBER 13662, EXPIRATION 10-22-2021.

NOTE: THESE DRAWINGS ARE THE PROPERTY
OF TRANSFORMING ARCHITECTURE AND, AS
SUCH, MAY NOT BE REUSED OR REPRODUCED,
EITHER WHOLLY OR IN PART, WITHOUT PRIOR
ARCHITECTURE

PERMIT
REVISION

PROJECT TITLE

THE
OGUNMEFUN
RESIDENCE
14050 Tridelphia Rd
Glenelg, MD 21737


REVISIONS


SYMBOL	DATE	ISSUED FOR
1	08-23-2019	PERMIT REVISION 1
2	12-27-2019	PERMIT AMENDMENT
3	02-21-2020	PERMIT AMENDMENT 2

PROJECT NUMBER	17-320
DATE	02/21/2020
SCALE	AS NOTED
DRAWING TITLE	FIRST FLOOR PLAN


SHEET NUMBER
A-101

LINE TYPE KEY:
NEW WALL
EXIST. WALL
ABOVE LINE
FON. WALL

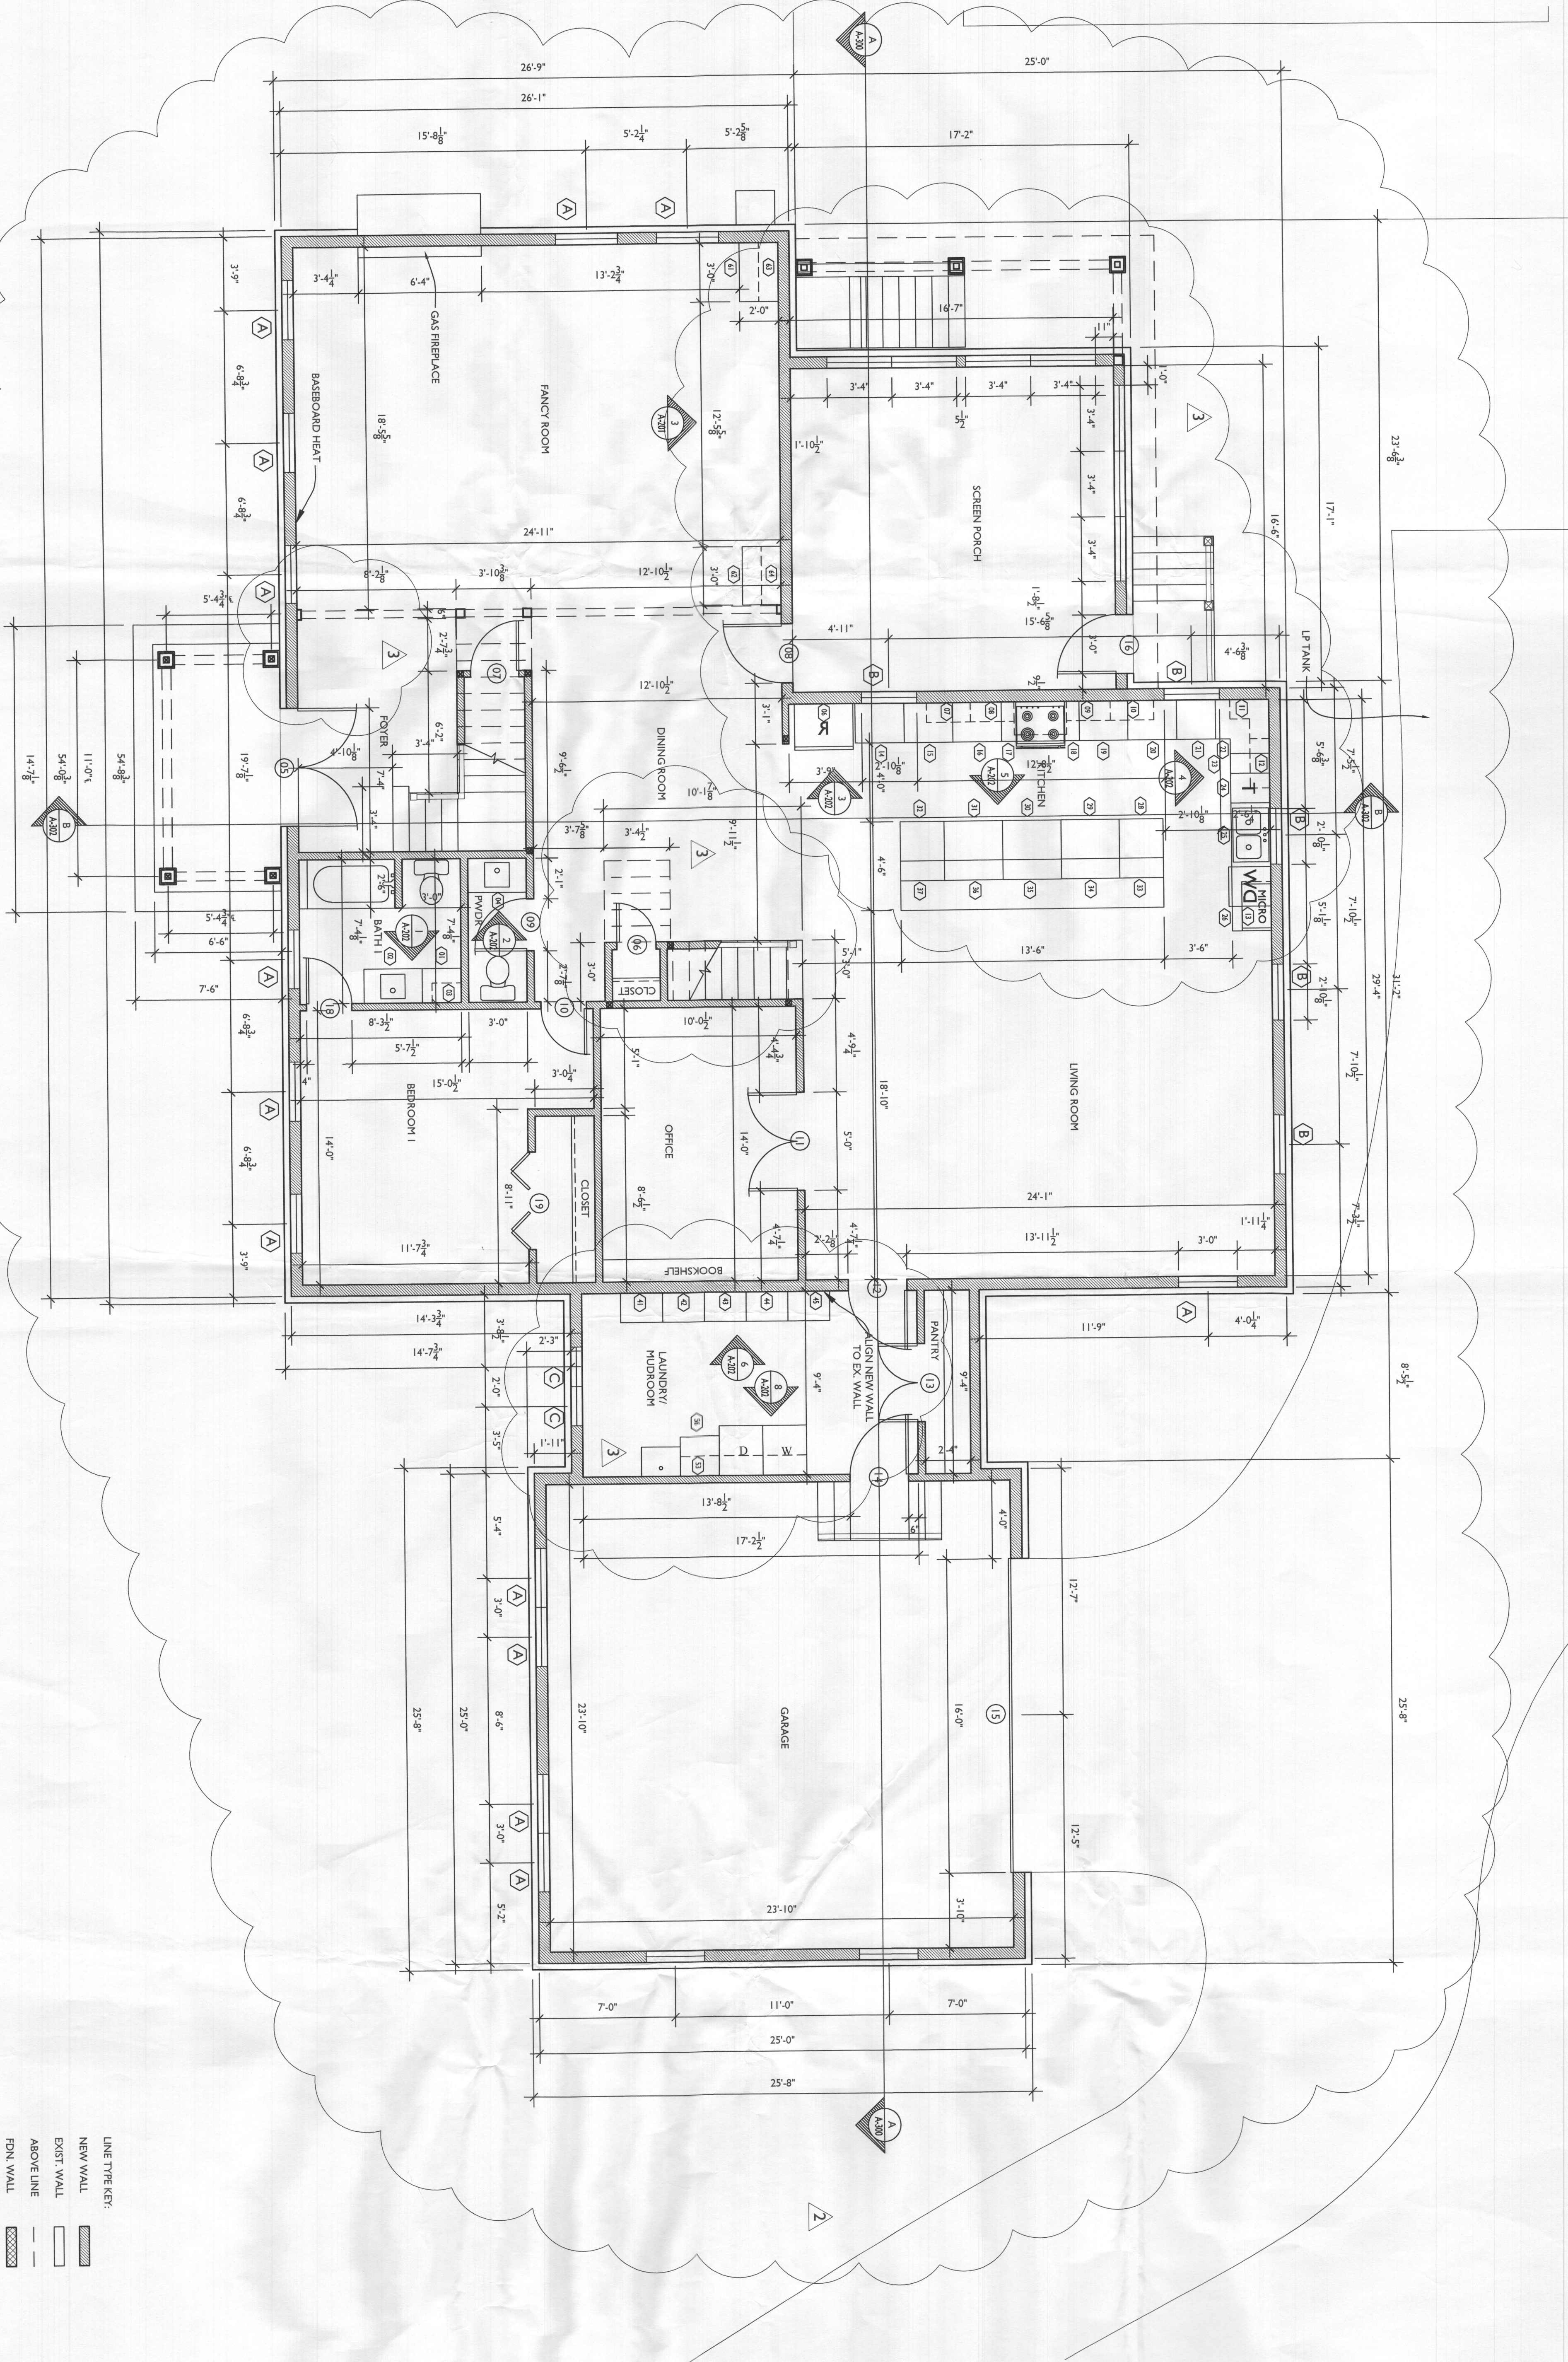

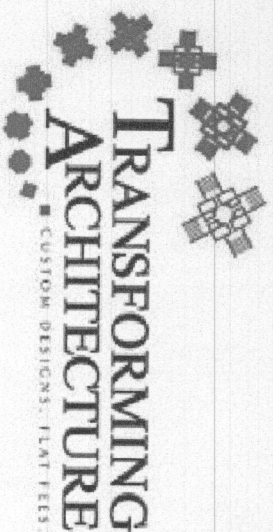

7612 Browns Bridge Road
Highland, MD 20777
301-776-3666
301-776-3886 fax
info@TransformingArchitecture.com
www.TransformingArchitecture.com

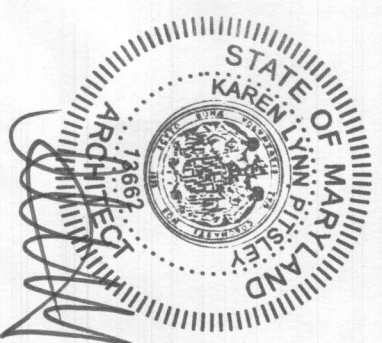

STAMP

I CERTIFY THAT THESE DOCUMENTS WERE PREPARED BY ME OR UNDER MY CLOSE PERSONAL SUPERVISION AND THAT I AM A DULY LICENSED ARCHITECT UNDER THE LAWS OF THE STATE OF MARYLAND, LICENSE NUMBER 13662, EXPIRATION 10/22/2021.

NOTE: THESE DRAWINGS ARE THE PROPERTY OF TRANSFORMING ARCHITECTURE AND, AS SUCH, MAY NOT BE USED OR REPRODUCED, EITHER WHOLLY OR IN PART, WITHOUT PRIOR WRITTEN CONSENT OF TRANSFORMING ARCHITECTURE.

PROJECT PHASE
PERMIT
REVISION

PROJECT TITLE

THE
OGUNMEFUN
RESIDENCE

14050 Triadelphia RD
Glenelg, MD 21737

REVISIONS

SYMBOL	DATE	ISSUED FOR
1	08/23/2019	PERMIT REVISION 1
2	12/27/2019	PERMIT AMENDMENT
3	02/21/2020	PERMIT AMENDMENT 2

PROJECT NUMBER	17-3220
DATE	02/21/2020
SCALE	AS NOTED

LINE TYPE KEY:
NEW WALL
EXIST. WALL
ABOVE LINE
FDN. WALL

DRAWING TITLE
SECOND FLOOR
PLAN

SHEET NUMBER

A-102

1
SECOND
FLOOR PLAN
SCALE: 1/4"=1'-0"

