

## **Bureau of Environmental Health**

8930 Stanford Boulevard, Columbia, MD 21045 Main: 410-313-2640 | Fax: 410-313-2648 TDD 410-313-2323 | Toll Free 1-866-313-6300 www.hchealth.org

Facebook: www.facebook.com/hocohealth


Maura J. Rossman, M.D., Health Officer

RECEIPT D	DATE: 12-10-19 ONSITE SEWAGE DISPOSAL SYSTEM P 66489	
INSTALLA APPROVAL D	PERMIT  A  SEWED LIGHT A	
	SEWER HOUSE CONNECTION	
PROPERTY AD	DDRESS: 13723 Tergeo Drive	
SUBDIVISION	J: LOT: TAX ID:	
CONTRACTOR	R: South Carroll Backage EMAIL:	
CONTRACTOR	R: South Carroll Backhol EMAIL:  RADDRESS: 4410 Salem Bottom Road PHONE: 410596-36,  WNER: NV Homes FMAIL:	18
	LIVIAL.	
OWNER ADDI	RESS: 9720 Patuxent Woods Drive PHONE: 410-379-5956	
NUMBER OF E	BEDROOMS: 5 CONNECTED TO PUBLIC WATER: YES NO	
LOCATION:	INSTALL 4" SEWER LINE PER APPROVED SITE PLAN.	
NOTES:		
ISSUED BY:	ISSUE DATE: 12-16-19 EXPIRATION DATE: 12-16-90	
NOTE: CONT	WARD COUNTY BUREAU OF UTILITIES APPROVAL OF GRINDER PUMP INSTALLATION IS REQUIRED OR TO SEPTIC PERMIT APPROVAL TRACTOR MUST SCHEDULE AN INSPECTION AND GAIN APPROVAL OF ALL COMPONENTS PRIOR TO COVERING ELECTRICAL PERMIT IS REQUIRED FOR INSTALLATION OF ANY ELECTRICAL COMPONENTS OF THE SYSTEM	

NEITHER THE HOWARD COUNTY COUNCIL NOR THE HEALTH DEPARTMENT IS RESPONSIBLE FOR THE SUCCESSFUL OPERATION OF ANY SYSTEM.

PERMITTEE RESPONSIBLE FOR OBTAINING FINAL APPROVAL ON THIS PERMIT.

CALL 410-313-1771 FOR INSPECTION OF SEPTIC SYSTEM.

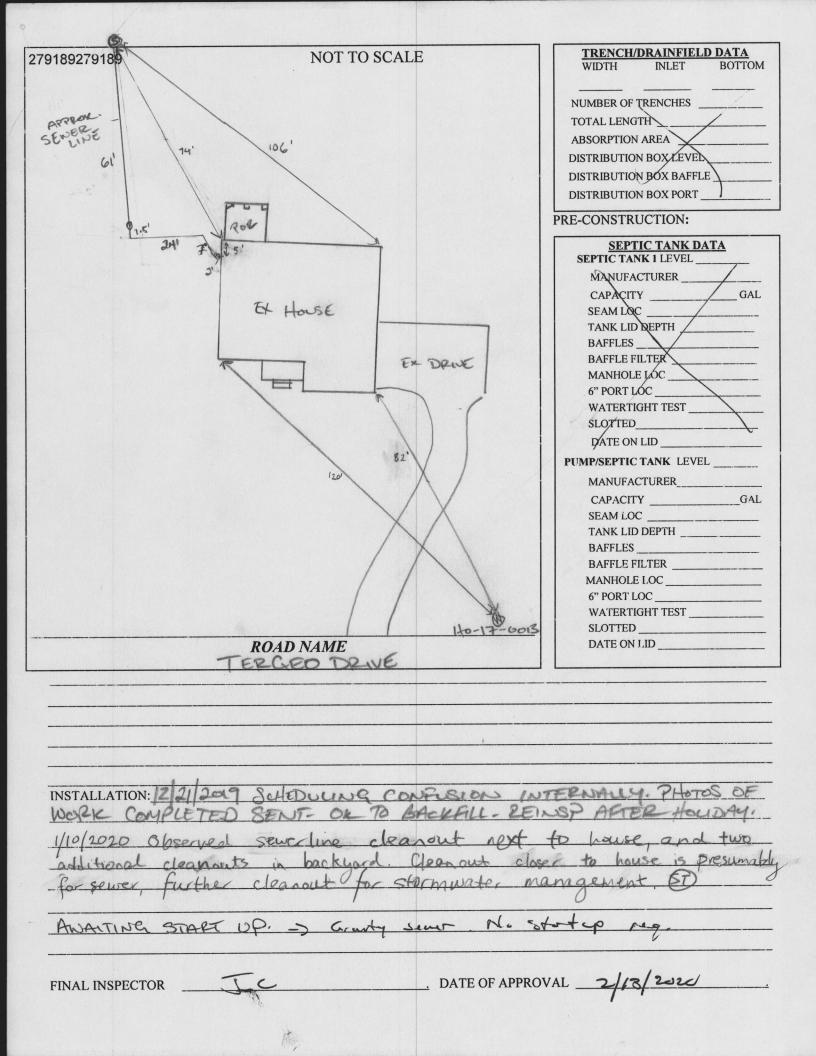

## Oswald, Hank

From:

Oswald, Hank

Sent:

Monday, September 30, 2019 7:53 AM

To:

**Tony Fertitta** 

Subject:

RE: Belvedere Lot 4 Health Signoff (B19002750)

Hi Tony:

The revised site plan now shows the same invert elevations out of the house (557.26) and at the grinder pit (557.26).

Hank

From: Tony Fertitta <tonyf@fcc-eng.com> Sent: Friday, September 27, 2019 2:46 PM

To: Oswald, Hank < hoswald@howardcountymd.gov> Subject: FW: Belvedere Lot 4 Health Signoff (B19002750)

[Note: This email originated from outside of the organization. Please only click on links or attachments if you know the sender.]

Any luck with this

From: Cagle, Clint < ccagle@nvrinc.com>

Sent: Wednesday, September 25, 2019 8:36 AM

To: Tony Fertitta < tonyf@fcc-eng.com >; Frank Manalansan II < frankm@fcc-eng.com > Cc: Cagle, Clint < ccagle@nvrinc.com >; Anastasia, James < janastas@nvrinc.com >

Subject: RE: Belvedere Lot 4 Health Signoff (B19002750)

Hi Tony & Frank,

Please see email chain below. Have not heard back from Dave.

Thanks,

Clint Cagle | NVHomes | 301-237-5776

From: Cagle, Clint

Sent: Wednesday, September 25, 2019 8:34 AM To: Dave Harward, III < DaveH@fcc-eng.com>

Cc: Anastasia, James < <u>janastas@nvrinc.com</u>>; Jim Kerwin (<u>jim@decaturbuildingservices.com</u>)

< iim@decaturbuildingservices.com >; frankm@fcc-eng.com

Subject: RE: Belvedere Lot 4 Health Signoff (B19002750)

Hi Dave,

I have not heard anything on this yet. Please let us know.

Thanks,

## **Clint Cagle** | NVHomes | 301-237-5776

From: Cagle, Clint

Sent: Monday, September 23, 2019 9:55 AM **To:** Dave Harward, III < <u>DaveH@fcc-eng.com</u>>

Cc: Anastasia, James < janastas@nvrinc.com >; Jim Kerwin (jim@decaturbuildingservices.com)

<jim@decaturbuildingservices.com>

Subject: RE: Belvedere Lot 4 Health Signoff (B19002750)

Hi Dave,

I hope you had a nice weekend. Any update on this being signed off by health?

Thanks,

**Clint Cagle** | NVHomes | 301-237-5776

From: Cagle, Clint

Sent: Thursday, September 19, 2019 11:15 AM To: Dave Harward, III < DaveH@fcc-eng.com> Cc: Anastasia, James < janastas@nvrinc.com>

Subject: Belvedere Lot 4 Health Signoff (B19002750)

Hi Dave,

Can you follow up with the health department to see what is going on with this signoff. It is the only approvale needed for the permit to be released.