

Name of Requestor: Transforming Architecture

Street Address: 7612 Browns Bridge Road

City, State, Zip: Highland, MD, 20777

Date: 02/21/2020

2nd

Amendment, Permit # B19004373

Ms. Debbie Whalen
Division of Plan Review
Department of Inspections, Licenses and Permits
Howard County Government
3430 Court House Dr
Ellicott City, MD 21043

Reunion
OK
DB

Dear Ms. Whalen:

I am requesting to amend Permit # B19004373 at

14050 Trudolph Road Glenelg, MD 21737 to
(Site Address)

add bathroom to fully finished basement addition,
change screen porch to enclosed 3 season room, and
add bathtub to master bath. This will be the 2nd
permit amendment that we have submitted.

Enclosed:

☒ Fee: _____

☒ Plot Plans

☒ Sets of Construction Drawings

Other: _____

If there is anything we can do to assist you, please let me know.

Sincerely,


CC: PIZ
Heath

Residential Reflections Arch, LLC
Invoice # 605804
CK # 3736
paid

Name: Taina Peters

Title: Architectural designer

Phone and/or Email: 301 776 2166

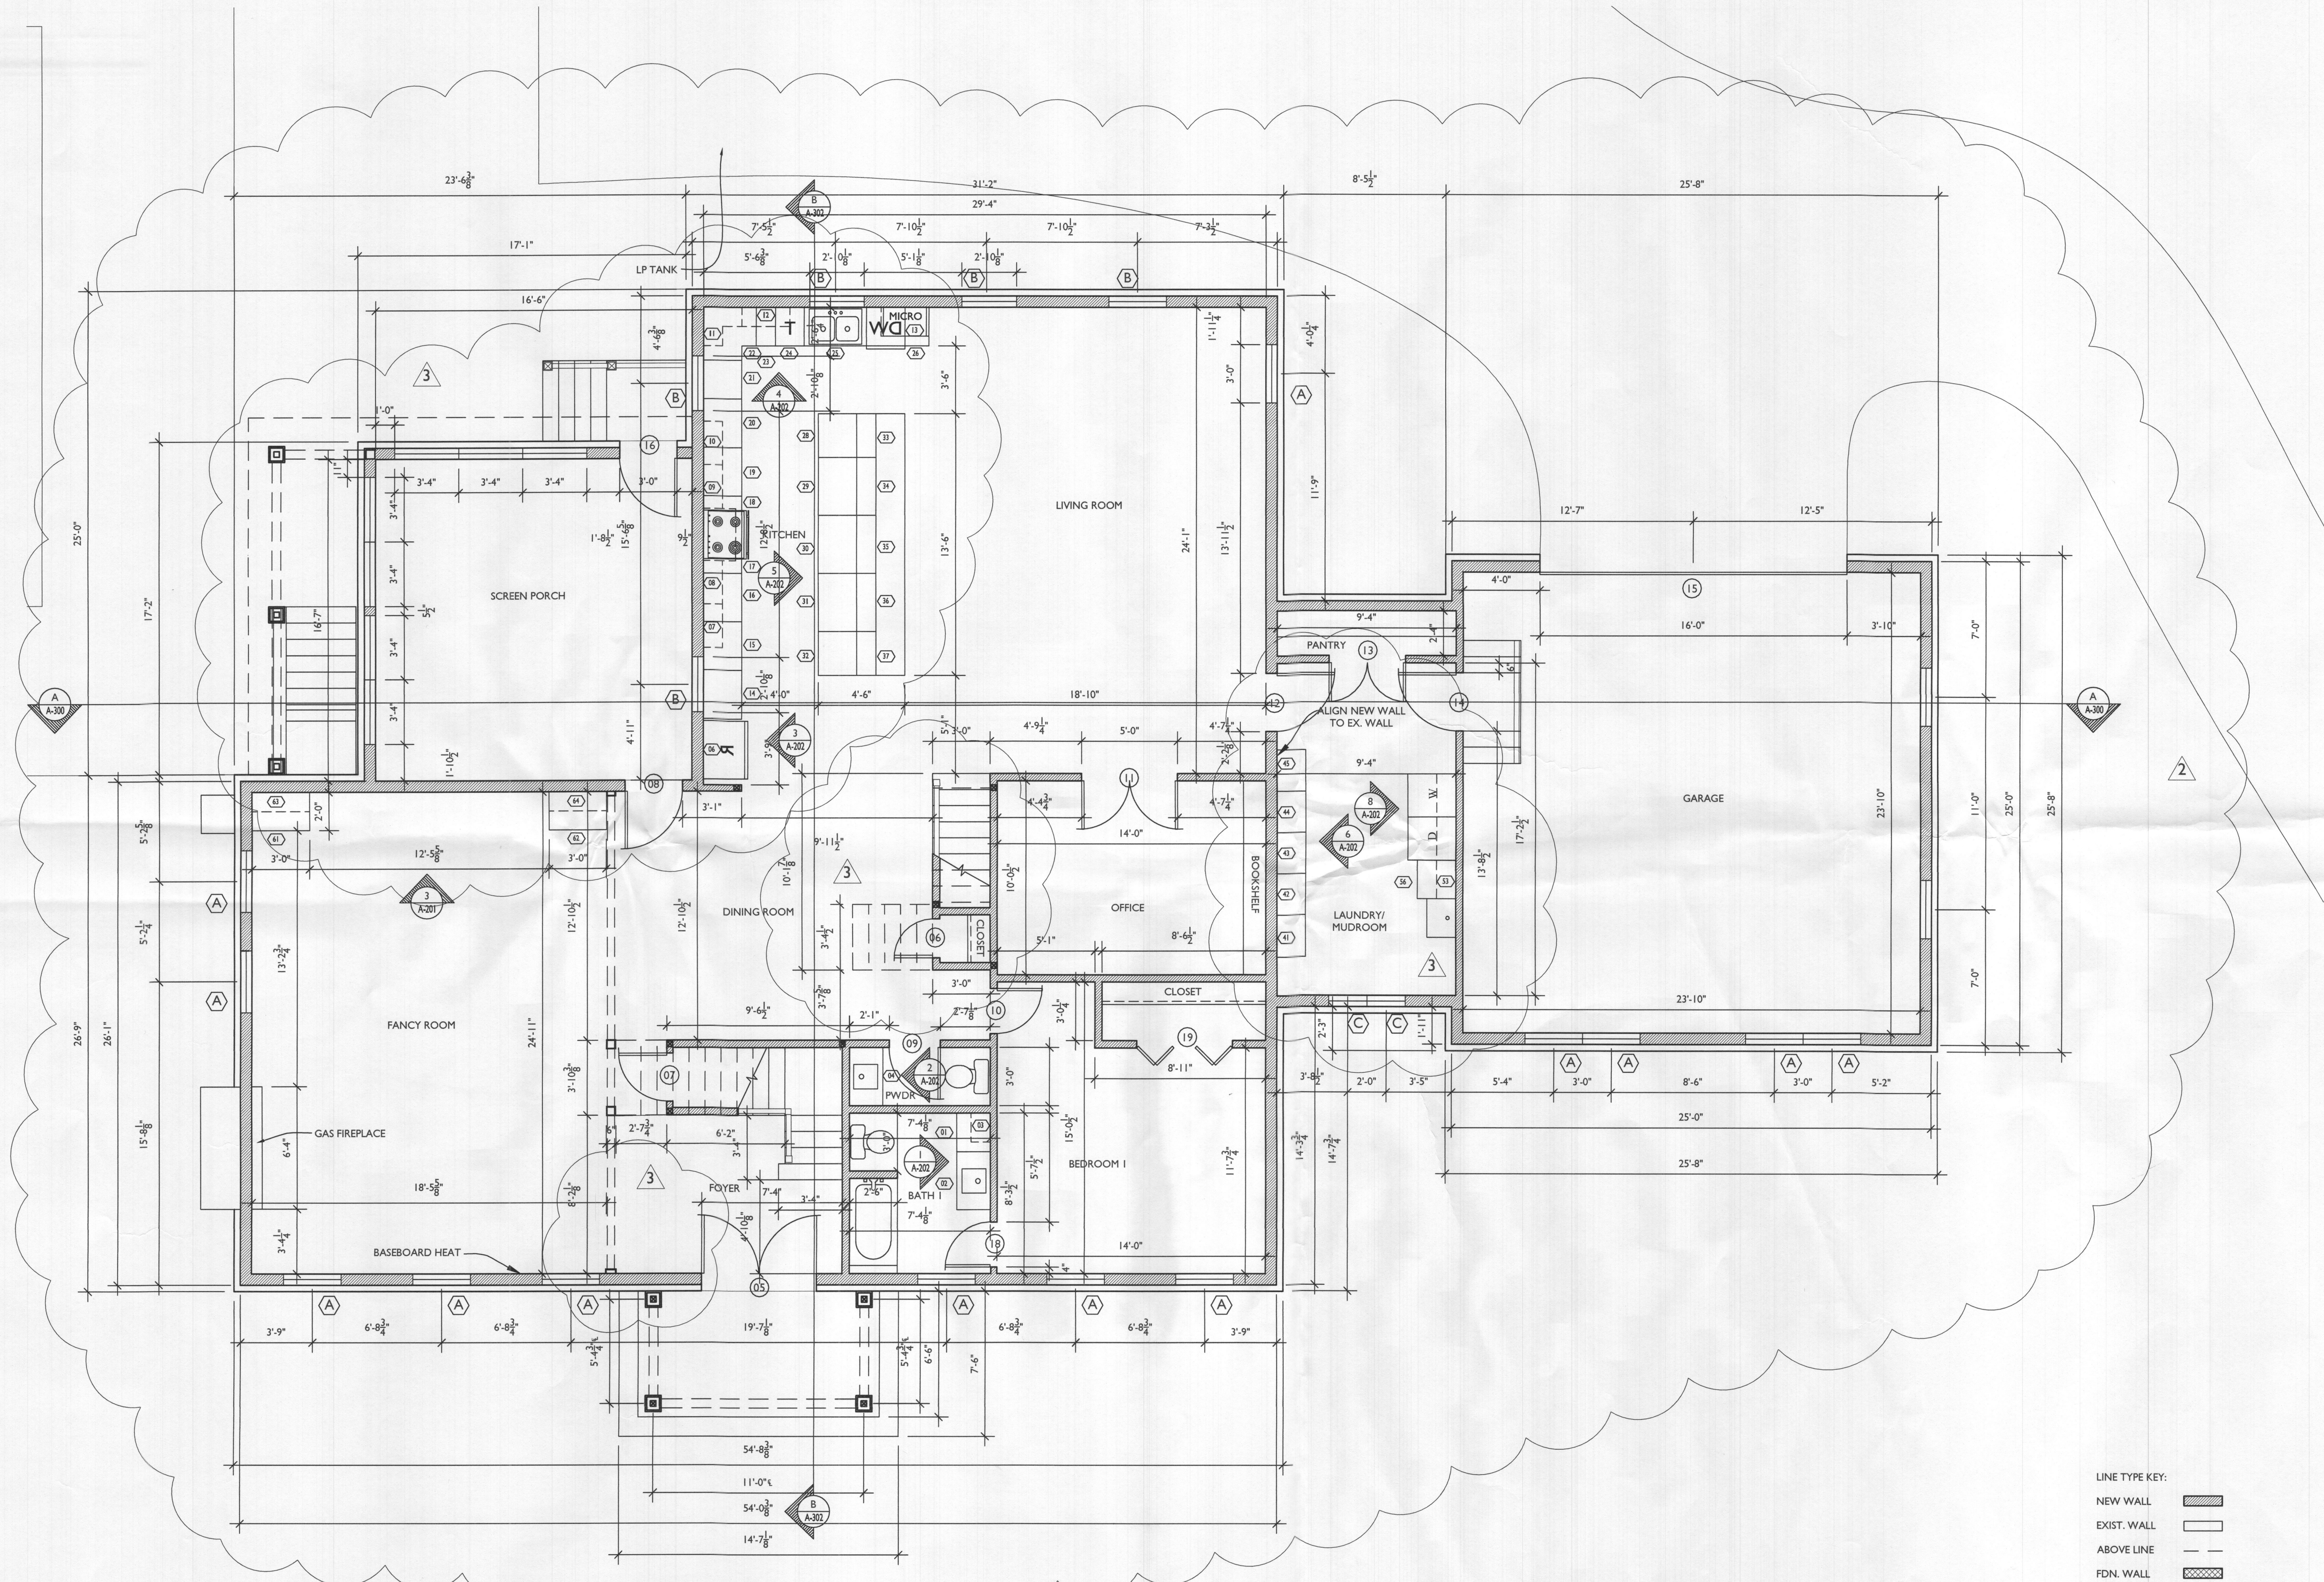

FIRST FLOOR PLAN
SCALE: 1/4"=1'-0"



7612 Browns Bridge Road
Highland, MD 20777
301-776-2666
301-776-2886 fax
info@TransformingArchitecture.com
www.TransformingArchitecture.com



STAMP
I CERTIFY THAT THESE DOCUMENTS WERE PREPARED OR APPROVED BY ME, AND THAT I AM A DULY LICENSED ARCHITECT UNDER THE LAWS OF THE STATE OF MARYLAND, LICENSE NUMBER 13662, EXPIRATION 10-22-2021.
NOTE: THESE DRAWINGS ARE THE PROPERTY OF TRANSFORMING ARCHITECTURE AND, AS SUCH, MAY NOT BE RE-USED OR REPRODUCED, EITHER WHOLLY OR IN PART, WITHOUT PRIOR WRITTEN CONSENT OF TRANSFORMING ARCHITECTURE.

PROJECT PHASE
PERMIT REVISION


PROJECT TITLE
THE OGUNMEFUN RESIDENCE
14050 Triadelphia RD
Glenelg, MD 21737

REVISIONS		
SYMBOL	DATE	ISSUED FOR
1	08-23-2019	PERMIT REVISION 1
2	12-27-2019	PERMIT AMENDMENT
3	02-21-2020	PERMIT AMENDMENT 2

PROJECT NUMBER 17-320
DATE 02/21/2020
SCALE AS NOTED

DRAWING TITLE
FIRST FLOOR PLAN


SHEET NUMBER
A-101

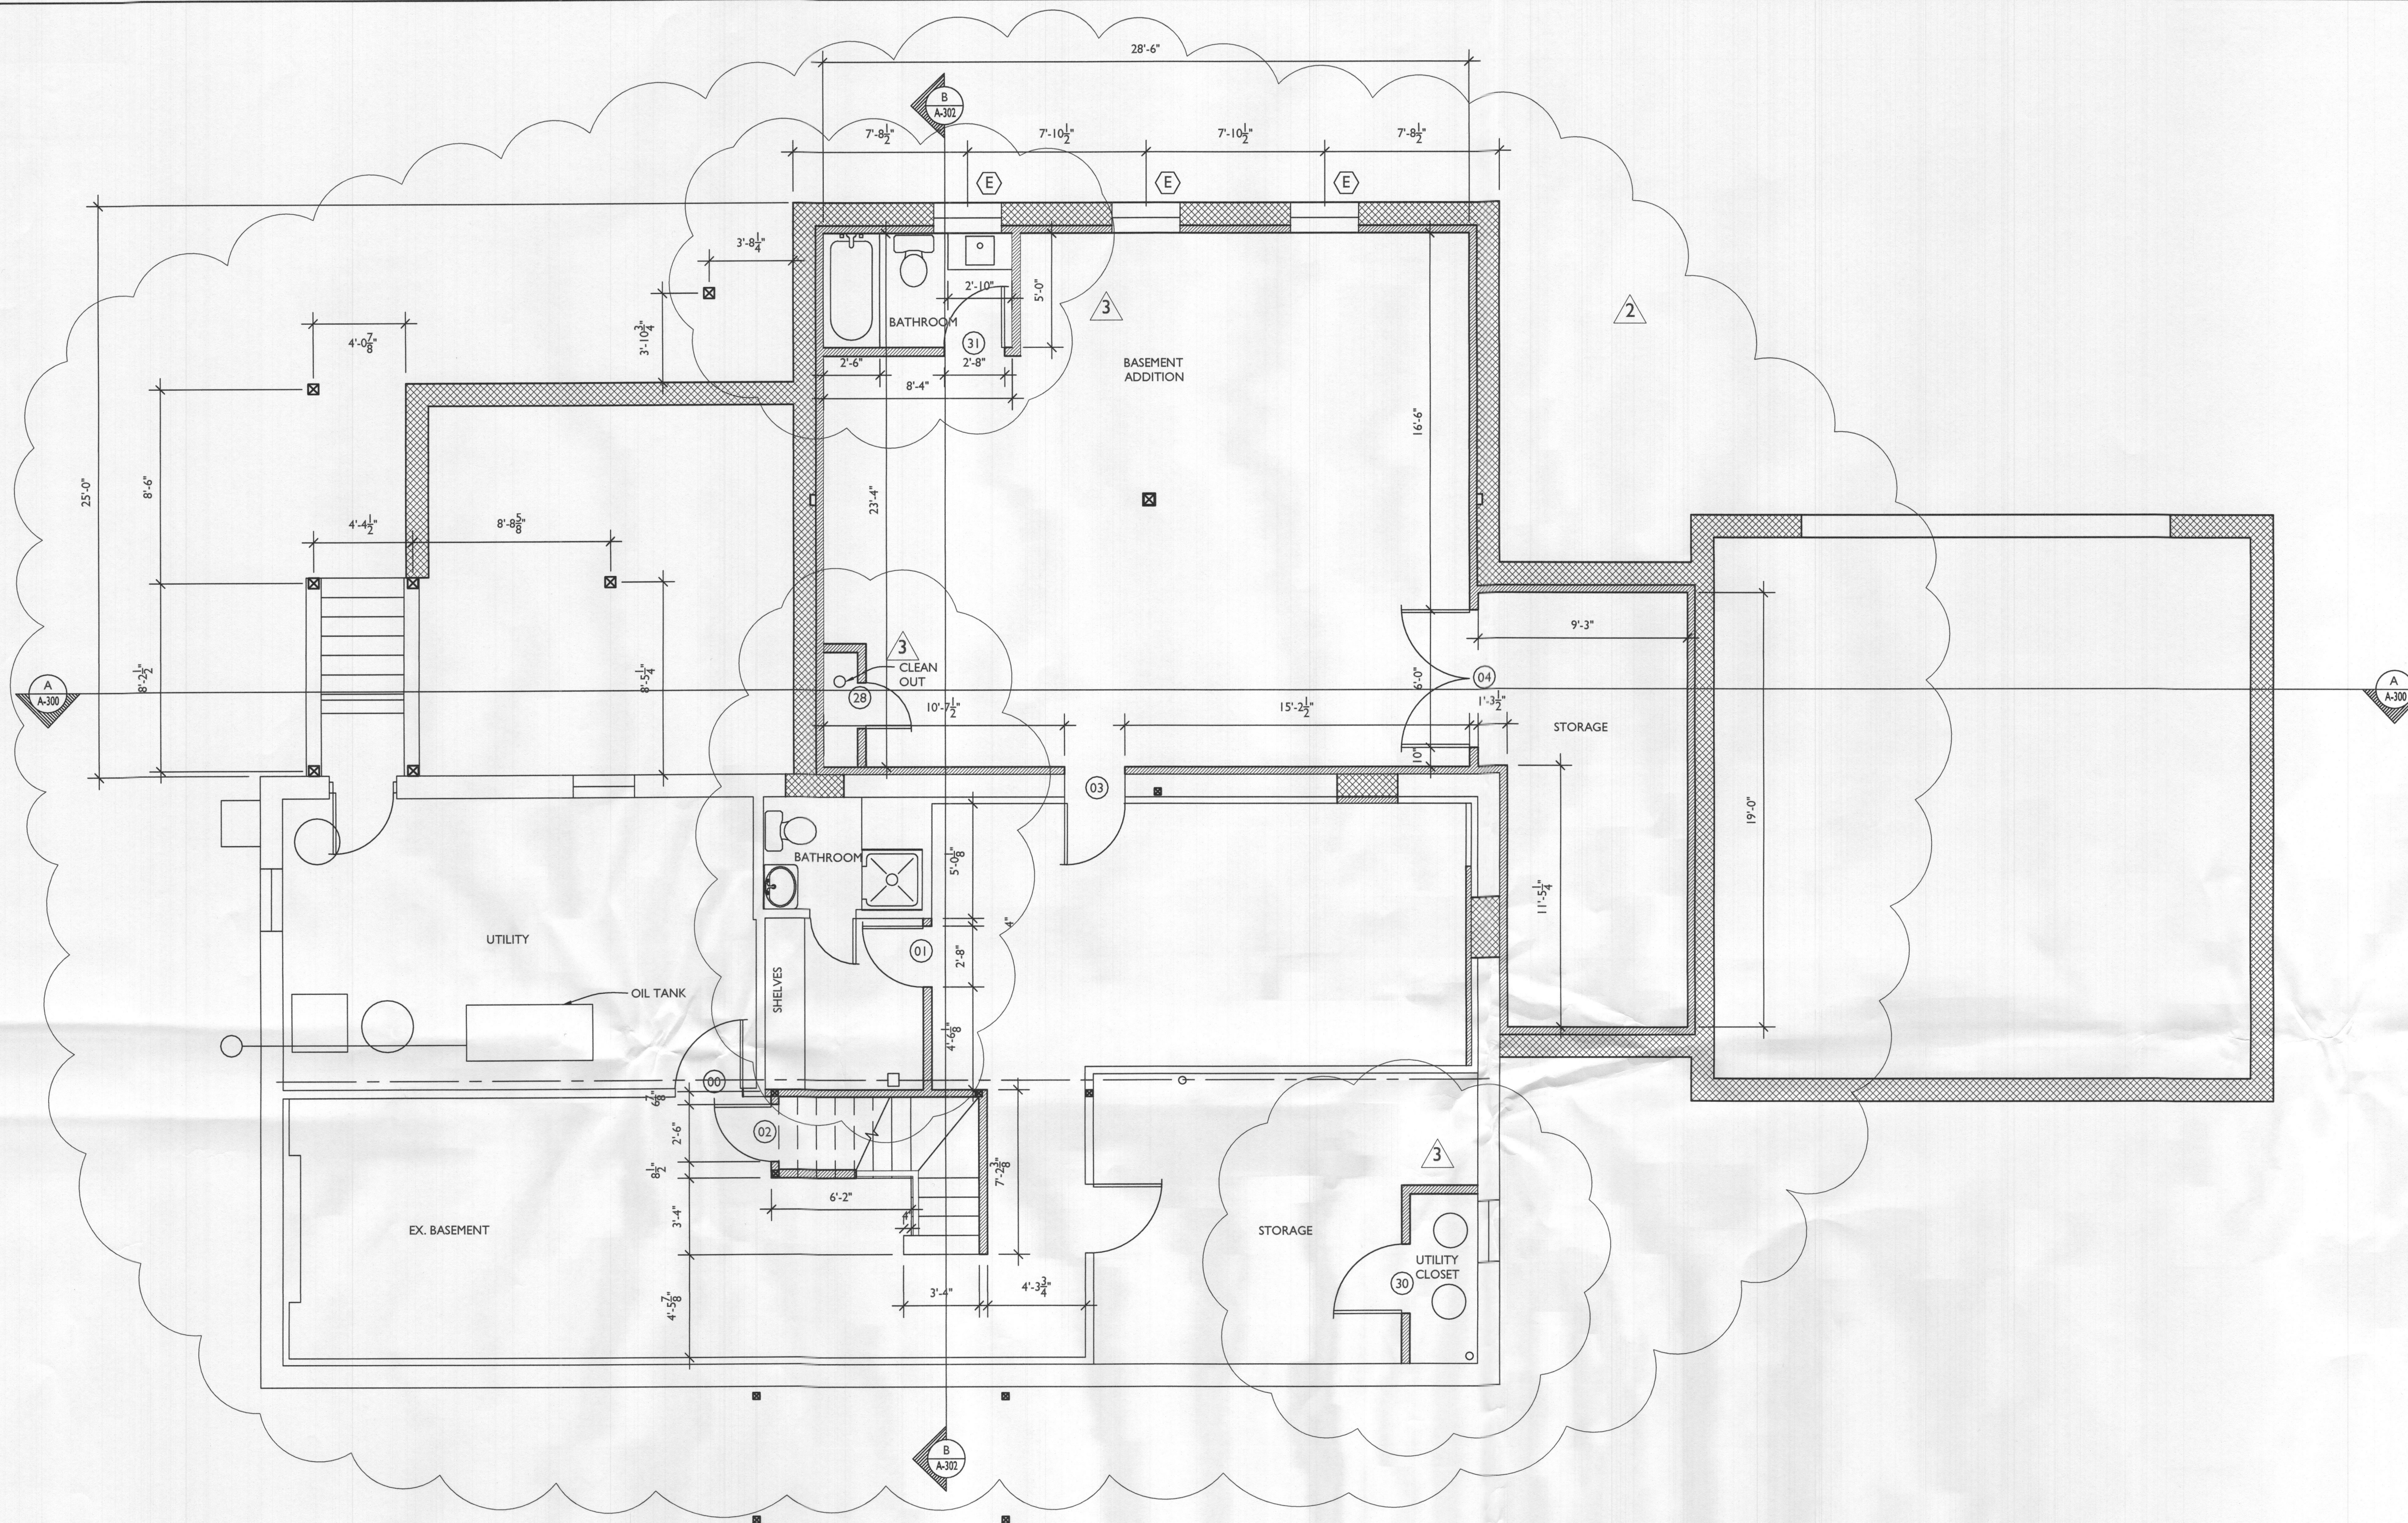

LINE TYPE KEY:
NEW WALL
EXIST. WALL
ABOVE LINE
FDN. WALL



7612 Browns Bridge Road
Highland, MD 20777
301-776-2666
301-776-2886 fax
info@TransformingArchitecture.com
www.TransformingArchitecture.com

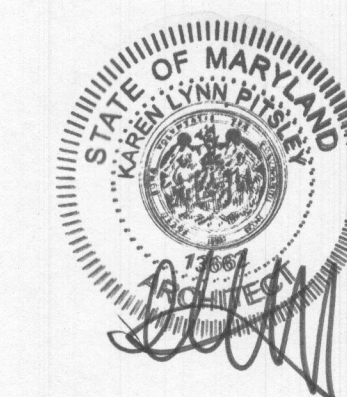

STAMP

I CERTIFY THAT THESE DOCUMENTS WERE PREPARED OR APPROVED BY ME, AND THAT I AM A DULY LICENSED ARCHITECT UNDER THE LAWS OF THE STATE OF MARYLAND, LICENSE NUMBER 13662, EXPIRATION 10-22-2021.

NOTE: THESE DRAWINGS ARE THE PROPERTY OF TRANSFORMING ARCHITECTURE AND, AS SUCH, MAY NOT BE RE-USED OR REPRODUCED, EITHER WHOLLY OR IN PART, WITHOUT PRIOR WRITTEN CONSENT OF TRANSFORMING ARCHITECTURE.

PROJECT PHASE

PERMIT
REVISION

PROJECT TITLE

THE
OGUNMEFUN
RESIDENCE

14050 Triadelphia RD
Glenelg, MD 21737

REVISIONS

SYMBOL	DATE	ISSUED FOR
1	08-23-2019	PERMIT REVISION 1
2	12-27-2019	PERMIT AMENDMENT
3	02-21-2020	PERMIT AMENDMENT 2

PROJECT NUMBER 17-320

DATE 02/21/2020

SCALE AS NOTED

DRAWING TITLE

FLOOR
PLAN

SHEET NUMBER

A-103

BASEMENT
PLAN
SCALE: 1/4"=1'-0"