

Approved 8.4.2020

- H.O.

Menu Save Reset Cancel Help

Record Detail * (This section is required.)

Permit Type	Permit Number	Opened Date
Building/Residential/Misc/Tanks	B20002059	07/02/2020
Description of Work		
SFD/ install (1) 500 gallon underground propane tank and connect to stub out on house per NFPA'58		

check spelling

Address * (This section is required.)

Search Reset Clear Get Parcel & Owner

Street #	Street Name	Street Type	
11111	WILLOW GREEN	WAY	
Unit Type	Unit #	X Coordinate	Y Coordinate
--Select--		-76.90105	39.31872
City	State	Zip Code	Primary
MARRIOTTSVILLE	MD	21104	Yes

Parcel * (This section is required.)

Search Reset Clear Get Address & Owner

GIS ID *	Parcel	Parcel Area	Land Value	Improved Value	Exemption Value	Plan Area
910071	326	1.14	246800	831600	584800	RURAL
Legal Description						
IMPSLOT 1 1.14 A[]11111 WILLOW GREEN WAY[]WOODFORDS GRANT III RSB						

check spelling

Block	Lot	Census Tract	Council Dist	Inspection Dist	Supervisor Dist	Map #	DAP Zone
	1	603000	5				
Plan Area	State Tax Id	Subdivision Name					
	1403331385	WOODFORDS GRANT III					
Section	Area	Tax Map					
		10					
Grid	Zoning District	ADC Map					
10-22	RC-DEO	4694-F10					
SDP No.	Final Plan No.	WP File No.					
	S-98-004						
Record Plat No.	WS Contract No.	FDP No.	Primary				
13801			Yes				
Owner Occupied	Year Built	Historic District					
<input type="radio"/> Yes <input type="radio"/> No	2000	<input type="radio"/> Yes <input checked="" type="radio"/> No					
Historic District Registry No.	Stat Area	Flood Plain					
	3-02A	<input type="radio"/> Yes <input checked="" type="radio"/> No					
Building No							

Owner * (This section is required.)

Search Reset Clear

Name *
 WISE TROY D
Address Line 1
 11111 WILLOW GREEN WAY
Address Line 2

Address Line 3

Mail City **Mail State** **Mail Zip Code**
 MARRIOTTSVILLE MD 21104
Phone **Primary**
 410-382-7956 Yes
E-mail

Cell Number **Fax Number**

Professionals (This section is not required.)

Search Reset Clear

License # * **Business Name**
 20100079809 AERO ENERGY
License Type * **First Name** **Middle Name** **Last Name**
 Propane Gs 3ICHARD THOMAS JARCY
Primary **Address Line 1**
 Yes 230 LINCOLN WAY EAST
Address Line 2

City **State** **ZIP Code**
 NEW OXFORD PA 17350-0000
Phone 1 **Phone 2** **Fax**
 2406744592 _____ 3016620709
E-mail
 RJARCY@AEROENERGY.COM

Applicant (This section is not required.)

Search As Owner As Lic. Prof As Contact

Type * **First Name** **MI** **Last Name**
 Applicant steve dannenfeldt
Relationship **Full Name**
 --Select-- steve dannenfeldt
Primary **Organization Name**
 Yes Aero Energy
Street Address
 230 lincoln way East
Address Line 2

City **State** **Zip Code**
 New Oxford PA 17350
Phone **Cell** **Fax**
 717-577-5923 _____ _____
E-mail *
 sdannenfeldt@aeroenergy.com

Addtl Info

Est Construction Cost *	Housing Units *	Number of Buildings *	Public Owned
3000	0	0	No
Construction Type			
--Select--			

TANK INFORMATION

RESIDENTIAL TANK INFORMATION

Capital Project-No Fee *	Capital Project Number	Fee Exempt *	Roadside Tree Project Permit *	Roadside Tree Permit #
<input type="radio"/> Yes <input checked="" type="radio"/> No		<input type="radio"/> Yes <input checked="" type="radio"/> No	<input type="radio"/> Yes <input checked="" type="radio"/> No	
Existing Use	Number of Tanks Installed *	Number of Tanks Removed *		
SFD	1	0		
Water Supply	Sewage Disposal	Expiration Date	Relocate Existing Tank *	
Private	Private	1/2/2021	0	

PAYMENT INFORMATION

Check 1	Payee 1	Check 2	Payee 2	SAP Doc No	SAP Entered

Submit Cancel

PLOT PLAN

Application Number

OWNER Troy Wise

ADDRESS 1111 Willow Green Way Marriottsville MD 21104

PLEASE SHOW BELOW:

- Property line dimensions and easements;
- Existing buildings;
- Existing well/septic; (show distance to nearest structure)
- Road names and location of alleys;
- If your property is in a tidal or riverine flood area, indicate elevation of lowest floor of proposed work.
- The proposed work and the setback distances to the proposed work.


Front Setback 88

Left Setback 18

Rear Setback 136

Right Setback 87

NOTE: Cannot fence access easement.

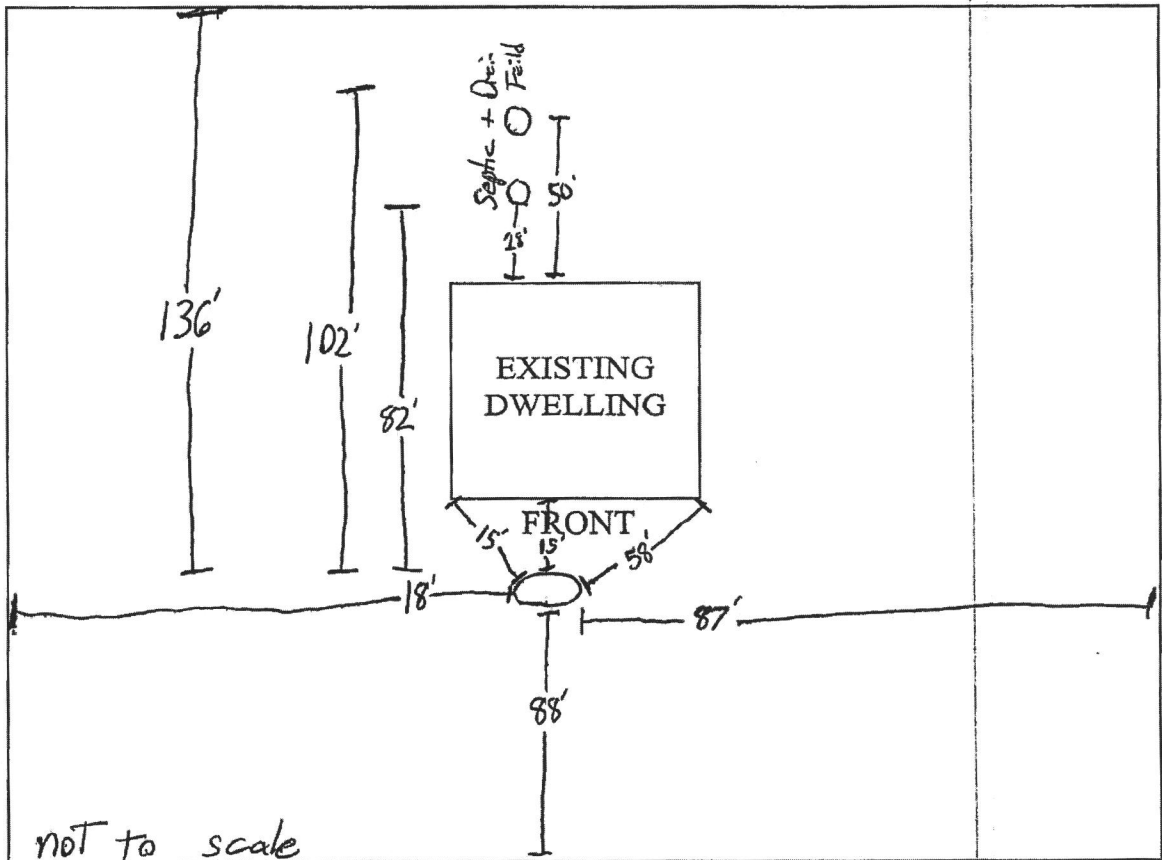

ROAD NAME Willow Green Way

Owner

Troy Wise

410-382-7956

Contractor

Aero Energy

David Smith

717-542-0894

717-577-5787

* Public Water

no well

500 Gallon

Underground Propane

Tank

LP Tank to septic

Tank

83.5'

LP Tank to Septic

Field

103.5'

LP Tank Front

Setback

88'

LP Tank Rear

Setback

136'

LP Tank left

side setback

18'

LP Tank Right

setback

87'

LP Tank to Left

Corner of Home

15'


LP Tank to Right

Corner of Home

58'

11111 Willow Green Way Marriottsville MD 21104

Account # 331385 District 3

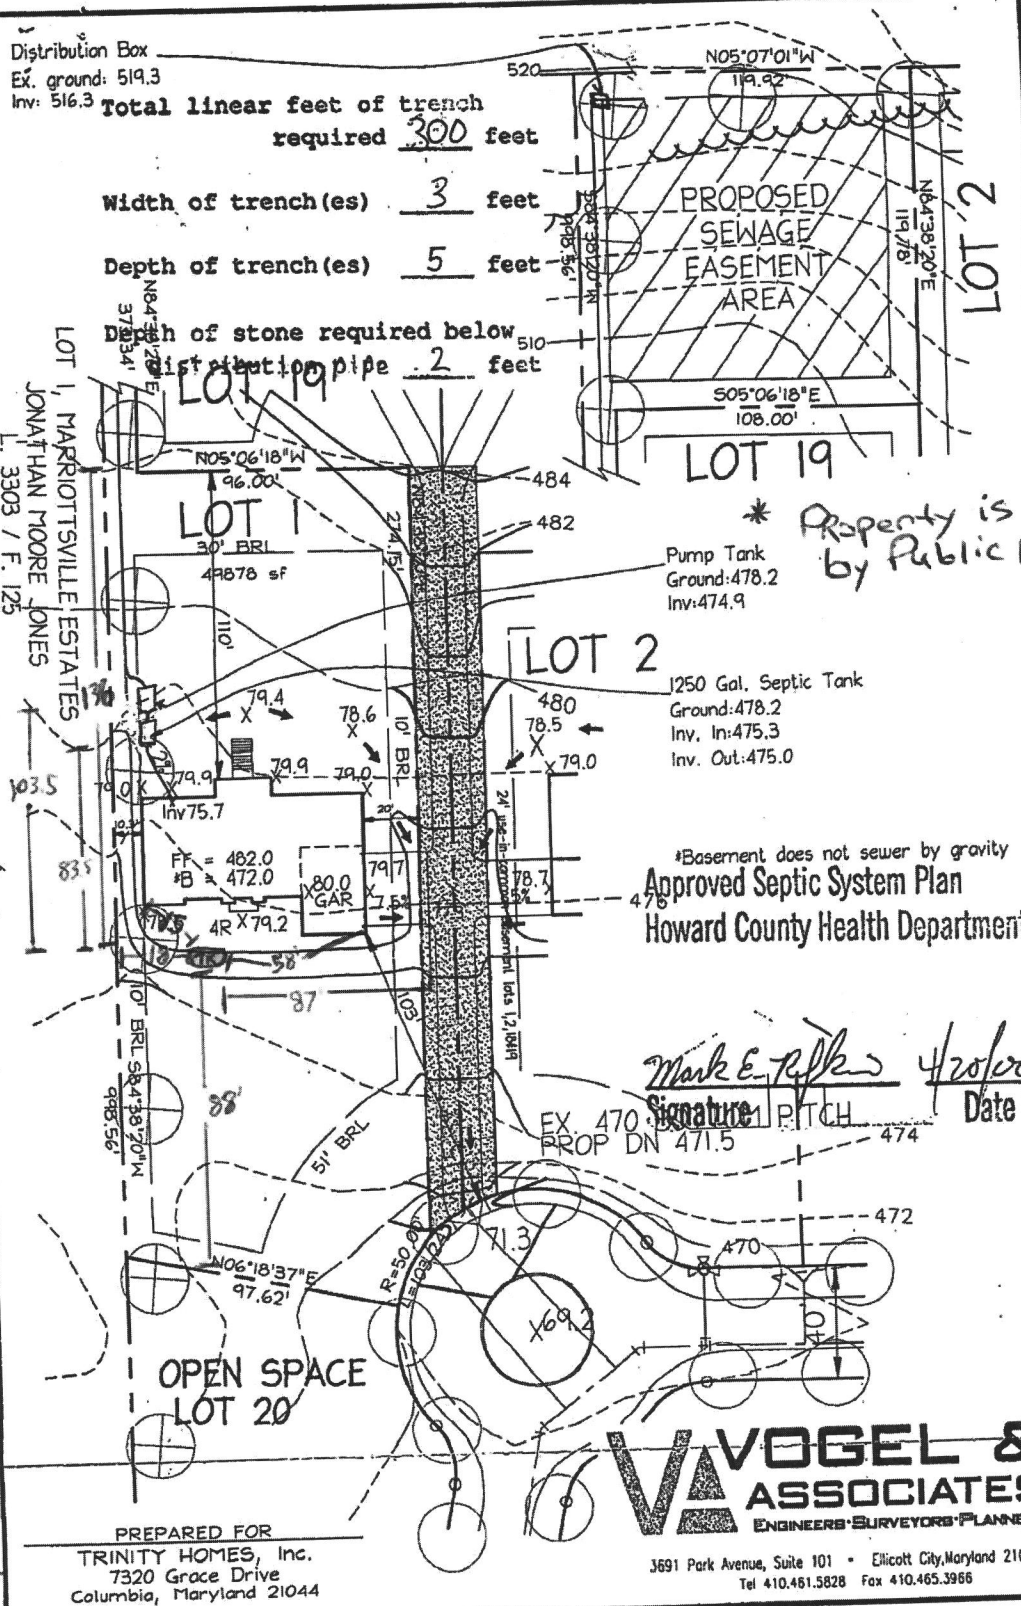

* Property is served by Public Water.

*Basement does not sewer by gravity
Approved Septic System Plan
Howard County Health Department

Mark E. Pritch
Signature
Date 4/20/00

VOGEL & ASSOCIATES
ENGINEERS SURVEYORS PLANNERS

3691 Park Avenue, Suite 101 - Ellicott City, Maryland 21043
Tel 410.461.5828 Fax 410.465.3966

PREPARED FOR
TRINITY HOMES, Inc.
7320 Grace Drive
Columbia, Maryland 21044

SCALE 1"=50'
DRAWN BY MM
CHECKED BY JCO
DATE April 19, 2000
W. O. # 98-097

PLOT PLAN
LOT 1
WOODFORDS GRANT III

TAX MAP 10 BLOCK 22 REFERENCE PLAT'S 13600-13602
PARCEL 293 3rd ELECTION DISTRICT HOWARD COUNTY, MARYLAND

c:\Land Projects\98-097\dwg\8021lot1.dwg-mm 04.19.00

GP. 99-209

Oswald, Hank

From: Oswald, Hank
Sent: Tuesday, July 7, 2020 8:17 AM
To: Steve Dannenfeldt
Subject: FW: B20002059_11111 Willow Green Way_500 Gallon UPT
Attachments: 11111 wgw.pdf

Hi Steve:

Good morning. You may use page 6 of this document (attachment) for your plot plan. Please be sure it prints to scale before adding in what you need to. You could also add a note that the property is served by public water. Please be sure that your information is on there too.

Let me know if you have any questions.

Thanks,

Hank

From: Oswald, Hank <hoswald@howardcountymd.gov>
Sent: Monday, July 6, 2020 3:25 PM
To: Steve Dannenfeldt <sdannenfeldt@aeroenergy.com>
Subject: Re: B20002059_11111 Willow Green Way_500 Gallon UPT

Hi Steve:

The plot plan must be draw to an appropriate scale between 1:30 to 1:100. The site plan must include the following:

- 1.) Identification of the property
- 2.) Name, address and contact information of the owner and person preparing the plan.
- 3.) Existing property lines
- 4.) Location of the existing septic system (i.e. septic tank, trench, SDA etc.).
- 5.) Location of the existing well.
- 5.) All existing structures.

For a copy of the existing septic record, please visit Howard County Health Department Website/Bureau of Environmental Health/Well & Septic Program/Public File Search. Should you have any questions, please don't hesitate to ask.

Respectfully,

Hank

From: Steve Dannenfeldt <sdannenfeldt@aeroenergy.com>
Sent: Monday, July 6, 2020 3:05 PM

To: Oswald, Hank <hoswald@howardcountymd.gov>
Subject: RE: B20002059_11111 Willow Green Way_500 Gallon UPT

[Note: This email originated from outside of the organization. Please only click on links or attachments if you know the sender.]

Here are the attachment. I am not sur how to send an ecopy of the app. It is online in your system

From: Oswald, Hank [<mailto:hoswald@howardcountymd.gov>]
Sent: Monday, July 6, 2020 2:44 PM
To: Steve Dannenfeldt <sdannenfeldt@aeroenergy.com>
Subject: B20002059_11111 Willow Green Way_500 Gallon UPT

Hi Steve:

Please also forward an e-copy of the BP application and plot plan for B20002059 (11111 Willow Green Way), so I can take a look at it from home today.

Thanks,

Hank

Hank Oswald
Howard County Health Department
Well and Septic Program