

Approved 8/25/20 - H.O.

Menu Save Reset Cancel Help

Record Detail * (This section is required.)

Permit Type	Permit Number	Opened Date
Building/Residential/Misc/Pool Spa	B20002720	08/19/2020
Description of Work		
SFD/ Install 39 x 20' in ground, gunite swimming pool depth - 3 -7'		

[check spelling](#)

Address * (This section is required.)

Search Reset Clear Get Parcel & Owner

Street #	Street Name	Street Type
13960	WEeping CHERRY	DR
Unit Type	Unit #	X Coordinate
--Select--		-76.99993
		39.30941
City	State	Zip Code
WEST FRIENDSHIP	MD	21794
	Primary	
	Yes	

Parcel * (This section is required.)

Search Reset Clear Get Address & Owner

GIS ID *	Parcel	Parcel Area	Land Value	Improved Value	Exemption Value	Plan Area
906910	52	1.18	226800	614200	387400	RURAL
Legal Description						
IMPSLOT 6 1.1873 A[]13960 WEeping CHERRY DR[]MCKENDREE OVERLOOK						

[check spelling](#)

Block	Lot	Census Tract	Council Dist	Inspection Dist	Supervisor Dist	Map #	DAP Zone
	6	605601	5				
Plan Area	State Tax Id	Subdivision Name					
	1404363353	MCKENDREE OVERLOOK					
Section	Area	Tax Map					
		15					
Grid	Zoning District	ADC Map					
15-1	RC-DEO	4812-K1					
SDP No.	Final Plan No.	WP File No.					
Record Plat No.	WS Contract No.	FDP No.					
14058							
Owner Occupied	Year Built	Historic District					
☐ Yes ☐ No	2000	☐ Yes ☒ No					
Historic District Registry No.	Stat Area	Flood Plain					
	4-06	☐ Yes ☒ No					
Building No							

Owner * (This section is required.)

Search Reset Clear

Name *

RUSSALESI MICHAEL E

Address Line 1

13960 WEEPING CHERRY DR

Address Line 2**Address Line 3****Mail City**

GLENWOOD

Mail State

MD ▼

Mail Zip Code

21738

Phone

410-917-1141

Primary

Yes ▼

E-mail

melli5146@yahoo.com

Cell Number**Fax Number****Professionals** (This section is not required.)

Search Reset Clear

License # *

08010016659

Business Name

ROWAN'S LANDSCAPE COMPANY INC

License Type *

MHIC Ind ▼

First Name

TIMOTHY

Middle Name**Last Name**

ROWAN

Primary

Yes ▼

Address Line 1

16643 FREDERICK ROAD

Address Line 2**City**

MT. AIRY

State

MD

ZIP Code

21771-0000

Phone 1

4104890707

Phone 2**Fax**

301-703-4066

E-mail

KARI@ROWANLANDSCAPE.COM

Applicant (This section is not required.)

Search As Owner As Lic. Prof As Contact

Type *

Applicant ▼

First Name

CHELSEA

MI**Last Name**

TREVEY

Relationship

Applicant ▼

Full Name

CHELSEA TREVEY

Primary

Yes ▼

Organization Name

ROWAN LANDSCAPE AND POOL CO. INC.

Street Address

16643 FREDERICK ROAD

Address Line 2**City****State****Zip Code**

MT. AIRY		MD	21771
Phone	Cell	Fax	
410-489-0707			
E-mail *			
OFFICE@ROWANLANDSCAPE.COM			

Addtl Info

Est Construction Cost *	Housing Units *	Number of Buildings *	Public Owned
50000	0	0	No
Construction Type			
--Select--			

POOL INFORMATION

MISCELLANEOUS POOL INFORMATION


Capital Project-No Fee *	Capital Project Number	Fee Exempt *	Water Supply *	Sewage Disposal *
☐ Yes ☒ No		☐ Yes ☒ No	Private	Private
Existing Use	Type of Pool or Spa *	Electrical Permit Number	Expiration Date	
SFD	In Ground Pool		2/17/2021	

PAYMENT INFORMATION

Check 1	Payee 1	SAP Doc No	SAP Entered

Submit

Cancel

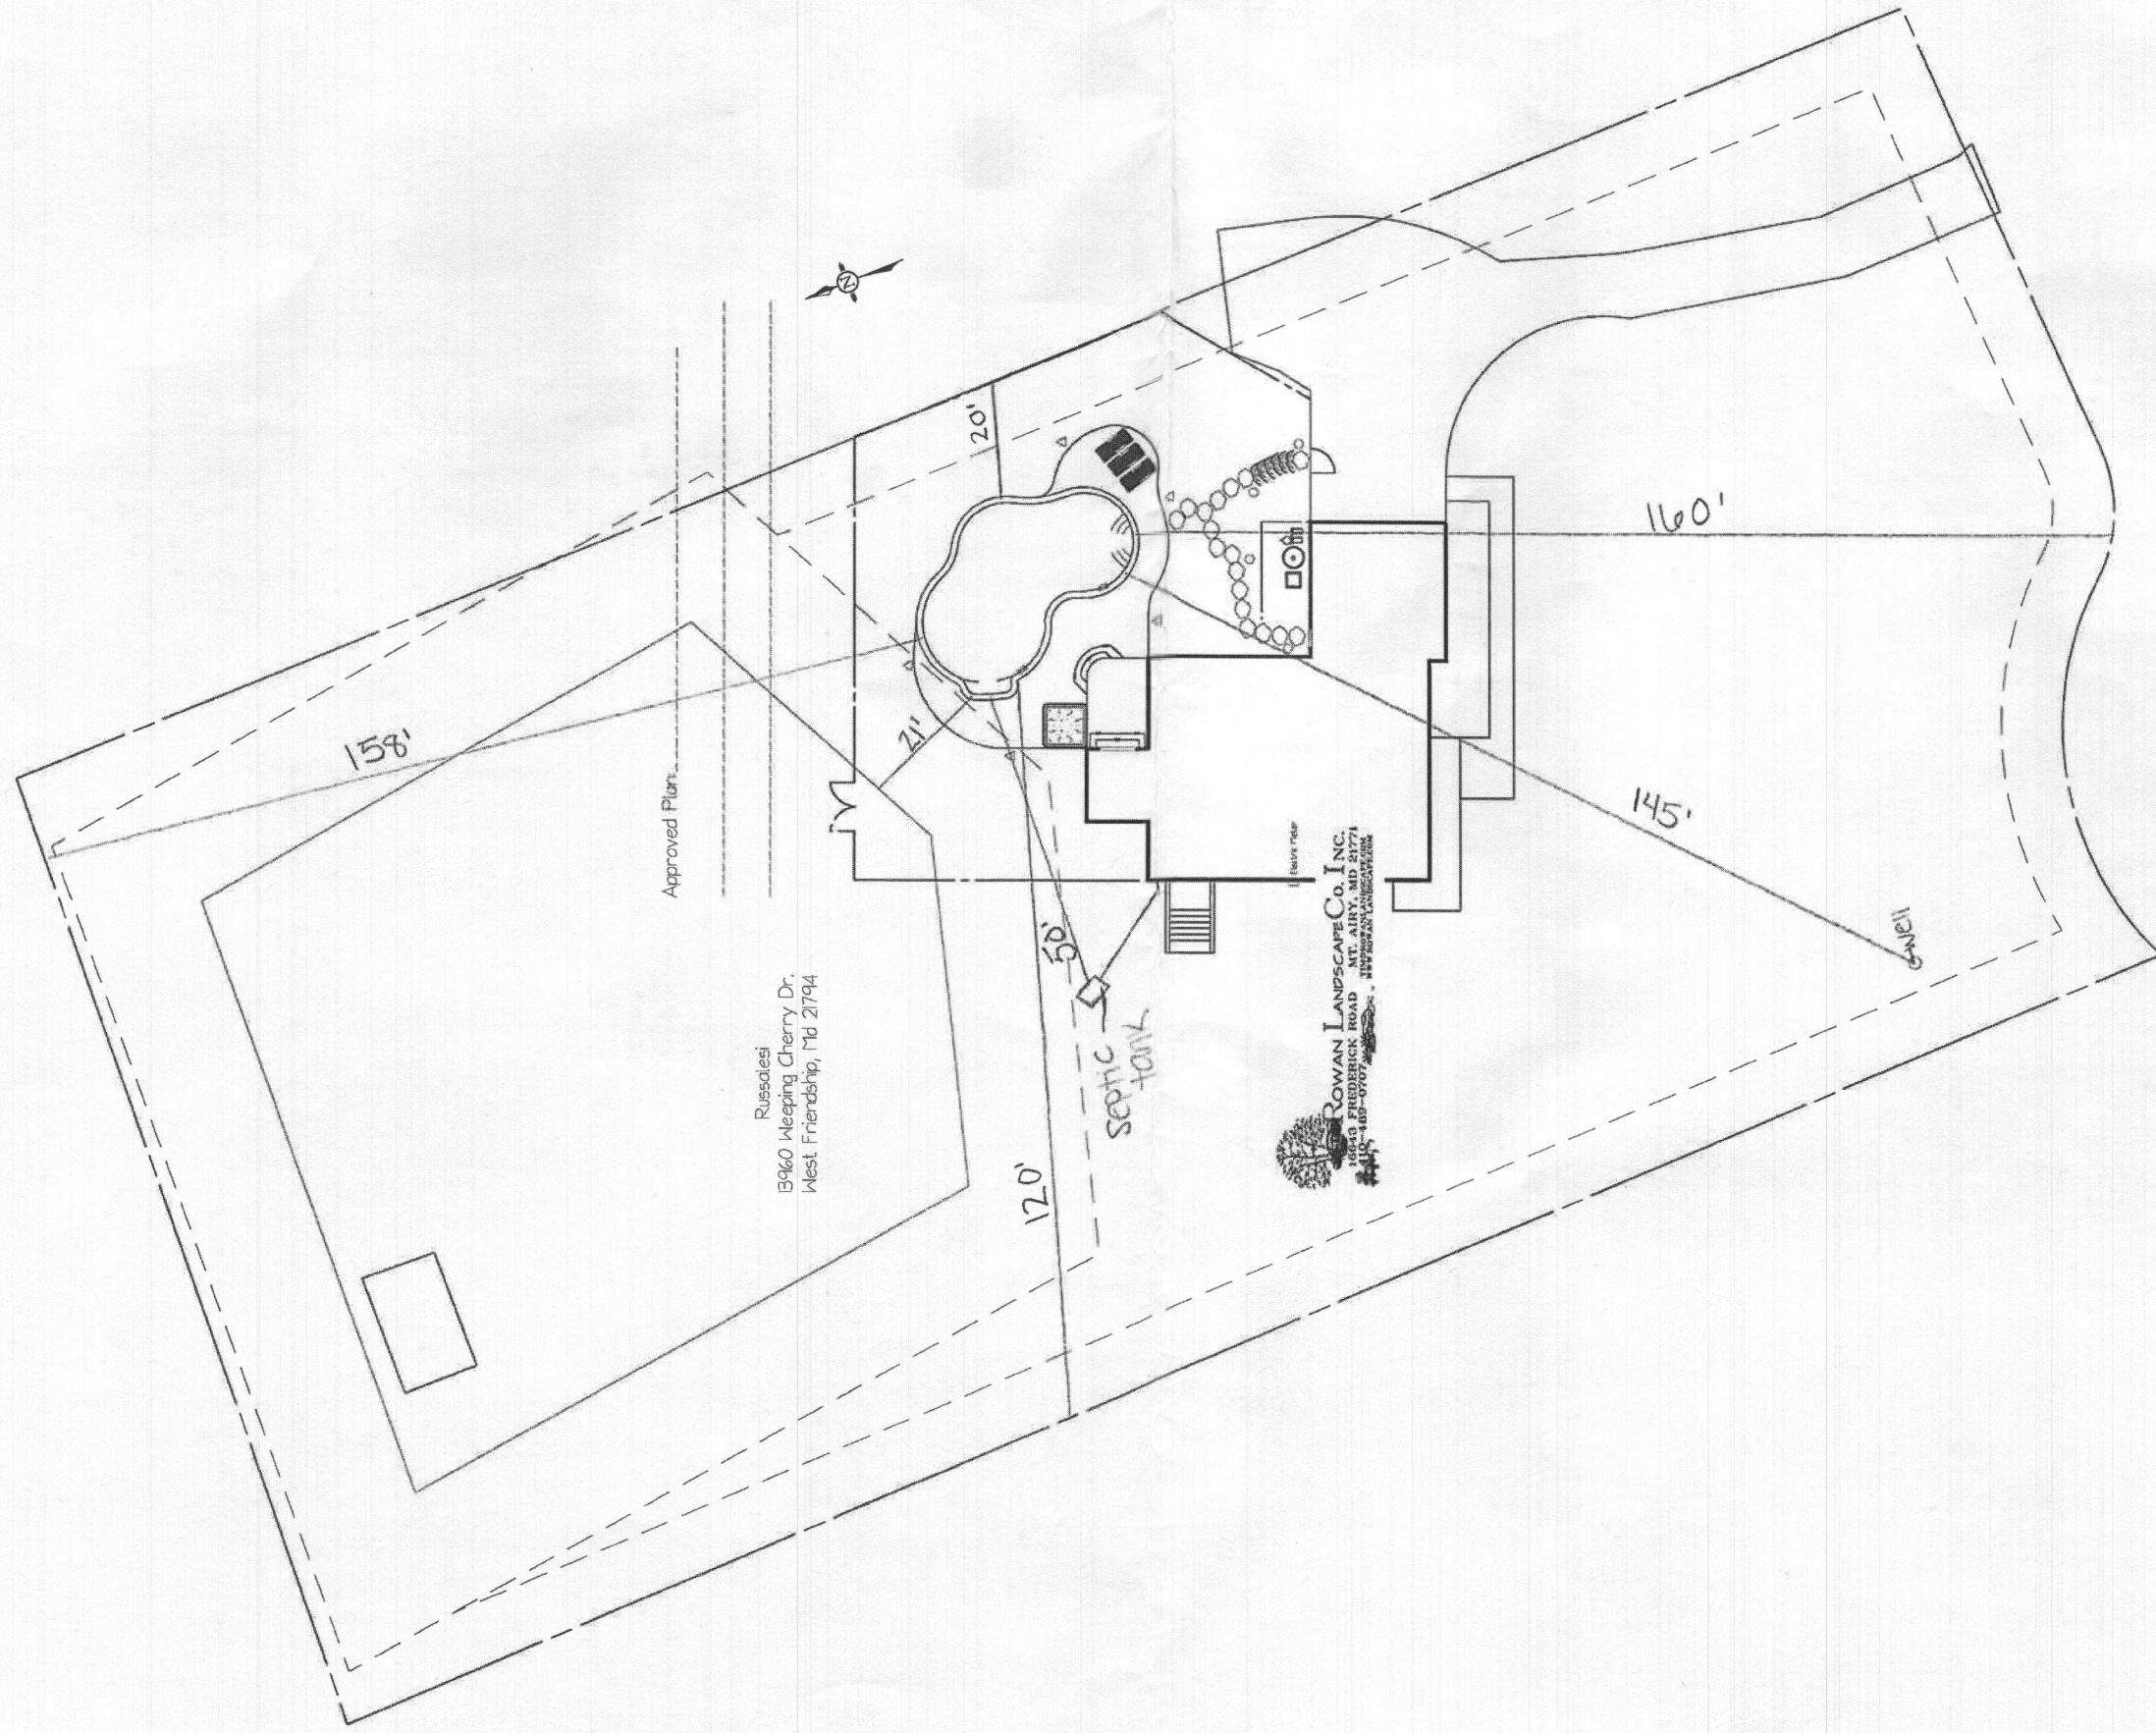

Scale 1" = 30'