

Approved 8/14/2020

N.O.

Menu Save Reset Cancel Help

Record Detail * (This section is required.)

Permit Type	Permit Number	Opened Date
Building/Residential/Misc/Tanks	B20002186	07/13/2020
Description of Work		
SFD/Install 1000 gallon underground propane tank and connect to stub out on house per NFPA'58		

check spelling

Address * (This section is required.)

Search Reset Clear Get Parcel & Owner

Street #	Street Name	Street Type	
1735	UNDERWOOD	RD	
Unit Type	Unit #	X Coordinate	Y Coordinate
--Select--		-76.97406	39.31857
City	State	Zip Code	Primary
SYKESVILLE	MD	21784	Yes

Parcel * (This section is required.)

Search Reset Clear Get Address & Owner

GIS ID *	Parcel	Parcel Area	Land Value	Improved Value	Exemption Value	Plan Area
11059411	328	4.26	0	0	0	RURAL
Legal Description						
LOT 4 4.26 A.[]1721 UNDERWOOD RD[]WILLOW BROOKE						

check spelling

Block	Lot	Census Tract	Council Dist	Inspection Dist	Supervisor Dist	Map #	DAP Zone
	4	603000	5				
Plan Area	State Tax Id	Subdivision Name					
	1403601468	Willow Brooke					
Section	Area	Tax Map					
		9					
Grid	Zoning District	ADC Map					
9-21	RC-DEO	4693-E10					
SDP No.	Final Plan No.	WP File No.					
	ECP-15-075						
Record Plat No.	WS Contract No.	FDP No.					
24889-2489							
Owner Occupied	Year Built	Historic District					
<input type="radio"/> Yes <input checked="" type="radio"/> No		<input type="radio"/> Yes <input checked="" type="radio"/> No					
Historic District Registry No.	Stat Area	Flood Plain					
	3-01	<input type="radio"/> Yes <input checked="" type="radio"/> No					
Building No							

Owner * (This section is required.)

Search Reset Clear

Name *		
William & Tara Witeman		
Address Line 1		
1751 UNDERWOOD RD		
Address Line 2		
Address Line 3		
Mail City	Mail State	Mail Zip Code
WEST FRIENDSHIP	MD <input type="checkbox"/>	21784
Phone	Primary	
717-240-7952	Yes <input checked="" type="checkbox"/>	
E-mail		
Cell Number	Fax Number	

Professionals (This section is not required.)

Search Reset Clear

License # *	Business Name		
20100079809	AERO ENERGY		
License Type *	First Name	Middle Name	Last Name
Propane Gs <input checked="" type="checkbox"/>	3ICHARD	THOMAS	JARCY
Primary	Address Line 1		
Yes <input checked="" type="checkbox"/>	230 LINCOLN WAY EAST		
Address Line 2			
City	State	ZIP Code	
NEW OXFORD	PA	17350-0000	
Phone 1	Phone 2	Fax	
2406744592		3016620709	
E-mail			
RJARCY@AEROENERGY.COM			

Applicant (This section is not required.)

Search As Owner As Lic. Prof As Contact

Type *	First Name	MI	Last Name
Applicant <input checked="" type="checkbox"/>	steve		dannenfeldt
Relationship	Full Name		
Applicant <input checked="" type="checkbox"/>	steve dannenfeldt		
Primary	Organization Name		
Yes <input checked="" type="checkbox"/>	Aero Energy		
Street Address			
230 lincoln way East			
Address Line 2			
City	State	Zip Code	
New Oxford	PA <input checked="" type="checkbox"/>	17350	
Phone	Cell	Fax	
717-577-5923			
E-mail *			
sdannenfeldt@aeroenergy.com			

Addtl Info

Est Construction Cost *	Housing Units *	Number of Buildings *	Public Owned
4000	0	0	No
Construction Type			
--Select--			

TANK INFORMATION

RESIDENTIAL TANK INFORMATION

Capital Project-No Fee *	Capital Project Number	Fee Exempt *	Roadside Tree Project Permit *	Roadside Tree Permit #
<input type="radio"/> Yes <input checked="" type="radio"/> No		<input type="radio"/> Yes <input checked="" type="radio"/> No	<input type="radio"/> Yes <input checked="" type="radio"/> No	
Existing Use	Number of Tanks Installed *	Number of Tanks Removed *		
SFD	1	0		
Water Supply	Sewage Disposal	Expiration Date	Relocate Existing Tank *	
Private	Private	1/30/2021	0	

PAYMENT INFORMATION


Check 1	Payee 1	Check 2	Payee 2	SAP Doc No	SAP Entered

Submit Cancel

8

DSA 45

1735 Underwood Rd

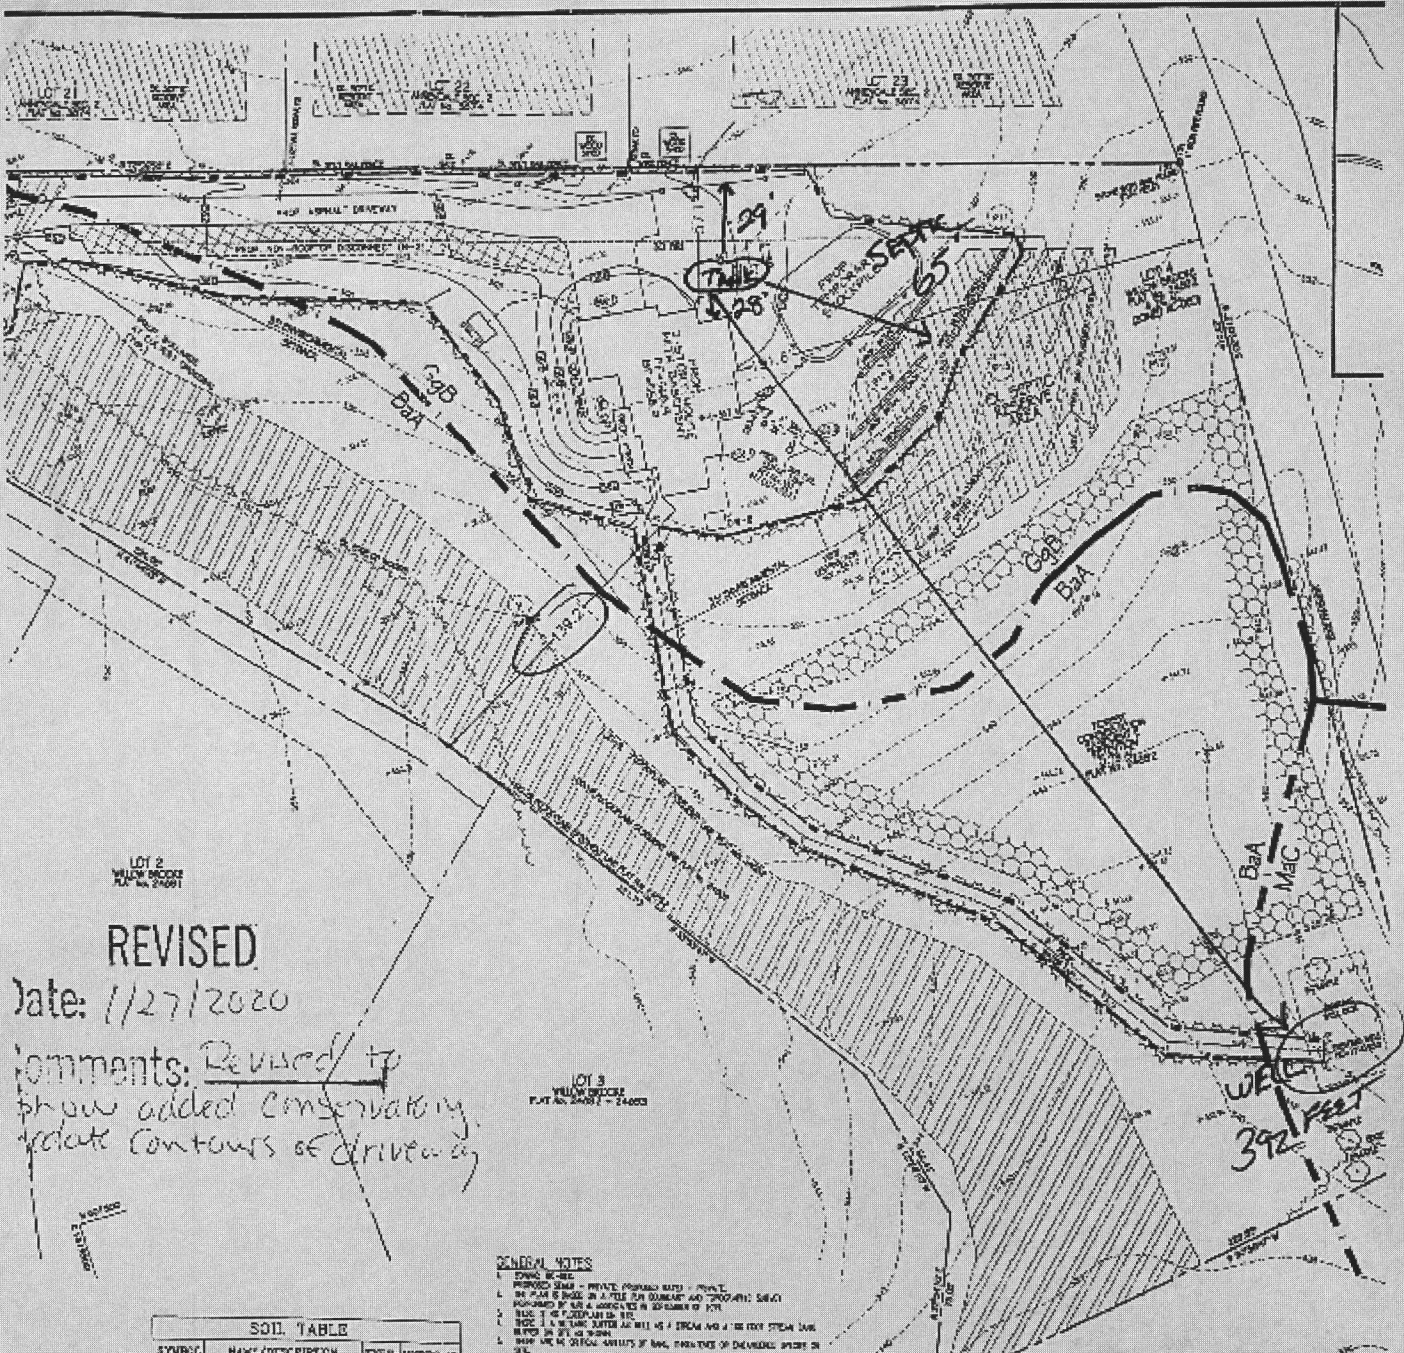

REVISED

Date: 1/27/2020

Comments: Revised to show added conservatory, delete contours of driveway

GENERAL NOTES

1. DRAINAGE - SEE PLAN
2. PROPOSED SEWER - PRIVATE (SEWERAGE RATE) - 150 GPD
3. THIS PLAN IS BASED ON A TITLE FOR EXISTING AND PROPOSED SURVEY INFORMATION BY AN A LICENSED SURVEYOR OF THE STATE OF MARYLAND.
4. THIS PLAN IS SUBJECT TO APPROVAL AND RECORDATION OF THE PLAN BY THE COMMISSIONER OF THE STATE DEPARTMENT OF ENVIRONMENTAL AND NATURAL RESOURCES.
5. THE CONTRACTOR SHALL VERIFY THE EXISTING UTILITIES AND SHALL BE RESPONSIBLE FOR ANY DAMAGE TO ANY UTILITIES FROM THE CONSTRUCTION OF THE PROJECT.
6. THE CONTRACTOR SHALL VERIFY THE EXISTING UTILITIES AND SHALL BE RESPONSIBLE FOR ANY DAMAGE TO ANY UTILITIES FROM THE CONSTRUCTION OF THE PROJECT.

SOIL TABLE			
SYMBOL	NAME/DESCRIPTION	TYPE	HYDROLOGIC
S3B	Clayey loam, 0 to 2% slope	3	4B
B3C	Clay loam, 0 to 15 percent slope	3	4B
S3A	Clay loam, 0 to 3 percent slope	2	4B

1735 Underwood Rd
SPYKESVILLE MD
21154

SHEET
SHEET 1 OF 3 GRADING, SE
SHEET 2 OF 3 SITE DETAILS
SHEET 3 OF 3 SEDIMENT A

APPROVED HOWARD SOIL CONSERVATION DISTRICT
THIS PLAN IS APPROVED FOR SOIL EROSION AND SEDIMENT CONTROL BY THE HOWARD SOIL CONSERVATION DISTRICT

DEVELOPER'S CERTIFICATE

I, THE CERTIFIED ENGINEER, HAVE REVIEWED AND CONSENTED TO THIS PLAN ACCORDING TO THE PLAN FOR EXISTING AND PROPOSED SURVEY INFORMATION BY AN A LICENSED SURVEYOR OF THE STATE OF MARYLAND. I HAVE REVIEWED THE PLAN AND AM SURE THAT ALL THE GRADING, SEDIMENTATION, AND EROSION CONTROL MEASURES SHOWN ON THIS PLAN ARE NECESSARY TO PROTECT THE SOILS FROM EROSION AND SEDIMENTATION. I HAVE REVIEWED THE PLAN AND AM SURE THAT ALL THE GRADING, SEDIMENTATION, AND EROSION CONTROL MEASURES SHOWN ON THIS PLAN ARE NECESSARY TO PROTECT THE SOILS FROM EROSION AND SEDIMENTATION.

DEVELOPER
1735 UNDERWOOD RD
SPYKESVILLE, MD 21154
211-547-2122

PLAN PREPARED BY:
NJR & ASSOCIATES
Land Surveying and Planning
6713 STATE ROUTE 32
WEST FREDERICK, MD 21794
TEL: (241) 660-8800

GRADING, SEDIMENT
WILLOW
PLAT NO.
1735 UNDERWOOD RD
TAX MAP 3,
500 ELECTION DISTRICT
SCALE: 1" = 30'
JOB NO.: 3052

HOWARD SOIL CONSERVATION DISTRICT DATE

SIGNATURE OF DEVELOPER DATE

