

Building Permit Application
Howard County Maryland
Department of Inspections, Licenses and Permits
3430 Court House Drive Permits: 410-313-2455 www.howardcountymd.gov

Date Received:
LICENSES & PERMITS
DIVISION
Permit No.:

Building Address: 150 46 Do	ouble Bridges ct.	Property Owner's Name: AMCIK Address: 15046 Double City: Glenels State: MD Phone: 234-138-5656 Fax:	Toot Bridges Ct.
City: Glenwood State:		City: Glenels State: MD	Zip Code: 21738
Suite/Apt. #SDP/V		Phone: 234-738-5656 Fax:	
Subdivision: Meriwether	FAIM	Email:	
Lot: 3 Tax Map: 002	Parcel: 0024	Applicant's Name & Mailing Address, (If other Applicant's Name:	er than stated herein) Ke
Existing Use: SFD		Address:	7. 0-1-
Proposed Use: 5FD with	Deck	City:State:	
	1	Phone:Fax: Email:	
Estimated Construction Cost: \$ 30	006		a 10
Description of Work: Boild a		Contractor Company: HNH Carpe	61779
L SHaped DCCK.	4x4 Larling	Contact Person: Henry Hol	La De
with Steps To		Address: 10622 Streen Ed	SE DI.
W	5.000	License No.: 65612	Zip Code:
		Phone: 443-324-5217 Fax:	- W
		Email: HNH Carpentry &	Anh. com
Occupant/Tenant Name:		Lillali.	7,0-1,007
Was tenant space previously occupied?	□Yes □No	Engineer/Architect Company:	
Contact Name:		Responsible Design Prof.:	
Address:		Address:	
City:St	ate: Zip Code:	City:State:Z	ip Code:
Phone:F	av.	Phone:Fax:	
Email:		Email:	
Commercial Building Characteristics	Residential Building Characteristics	Utilities	
Height:	☑ SF Dwelling ☐ SF Townhouse	Electric:	The state of the s
No. of stories:	<u>Depth</u> <u>Width</u>	Gas: ☐ Yes ☐ No	
Gross area, sq. ft./floor:	1st floor:	Water Supply	
	2 nd floor:	☐ Public	Chromatic and Appendix of the same
Area of construction (sq. ft.):	Basement:	☑ Private RR	WED
Use group:	☐ Unfinished Basement	Sewage Disposal	
озе втоир.	☐ Crawl Space	□ Public APR 2	2 0000
Construction type:	☐ Slab on Grade	Private AFR Z	2 5050
☐ Reinforced Concrete	No. of Bedrooms:	Heating System ICENSES	& PERMITO
☐ Structural Steel	Multi-family Dwelling	DIVIO	SION
☐ Masonry	No. of efficiency units:	La ciccurio La Gii	
☐ Wood Frame	No. of 1 BR units:	☐ Natural Gas ☐ Propane Gas	
☐ State Certified Modular	No. of 2 BR units: No. of 3 BR units:	Other:	
	Other Structure:	Sprinkler System:	
	Dimensions:	☐ Yes ☐ No	
> Roadside Tree Project Permit	Footings:		
□Yes IZNo	Roof:	Grading Permit Number:	
Roadside Tree Project Permit #	☐ State Certified Modular		
	☐ Manufactured Home	Building Shell Permit Number:	
WITH ALL REGULATIONS OF HOWARD COUNTY WHI APPLICATION; (5) THAT HE/SHE GRANTS COUNTY OF Applicant's Signature Applicant's Signature	ICH ARE APPLICABLE THERETO; (4) THAT HE/SHE WILL OFFICIAL THE RIGHT TO ENTER ONTO THIS PROPERTY OFFI OFFI ALLCOM	MAKE THIS APPLICATION; (2) THAT THE INFORMATION IS CORL PERFORM NO WORK ON THE ABOVE REFERENCED PROPERTY FOR THE PURPOSE OF INSPECTING THE WORK PERMITTED AN ACTION OF THE Name 4 - 21 - 2020 ate	NOT SPECIFICALLY DESCRIBED IN TH
Contractor			
Title/Company			
	Checks Payable to: DIRECTOR OF I **PLEASE WRITE NE -FOR OFFICE		

Health	5 20	30	W、COS いんしょく uance? □ Yes □ No
PSZA (Engineering)			
PSZA (Zoning)			
Building Officials			
State Highways			
AGENCY	DATE	SIGN	IATURE OF APPROVAL

DPZ SETBACK INFORMATION		
Front:		
Rear:		
Side:		
Side St.:		
All minimum setbacks met?	☐ Yes	□No
Is Entrance Permit Required?	☐ Yes	□No
Historic District?	☐ Yes	□No
Lot Coverage for New Town Z	one:	
SDP/Red-line approval date:		

Filing Fee	\$ 5500
Permit Fee	\$
Tech Fee	\$
Excise Tax	\$
PSFS	\$
Guaranty Fund	\$
Add'l per Fee	\$
Total Fees	\$
Sub- Total Paid	\$
Balance Due	\$
Check	# 14 12

Distribution of Copies: White: Building Officials

Green: PSZA,Zoning

Yellow: PSZA, Engineering

Pink: Health

Gold: SHA



HNHDeckandPorch.com

HNHDeckandPorch@aol.com 10622 Stream Edge Dr. Laurel, MD 20723

> Cell: 443-324-5217 Fax: 240-581-9955

To Whom It May Concern,


Hank Oswald at the Health Dept. ask me to resubmit the site plan for address 15046 Double Bridges Ct Glenelg MD 21738. Permit #B20001338 I didn't have the septic tank in the correct location. The new site plan is correct, and I have sent him a email copy also. If you have any questions, please feel free to call.

Henry 443-324-5217


			CURVE	TABLE		
CURVE	RADIU5	LENGTH	DELTA	TAN	CHD. BRG.	CHD. DIST.
CI	310.001	74.171	13'42'33'	37.27'	578°59'43"W	74.00¹
C2	25.00 ^t	11.981	27°27'29"	6.11	N85°52'10"E	11.871

Date: 5/19/20

Comments: Ba-1338

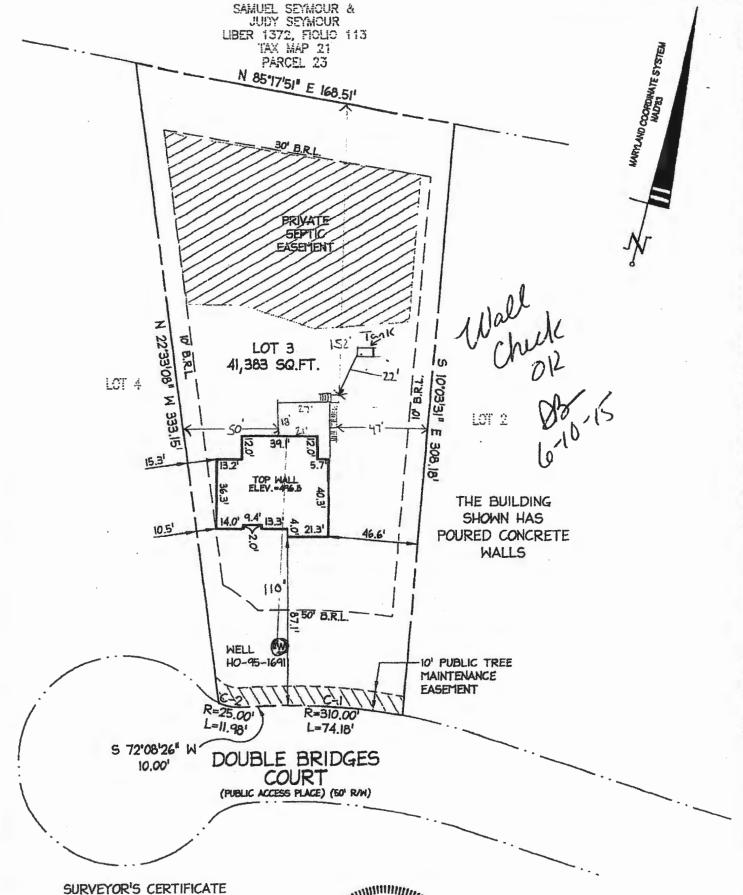

I HEREBY CERTIFY THAT I EITHER PERSONALLY PREPARED OR WAS IN RESPONSIBLE CHARGE OVER THE PREPARATION OF THIS DRAWING AND THE SURVEYING WORK REFLECTED IN IT, AND THAT IT IS IN COMPLIANCE WITH REQUIREMENTS SET FORTH IN REGULATION .12 OF CHAPTER 06, MINIMUM STANDARDS OF PRACTICE. I AM A DULY LICENSED PROPERTY LINE SURVEYOR UNDER THE LAMS OF THE STATE OF MARYLAND, LICENSE NO. 234, EXPIRATION DATE 7/6/16.

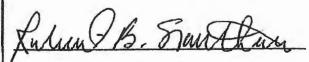

PROPERTY OF MARY AND A SOUTH A

WALL CHECK SURVEY #15046 DOUBLE BRIDGES COURT LOT 3

MERIWETHER FARM SECTION ONE PLAT NO. 21343

PLAT NO. 21343 4TH ELECTION DISTRICT HOWARD COUNTY, MD

	DDC JOB#:	13085.2
	DATE:	5-4-2015
	SCALE:	1°=501
-	DRN. BY:	RC
	CHK. BY:	RB5



Planners Surveyors Engineers Landscape Architects

192 East Hain Street
Westminster, HD 21157
410.386.0560
410.386.0564 (Fax)
DDC@DDCinc.us
www.DDCinc.us