

Approved 5/19/2020
-U.O.

James Killorin
3346 Sang Rd.
Glenwood Md. 21738
5/6/2020

Plan Review
Re: Amendment to Permit# B20000541

Plan Review:

I am requesting an amendment to Permit# B20000541 to add a 12' x 14' deck and stairs to the existing deck at 3346 Sang Rd. Glenwood MD. 21738

Sincerely,




James Killorin

443-878-6584

cc: P42

DED
Heath

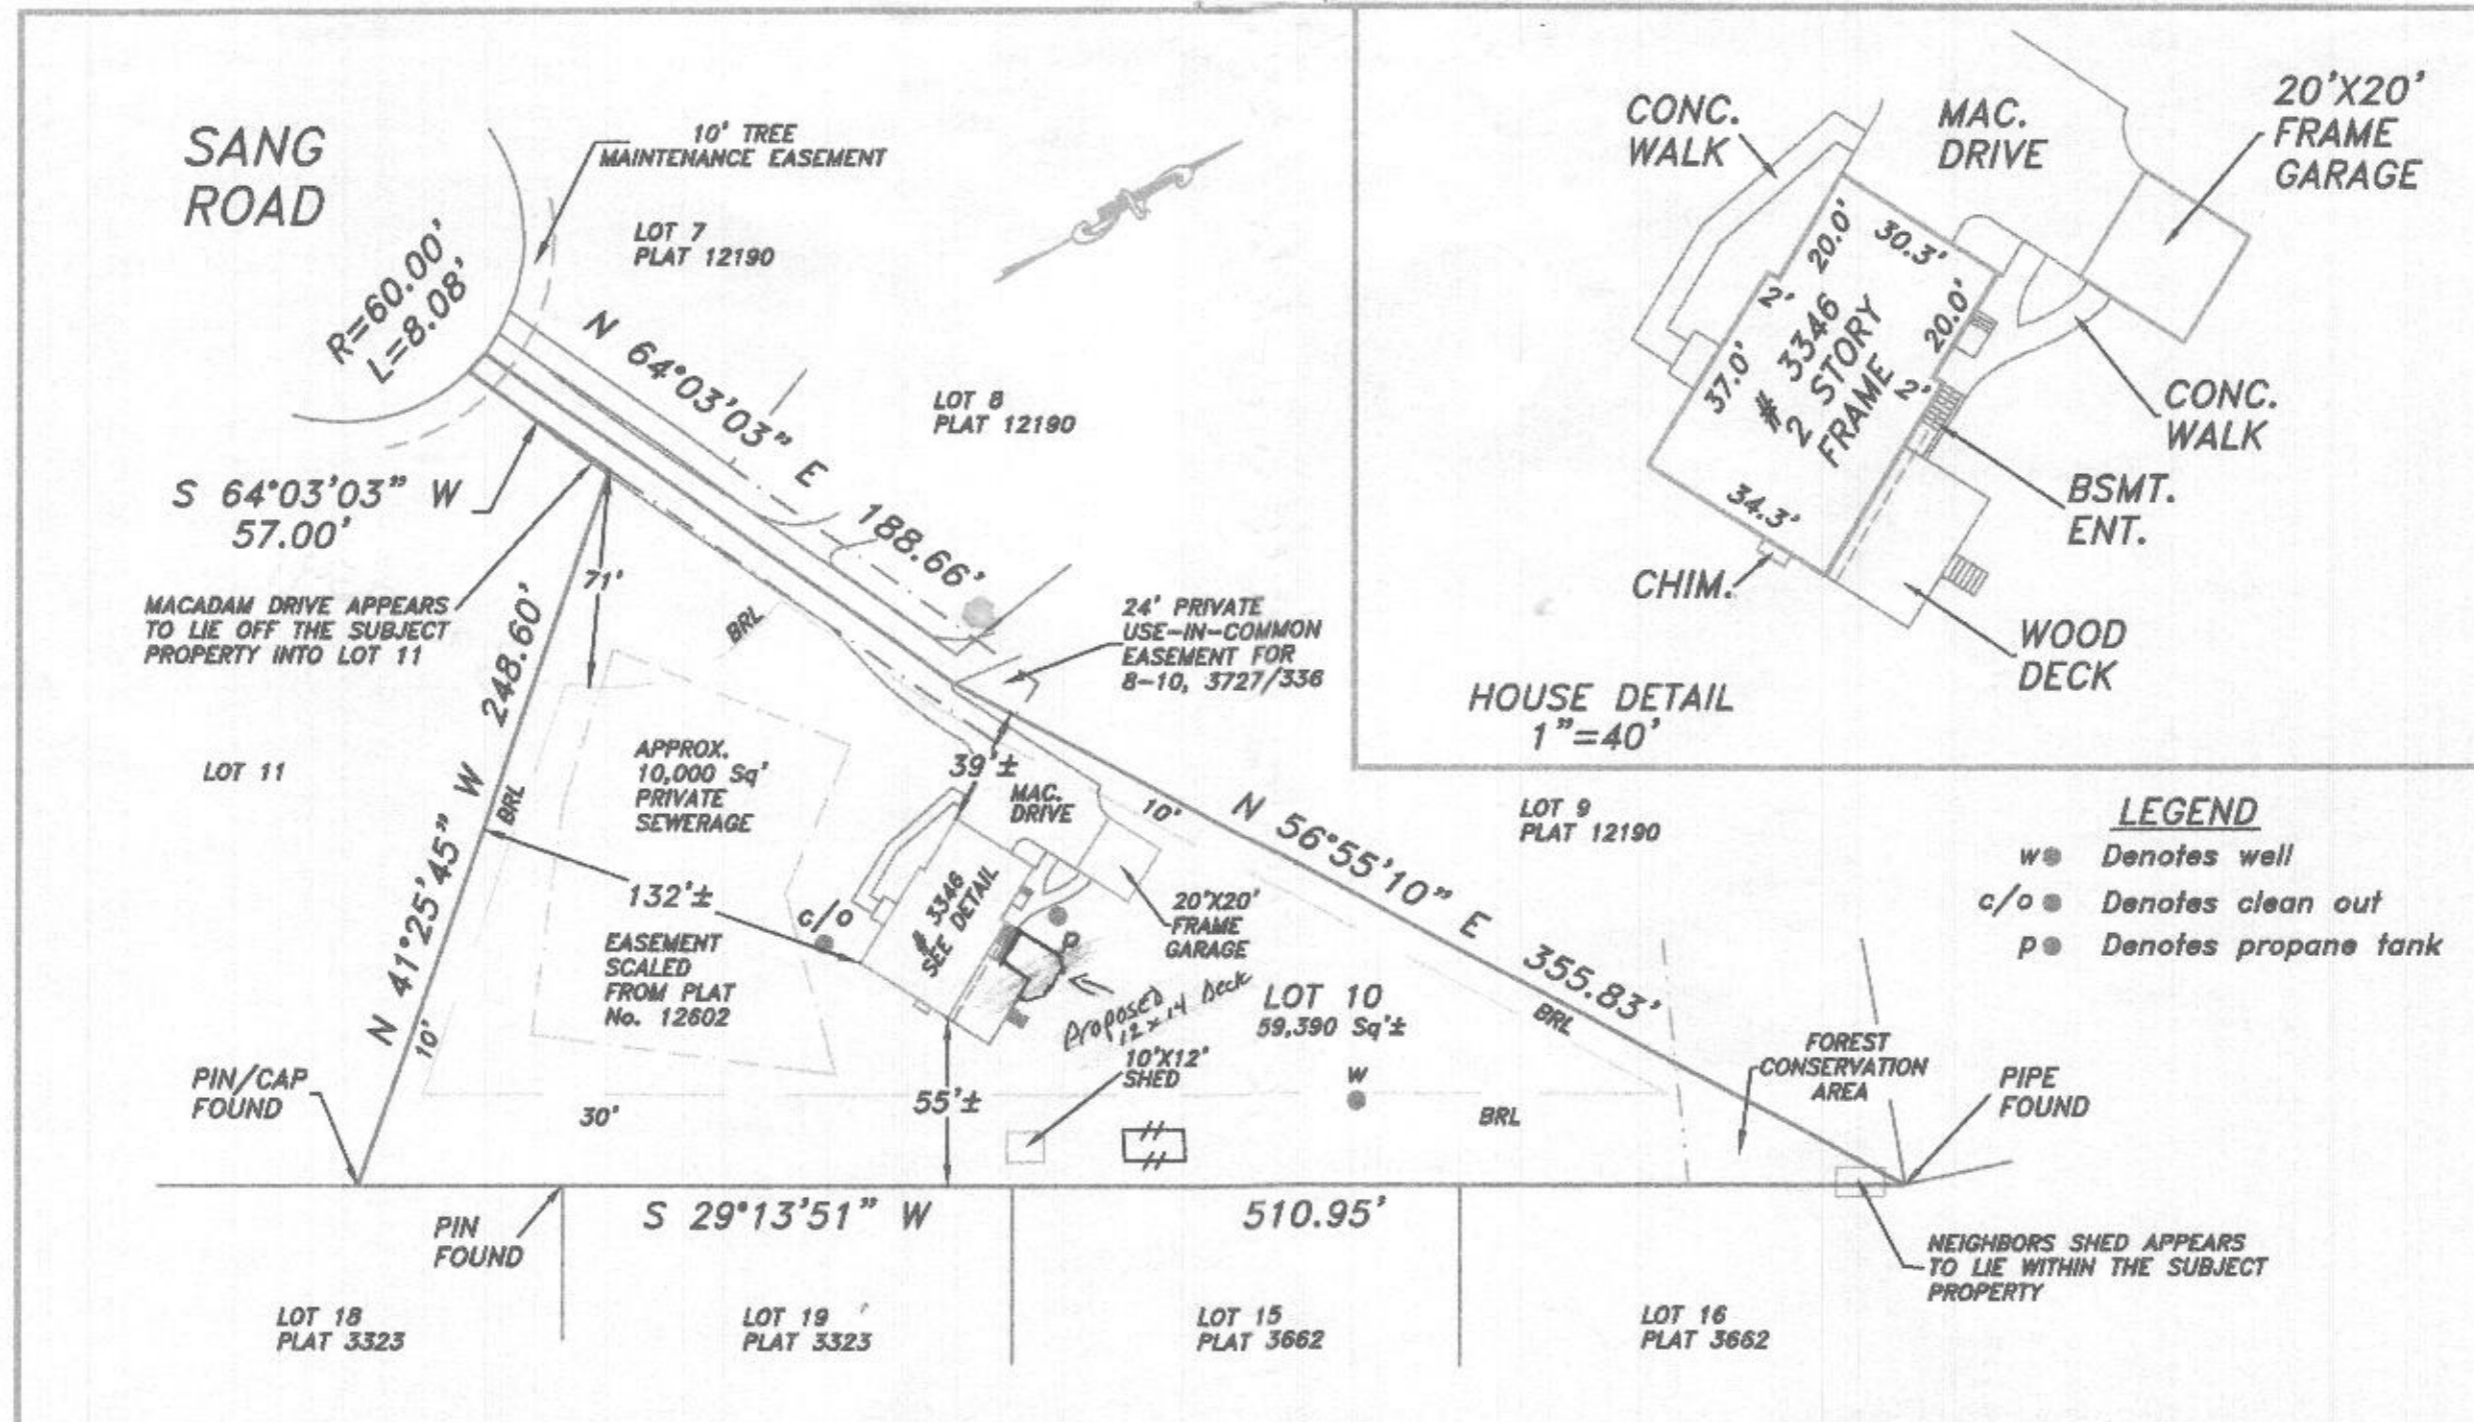

The purpose of this drawing is to locate, describe, and represent the positions of buildings and substantial improvements affecting the property shown hereon, being known as:
 LOT 10, as shown on the plat entitled
 "HOLLY HILLS" SECTION II
 recorded among the land records of Howard County, Maryland in
 Plat Number 12602

This is to certify that I either personally prepared or was in responsible charge over the preparation of this drawing and the surveying work reflected in it, all set forth in Regulation .12 of Chapter 09.13.06 of the Code of Maryland Annotated Regulations.

This is page one of a two page document. The advice found on the affixed page is an integral part of this drawing, and is not valid without all pages.



James Carl Hudgins
 Property Line Surveyor #96
 Expiration Date: 3/11/16

LOCATION DRAWING
 3346 SANG ROAD
 4th ELECTION DISTRICT
 HOWARD COUNTY, MARYLAND

NTT Associates, Inc.
 16205 Old Frederick Rd.
 Mt. Airy, Maryland 21771
 Phone: (410) 442-2031
 Fax: (410) 442-1315
 www.nttsurveyors.com

Scale:	1" = 80'
Date:	4/26/14
Field By:	RIK
Drawn By:	RIK
File No.:	MISC 11074
Page No.:	1 of 2