

Menu Save Reset Cancel Help

Record Detail * (This section is required.)

Permit Type	Permit Number	Opened Date
Building/Residential/Misc/Deck	B20001444	05/12/2020
Description of Work		
SFD/ CONSTRUCT 8 X 7 OPEN DECK W/ STEPS		

[check spelling](#)

Address * (This section is required.)

Search Reset Clear Get Parcel & Owner

Street #	Street Name	Street Type	
3926	CLARKS MEADOW	DR	
Unit Type	Unit #	X Coordinate	Y Coordinate
-Select-		-77.01707	39.2609
City	State	Zip Code	Primary
GLENWOOD	MD	21738	Yes

Parcel * (This section is required.)

Search Reset Clear Get Address & Owner

GIS ID *	Parcel	Parcel Area	Land Value	Improved Value	Exemption Value	Plan Area
922763	227	43413	219000	869700	650700	RURAL
Legal Description						
IMPSLOT 10 43413 SQ[]3926 CLARKS MEADOW DR[]CLARKS MEADOW RSB LOT 4						

[check spelling](#)

Block	Lot	Census Tract	Council Dist	Inspection Dist	Supervisor Dist	Map #	DAP Zone
17	10	605601	5				
Plan Area	State Tax Id	Subdivision Name					
	1404370902	Clarks Meadow					
Section	Area	Tax Map					
		21					
Grid	Zoning District	ADC Map					
21-17	RC-DEO	4812-H9					
SDP No.	Final Plan No.	WP File No.					
	F-06-029						
Record Plat No.	WS Contract No.	FDP No.					
18482-1848		Yes					
Owner Occupied	Year Built	Historic District					
☐ Yes ☐ No	2012	☐ Yes ☒ No					
Historic District Registry No.	Stat Area	Flood Plain					
	4-09	☐ Yes ☒ No					
Building No							

Owner * (This section is required.)

Search Reset Clear

Name *		
ROSS ROBERT		
Address Line 1		
3926 CLARKS MEADOW DR		
Address Line 2		
Address Line 3		
Mail City	Mail State	Mail Zip Code
GLENWOOD	MD	21738
Phone	Primary	
410-969-4444	Yes	
E-mail		
Cell Number	Fax Number	

Professionals (This section is not required.)

License # *	Business Name		
08050045780	FENCE & DECK CONNECTION		
License Type *	First Name	Middle Name	Last Name
MHIC Co	JAMES	W	RUBUSH
Primary	Address Line 1		
Yes	8057 VETERANS HIGHWAY		
	Address Line 2		
	City	State	ZIP Code
	MILLERSVILLE	MD	21108-0000
	Phone 1	Phone 2	Fax
	4109694444		4109694448
	E-mail		
	PERMITS@FENCEDECKCONNECT.COM		

Applicant (This section is not required.)

Type *	First Name	MI	Last Name
Applicant	JOSH		SIMPSON
Relationship	Full Name		
Applicant	JOSH SIMPSON		
Primary	Organization Name		
Yes	FENCE & DECK CONNECTION		
	Street Address		
	8057 VETERANS HIGHWAY		
	Address Line 2		
	City	State	Zip Code
	MILLERSVILLE	MD	21108
	Phone	Cell	Fax
	410-969-4444		
	E-mail *		
	permits@fencedeckconnect.com		

Addtl Info

Est Construction Cost *	Housing Units *	Number of Buildings *	Public Owned
6000	0	0	No
Construction Type			
-Select-			

MISC PERMIT INFO

MISCELLANEOUS PERMIT INFORMATION

Capital Project-No Fee *	Capital Project Number	Exempt *	Roadside Tree Project Permit *	Roadside Tree Project Permit #
☐ Yes ☒ No		☐ Yes ☒ No	☐ Yes ☒ No	
Existing Use *	Water	Sanitary	Expiration Date	
SFD	Private	Private	11/8/2020	

PAYMENT INFORMATION

Check 1	Payee 1	Check 2	Payee 2	SAP Doc No	SAP Entered

Submit Cancel

Approved Santa Anita Plan
Howard County Health Department


8' x 7' Deck w/stairs
as illustrated
5/14/2020 Date

P. Bricker
Signature

3026 Clark's Meadow Rd
B2000/444

- EXISTING 2' CONTOURS
- EXISTING 10' CONTOURS
- EXISTING TREE LINE
- SOIL LINES AND TYPES
- ⊙ DENOTES PROPOSED WELL
- DENOTES FAILED PERC
- DENOTES PASSED PERC
- DENOTES 1500 Sq.Ft. ALTERNATE WELL SITE
- EXISTING SEPTIC AREA 10,002 SQ.FT.
- PROPOSED SEPTIC AREA 10,041.50 FT.

Scale: 1"=60'-0"

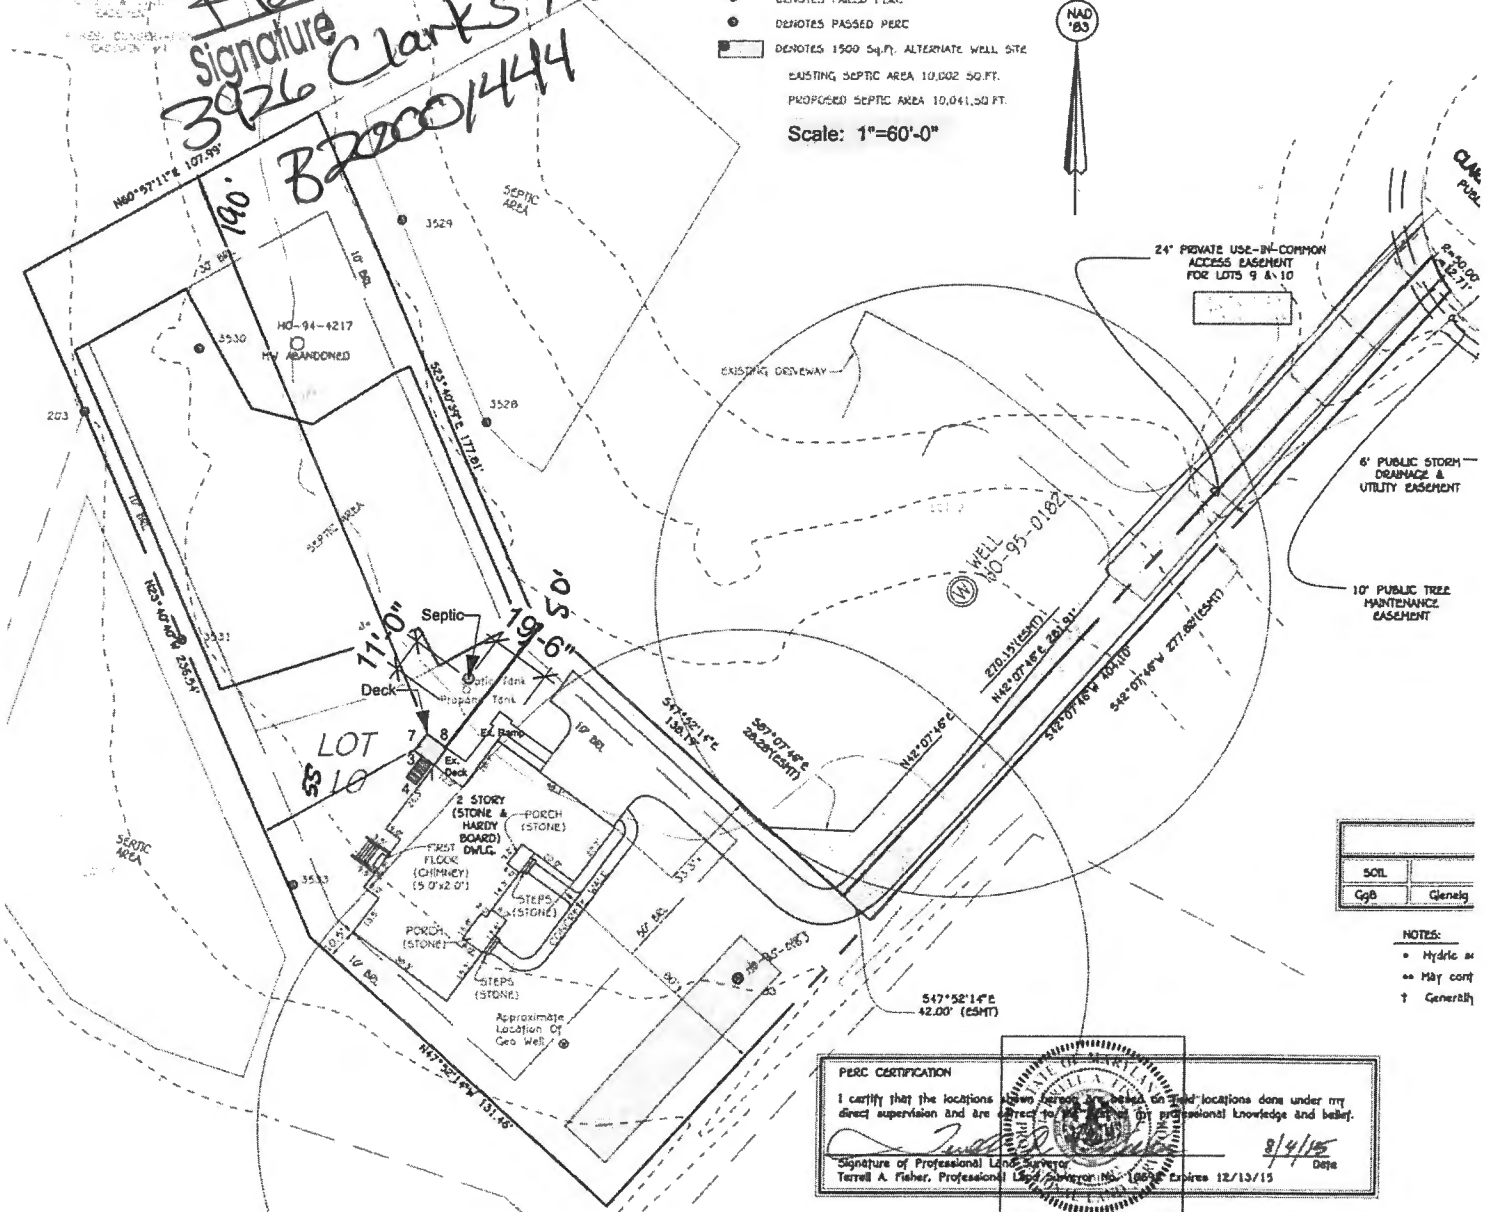

SOIL	
CgB	Glens

NOTES:
• Hydric soil
• May cont
† Generally

PERC CERTIFICATION

I certify that the locations shown herein are based on field locations done under my direct supervision and are correct to the best of my professional knowledge and belief.

Signature of Professional Land Surveyor
Terrell A. Fleher, Professional Land Surveyor No. 18684 Expires 12/13/15

8/4/15 Date