

PERMIT NUMBER: B 20001165

DATE ACCEPTED:



RESIDENTIAL BUILDING PERMIT APPLICATION

HOWARD COUNTY DEPARTMENT OF INSPECTIONS, LICENSES, AND PERMITS

3430 COURT HOUSE DRIVE, ELLICOTT CITY, MD 21043 - PHONE: (410) 313-2455 OPTION #4

www.howardcountymd.gov

Health
RECEIVED
APR 06 2020

BUILDING SITE ADDRESS *REQUIRED*

Street Address: 1605 Fields Ends Ct.

Unit: LICENSES & PERMITS
DIVISION

City: Woodbine

State: MD

Zip Code: 21797

Subdivision/Village/Complex Name:

SDP/WF/BA #:

Lot:

Tax Map:

Parcel:

Grading Permit #:

DESCRIPTION OF WORK *REQUIRED*

Existing Use: none

Proposed Use: covered porch

Estimated Cost: \$20.00

Trade Work to Be Completed (Separate Permits Required): ☐ Mechanical (HVAC) ☒ Electrical ☐ Plumbing ☐ None

Build a porch on rear of the house with a covered roof size of the porch is 12' wide X 15 long with 1 set of 3' wide steps.

PROPERTY OWNER INFORMATION *REQUIRED*

Owner(s) Name(s) (As it appears on tax records): Lew and Betsy Dutrow

Primary Residence: ☒ Yes ☐ No

Owner's Street Address: 1605 Fields Ends Ct.

City: Woodbine

State: MD

Zip Code: 21797

Phone: (410) 489-6681

Email: toomanyth1ngs@netzero.net

APPLICANT NAME *REQUIRED - INDIVIDUAL WHO SIGNS THIS APPLICATION*

Business Name: Henderson Services LLC

Contact Name: Ron Henderson

Street Address: 2550 Greene Rd

City: Baldwin

State: MD

Zip Code: 21013

Phone: (443) 942-1182

Email: hendersonservicesllc@yahoo.com

CONTRACTOR INFORMATION *REQUIRED*

Business Name: Henderson Services LLC

Licensee's Name: Ron Henderson

License #: 98207

Street Address: 2550 Greene Rd

City: Baldwin

State: MD

Zip Code: 21013

Phone: (443) 942-1182

Email: hendersonservicesllc@yahoo.com

ARCHITECT/ENGINEER INFORMATION *INDIVIDUAL WHO SIGNED PLANS, IF APPLICABLE*

Business Name: Norton Consulting Engineers

Name: George Norton

Street Address: 5718 NOTTINGHAM PLACE

City: ADAMSTOWN

State: MD

Zip Code: 21710

Phone: (240) 393-3672

Email:

BUILDING CHARACTERISTICS *REQUIRED*Primary Structure: ☒ SF Dwelling ☐ SF Townhouse ☐ SF Duplex ☐ Mobile Home ☐ Multi-Family Dwelling (MF*) Condo: ☐ Yes ☒ NoUtilities: ☒ Electric ☐ Gas Water Supply: ☐ Public ☒ Private (Well) Sewage Disposal: ☐ Public ☒ Private (Septic)Heating System: ☒ Electric ☐ Natural Gas ☐ Propane ☐ Other: Roadside Tree Project: ☐ No ☐ Yes: #Sprinkler System: ☐ NFPA 13 ☐ NFPA 13R ☐ NFPA 13D ☒ None Fire Alarm System: ☒ Yes ☐ No ☐ Voice Evac

ADDITIONAL RESIDENTIAL INFORMATION (PLEASE SELECT/COMPLETE ALL THAT APPLY)

Model Name & Options:

of Bedrooms (SF): # of efficiency units (MF*): # of 1 BR (MF*): # of 2 BR (MF*): # of 3 BR (MF*):

Rooms: # Full Baths: # Half Baths: # Fireplaces:

Garage/Carport Info: ☐ Attached Garage ☐ Detached Garage ☐ Integral Garage ☐ Carport ☐ NoneBasement/Foundation Info: ☐ Slab on Grade ☐ Post & Pier ☐ Unfinished Basement ☐ Finished Basement: ☐ Full or ☐ Partial1st Fl Width: 1st Fl Depth: 2nd Fl Width: 2nd Fl Depth: Bsmt Width: Bsmt Depth:Energy Method: ☐ Prescriptive ☐ Performance ☐ UA Alternative ☐ ERI Gross Area: sq ft Occupiable Area: sq ftAGREEMENT/ DISCALIMER *REQUIRED*

THE UNDERSIGNED HEREBY CERTIFIES AND AGREES AS FOLLOWS: (1) THAT HE/SHE IS AUTHORIZED TO MAKE THIS APPLICATION; (2) THAT THE INFORMATION IS CORRECT; (3) THAT HE/SHE WILL COMPLY WITH ALL REGULATIONS OF HOWARD COUNTY WHICH ARE APPLICABLE THERETO; (4) THAT HE/SHE WILL PERFORM NO WORK ON THE ABOVE REFERENCED PROPERTY NOT SPECIFICALLY DESCRIBED IN THIS APPLICATION; (5) THAT HE/SHE GRANTS COUNTY OFFICIALS THE RIGHT TO ENTER ONTO THIS PROPERTY FOR THE PURPOSE OF INSPECTING THE WORK PERMITTED AND POSTING NOTICES.

APPLICANT'S ORIGINAL SIGNATURE

DATE SIGNED

FOR OFFICE USE ONLY

CHECKS PAYABLE TO: DIRECTOR OF FINANCE OF HOWARD COUNTY


AGENCIES REQUIRED/APPROVALS:

☒ PR ☐ DPZ ☐ DED ☒ Health ☐ SHA ☐ CID

SUBMITTAL FEES:


PAYMENT:

ACCEPTED BY:

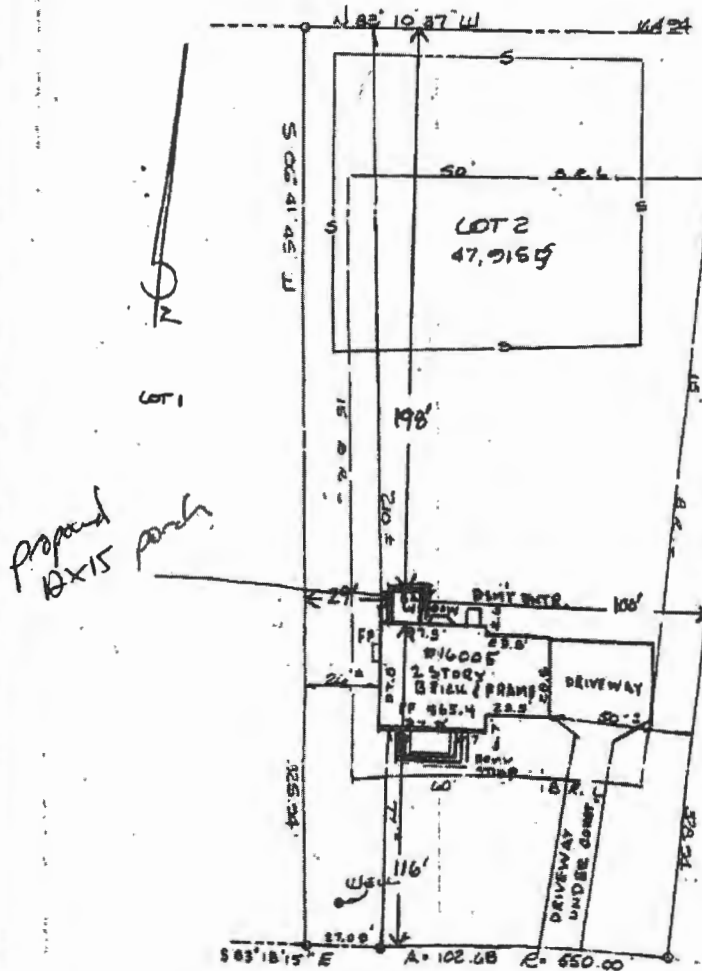

FIELD END COURT
(60' e/w)

HOUSE LOCATION
LOT 2, SECTION 2
WARFIELD'S GRANT
#16005 FIELD END COURT
ELECTION DISTRICT NO. 4
HOWARD COUNTY, MARYLAND
SCALE: 1" = 50'

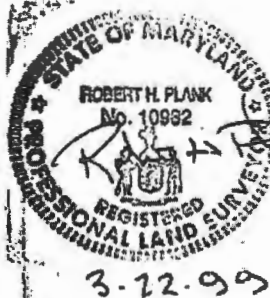

I CERTIFY THIS PLAT TO BE CORRECT; IT IS THE RESULT OF AN ACTUAL FIELD SURVEY BASED ON DATA FOUND AMONG THE LAND RECORDS OF HOWARD COUNTY, MARYLAND AS REFERENCED HEREON.

REFERENCE	JOB NO.
Plat No. 11972	9864 8710

WARRANT - RECOVERY, INC.

204 S. MAIN STREET
MOUNT AIRY, MARYLAND
301-829-2296

21771