

5/18/76  
arrived 1 PM

app 5-10-76  
down

# PERMIT

SEWAGE DISPOSAL SYSTEM

MARYLAND STATE DEPARTMENT OF HEALTH

HOWARD COUNTY

INDEXED

P 23177

A

ELLICOTT CITY

DISTRICT 5

DATE 5/3/76

Jack Fyock IS PERMITTED TO INSTALL ALTER X

ADDRESS Ten Oaks Road, Dayton, Maryland PHONE 286-2939

A SEWAGE DISPOSAL SYSTEM LOCATED AT

SUBDIVISION Dogwood ROAD 6801 Redberry Road LOT 3

PROPERTY OWNER David W. Marjaram

ADDRESS

## SPECIFICATIONS

DRAIN FIELD DEPTH FEET, BOTTOM AREA SQ. FT.

SEEPAGE PITS ABSORBENT SIDE-WALL AREA SQ. FT.

SEPTIC TANK CAPACITY GALLONS

FOR GARBAGE GRINDER, INCREASE DISPOSAL AREA 22% & TANK CAPACITY 80%.

OTHER REPAIR - CALL FOR INSPECTION OF GROUND WHEN OPENED UP SO SANITARIAN CAN


RECOMMEND REPAIR SYSTEM.

PLANS APPROVED BY Donald W. Monaghan DATE 5/3/76

FILL SEPTIC TANK AND DISTRIBUTION BOX WITH WATER BEFORE CALLING FOR AN INSPECTION. COVER NO WORK UNTIL INSPECTED AND APPROVED.

NEITHER THE HOWARD COUNTY COMMISSIONERS NOR THE HEALTH DEPARTMENT IS RESPONSIBLE FOR THE SUCCESSFUL OPERATION OF ANY SYSTEM.

P 23177

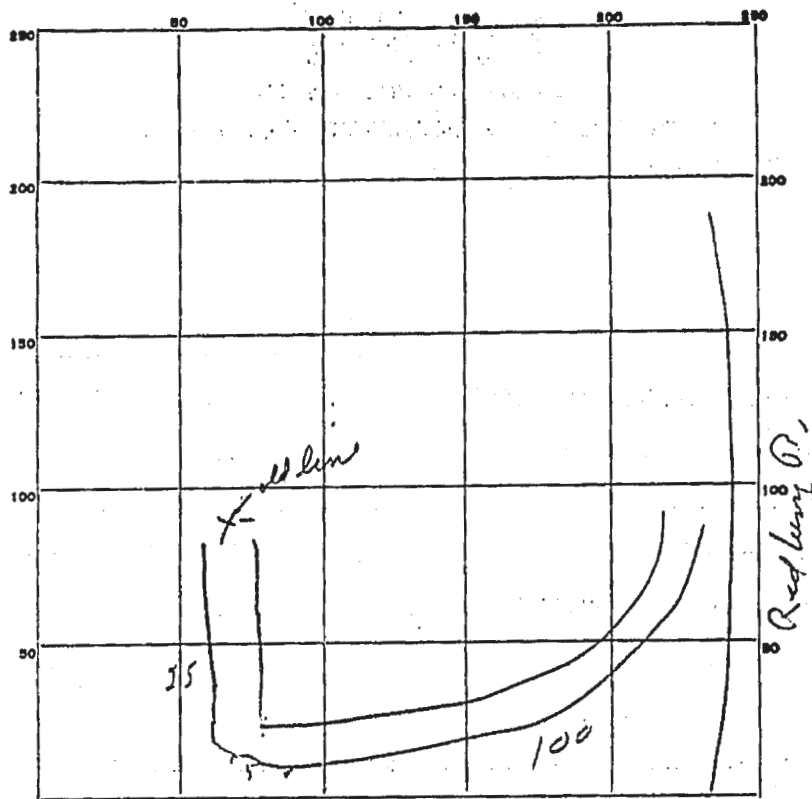

INDICATE NORTH. - NAME ADJOINING ROADWAY AS BASE LINE.

PERMIT CARD 012

SEPTIC TANK, LEVEL \_\_\_\_\_

CLEANOUTS \_\_\_\_\_

DISTRIBUTION BOX, LEVEL \_\_\_\_\_

TILE FIELD, DEPTH 8-9 FT. TRENCH WIDTH 2 FT.

GRAVEL DEPTH 118 IN. TOTAL LENGTH 130 FT.

NUMBER OF TRENCHES 1 TOTAL BOTTOM AREA 260

SEEPAGE PITS, INSIDE DIAMETER \_\_\_\_\_ FT. DEPTH BELOW INLET \_\_\_\_\_ FT.

ABSORBENT AREA 520 SQ. FT. 1 side of trench

REMARKS 5/10/76 - trench appears to be in good condition

DATE SYSTEM APPROVED 5/10/76

INSPECTOR W. M. [Signature]

5/18/76  
around 1 PM

# PERMIT

SEWAGE DISPOSAL SYSTEM

MARYLAND STATE DEPARTMENT OF HEALTH

HOWARD COUNTY

INDEXED

ELLICOTT CITY

DISTRICT 5

DATE 5/3/76

app 5-10-76  
SWM

P 23177

A \_\_\_\_\_

Jack Fyock IS PERMITTED TO INSTALL ALTER X

ADDRESS Ton Oaks Road, Dayton, Maryland PHONE 286-2939

A SEWAGE DISPOSAL SYSTEM LOCATED AT \_\_\_\_\_

SUBDIVISION Dogwood ROAD 6801 Radberry Road LOT 3

PROPERTY OWNER David W. Marjarum

ADDRESS \_\_\_\_\_

## SPECIFICATIONS

DRAIN FIELD \_\_\_\_\_ DEPTH \_\_\_\_\_ FEET, BOTTOM AREA \_\_\_\_\_ SQ. FT.

SEEPAGE PITS \_\_\_\_\_ ABSORBENT SIDE-WALL AREA \_\_\_\_\_ SQ. FT.

SEPTIC TANK CAPACITY \_\_\_\_\_ GALLONS

FOR GARBAGE GRINDER, INCREASE DISPOSAL AREA 25% & TANK CAPACITY 50%.

OTHER REPAIR - CALL FOR INSPECTION OF GROUND WHEN OPENED UP SO SANITARIAN CAN

RECOMMEND REPAIR SYSTEM.

PLANS APPROVED BY Donald W. Monaghan DATE 5/3/76

FILL SEPTIC TANK AND DISTRIBUTION BOX WITH WATER BEFORE CALLING FOR AN INSPECTION. COVER NO WORK UNTIL INSPECTED AND APPROVED.

NEITHER THE HOWARD COUNTY COMMISSIONERS NOR THE HEALTH DEPARTMENT IS RESPONSIBLE FOR THE SUCCESSFUL OPERATION OF ANY SYSTEM.

P  
23177

## Oswald, Hank

---

**From:** Oswald, Hank  
**Sent:** Thursday, August 13, 2015 9:16 AM  
**To:** 'Guihua Wang'  
**Cc:** Timothy Wolfe; Williams, Jeffrey  
**Subject:** RE: 6801 Redberry Road  
**Attachments:** A23170\_P23177\_6801 Redberry Lane.pdf

Hi Grace:

My coworker found the septic permit for this property. A repair was done in 1976. The drawing shows a 100 foot trench alongside Hall Shop Road in the proposed sand mound system area (s). Please see attached document.

Hank

---

**From:** Guihua Wang [<mailto:Guihua.Wang@kci.com>]  
**Sent:** Monday, August 10, 2015 6:54 AM  
**To:** Oswald, Hank  
**Cc:** Timothy Wolfe  
**Subject:** RE: 6801 Redberry Road

Hank,

There might be some miscommunication.

The Owner hired Fogle's Septic to determine where the trenches are so that the Health Dept can go out to the site to evaluate whether there is 4' buffer zone and whether the disposal field is functioning. Fogle's Septic has marked up the trenches. If you or Jeff would be able to schedule a time with Fogle, that would be great. Fogle can expose a small area for you to evaluate.

Thanks,

Grace Wang, Ph.D., P.E., BCEE, ENV SP  
Environmental Discipline  
KCI Technologies, Inc.  
936 Ridgebrook Road  
Sparks, MD 21152

Tel: 410-891-1762 (Office)  
410-271-8158 (Cell)

---

**From:** Oswald, Hank [<mailto:hoswald@howardcountymd.gov>]  
**Sent:** Friday, August 07, 2015 4:26 PM  
**To:** Guihua Wang; [timothywolfe@kci.com](mailto:timothywolfe@kci.com)  
**Subject:** 6801 Redberry Road

Ms. Wang/Mr. Wolfe:

Today, I received a call from Fogle's Septic requesting a date to perform additional testing at Redberry Lane. Per our meeting on July 22, 2015, your company was supposed to field locate the existing septic system components (i.e. drywell and/or trench) using your ground radar equipment and figure out if the existing septic system meets the 4 foot buffer requirement

Prior to scheduling the next phase of testing, we will need to see this information on a revised plan showing the exact location of the existing septic system. If the system is not located in the proposed sand mound locations, and the existing septic system does not meet the 4 foot buffer requirement then we may proceed with At-Grade or Sand Mound testing.

Please note: it's extremely important to rope off the proposed sand mound areas so trucks and heavy equipment do not compact those areas and render unfit for a future system (while searching for the existing septic system). Should you need to extend your search into the proposed sand mound area, please use a probe.

Also, the Sand Mound calculations submitted for review shows a Bed Length of 80 feet but the length of the proposed sand Mound systems shown on the plan are only 65 feet.

Let me know if you have any questions.

Hank

Hank Oswald, L.E.H.S.  
Howard County Health Department  
Bureau of Environmental Health  
Well & Septic Program  
410.313.1786

GEORGE AND LINDA ROHALEY  
11924 HALL SHOP ROAD  
TAX MAP 35, GRID 20, PARCEL 360  
LOT 17 SEC 2 FOXPAUSE

Proposed Alternative  
Absorption Bed

Proposed  
Absorption Bed

HALL SHOP ROAD

EX. SEPTIC AREA

EX. HOUSE #6801

PROP. DECK  
PROP. ADDITION

PROP. B.R.  
OVER EX.  
GARAGE

10,000 SQ. FT.

WILLIAM AND HEATHER SCHAD  
11867 HALL SHOP ROAD  
TAX MAP 35, GRID 20, PARCEL 152

ANIKET AND VENKATARAMANA S'DHAYE  
6801 REDBERRY ROAD  
TAX MAP 35, GRID 19, PARCEL 205  
LOT 3 SEC. 1 DOGWOODS

JAMES AND CYNTHIA SULLIVAN  
6802 REDBERRY ROAD  
TAX MAP 35, GRID 19, PARCEL 205  
LOT 2 SEC. 1 DOGWOODS


ROBERT C. COLE AND PATR  
6838 GUILFORD ROAD  
TAX MAP 35, GRID 20, PAR

NO WELLS OR SEPTICS  
WITHIN 200' OF #6801  
REDBERRY ROAD




OLD D.W.  
POOL  
BERLY WATERWORTH  
P ROAD

NOTE:

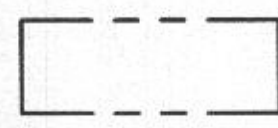

DESIGNATES PROPOSED ABSORPTION BED

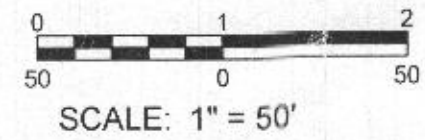

DATE:	July 2015
SCALE:	1:50
DRAWN BY:	MRL
CHECKED BY:	GW

FIGURE 1

DRAWING

1 OF 1

Jun 30, 2015 -- 2:25pm User: michelle.rosario  
M:\2015\1315828\Drawings\5mnd Round Sketch.dwg