


SINGLE STORY HOUSE

REVISED
Date: 2/24/21 - B21 000278
Comments: Revised Floor Plans

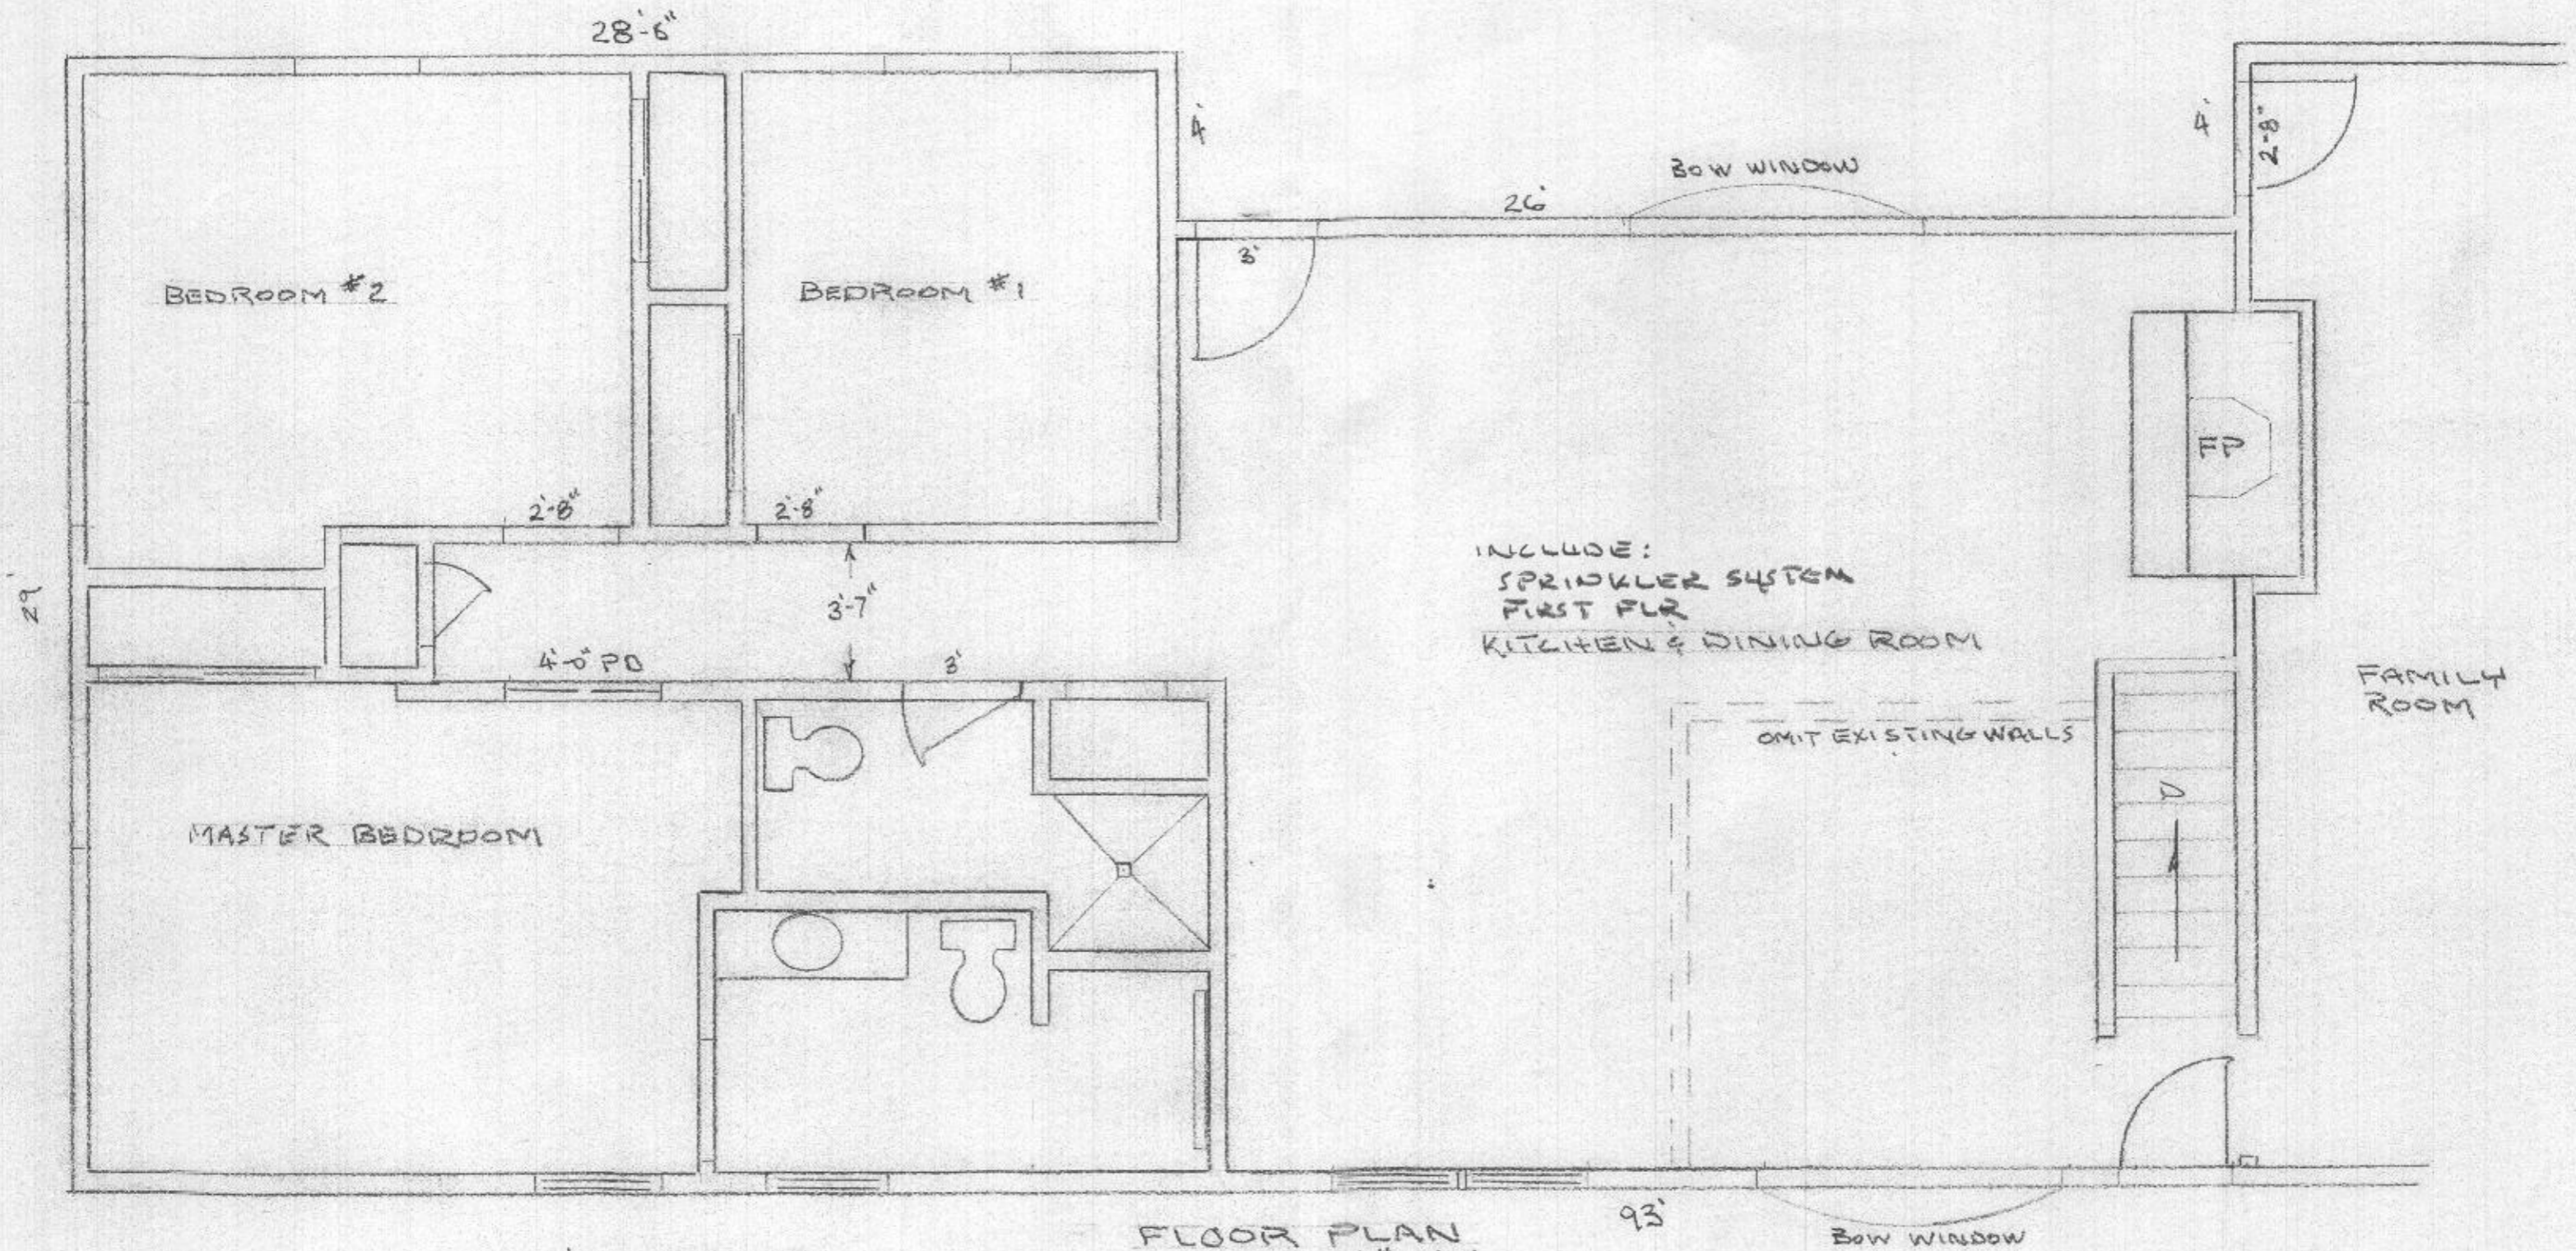


LOW & JANICE FRIES
12830 PANS SPRING CT
ELLICOTT CITY, MD 21042

SINGLE STORY HOUSE

REVISED

Date:

Comments: _____

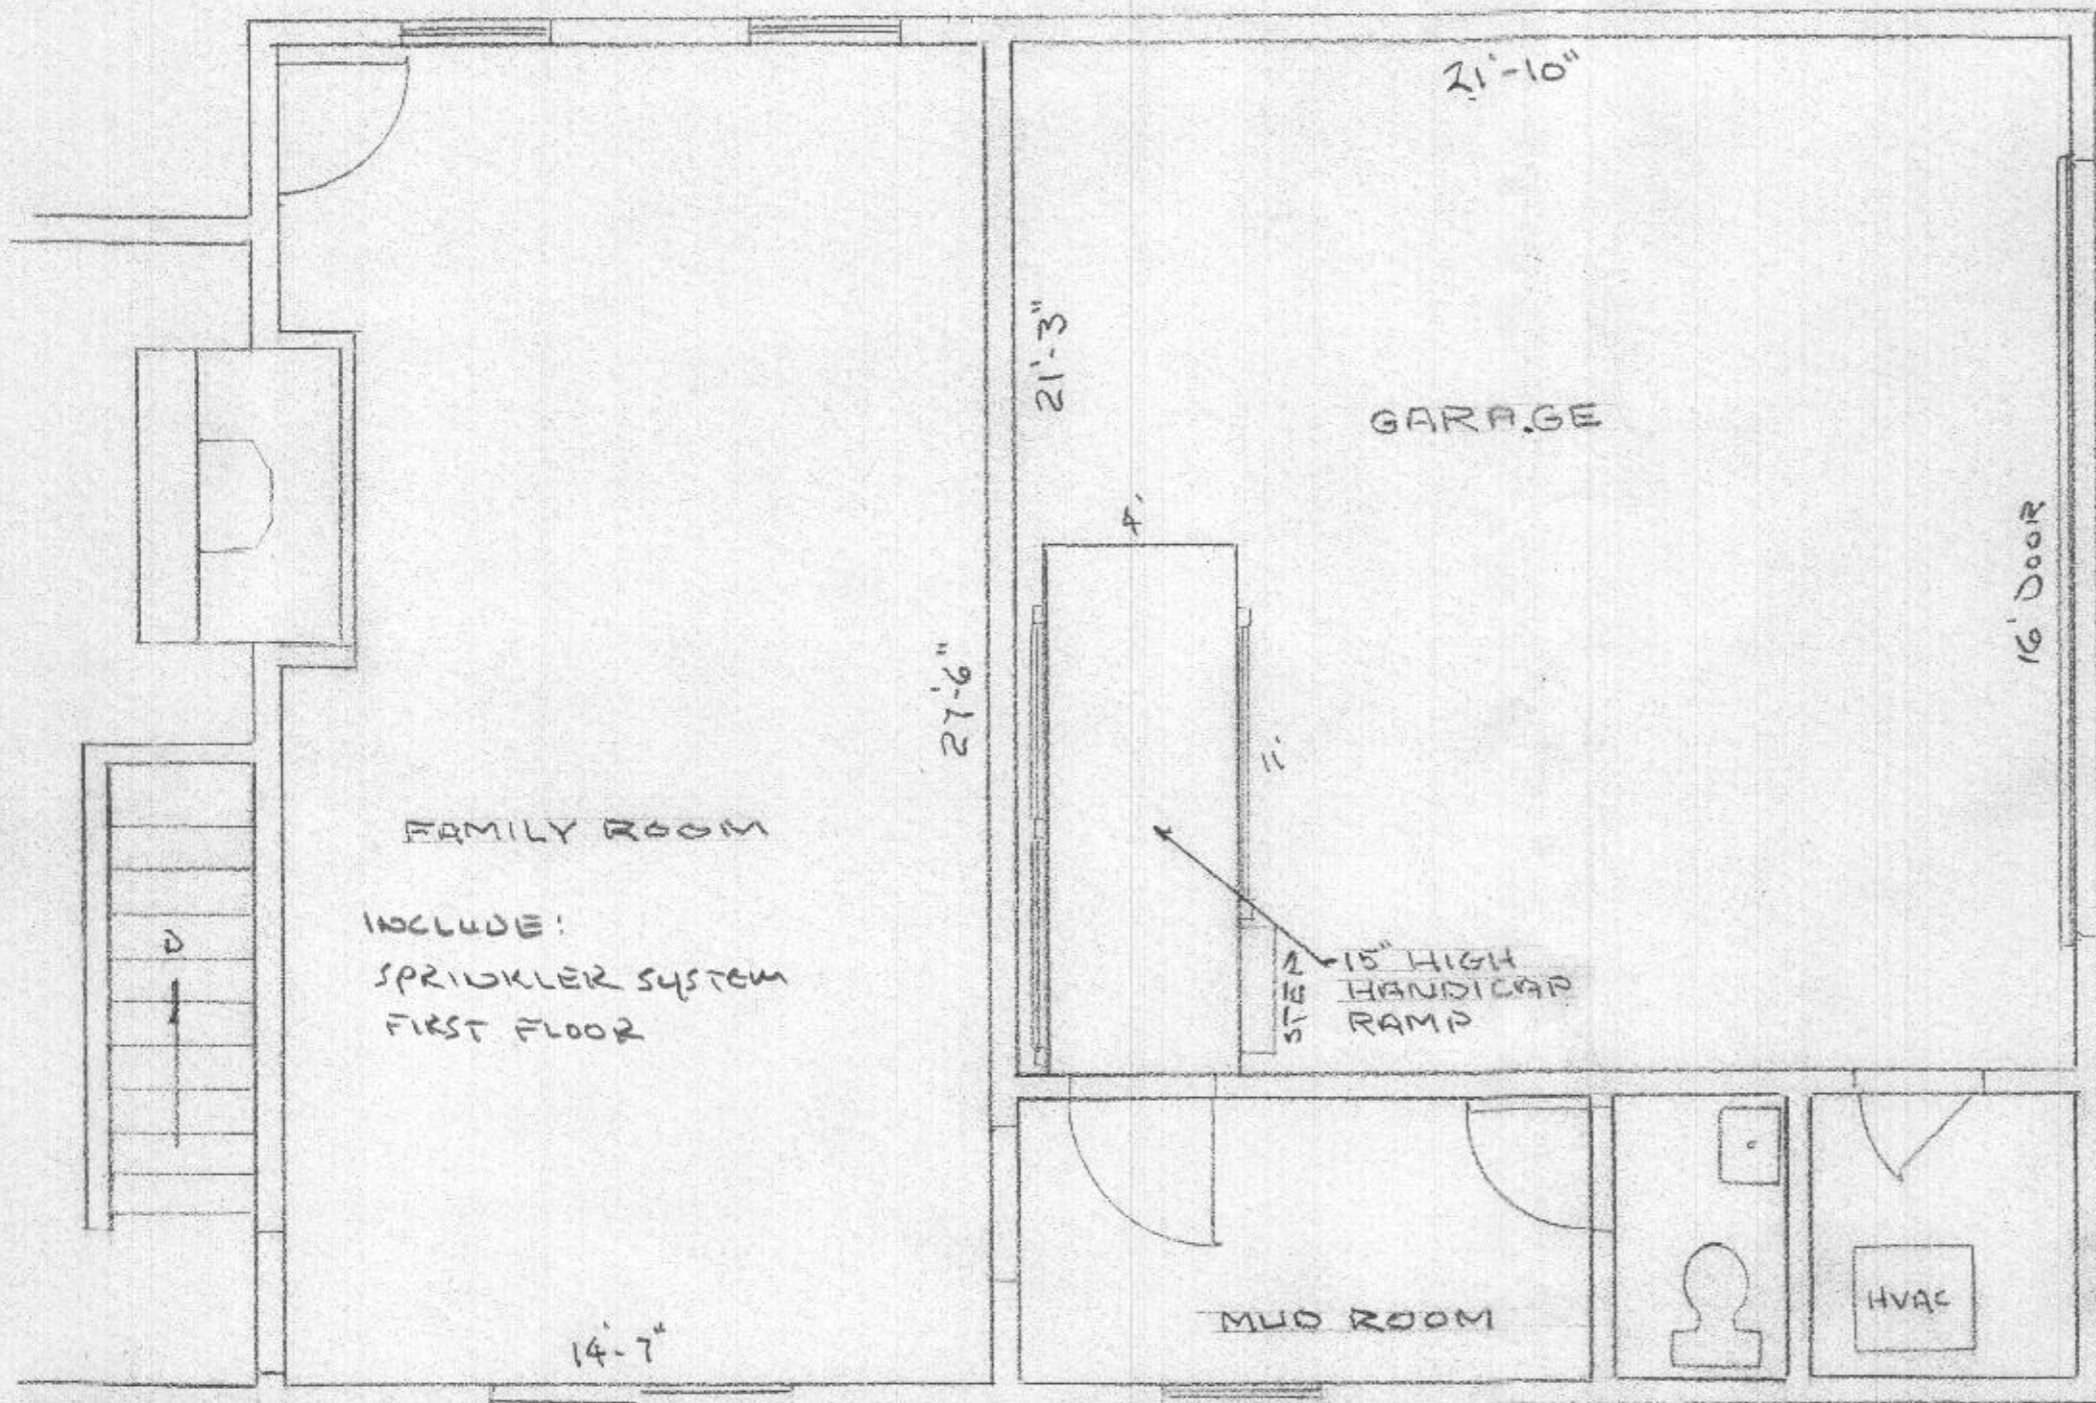

JOB ADDRESS:
12330 PAN'S SPRING CT.
ELLCOTT CITY, MD 21042
HOME OWNER:
LOU & JANICE FRIES

FIRST FLOOR-INTERIOR
SF 1876
BASEMENT SF 1330


FLOOR PLAN
SCALE: 1/4" = 1'-0"

SINGLE STORY HOUSE
SCALE: 1/4" = 1'-0"

REVISED


Date:

Comments: _____

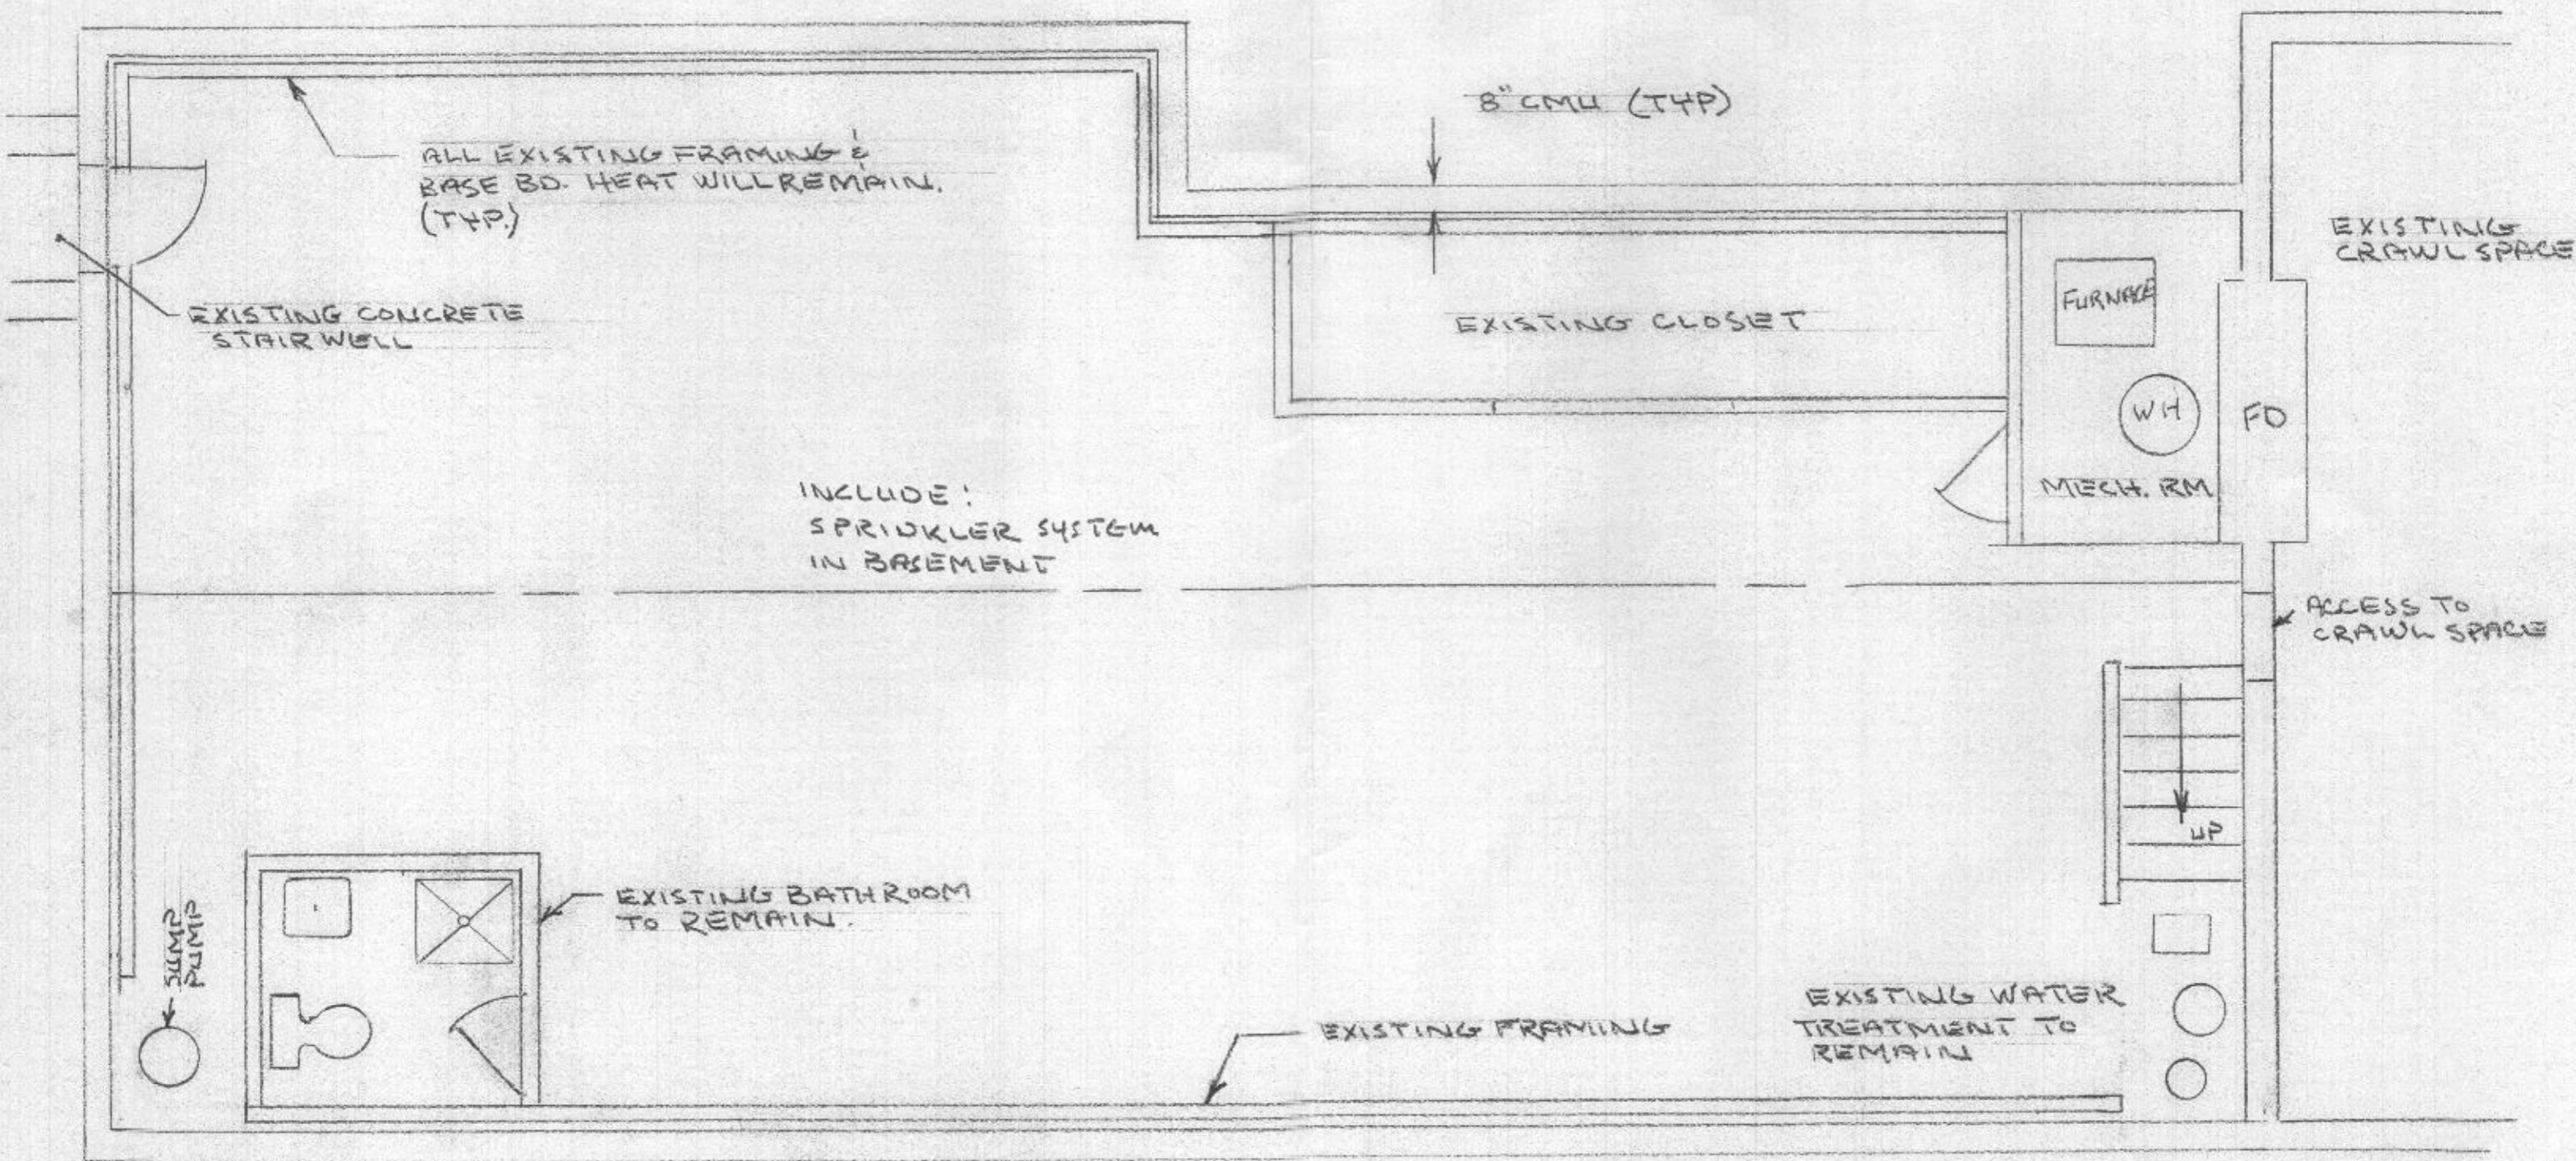

BASEMENT FLOOR PLAN
12380 PAN'S SPRING CT
ELlicOTT CITY, MD 21042

SINGLE STORY HOUSE

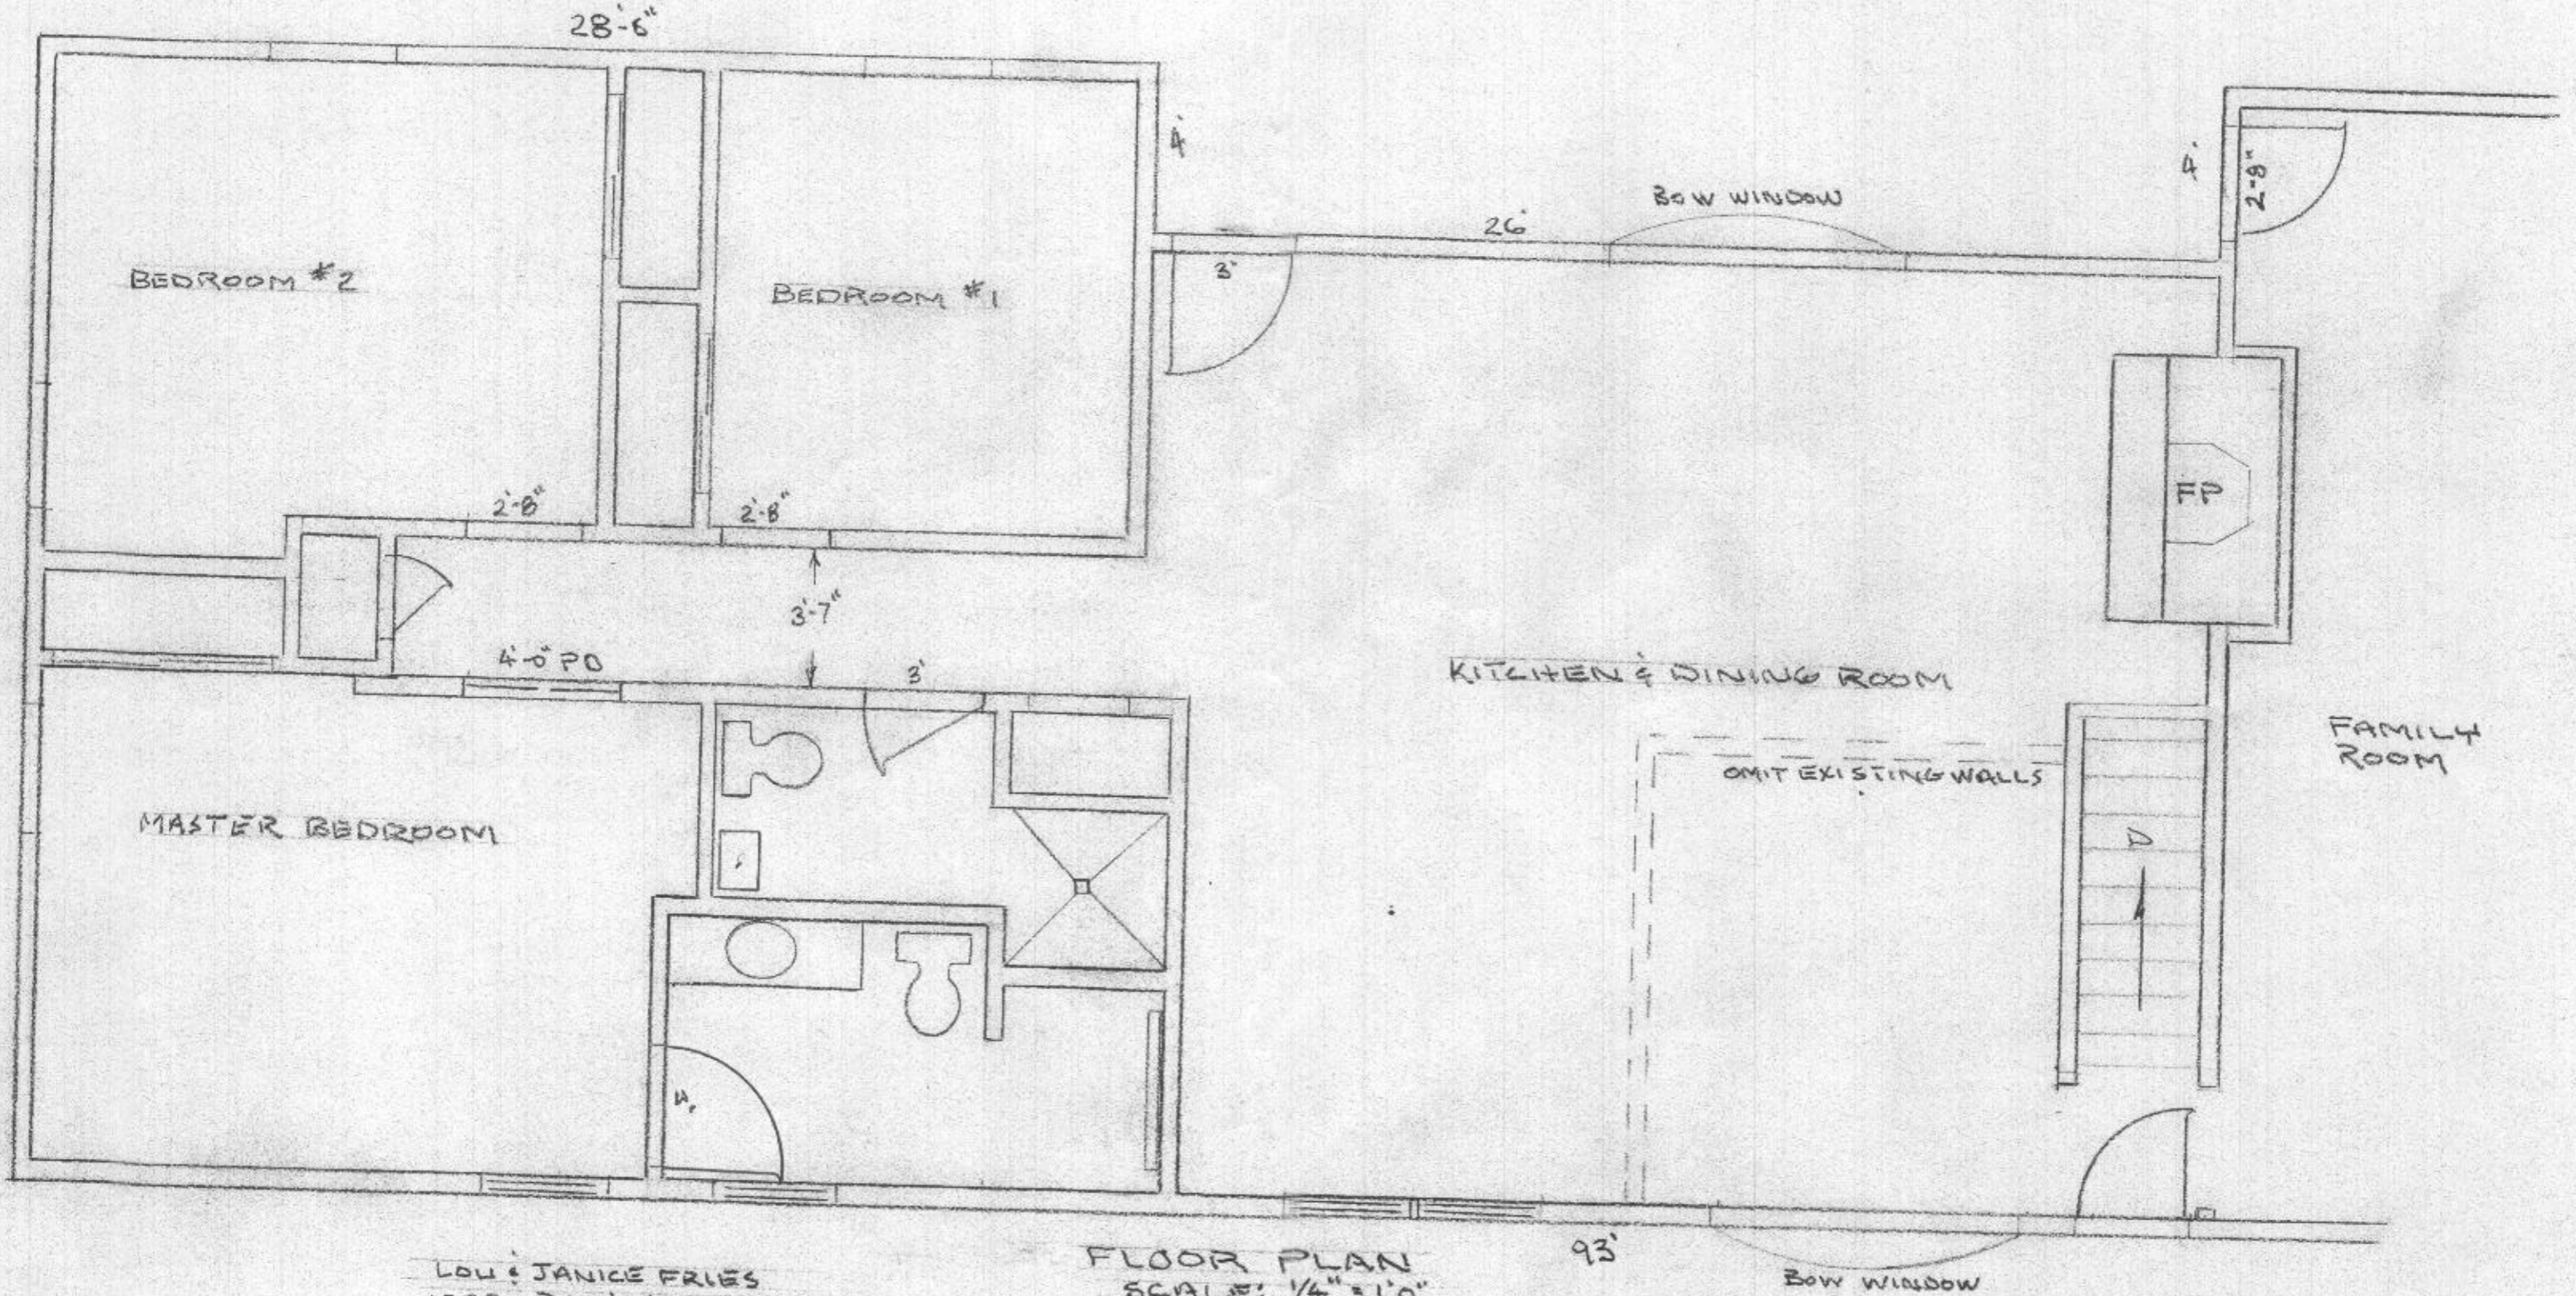


LOU & JANICE FRIES
12330 PANS SPRING CT
ELLICOTT CITY, MD 21042

FLOOR PLAN
SCALE: 1/4" = 1'0"

BOW WINDOW

SINGLE STORY HOUSE

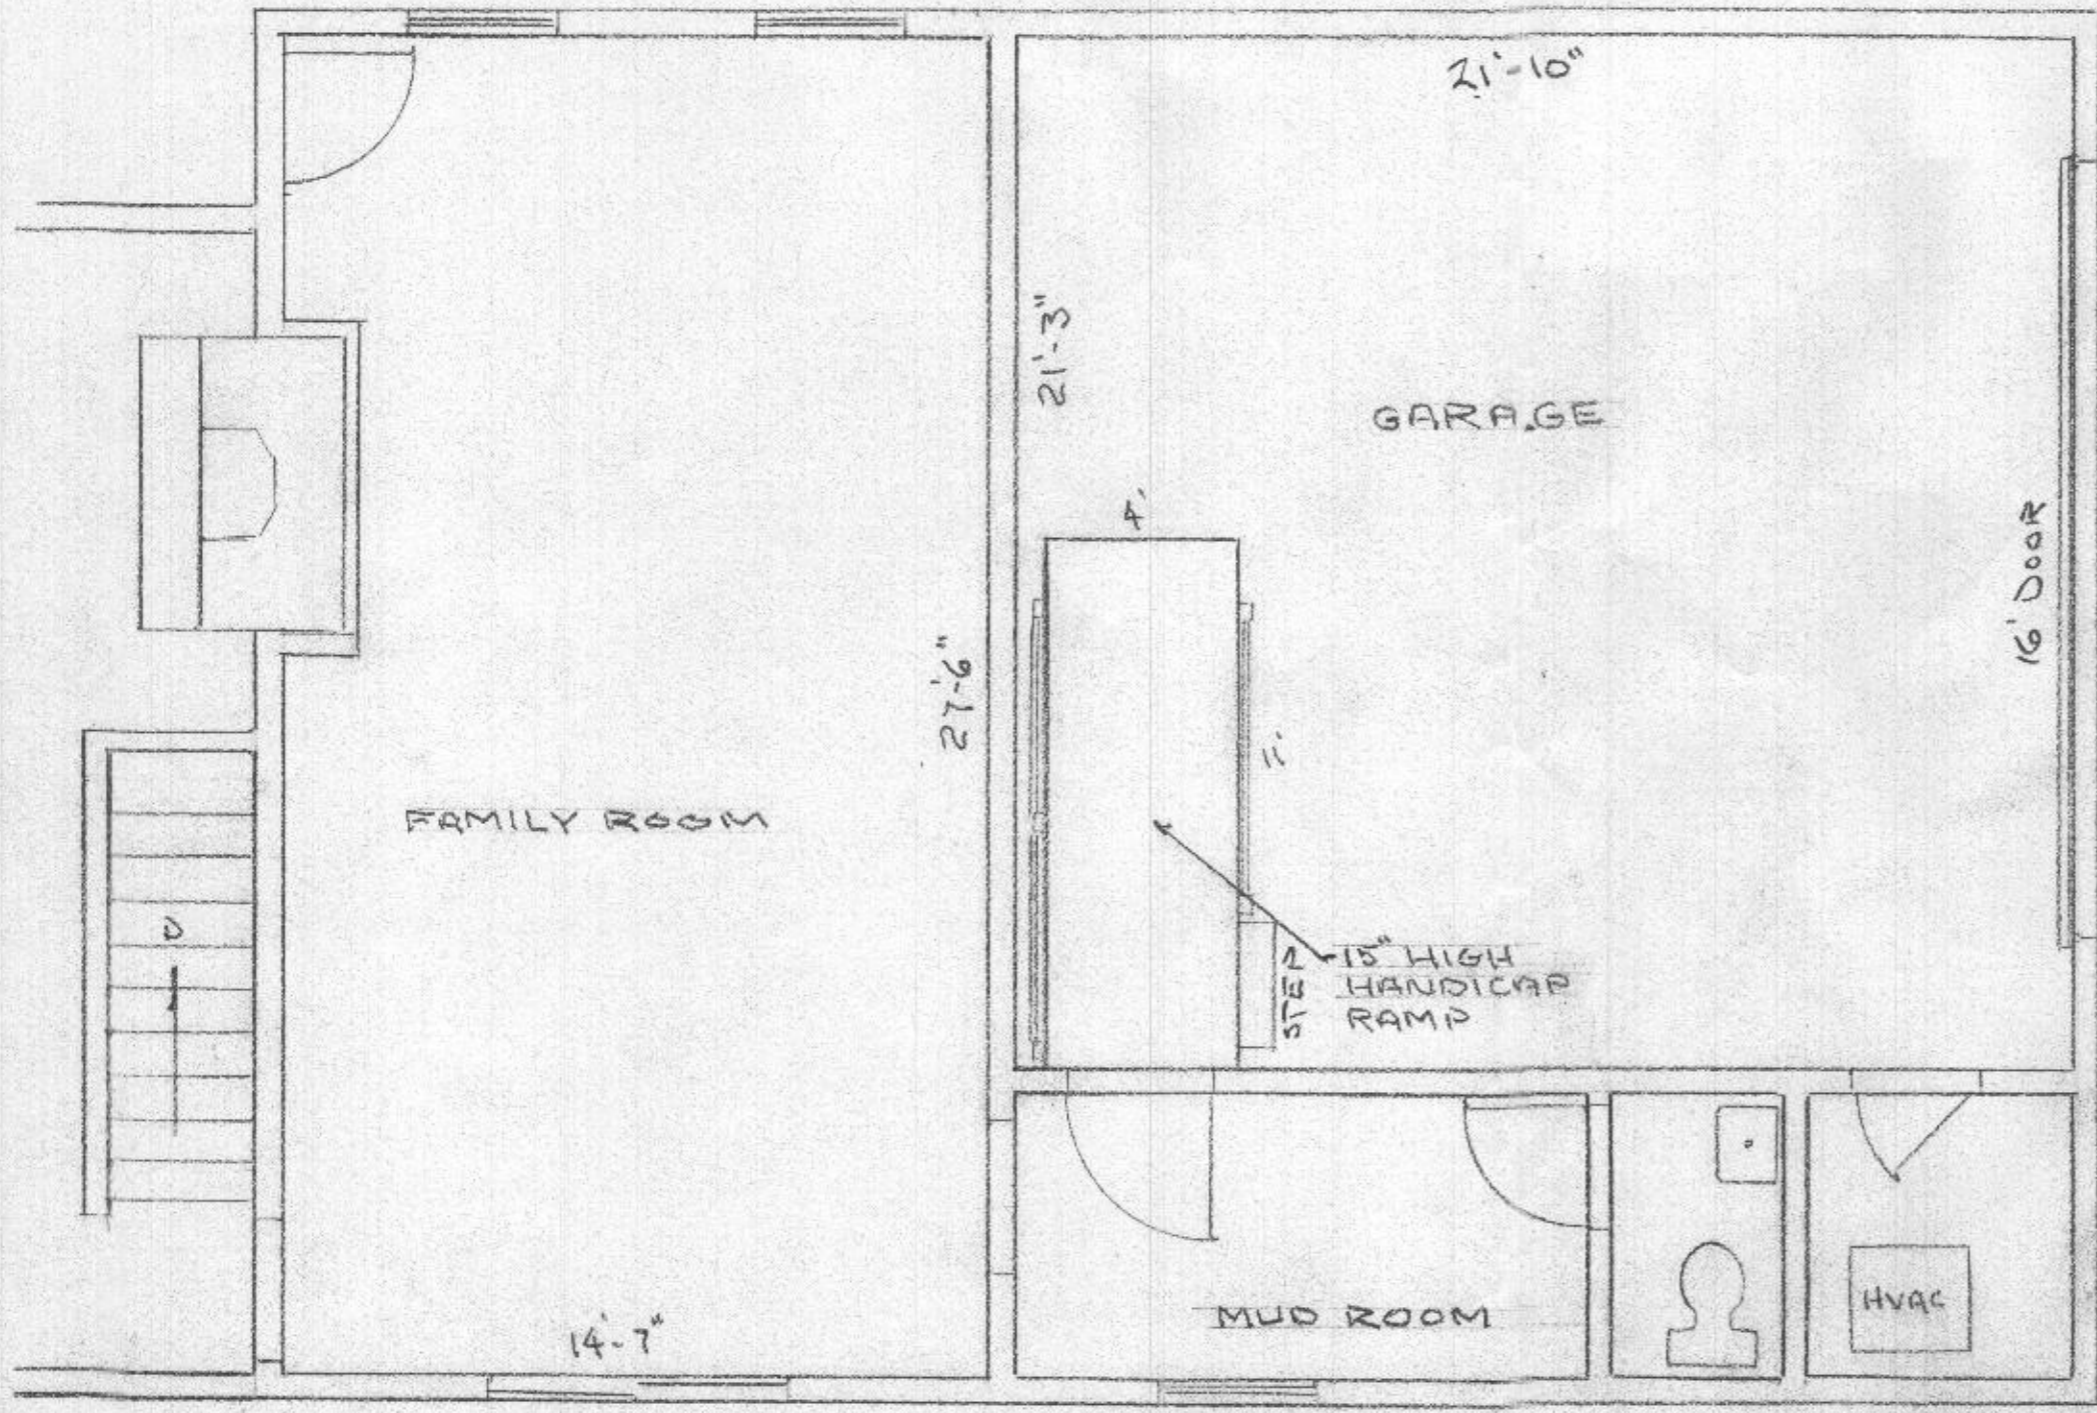


JOB ADDRESS:
12330 PAN'S SPRING CT.
ELLCOTT CITY, MD 21042
HOME OWNER:
LOW & JANICE FRIGS

FIRST FLOOR-INTERIOR
SF 1,876
BASEMENT SF 1,330


FLOOR PLAN
SCALE: 1/4" = 1'-0"

SINGLE STORY HOUSE
SCALE: 1/4" = 1'-0"

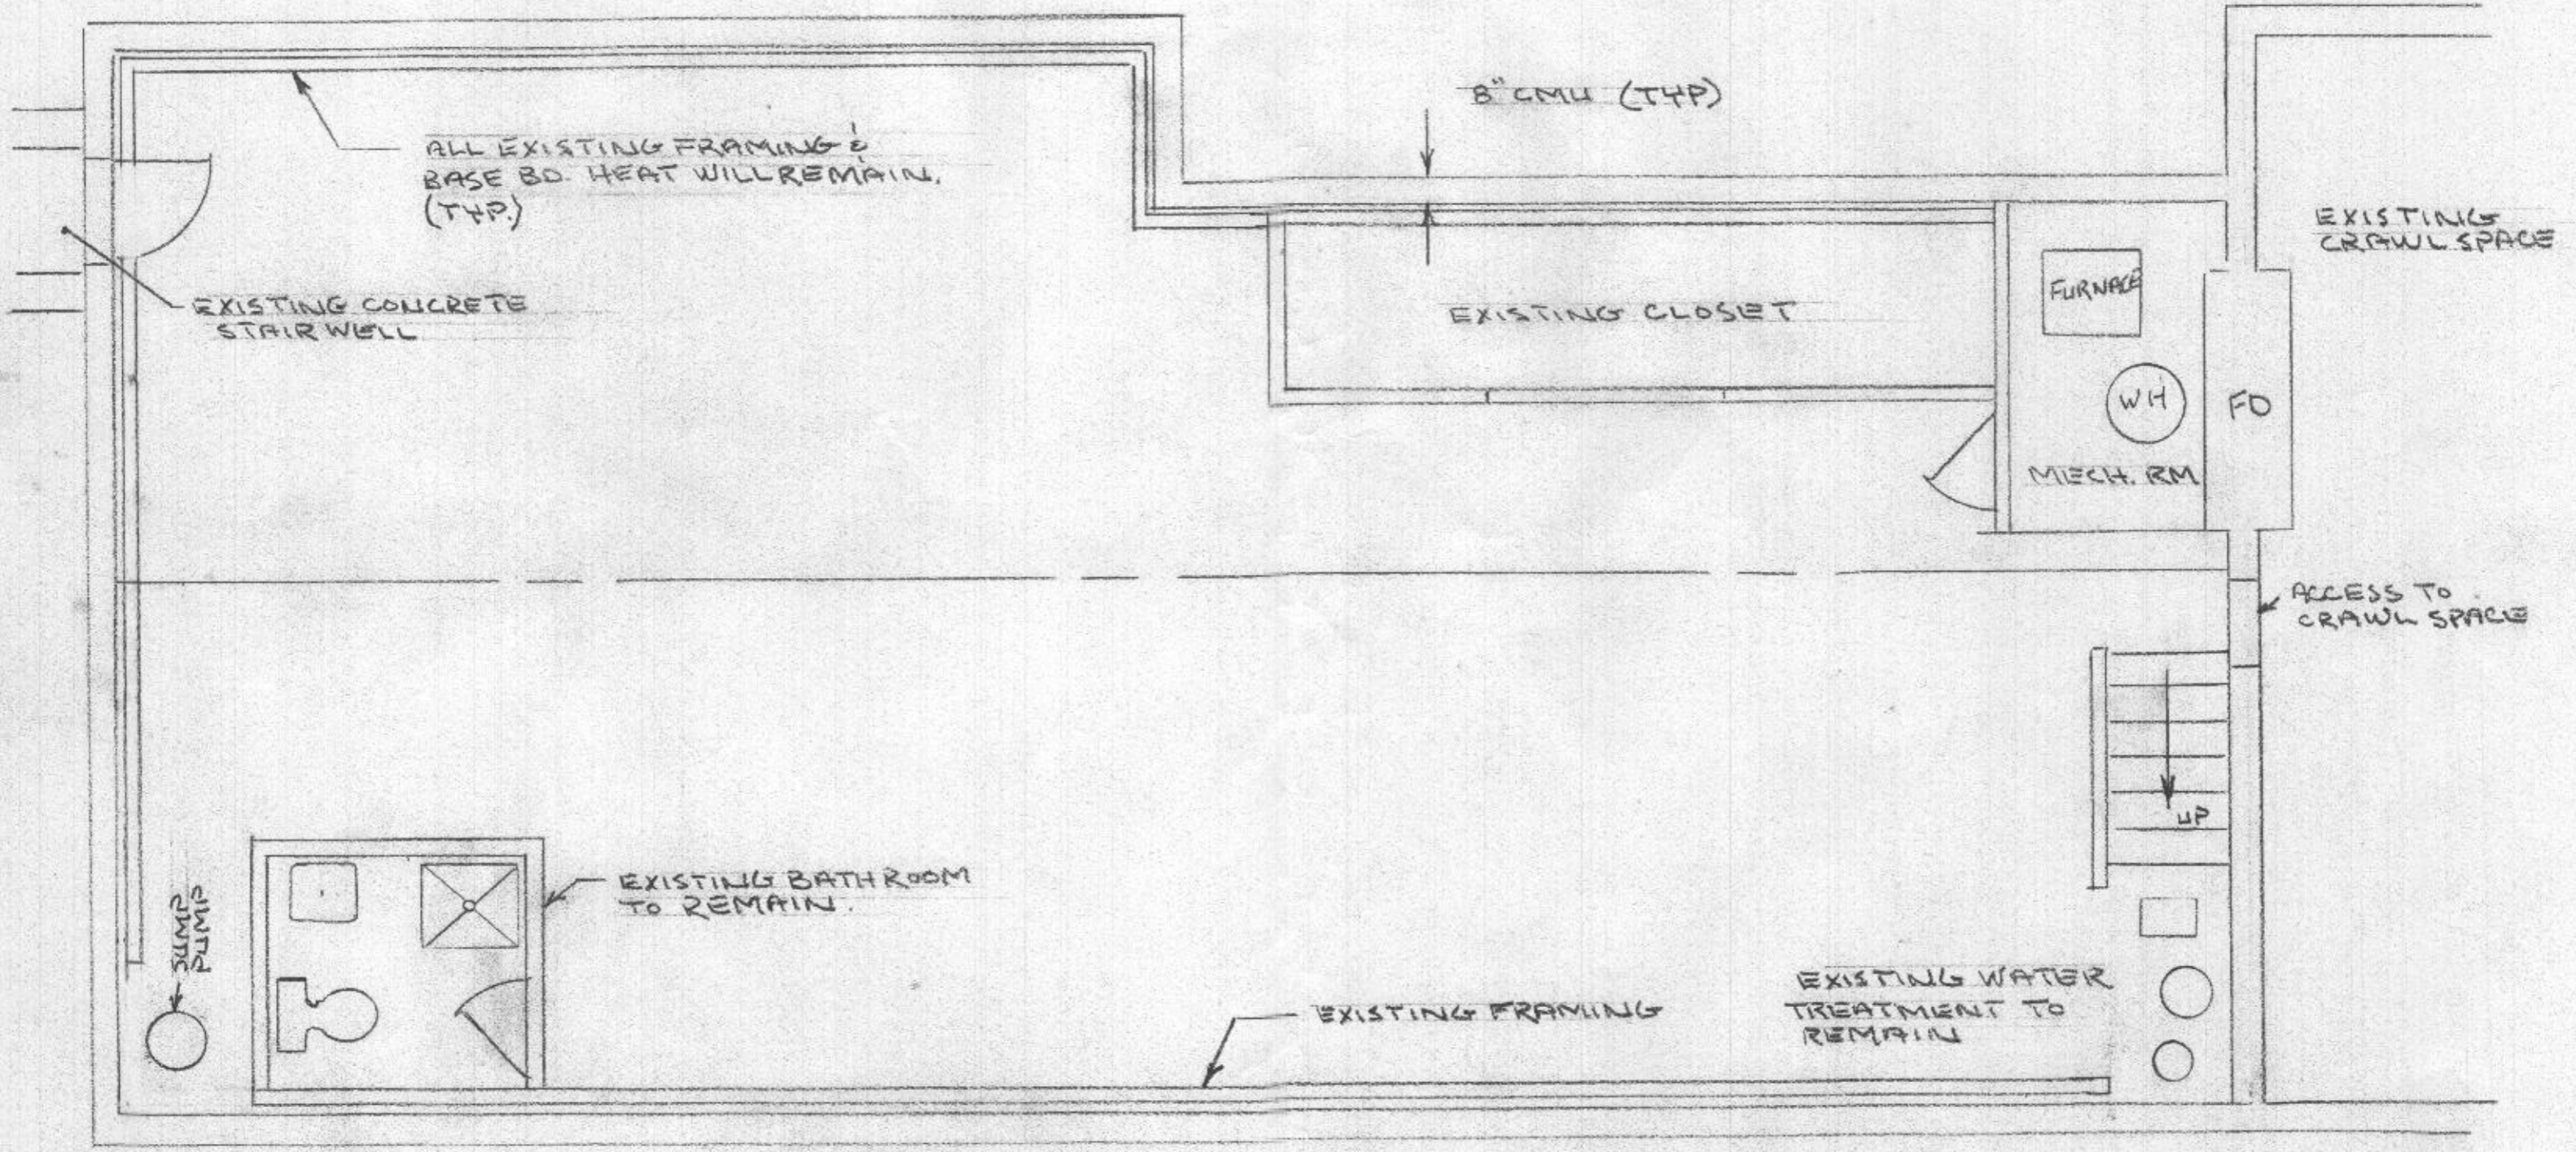

BASEMENT FLOOR PLAN
12380 PAN'S SPRING CT
ELLCOTT CITY, MD 21042

PAN'S SPRING COURT
50' R/W

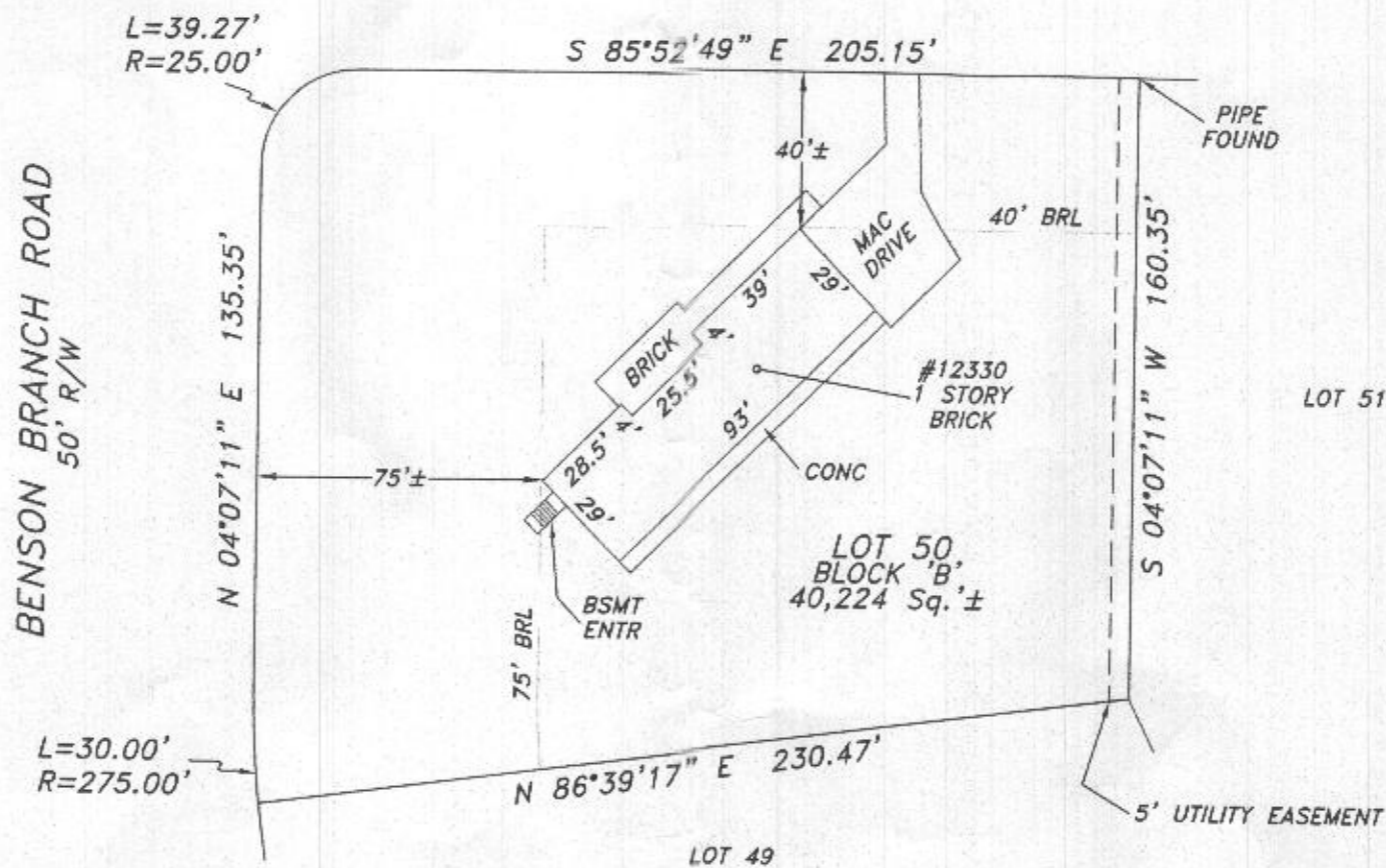

The purpose of this drawing is to locate, describe, and represent the positions of buildings and substantial improvements affecting the property shown hereon, being known as:
LOT 50, BLOCK 'B', SECTION SIX "WOODMARK"
 recorded among the land records of Howard County, Maryland in Plat Book 18, page 100



James Carl Hudgins
 Property Line Surveyor #96
 Expiration Date: 3/11/2022

LOCATION DRAWING
 12330 PAN'S SPRING COURT
 3rd ELECTION DISTRICT
 HOWARD COUNTY, MARYLAND

PREPARED FOR:

R&P
 SETTLEMENT GROUP

This is page one of a two page document. The advice found on the affixed page is an integral part of this drawing, and is not valid without all pages.

NTT Associates, Inc.
 16205 Old Frederick Rd.
 Mt. Airy, Maryland 21771
 Phone: (410) 442-2031
 Fax: (410) 442-1315
 www.nttsurveyors.com

Scale:	1" = 50'
Date:	11/25/2020
Field By:	SLM
Drawn By:	SLM
File No.:	20-3336-BS
Page No.:	1 of 2