
WATER WELL ABANDONMENT-SEALING REPORT FORM

SUBMIT COPIES OF COMPLETED FORM TO:

- * COUNTY ENVIRONMENTAL AGENCY (contact MDE, WMA if address needed)
- * WELL OWNER
- * MDE, WATER MANAGEMENT ADMINISTRATION, WELL PROGRAM

APPROVED
12/04/2020
[Signature]

DATE WELL ABANDONED: 7-2-20 (month/day/year)

* PERMIT NUMBER OF ABANDONED WELL (if any) _____

— N/A —

* PERMIT NUMBER OF REPLACEMENT WELL: _____


* PERSON ABANDONING WELL: Andrew Hansen WELL DRILLER'S LICENSE NUMBER: 224

CIRCLE: MWD / MSD / MGD

* OWNER'S NAME: James Foster

SITE LOCATION MAP

* WELL LOCATION:
COUNTY: Howard
NEAREST TOWN: Clarksville
TAX MAP 0035 BLOCK 0007 PARCEL 0023
SUBDIVISION: _____
SECTION: _____ LOT: _____
STREET ADDRESS: 6044 Trotter RD

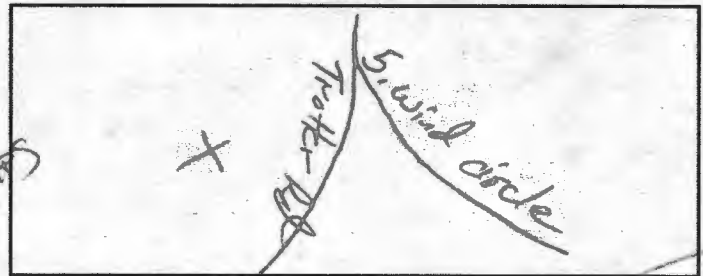

FOSTER JAMES
TRUSTEE

LATITUDE 39.203595
LONGITUDE 76.920223

LOG OF SEALING MATERIAL

* TYPE OF WELL BEING ABANDONED:
 DRILLED JETTED
 BORED HAND DUG
 OTHER (specify) _____

MATERIAL	FEET	
	FROM	TO
Stone	34	15
Concrete	15	7

* USE CODE:
 DOMESTIC MUNICIPAL/PUBLIC
 IRRIGATION INDUSTRIAL
 TEST/OBSERVATION GEOTHERMAL

VOLUME OF MATERIAL USED

* TYPE OF CASING:
 STEEL PLASTIC
 CONCRETE OTHER (specify) _____

Stone 8 tons / 3.5 yds concrete

SIZE OF CASING: _____ INCHES IN DIAMETER

DEPTH OF WELL: 34 FEET DEEP

WAS ANY CASING REMOVED? YES NO
If yes, length removed, in feet: _____

WAS CASING RIPPED OR PERFORATED? YES NO

Pursuant to § 10-624 of the State Govt. Article of the Maryland Code, personal info requested on this form is used in processing this form pursuant to COMAR 26.04.04. Failure to provide the info may result in this form not being processed. You have the right to inspect, amend, or correct this form. The Maryland Department of the Environment is subject to the Maryland Public Information Act. This form may be made available on the Internet via MDE's website and is subject to inspection or copying, in whole or in part, by the public and other governmental agencies, if not protected by federal or State Law.

SIGNATURE-MASTER WELL DRILLER OR SUPERVISING SANITARIAN LICENSE# _____

224 MWD MSD MGS

CIRCLE ONE

7-2-20 DATE

COUNTY