



Howard County Health Department

Maura J. Rossman, M.D., Health Officer

Bureau of Environmental Health

8930 Stanford Boulevard, Columbia, MD 21045

Main: 410-313-2640 | Fax: 410-313-2648

TDD 410-313-2323 | Toll Free 1-866-313-6300

www.hchealth.org

Facebook: www.facebook.com/hocohealth

RECEIPT DATE: 4/23/21

ONSITE SEWAGE DISPOSAL SYSTEM

P 568876

APPROVAL DATE: 5/27/21

PERMIT:

REPAIR

A

PROPERTY ADDRESS: 12704 Triadelphia Road

SUBDIVISION: _____

LOT: _____

TAX ID: _____

CONTRACTOR: Fogles Septic Clean Inc

EMAIL: kim@foglesinc.com

CONTRACTOR ADDRESS: 580 Obrecht Road, Sykesville, MD 21784

PHONE: 410-795-5670

PROPERTY OWNER: Alexandra Crisostomo

EMAIL: _____

OWNER ADDRESS: 12704 Triadelphia Road, Ellicott City, MD 21042

PHONE: 443-878-9379

SEPTIC TANK SIZE (GALLONS): Fasting PUMP CHAMBER CAPACITY (GALLONS): — PUMP SIZE: —

NUMBER OF BEDROOMS: 3 HOUSE SQ. FT. _____ APPLICATION RATE: 1.2

DISTRIBUTION SYSTEM: GRAVITY FED ☒ LOW PRESSURE DOSED ☐

TRENCHES:	LINEAR FEET REQUIRED: <u>60 LF</u>	INLET DEPTH: <u>4</u>
	TRENCH WIDTH: <u>3</u>	MAXIMUM BOTTOM DEPTH: <u>10'</u>
	MINIMUM SPACE BETWEEN TRENCHES: <u>N/A</u>	EFFECTIVE AREA BEGINNING DEPTH: <u>6.5'</u>
LOCATION:	TO BE STAKED BY SANITARIAN DURING PRE-CONSTRUCTION INSPECTION.	
NOTES:	Install 1x60' trench just below perc A. Trench flagged out in field. Pump and collapse ex. D.W.	

ISSUED BY: K. Wolf ISSUE DATE: 5/12/21 EXPIRATION DATE: 5/15/22

NOTE: CONTRACTOR MUST SCHEDULE A PRE-CONSTRUCTION INSPECTION PRIOR TO BEGINNING ANY INSTALLATION

NOTE: CONTRACTOR MUST SCHEDULE AN INSPECTION AND GAIN APPROVAL OF ALL COMPONENTS PRIOR TO COVERING

NOTE: STONE MUST BE APPROVED BY HEALTH DEPARTMENT AND GRAVEL TICKET MUST BE AVAILABLE FOR REVIEW.

NOTE: WATERTIGHT SEPTIC TANKS REQUIRED

NOTE: ALL PARTS OF SEPTIC SYSTEM SHALL BE AT LEAST 100 FEET DOWNGRADE FROM ANY WATER WELL

NOTE: MANHOLE RISERS REQUIRED ON ALL SEPTIC TANKS AND PUMP CHAMBERS

NOTE: AN ELECTRICAL PERMIT IS REQUIRED FOR INSTALLATION OF ANY ELECTRICAL COMPONENTS OF THE SYSTEM

☐ ELECTRICAL PERMIT ISSUED E N/A

NOTE: THE HCHD DOES NOT WARRANTY ANY SYSTEM AND CANNOT GUARANTEE THE PERFORMANCE OF THIS SYSTEM AS DESIGNED. BY ACCEPTING THIS PERMIT, THE OWNER AND/OR APPLICANT ACKNOWLEDGE THAT THE SPECIFICATIONS DETAILED IN THIS DESIGN ARE ONE POSSIBLE OPTION AND THAT THE HCHD WILL REVIEW OTHER PROPOSALS. YOU HAVE THE OPTION TO SEEK THE ADVICE OF A QUALIFIED DESIGN CONSULTANT OR PROFESSIONAL ENGINEER FOR FURTHER GUIDANCE.

NOTE: MDE RECOMMENDS SEPTIC TANKS, BAT, AND OTHER PRETREATMENT UNITS BE PUMPED AT A FREQUENCY ADEQUATE TO ENSURE THAT SOLIDS ARE NOT DISCHARGED TO THE DISPOSAL AREA


NEITHER THE HOWARD COUNTY COUNCIL NOR THE HEALTH DEPARTMENT IS RESPONSIBLE FOR THE SUCCESSFUL OPERATION OF ANY SYSTEM.

PERMITTEE RESPONSIBLE FOR OBTAINING FINAL APPROVAL ON THIS PERMIT.

CALL 410-313-1771 TO SCHEDULE INSPECTIONS.

NOT TO SCALE

Ex. well
W (P. 8)

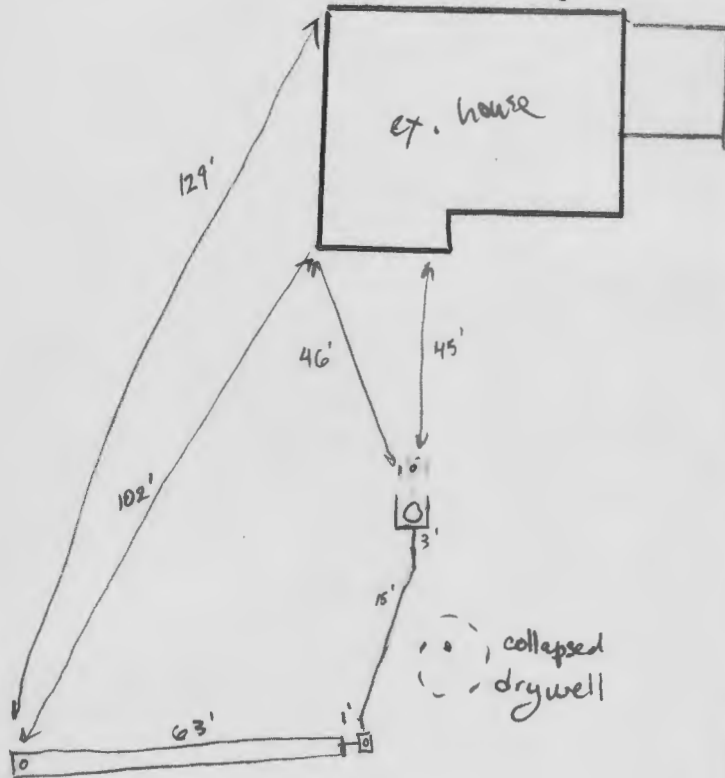

TRENCH/DRAINFIELD DATA

WIDTH	INLET	BOTTOM
3'	4'	10'
NUMBER OF TRENCHES		1
TOTAL LENGTH		63'
ABSORPTION AREA		189 sq ft + sidewalk
DISTRIBUTION BOX LEVEL		N/A
DISTRIBUTION BOX BAFFLE		yes
DISTRIBUTION BOX PORT		yes

SEPTIC TANK DATA

SEPTIC TANK 1 LEVEL _____

MANUFACTURER _____ ?

CAPACITY _____ 1000 ? GAL

SEAM LOC _____ mid

TANK LID DEPTH _____ 3'

BAFFLES _____ outlet (existing)

BAFFLE FILTER _____

MANHOLE LOC _____ outlet (new)

6" PORT LOC _____ inlet

WATERTIGHT TEST _____

SLOTTED _____ A2

DATE ON LID _____

PUMP/SEPTIC TANK LEVEL

MANUFACTURER _____

CAPACITY _____ GAL

SEAM LOC _____

TANK LID DEPTH _____

BAFFLES _____

BAFFLE FILTER _____

MANHOLE LOC _____

6" PORT LOC _____

WATERTIGHT TEST _____

SLOTTED _____

DATE ON LID _____

PRE-CONSTRUCTION:

5/12/21 House is only 2BR. Install 1x60' trench run out towards corner prop. line keep 100' from well arc's.

15m

INSTALLATION:

5/27/21 Installed new manhole on outlet side of tank. D-box set, 1x63' trench constructed. Old drywell was full, will be filled and collapsed. (ST)

FINAL INSPECTOR

Susan Thomas

DATE OF APPROVAL

5/27/21



HOWARD COUNTY HEALTH DEPARTMENT

68876

DATE 4/23/21

Received From

Doles Septic

PHONE #

410-75-5670

For

Septic Repair - 12704 Pers Triadaphia R.D.

☐ CASH

☒ CHECK

NO.

11739

Three hundred thirty

Dollars

\$

330.00

Received By

J. Kent