

**COMPLETE THIS FORM WHEN DROPPING OFF ANY
CORRESPONDENCE AND/OR PLANS TO THE HOWARD COUNTY
DEPARTMENT OF INSPECTIONS, LICENSES AND PERMITS COUNTER:**

Date:

5/17/2021

To:

CINDY FERITTA

(Person's Name and Division)

From:

THOMAS CAPPS 410.984-6385

(Your Name, Company Name and Telephone Number)

Subject:

Project name

Homeowner detached GARAGE

Project site address

14955 TRIADELPHIA RD. GLENELG MD.

Permit Number

B 20004280

SDP #

Other information pertinent to this project

☒ Please check the attachments below that you are submitting with this transmittal:

☐ Letter of response to Howard County plan review code letter

☒ Revised plans and/or revised details: When submitting for a complete re-review, duplicate sets shall be submitted.

☐ Structural steel certification

☐ Energy conservation calculations

☐ Certification for _____ (be specific).

☐ Copies of _____ (be specific).

☐ Two sets of single family dwelling model plans to be placed on permanent file: Model name and/or # ITS

☐ Other _____

Is there anyone else that should be contacted regarding this project if there are questions?

If so, please list that person's name and telephone number below:

(Person's name)

(Telephone number)

PLEASE ASSURE ALL DOCUMENTS AND/OR REVISIONS ARE APPROPRIATELY SIGNED AND SEALED, IF NECESSARY, BY A LICENSED ARCHITECT OR ENGINEER. PLEASE BE ADVISED THAT INSUFFICIENT INFORMATION MAY RESULT IN THE DELAY OF REVIEW BY THE PLANS EXAMINER. THE DEPARTMENT OF INSPECTIONS, LICENSES AND PERMITS WILL CONTACT YOU IF THERE IS A PROBLEM. IN ADDITION, ONCE THE BUILDING PERMIT IS APPROVED BY THE PLAN REVIEW DIVISION AND ALL OTHER REQUIRED SIGNATORY AGENCIES, AND THE BUILDING PERMIT IS READY FOR ISSUANCE, THE PERMIT DIVISION WILL NOTIFY THE APPROPRIATE CONTACT PERSON FOR PERMIT PICK UP. ALL PERMIT STATUS INQUIRIES SHALL BE DIRECTED TO THE PERMIT DIVISION AT 410-313-2455, CODE RELATED QUESTIONS AND PLAN REVIEW INQUIRIES SHALL BE DIRECTED TO THE PLAN REVIEW DIVISION AT 410-313-2436. PLEASE ALLOW A MINIMUM OF FIVE (5) WORKING DAYS FOR ANY PLAN SUBMITTALS TO BE REVIEWED. THANK YOU.

Received by

DROP BOX


white: Plan Review Division
yellow: Applicant
pink: Permit Division

t:\Updated forms\transmit.frm - Rev. 5/08


CHECK # 77

750.00 FEE

* ADDING 2ND FL BATH & KITCHENETTE
 * ADDING INTERIOR STAIRS
 * ADDING WASH SINK ON 1ST FLOOR
 * ADDING MISC. LIGHTING
 * ADDING 2ND FLOOR H.V.A.C.

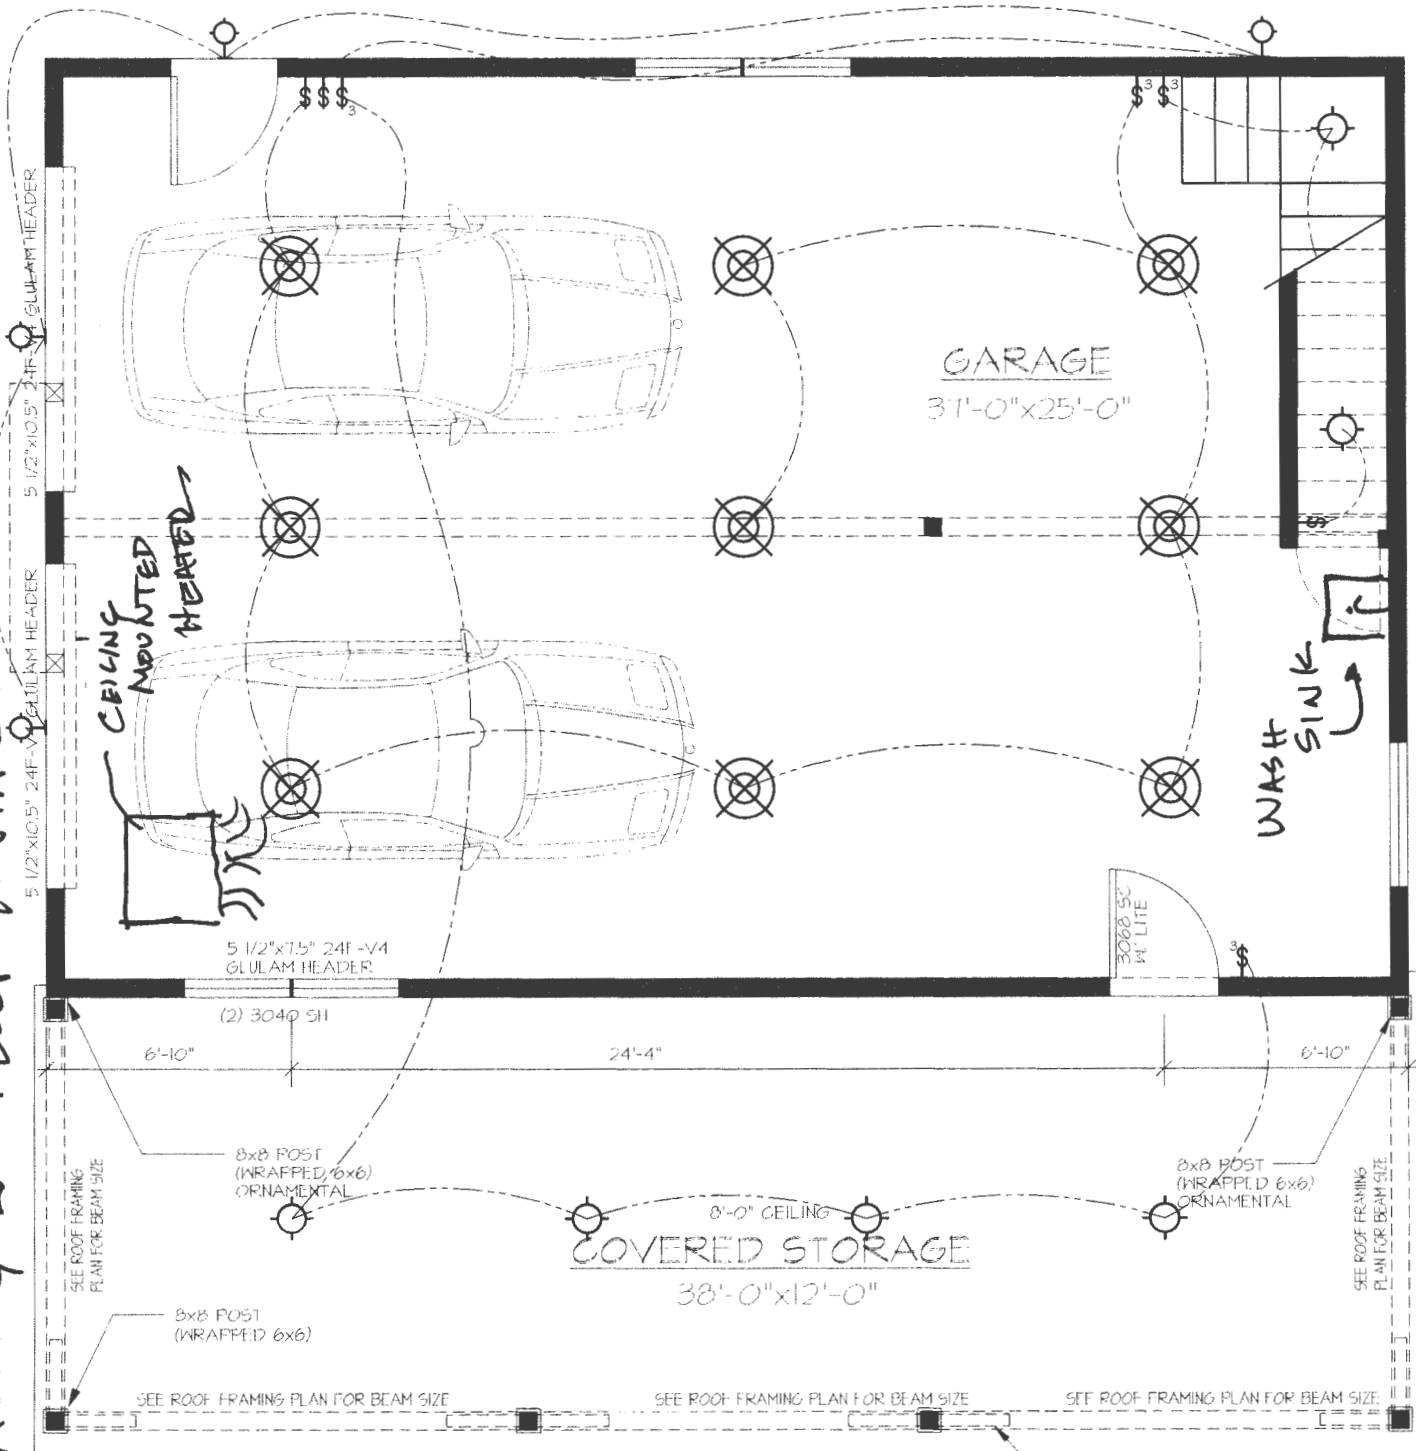

SCALE: 3/16" = 1'-0"

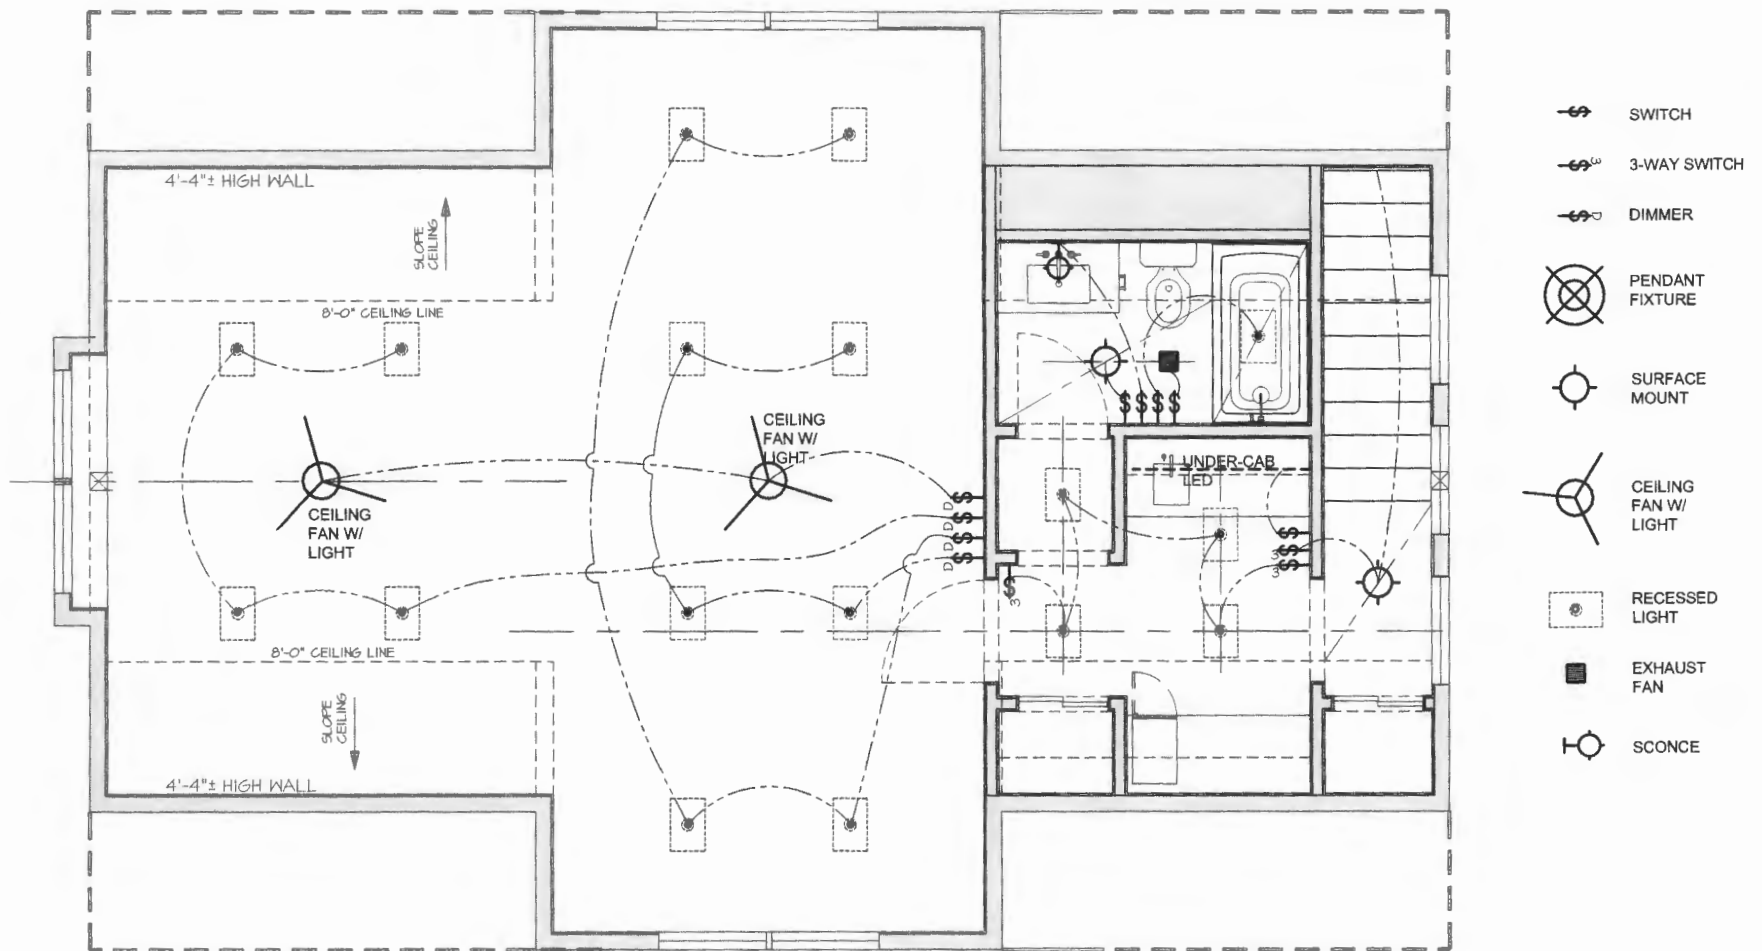

SCALE: 3/16" = 1'-0"

